
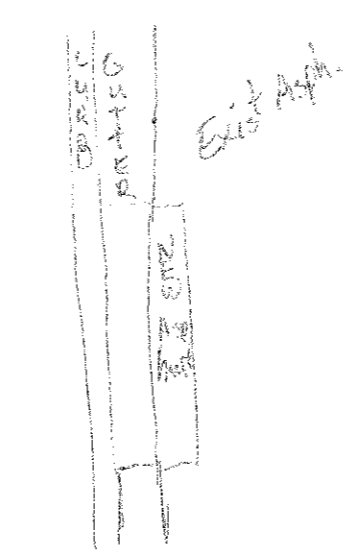


- NOTES:
1. AN APPROVED WHITE PIGMENTED CURING COMPOUND SHALL BE APPLIED TO THE SURFACE OF THE CURB AND GUTTER AS SOON AS IT HAS BEEN PLACED AND FINISHED.
 2. ALL REINFORCING STEEL SHALL BE #4 BARS.

Show concrete frame detail (s)!

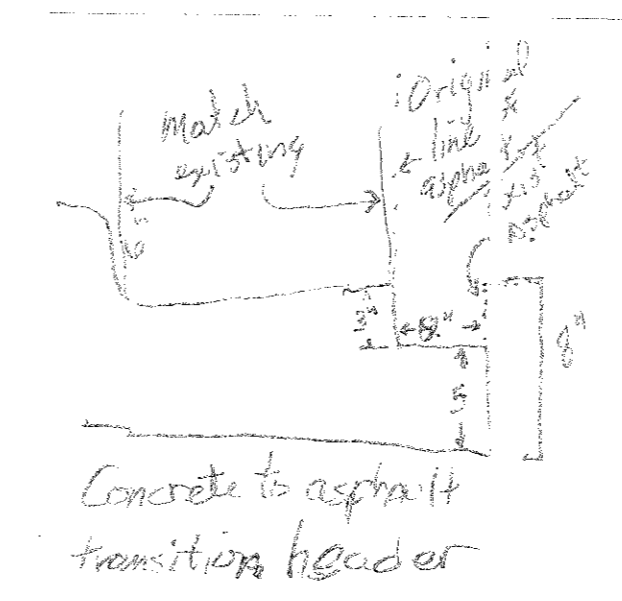

DRAFTED BY: O.E.I.

DESIGNED BY: O.E.I.

NOTES AND REVISIONS:

SEAL FOR REVIEW ONLY

ISSUED: 1/14/03

THIS DOCUMENT IS FOR REVIEW ONLY AND NOT INTENDED FOR BIDDING, CONSTRUCTION, OR PERMIT PURPOSES. IT WAS PREPARED BY, OR UNDER THE DIRECT SUPERVISION OF:

JIM O'BRIEN, P.E. #55881
O'BRIEN ENGINEERING, INC.

PREPARED BY:
O'Brien Engineering, Inc.
401 West Plano Parkway Suite 108 Plano, Texas 75093 Tel 972-312-8850

T.F. STONE COMPANIES INC.
T.F. STONE BUILDING
LOT 1, BLOCK A, ADDISON STORAGE ADDITION
CONSTRUCTION DETAILS
ADDISON, DALLAS COUNTY, TEXAS

DATE: 1/14/03

O.E. JOB NO. 138-02

SHEET NO. 7

OF 9 SHEETS