

CONSTRUCTION PLANS

FOR

16200 ADDISON ROAD OFFICE BUILDING

AN ADDITION TO

THE TOWN OF ADDISON, TEXAS

Index Of Drawings


- C-1 Cover Sheet
- C-2 Plat
- C-3 Demolition Plan
- C-4 Paving Plan
- C-5 Grading Plan
- C-6 Drainage Area Map
- C-7 Storm Sewer Plan
- C-8 Storm Sewer Profile
- C-9 Water / Sanitary Sewer Plan
- C-10 Erosion Control Plan
- C-11 Horizontal Control Plan

GENERAL NOTES

- A. Prior to final acceptance by the Town of Addison,
 1. A Texas Registered Professional Engineer shall certify that the project was constructed in accordance with the plans and specifications approved by the Town of Addison.
 2. The Owner shall provide one reproducible set of as-built (sealed and certified by a Texas Registered Engineer) and two blue line sets.
 3. A five foot (5') sidewalk shall be installed along the public streets. See attached detail.
 4. A one year 100% maintenance bond is required for the public infrastructure.
 5. Contractor shall demonstrate that the water and sanitary sewer systems meet the property pressure, bacteria, and mandrel tests. In addition, the Owner shall provide a VHS format video tape of the sanitary sewer.
- B. Prior to starting construction, the Contractor shall contact the utility companies to locate existing facilities. These include but may not be limited to the following:
 1. Town of Addison
 2. Lone Star Gas
 3. Southwestern Bell
 4. Storax Cable
 5. Planned Cable Systems
 6. T.U. Electric
- C. Prior to beginning construction, the Owner or his authorized representative shall convene a preconstruction conference among the Town of Addison, Consulting Engineers, Contractor(s), Utility companies and any other affected parties. Notify Brock Ellis (972) 450-2847 at least 48 hours prior to beginning of construction.
- D. Any existing pavement, curbs, and/or sidewalks damaged or removed will be repaired by the Contractor at their expense.
- E. Lot pins shall be installed after construction and prior to final acceptance. Concrete monuments shall be placed as shown on the final plat and iron pins shall be placed at block corners, curve points and angle points in public right-of-way. Concrete monuments shall be six inches (6") in diameter and twenty-four inches (24") long, an iron rod one-half inch (1/2") in diameter embedded at least three inches (3") in the monument at the exact intersection point of the monument. The monuments shall be set at such an elevation that after construction, the top of the monument will be not less than twelve inches (12") below the ground surface.
- F. The Contractor shall stomp a two inch (2") "S" and a two inch (2") "W" in the curb at the location of the sewer service and water service lines, respectively.
- G. At intersections that have valley drainage, the crown of the intersecting streets will culminate in a distance of 40 feet (40') from the intersecting curb line unless otherwise noted.
- H. Temporary or permanent street barricades shall remain at all points of ingress and egress to prevent public use until such street received final acceptance.
- I. Contractor shall obtain a right-of-way permit by the Town of Addison for working within the public right-of-way.
- J. During construction, the Owner shall provide a qualified geotechnical lab to perform materials testing during the construction at the request of the Town of Addison.
- K. The Contractor shall submit material sheets to the Town of Addison for approval prior to incorporating materials into the job.
- L. The utility contractor shall submit to the Town of Addison for approval a trench safety plan sealed by a Registered Professional Engineer for the installation of utilities greater than five feet (5') in depth.
- M. All existing and proposed improvements (valves, manholes, fire hydrants, water meters, etc.) shall be adjusted to finished grade by the Contractor.


Developer
Cole Partners, LTD.
4514 Cole Avenue, Suite 400
Dallas, Texas 75204
(214) 443-1900

Engineer
Brockette • Davis • Drake
4144 N. Central Expressway, Suite 1100
Dallas, Texas 75204
(214) 824-3647

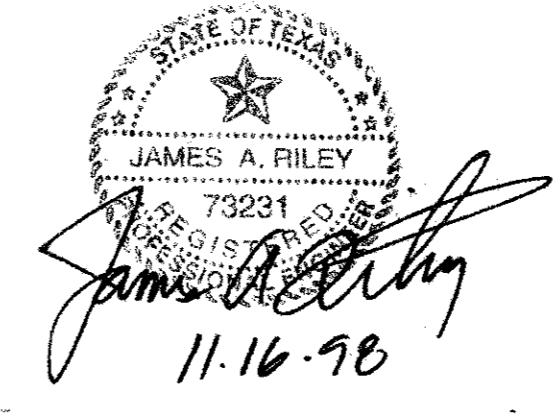
 JAMES A. RILEY
 11.16.98

AS-BUILT

NOTE:
 THESE PLANS HAVE BEEN REVISED
 TO CONFORM WITH CONSTRUCTION
 RECORDS PROVIDED BY CONTRACTOR.

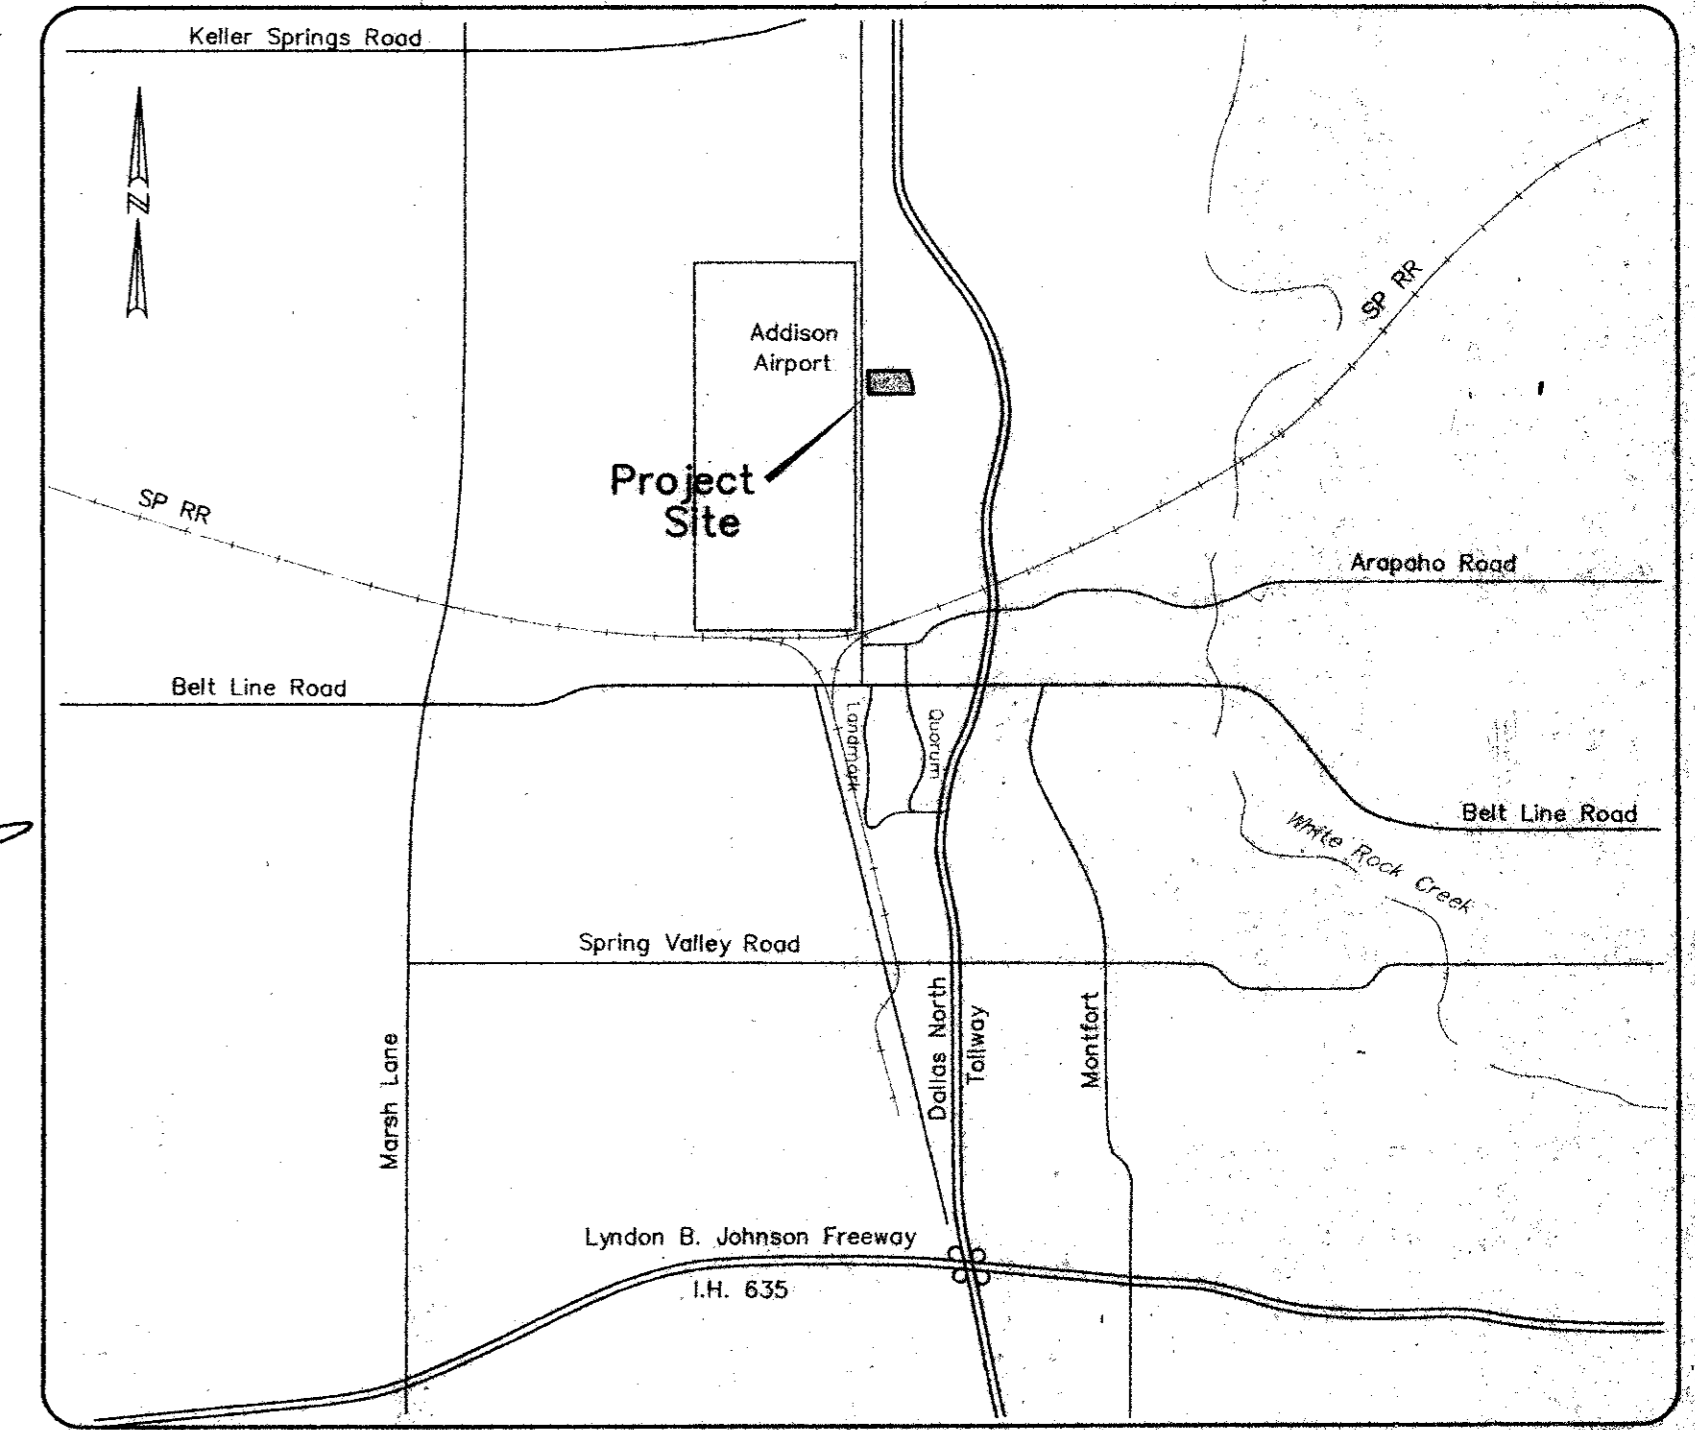

Location Map
nts