
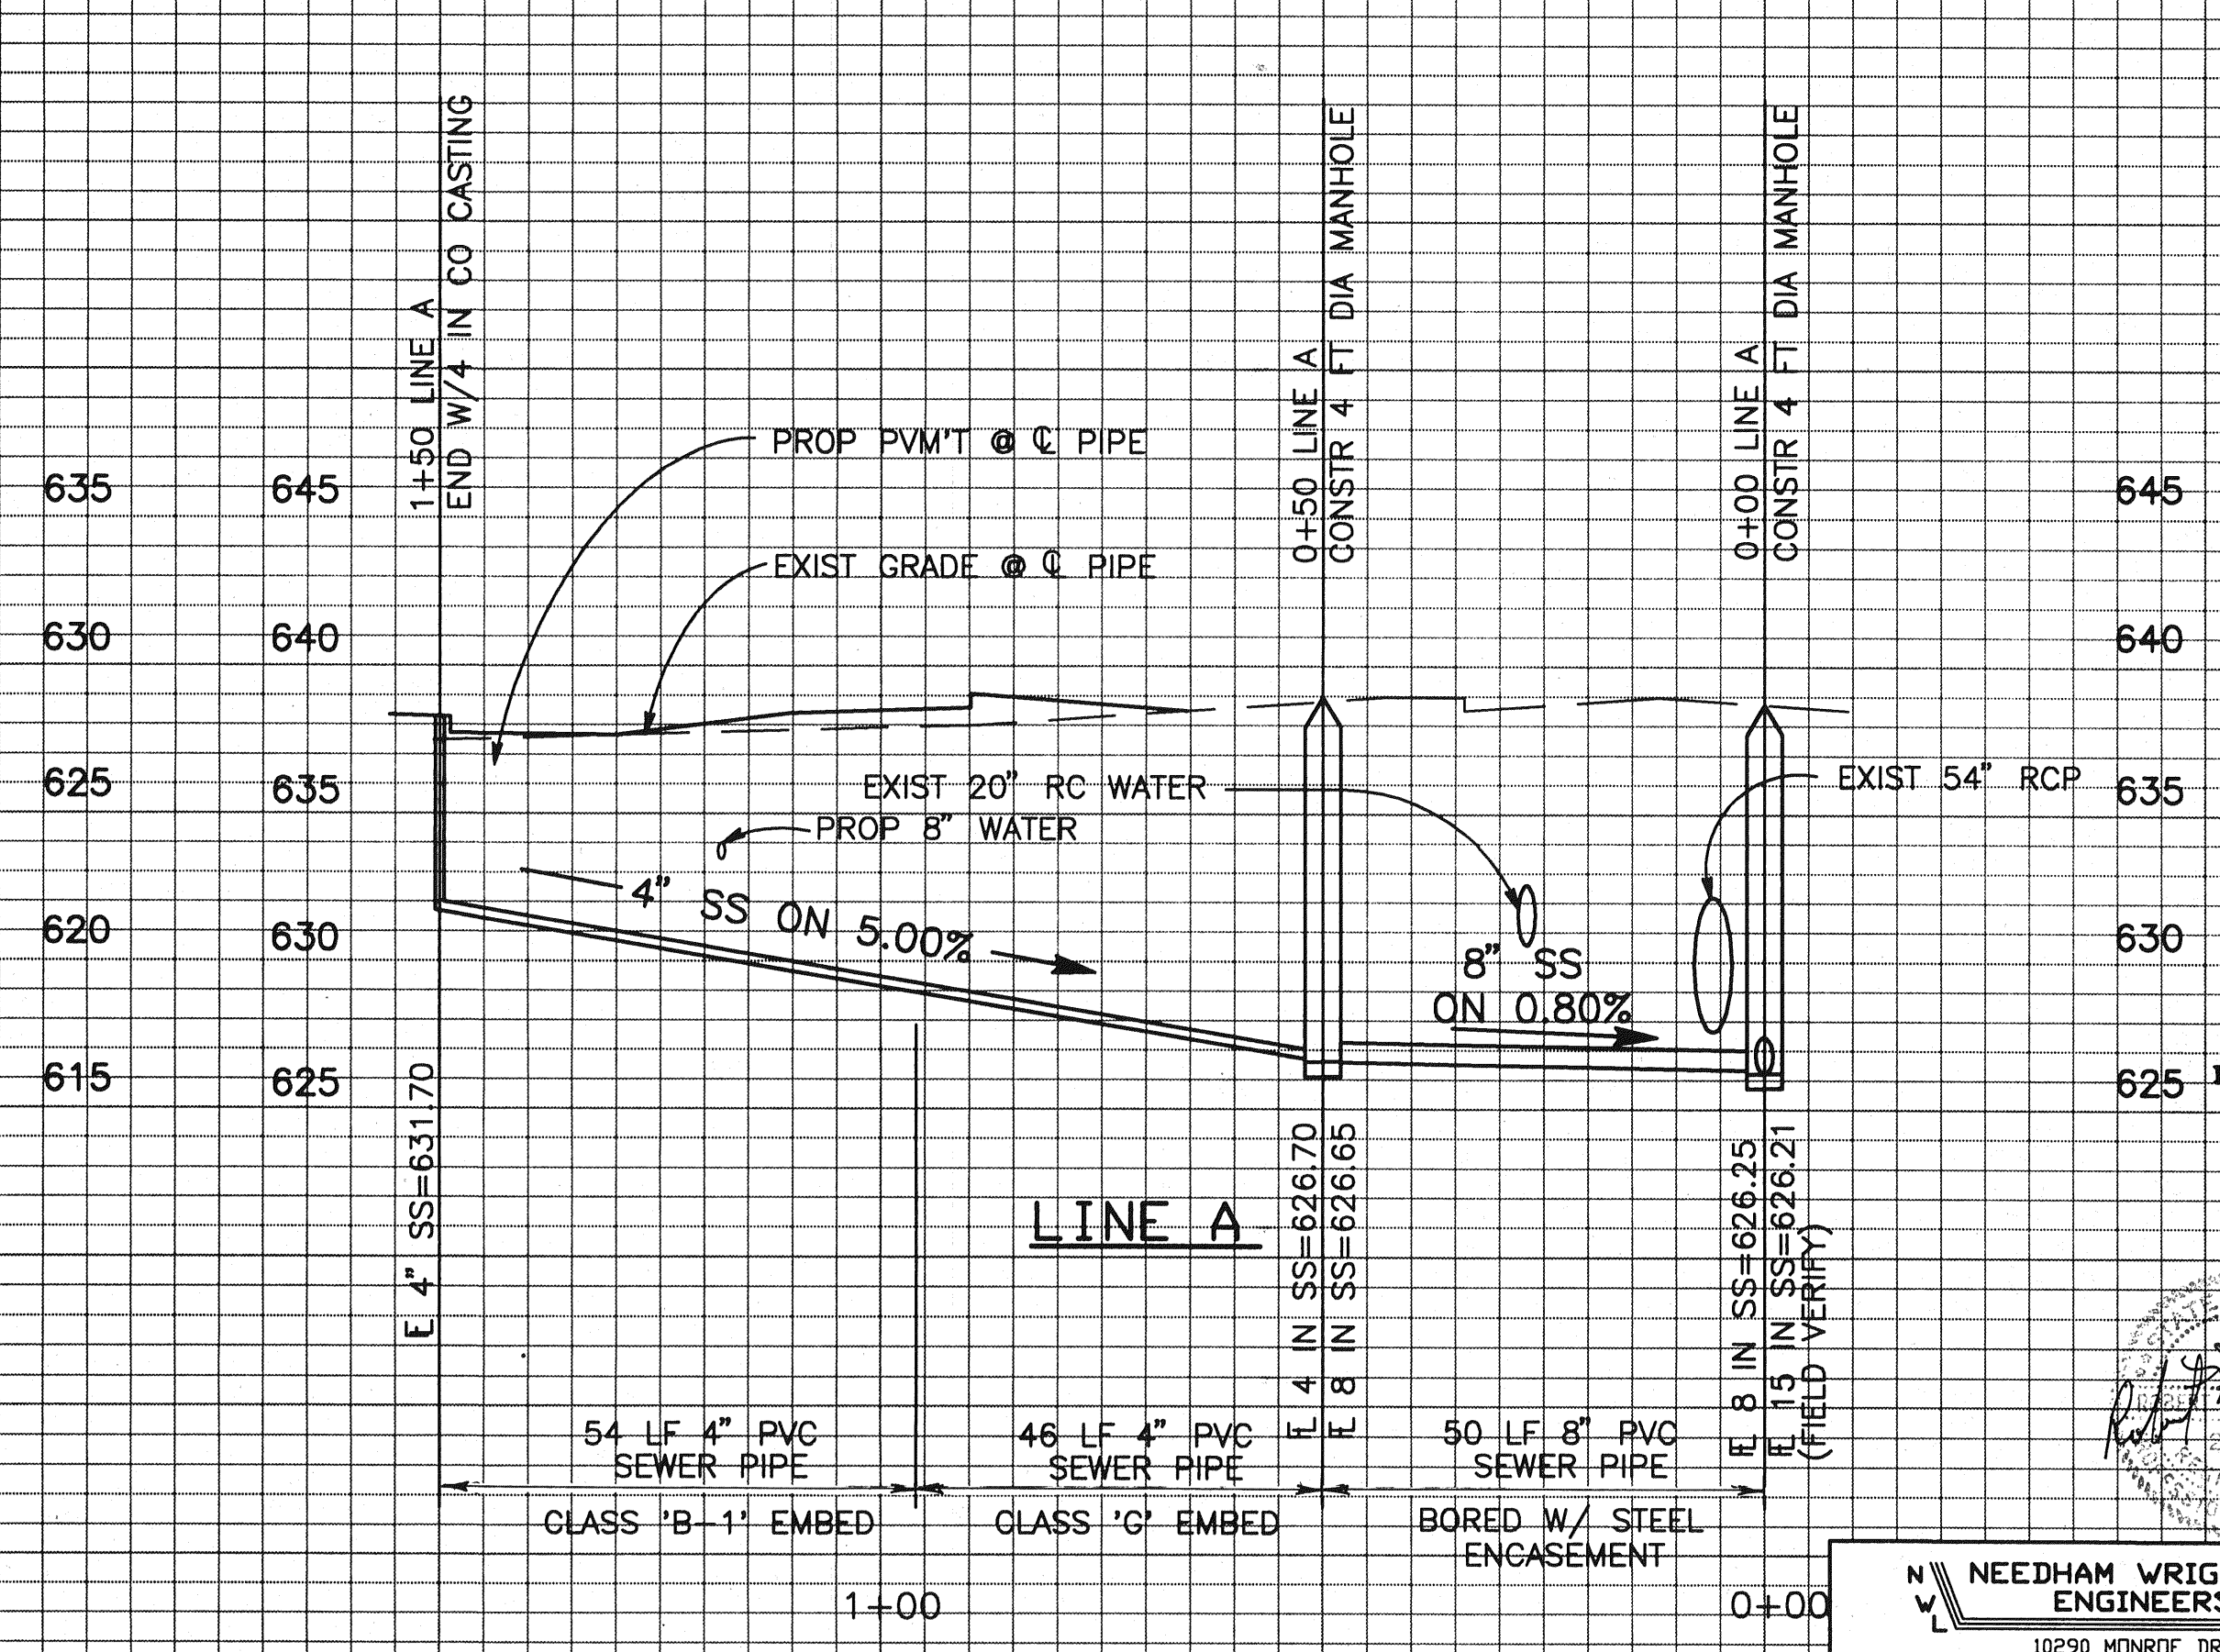


LINE C

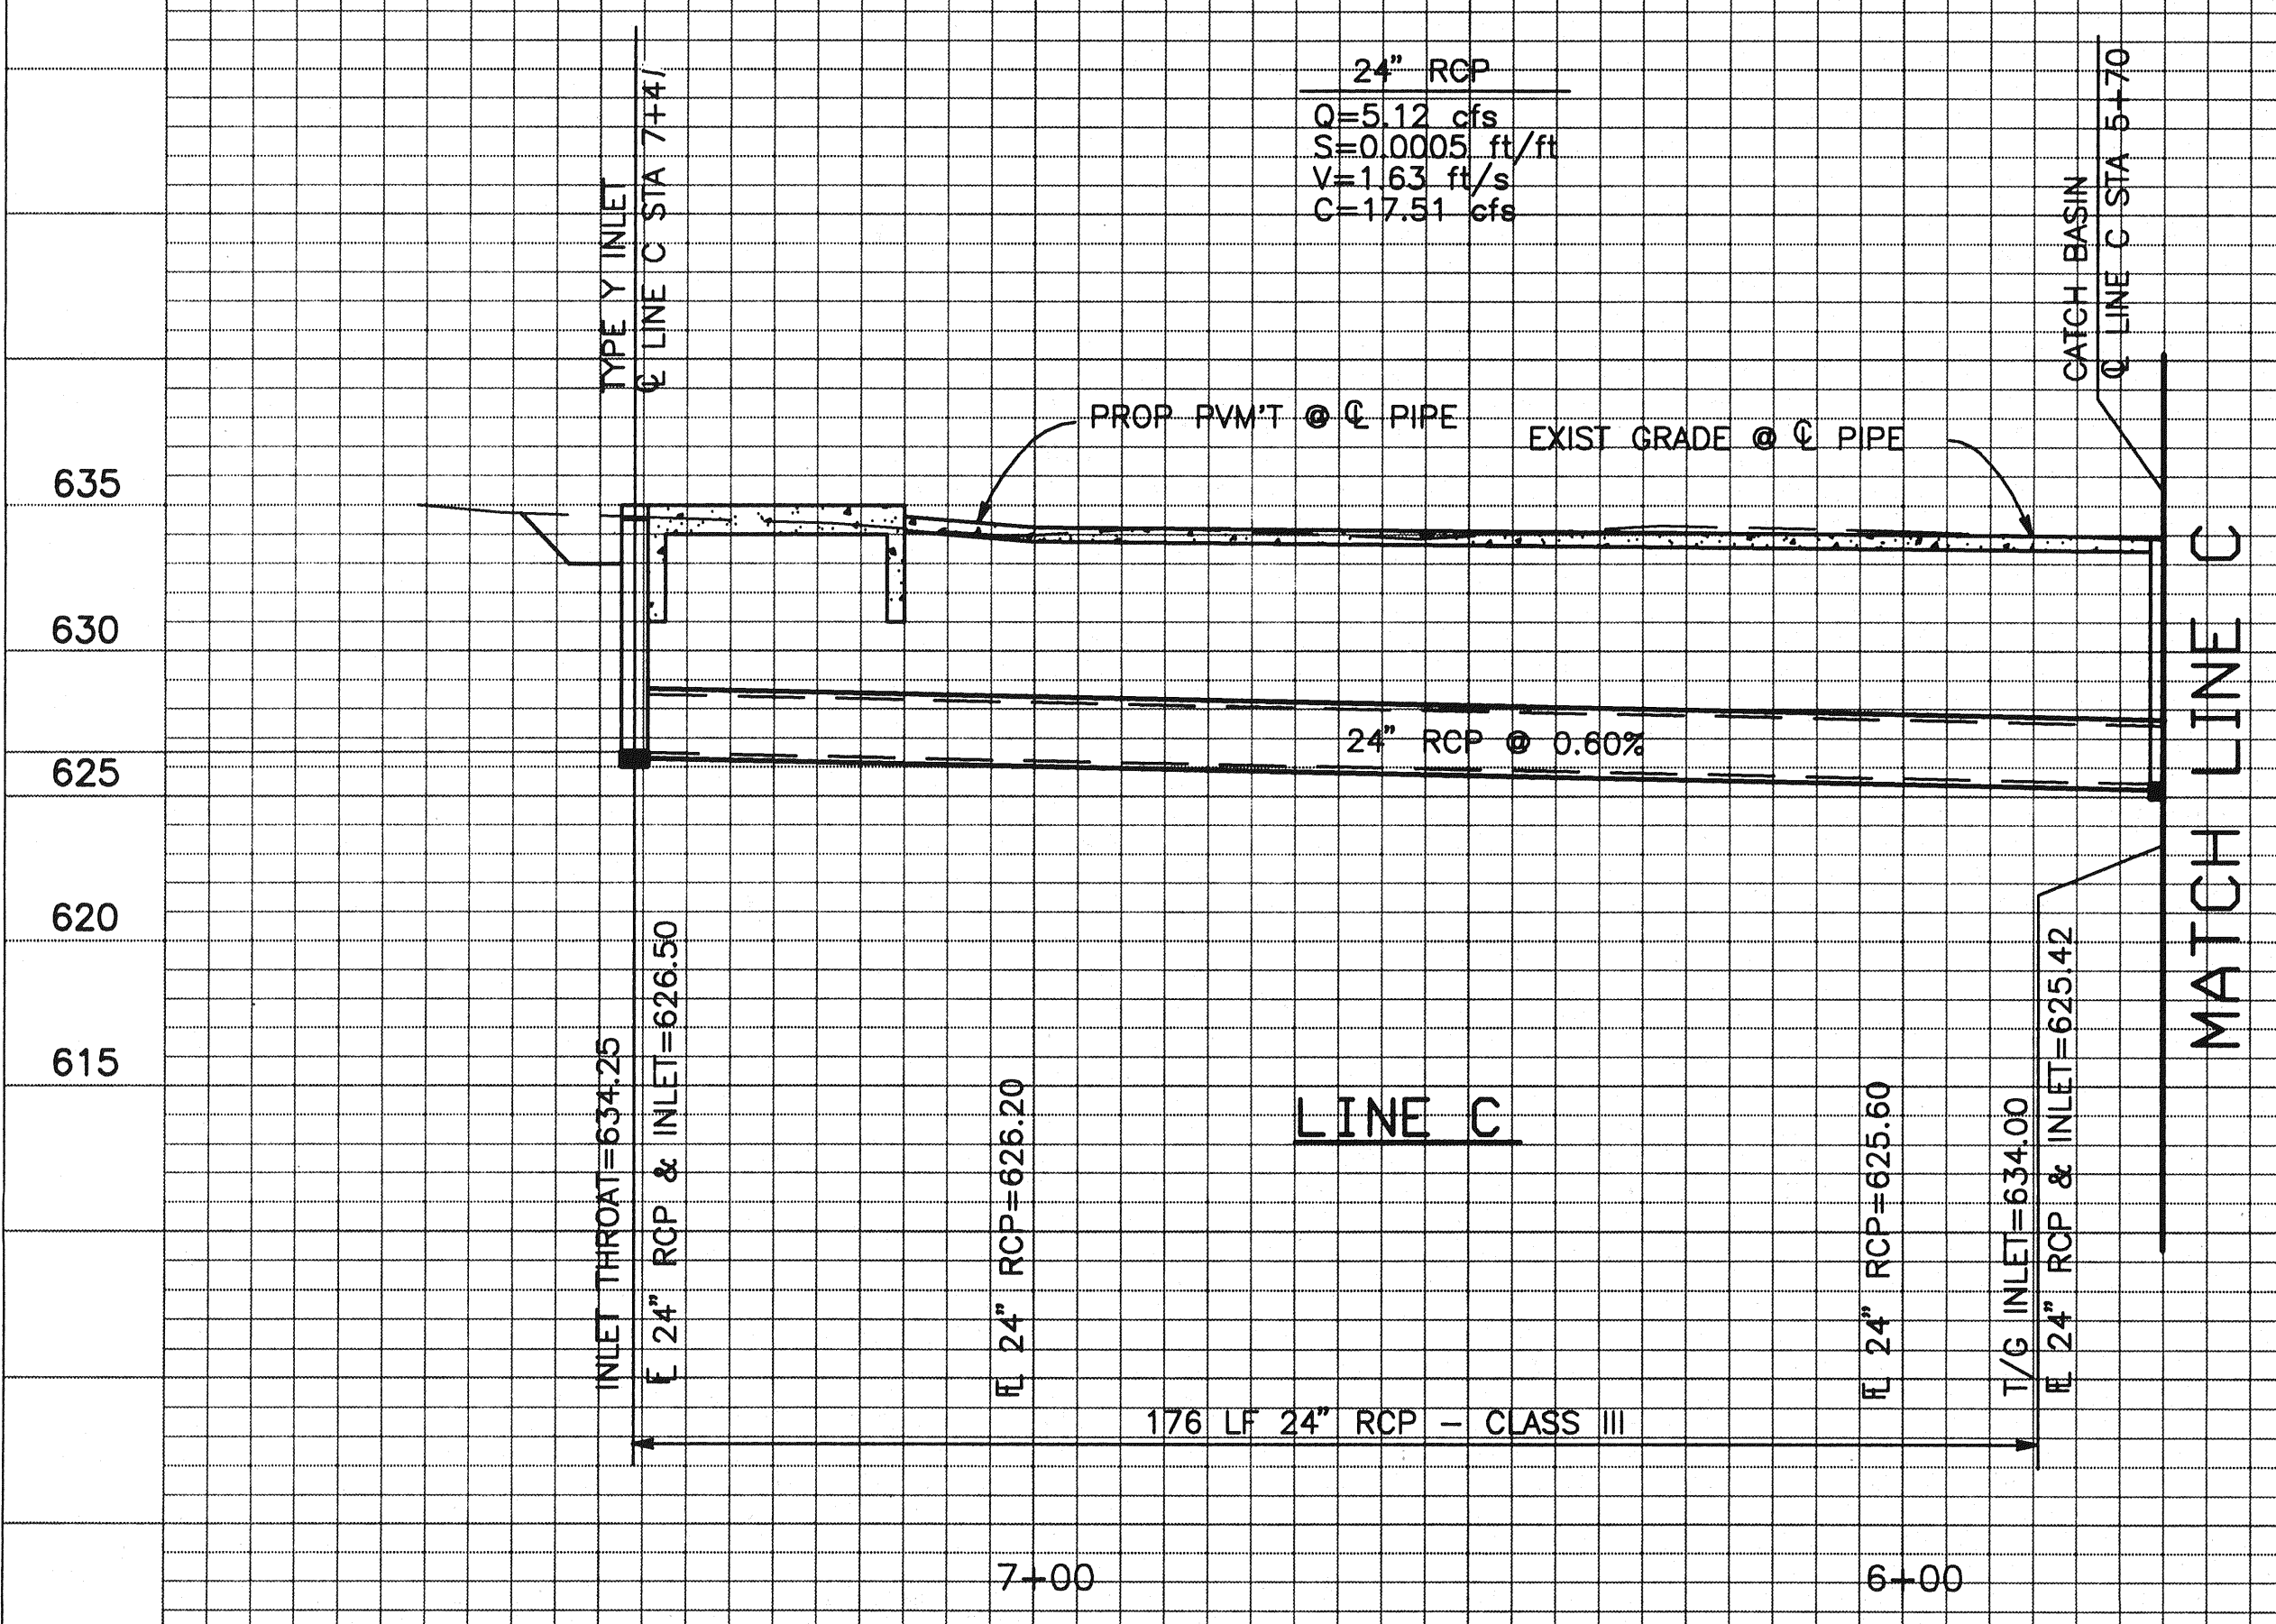

30" RCP
 Q=19.26 cfs
 S=0.0022 ft/ft
 V=3.92 ft/s
 C=31.75 cfs

24" RCP
 Q=5.12 cfs
 S=0.0005 ft/ft
 V=1.63 ft/s
 C=17.51 cfs

RECORD DRAWINGS
 REVISED TO REFLECT KNOWN CHANGES MADE DURING CONSTRUCTION. DATE: 7-15-95

NEEDHAM WRIGHT LASKEY ENGINEERS INC.
 10290 MONROE DRIVE
 SUITE 305
 DALLAS, TEXAS 75229
 PH. 214 357 2981

DRAINAGE & UTILITY PROFILES
 ADDISON ROAD SELF STORAGE
 ADDISON ROAD, ADDISON TEXAS
 ADDISON ROAD SELF STORAGE LIMITED PARTNERSHIP

DRAWN	DESIGN	DATE	SCALE	NOTES	FILE	SHEET
DMS	CSC	5/05/94	H 1"=20' V 1"=6'			C-4