



SOUTH ELEVATION SCALE: 1/8" = 1'-0"

1. RAIN RUNOFF FROM ROOF MUST NOT DRAIN TO ADJACENT PROPERTY. IT MUST TIE IN UNDERGROUND TO STORM DRAIN. PROVIDE ROOF GUTTERS AND DRAIN PIPES TO STORM DRAIN ~~OR AS SHOWN~~

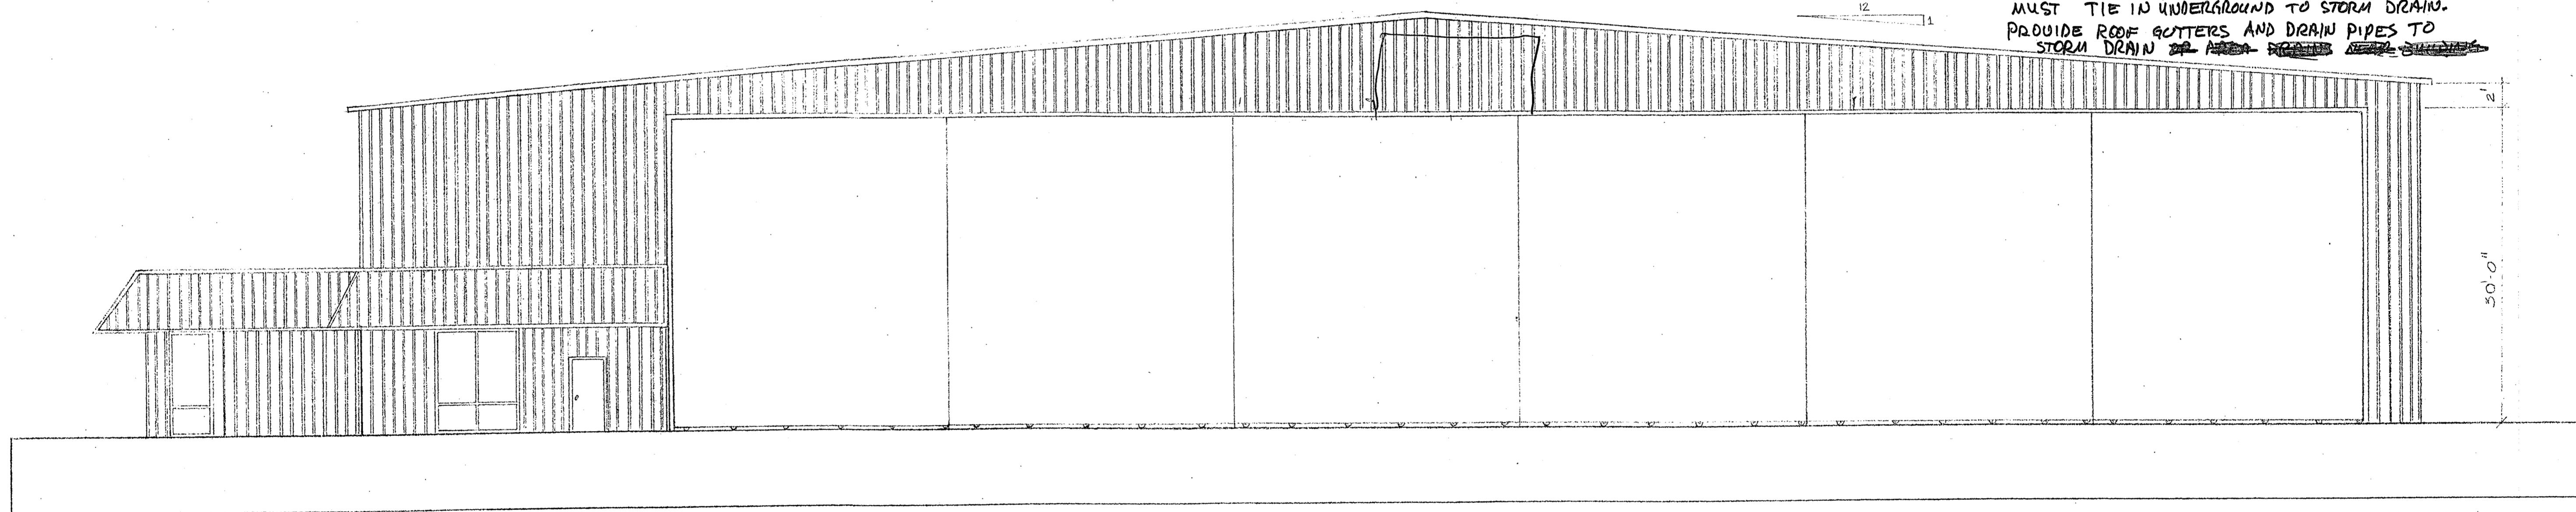

EAST ELEVATION SCALE: 1/8" = 1'-0"

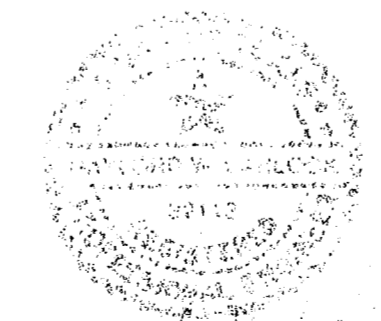

		WFC W. F. CARTER CONSTRUCTION, INC. GENERAL CONTRACTORS 5809 East Berry • Fort Worth, Texas 76119 • 817 / 451-0410 • (Metro) 265-3251	
DRAWN BY +N	CHECKED BY	ENGINEER	CUSTOMER (BUILDER) DON CARTER HANGER LOCATION DALLAS, TEXAS JOB NUMBER
REV ▲ ▲ ▲	DATE	DESCRIPTION	BY ISSUE DATE SEP 11 ISSUE DRAWING NO. A-1