



STRUCTURAL DRAWINGS
 REVD WITH ENG
 SEAL

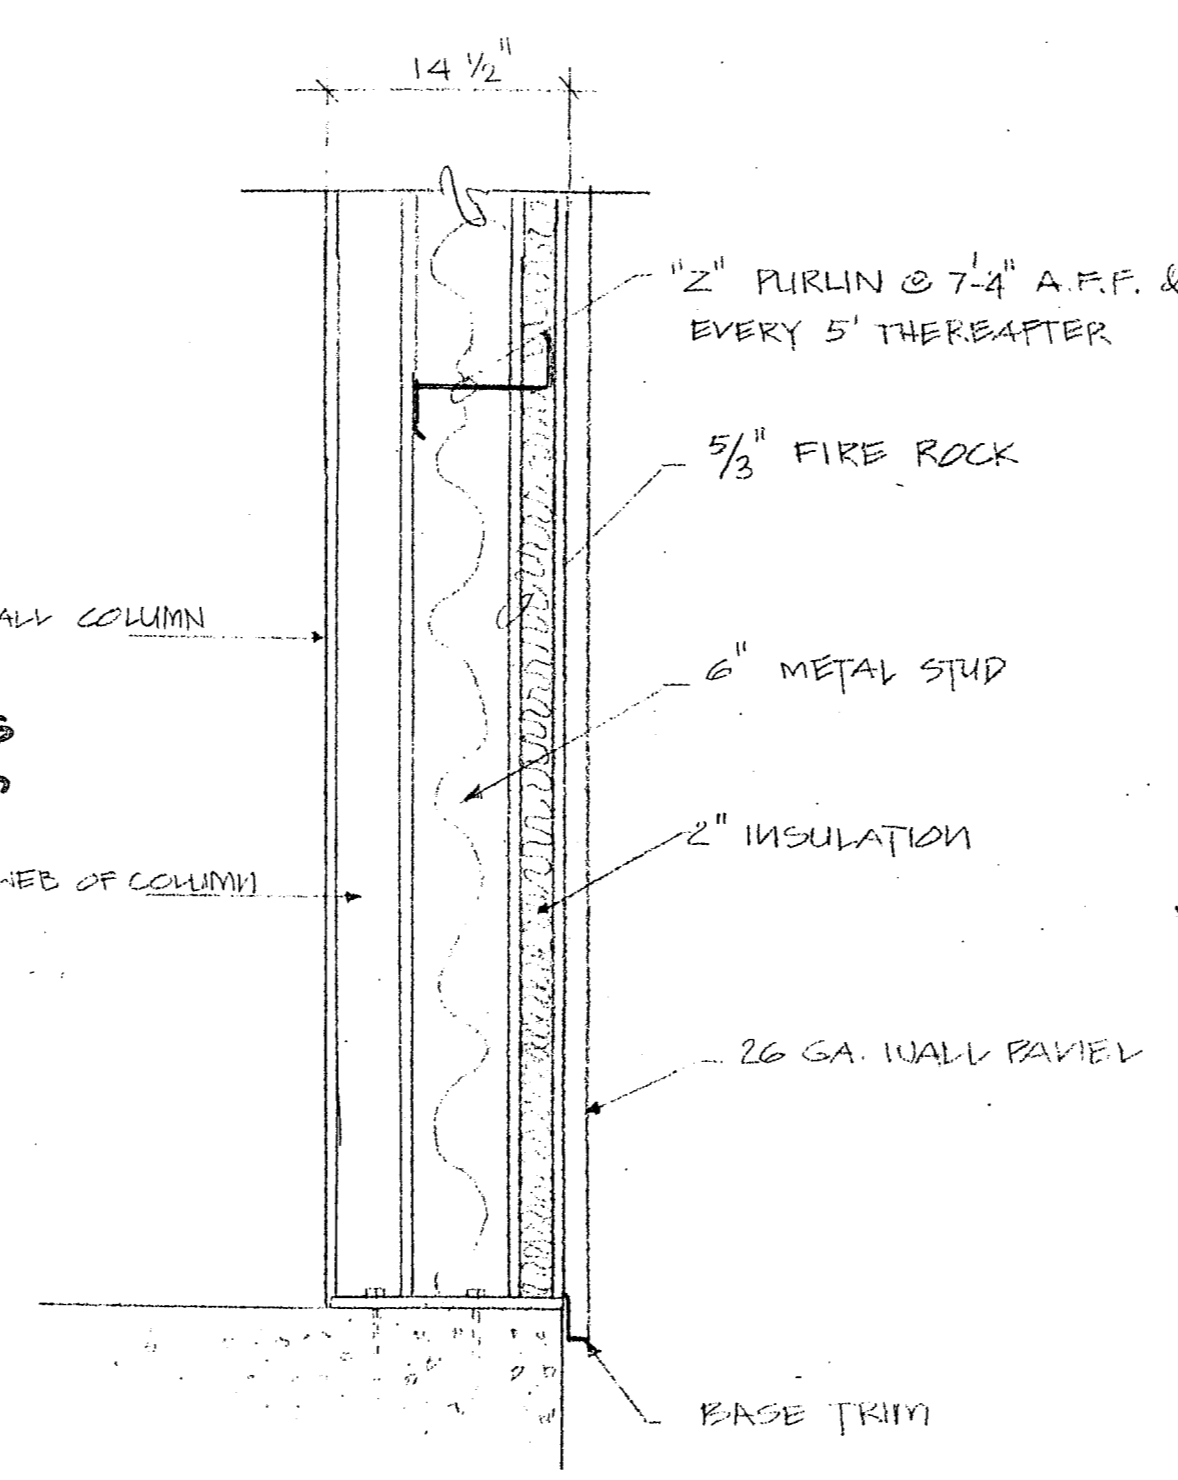

ONE-HOUR FIRE WALL SCALE 1"=1'-0"

ALL STRUCTURAL ELEMENTS LOCATED IN REVD
 FIRE WALL MUST HAVE FIRE PROTECTION ALSO

1 WALL DETAIL SCALE: 1"=1'-0"

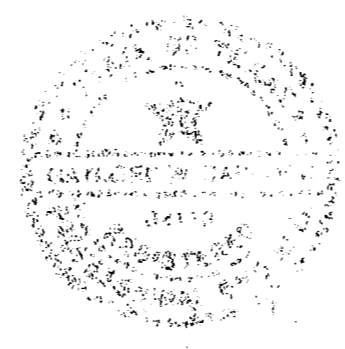

		WFC W. F. CARTER CONSTRUCTION, INC. GENERAL CONTRACTORS 5809 East Berry • Fort Worth, Texas 76119 • 817 / 451-0410 • (Metro) 265-3251	
		REV DATE DESCRIPTION BY	CUSTOMER (BUILDER) DON CARTER HANGER
DRAWN BY TM	CHECKED BY	LOCATION DALLAS TEXAS	DRAWING NO. C-2
ENGINEER	JOB NUMBER	DETAILS	