

1. SEE ATTACHED DRAWING FOR HAZARDOUS AREA LOCATIONS.


2. NO WELDING ALLOWED IN HAUGAR - BUILD IS BS TYPE II N.

3. OUTLETS IN OFFICE AREA MUST BE 15" MIN ABOVE FLOOR.

4. 2ND EXIT RECD


190

WEST WALL RECD TO BE 1HR COLLISION IN WEST WALL MUST HAVE 1HR PROTECTON ALSO.

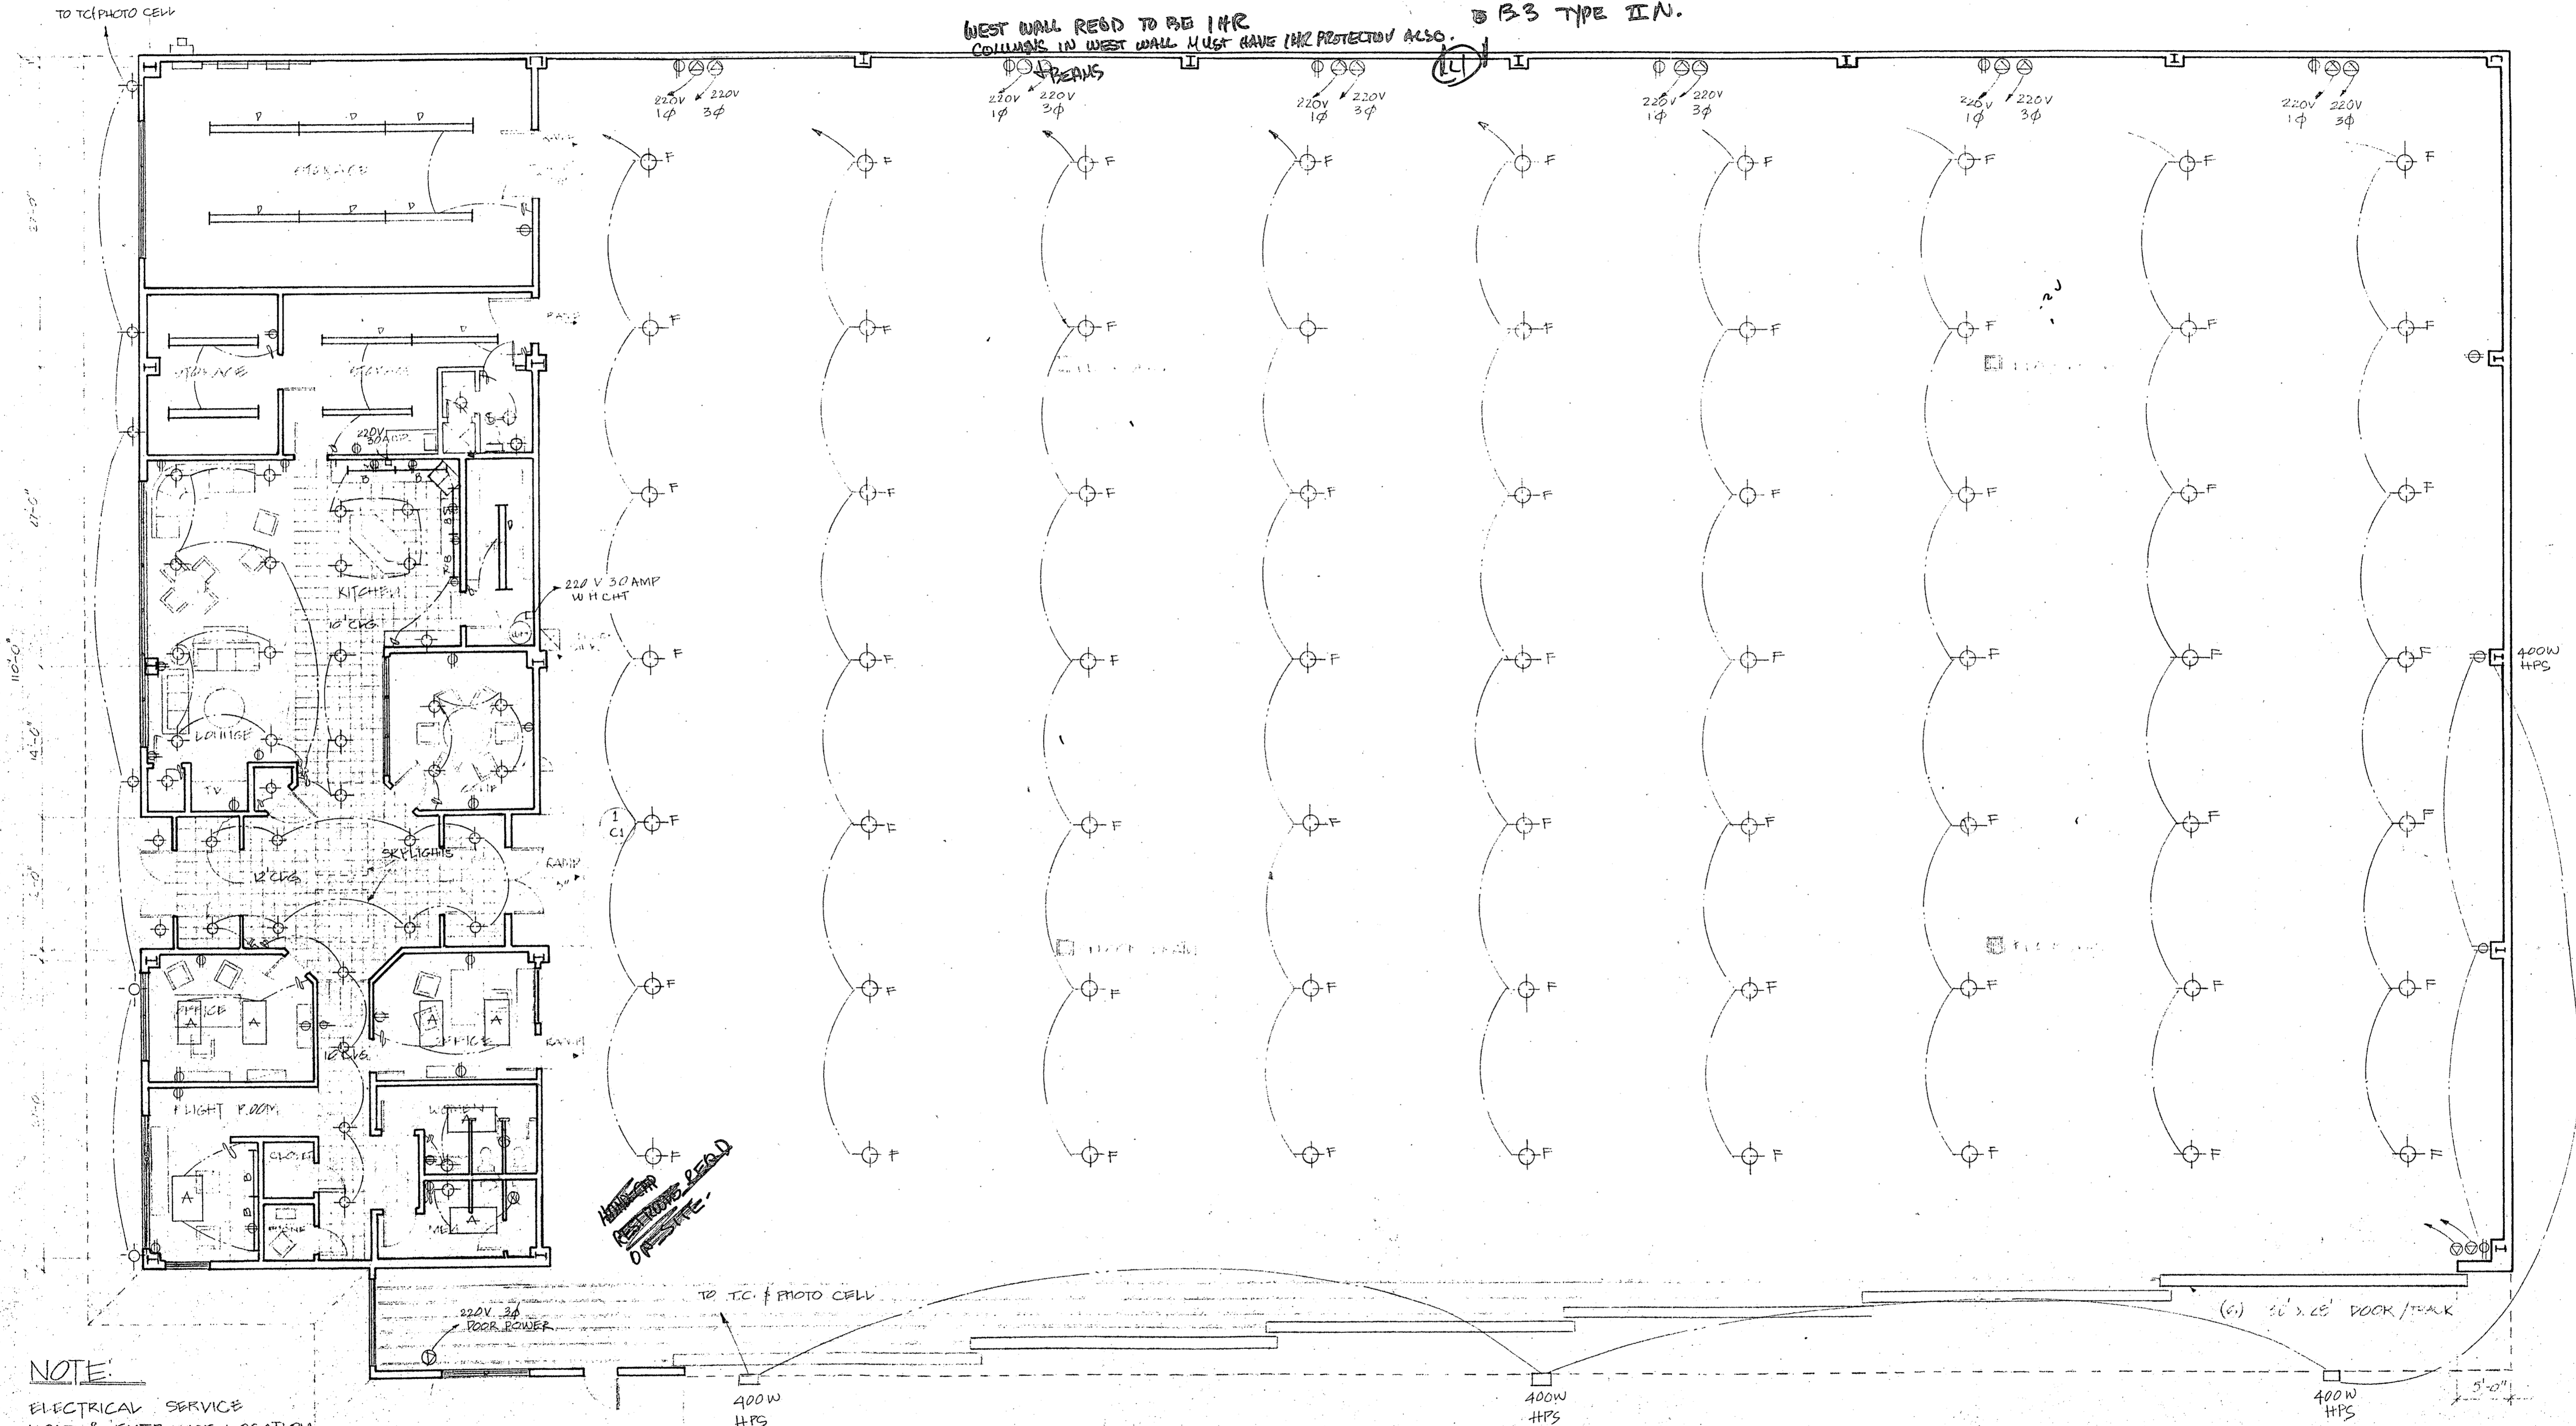

NOTE:
ELECTRICAL SERVICE LOAD & ENTRANCE LOCATION TO BE SUPPLIED BY ELECTRICAL CONTRACTOR AS AUTHORIZED BY THE OWNER.

ELECTRICAL PLAN SCALE: 1/8" = 1'-0" N

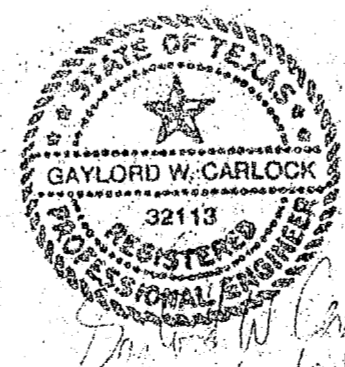

		WFC W. F. CARTER CONSTRUCTION, INC. GENERAL CONTRACTORS 5809 East Berry • Fort Worth, Texas 76119 • 817/451-0410 • (Metro) 265-3251	
DRAWN BY TM	CHECKED BY	ENGINEER	CUSTOMER (BUILDER) DAN CARTER HAUSER LOCATION DALLAS, TEXAS JOB NUMBER
REV. DATE △ △ △	DESCRIPTION	BY	ISSUE DATE 9/21/91 ISSUE DRAWING NO. E-1