


1 —— Ring

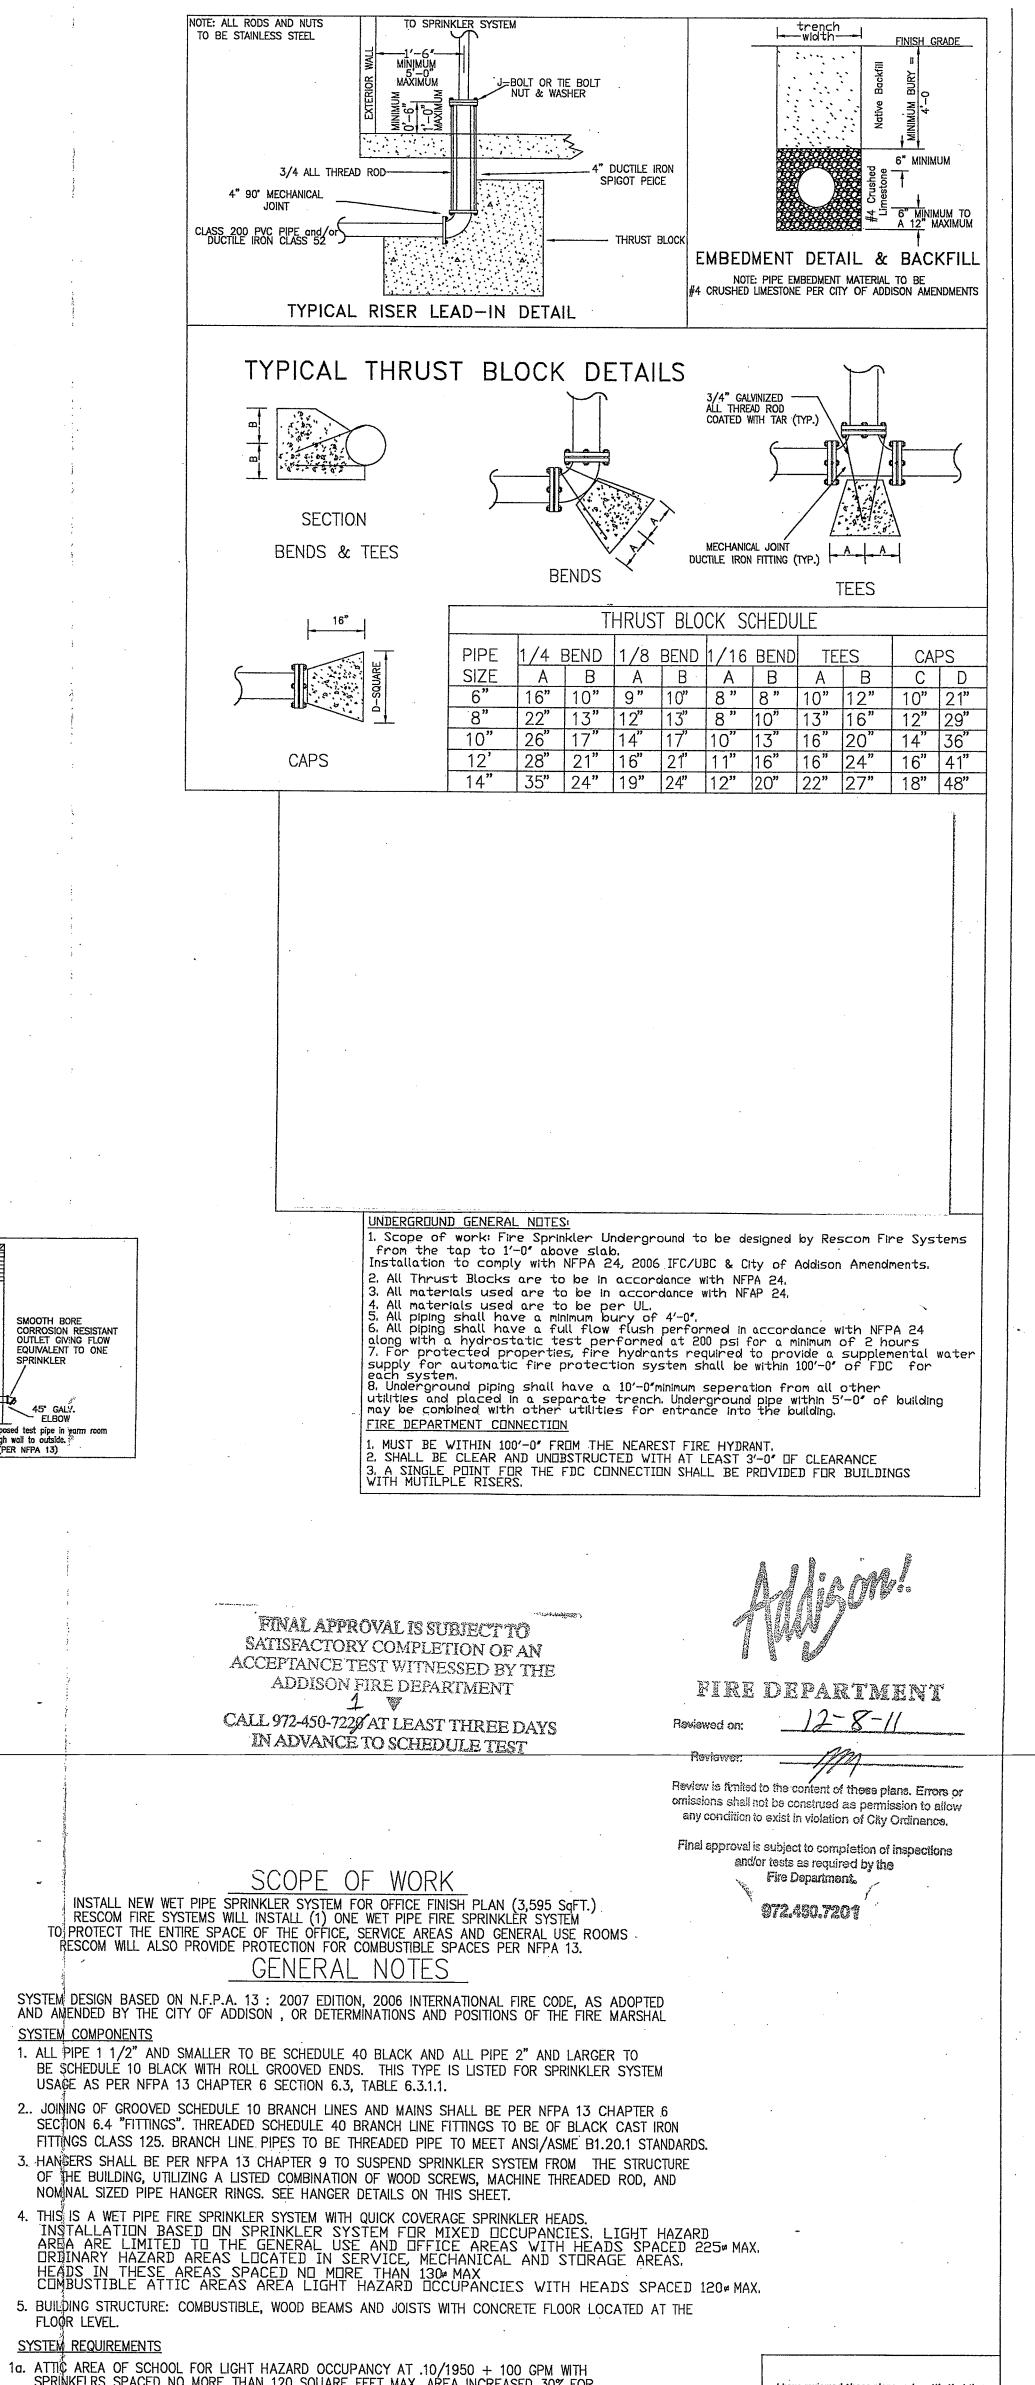

Rescom Fire Systems, Inc. P.O. Box 630886 Irving, Texas 75063 PH: (214) 350-1755 12/05/2011 Im Jackson Custom Homes See Drawing
Job No: 16400 Addison Road Addison, Texas Drawn By: 85 SHEET TITLE:

TOTAL SPRINKLERS REQUIRED ON THIS SHEET:

TOTAL SPRINKLERS REQUIRED ON THIS CONTRACT: 85 Office FO Fire Protection Plan FP-1 of 1

comply with the adopted NFPA standards

P.O. Box 630886

☐ AS-BUILT SUBMITTAL OTHER

Irving, Texas 75063
Ph: 2/4-350-1175
3CR #03/4
RME-Signature:
Printed RME Name:
Rapidy J. Scott

Rescom Fire Systems, Inc.