


REVISIONS	BY

DUVAL & ASSOCIATES
CONSULTING & CONSTRUCTION
COMPANY
SACHSE, TEXAS

WATER & SANITARY SEWER
AS-BUILT DRAWING

ADDISON CENTER
16415 ADDISON RD.
ADDISON, TEXAS

DATE	SCALE	JOB NO.	SHEET
5/14/1987	1" = 40'		

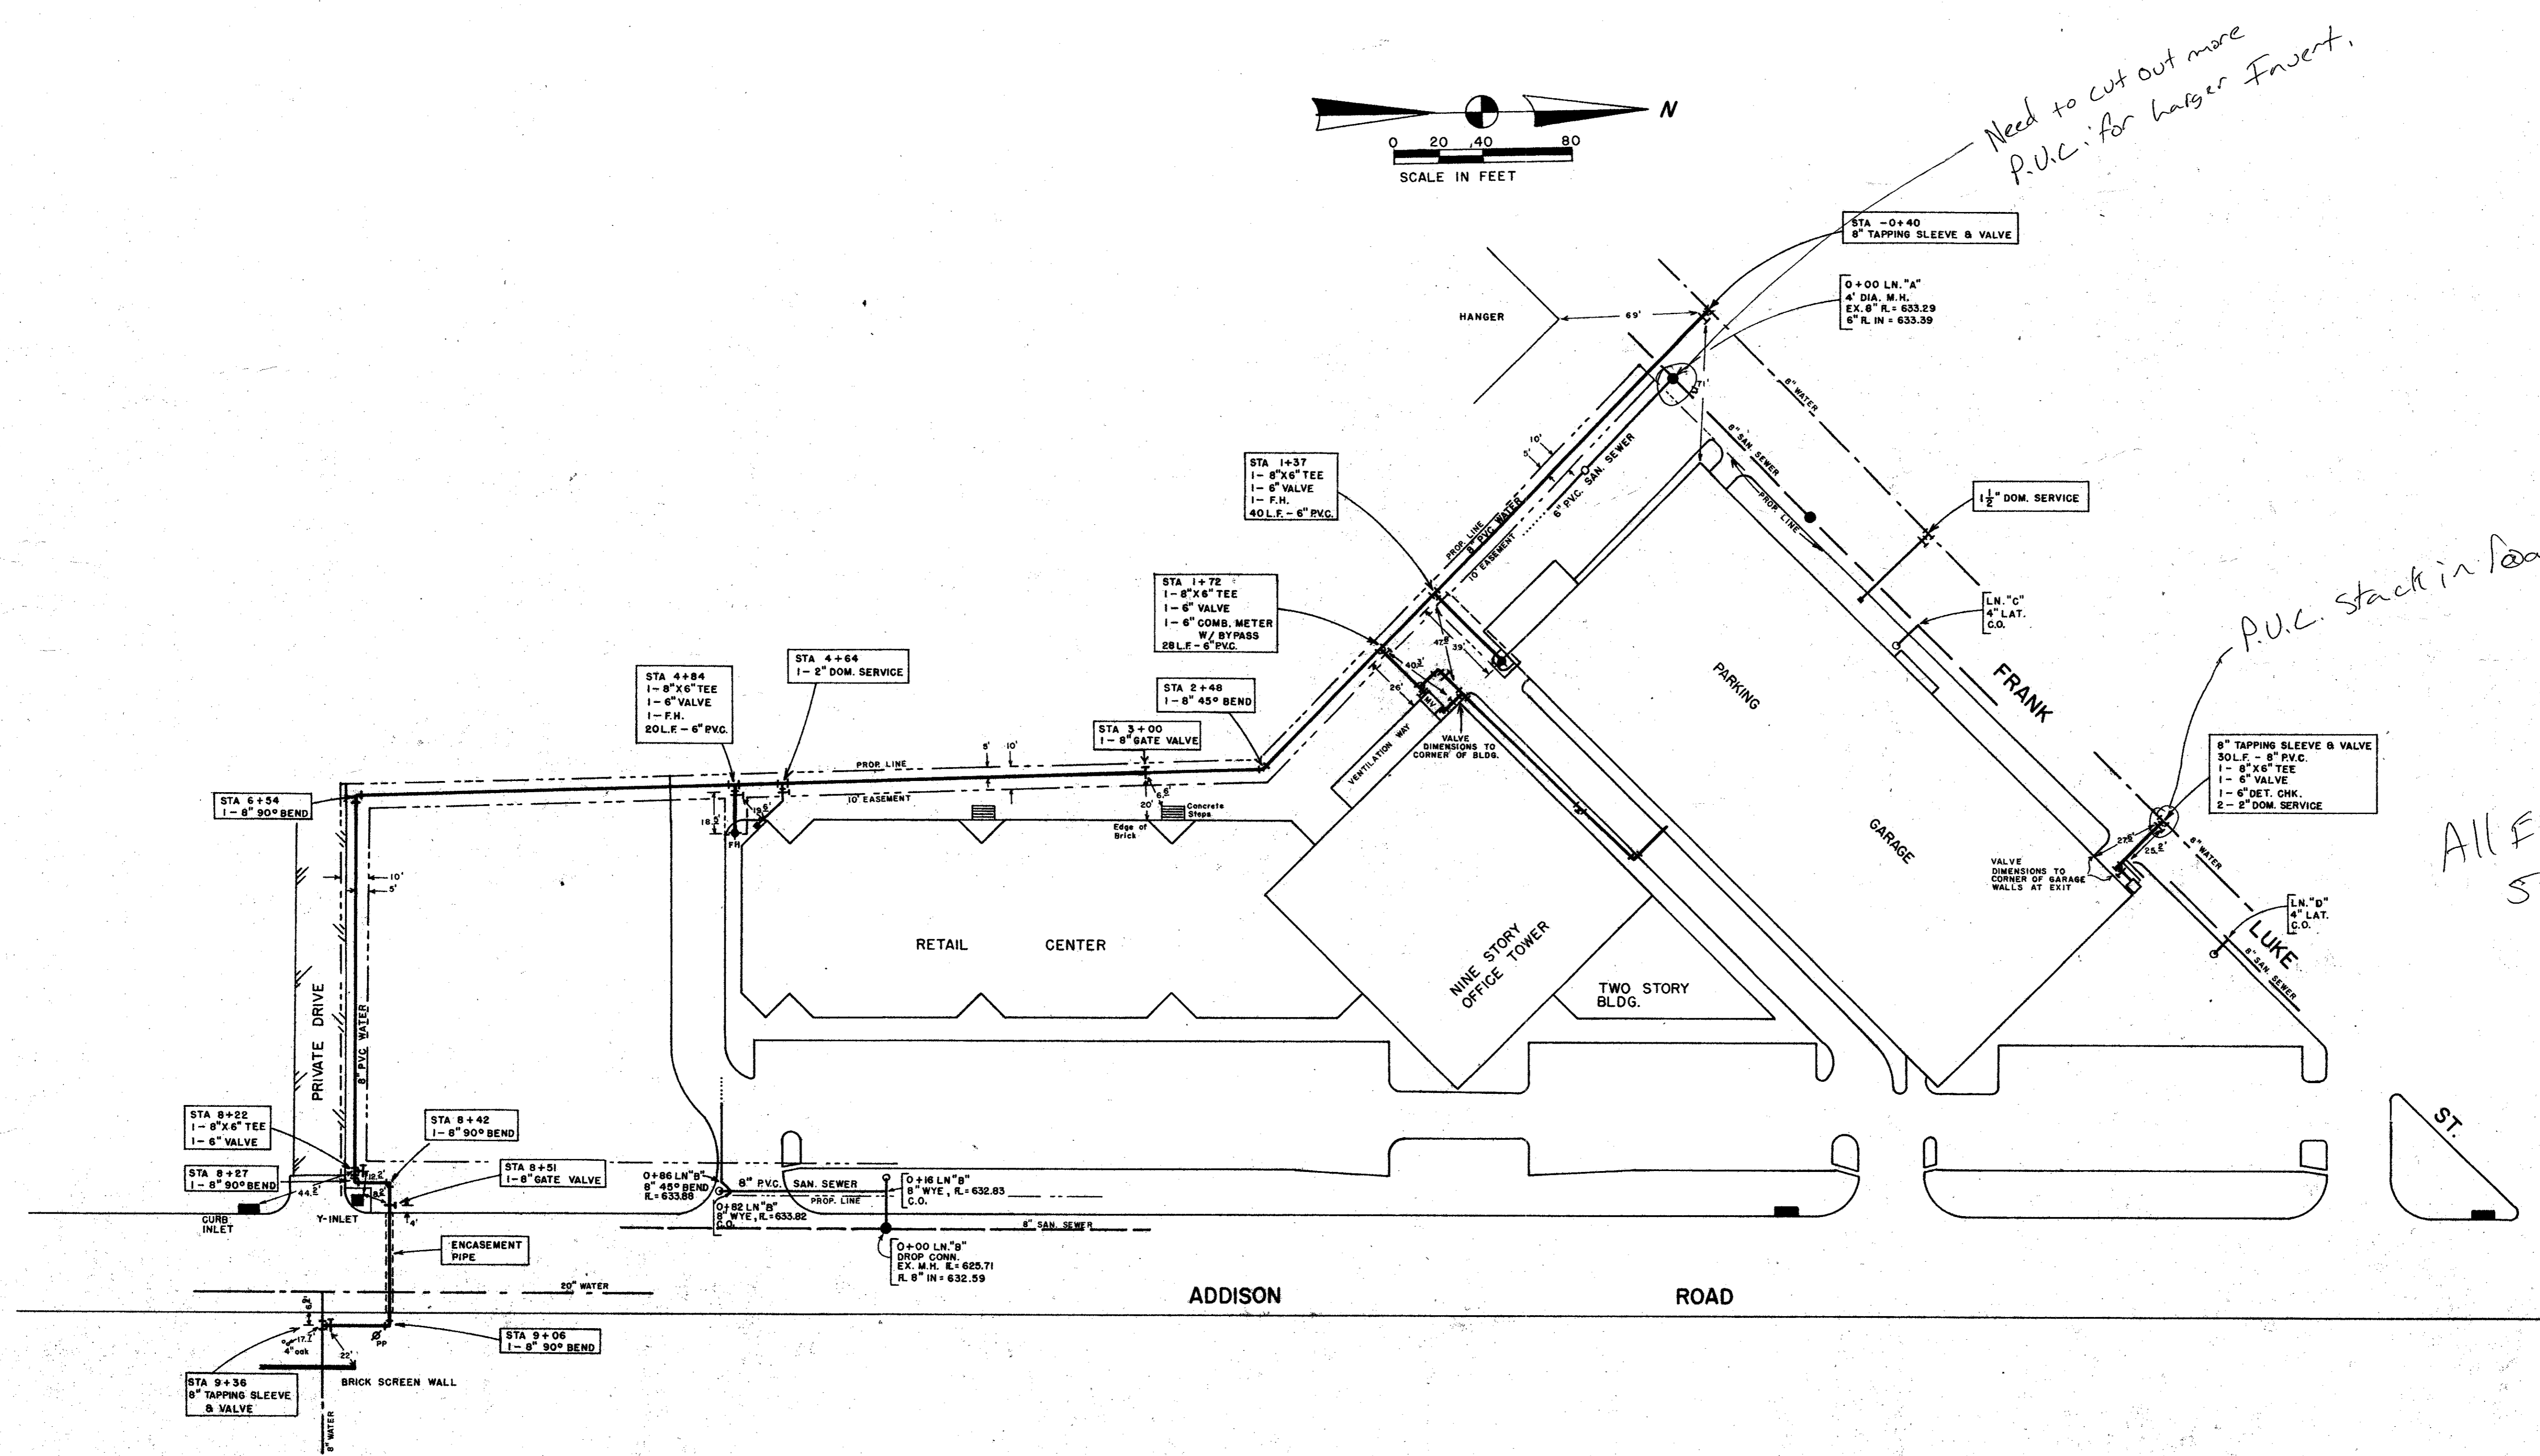

TELETYPE UNIT TRACKING PAPER, NO. 186A-24238-001