


USER: hpxton JOB: hpxton PLOTTED Thu Mar 09 13:48:28 2006
 LOCAL: \\p1183-01-33-41-46-48-53-53 LOCAL: \\p1183-01-33-41-46-48-53-53
 SCALE: 20.000000 TBL: \\p1183-01-33-41-46-48-53-53
 ROT: 90.000000 PRE: \\vadm-s232-s1000-13320000-3320000-3320000-3320000
 PLOT: \\p1183-01-33-41-46-48-53-53
 USER: hpxton JOB: hpxton PLOTTED Thu Mar 09 13:48:28 2006
 LOCAL: \\p1183-01-33-41-46-48-53-53 LOCAL: \\p1183-01-33-41-46-48-53-53
 SCALE: 20.000000 TBL: \\p1183-01-33-41-46-48-53-53
 ROT: 90.000000 PRE: \\vadm-s232-s1000-13320000-3320000-3320000-3320000
 PLOT: \\p1183-01-33-41-46-48-53-53
 USER: hpxton JOB: hpxton PLOTTED Thu Mar 09 13:48:28 2006

B19-15
 16426 Addison Rd. ADDISON OFFICE CONDOS
 CONSTRUCTION PLANS

CONSTRUCTION PLANS
 FOR
 PAVING, DRAINAGE & UTILITIES
ADDISON OFFICE CONDOS
 TOWN OF ADDISON, DALLAS COUNTY, TEXAS
MARCH 2006

✓ P & C UTILS 08/24/05

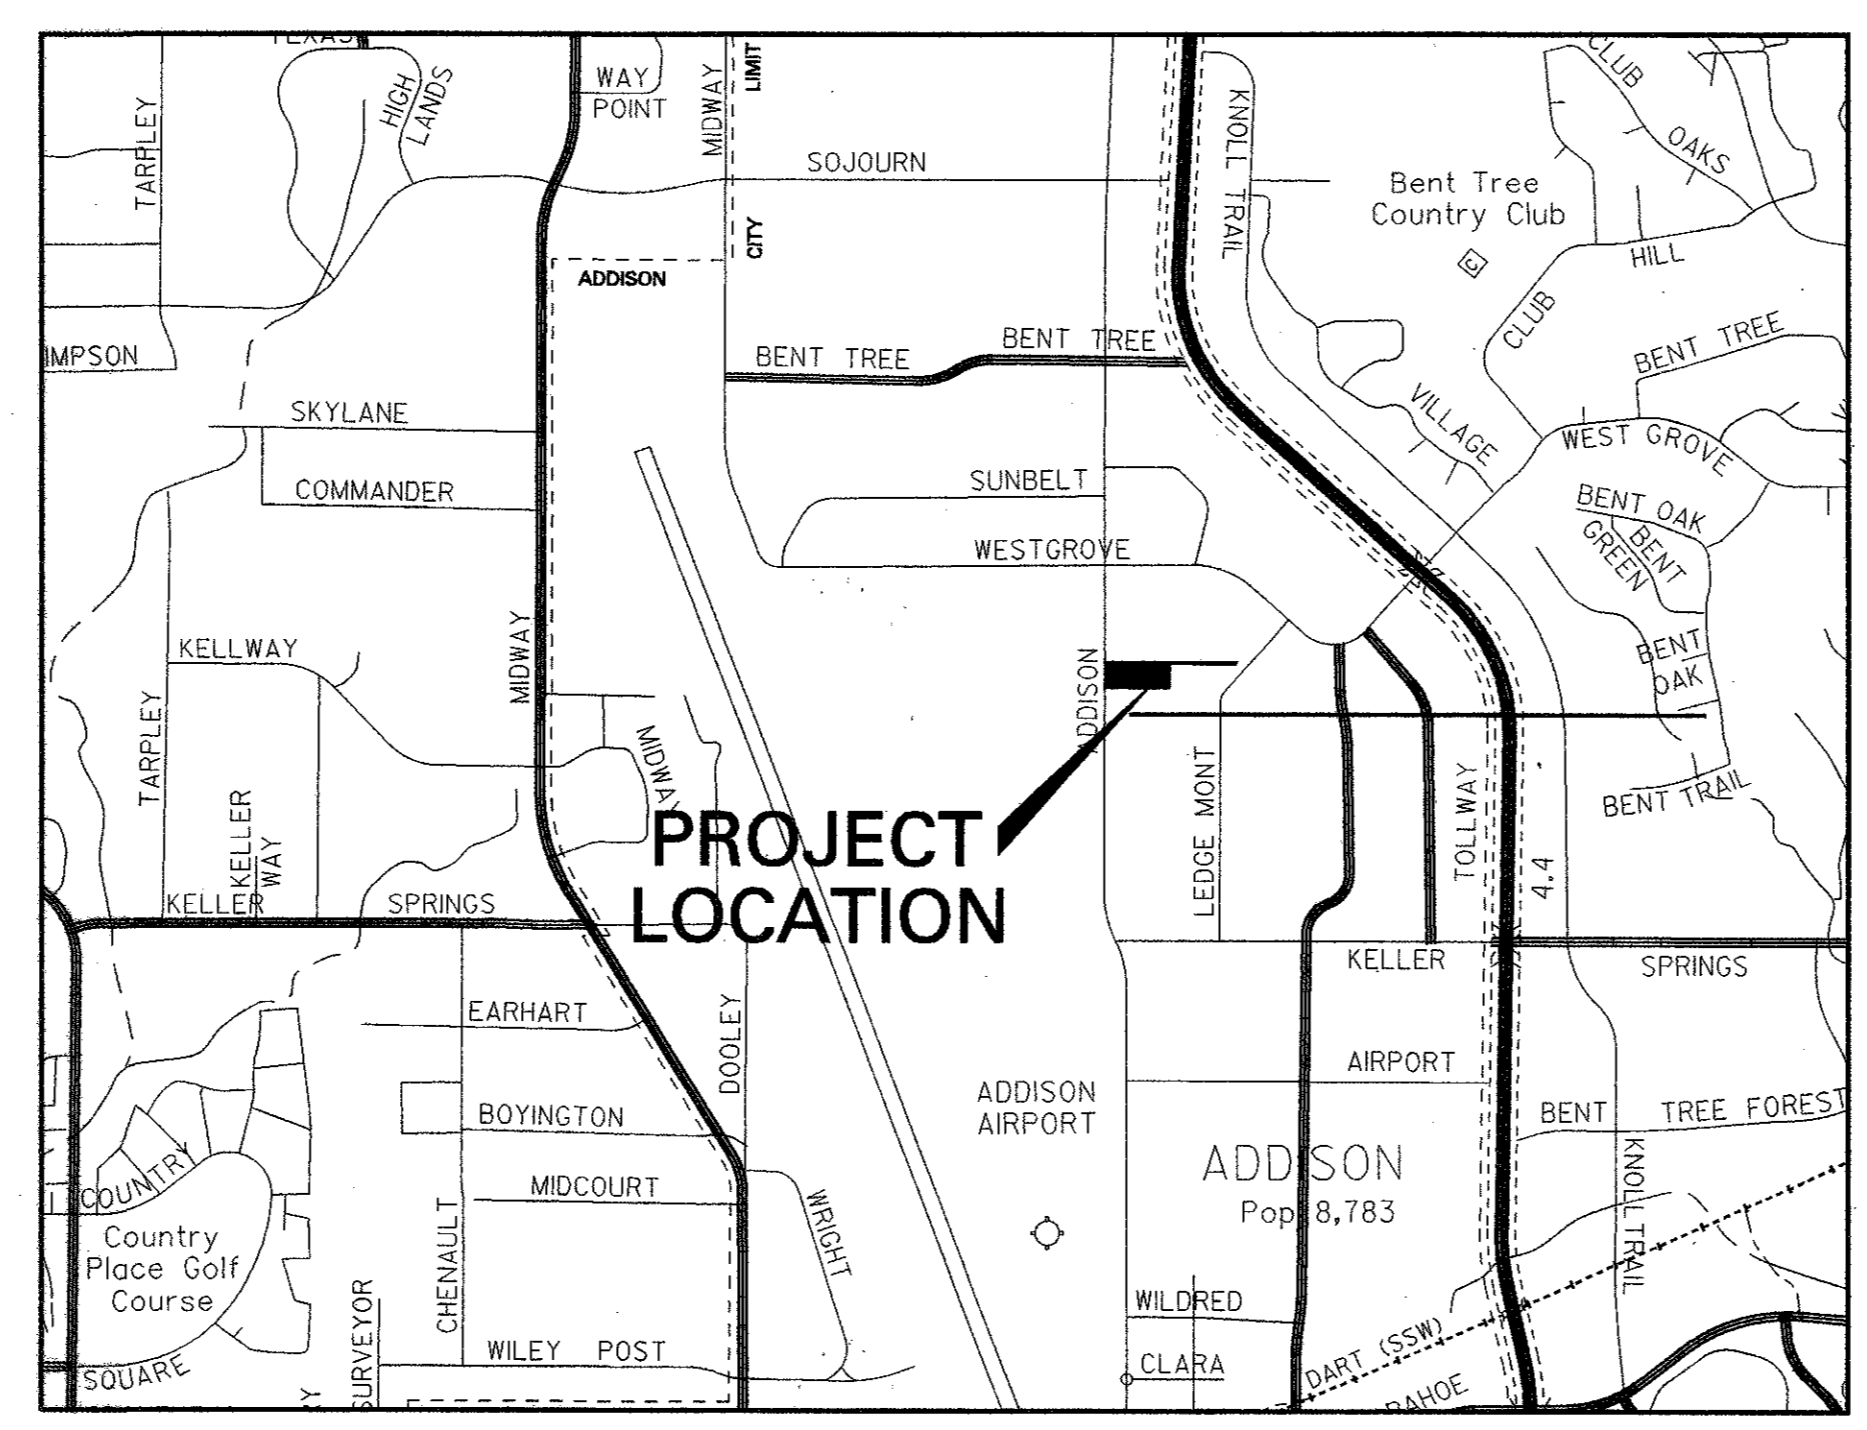

VICINITY MAP
 NTS


SHEET INDEX

- 1 COVER SHEET
- 2 FINAL PLAT
- 3 GENERAL NOTES
- 4 DIMENSION CONTROL PLAN
- 5 GRADING PLAN
- 6 PAVING PLAN & PROFILE - SHARED DRIVE A & SHARED DRIVE B
- 7 PAVING PLAN & PROFILE - SHARED DRIVE C, SHARED DRIVE D & SHARED DRIVE E
- 8 DRAINAGE AREA MAP
- 9 STORM DRAIN PLAN & PROFILE - SD-1 & SD-2
- 10 DETENTION GRADING & INLET DETAIL
- 11 WATER LAYOUT
- 12 SANITARY SEWER PLAN & PROFILE
- 13 TRAFFIC CONTROL
- 14 EROSION CONTROL
- 15 HORIZONTAL INLET - TYPE 'H' DETAIL
- 16 DRAINAGE CALCULATIONS
- 17 PAVING DETAILS

RECORD DRAWING

THIS DRAWING HAS BEEN MODIFIED TO REFLECT CONSTRUCTION RECORDS PROVIDED TO THE ENGINEER

ENGINEER: _____

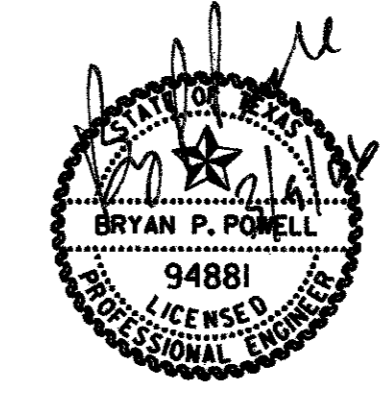

Carter :: Burgess

CARTER & BURGESS, INC.
 7950 ELMBROOK DRIVE, SUITE 250
 DALLAS, TX 75247-4951

B19-15

The seal appearing on this document was authorized by Bryan P. Powell, P.E. 94881, on March 07, 2006. Alteration of a sealed document without proper notification to the responsible engineer is an offense under the Texas Engineering Practice Act.