

PLOTTED Thu Mar 09 08:58:48 2006

USER=tipton

JOB=CONDO

SCALE=20.000000



ROT=90.000000

SCALE=20.000000

SCALE=20.000000

SCALE=20.000000


SCALE=20.000000

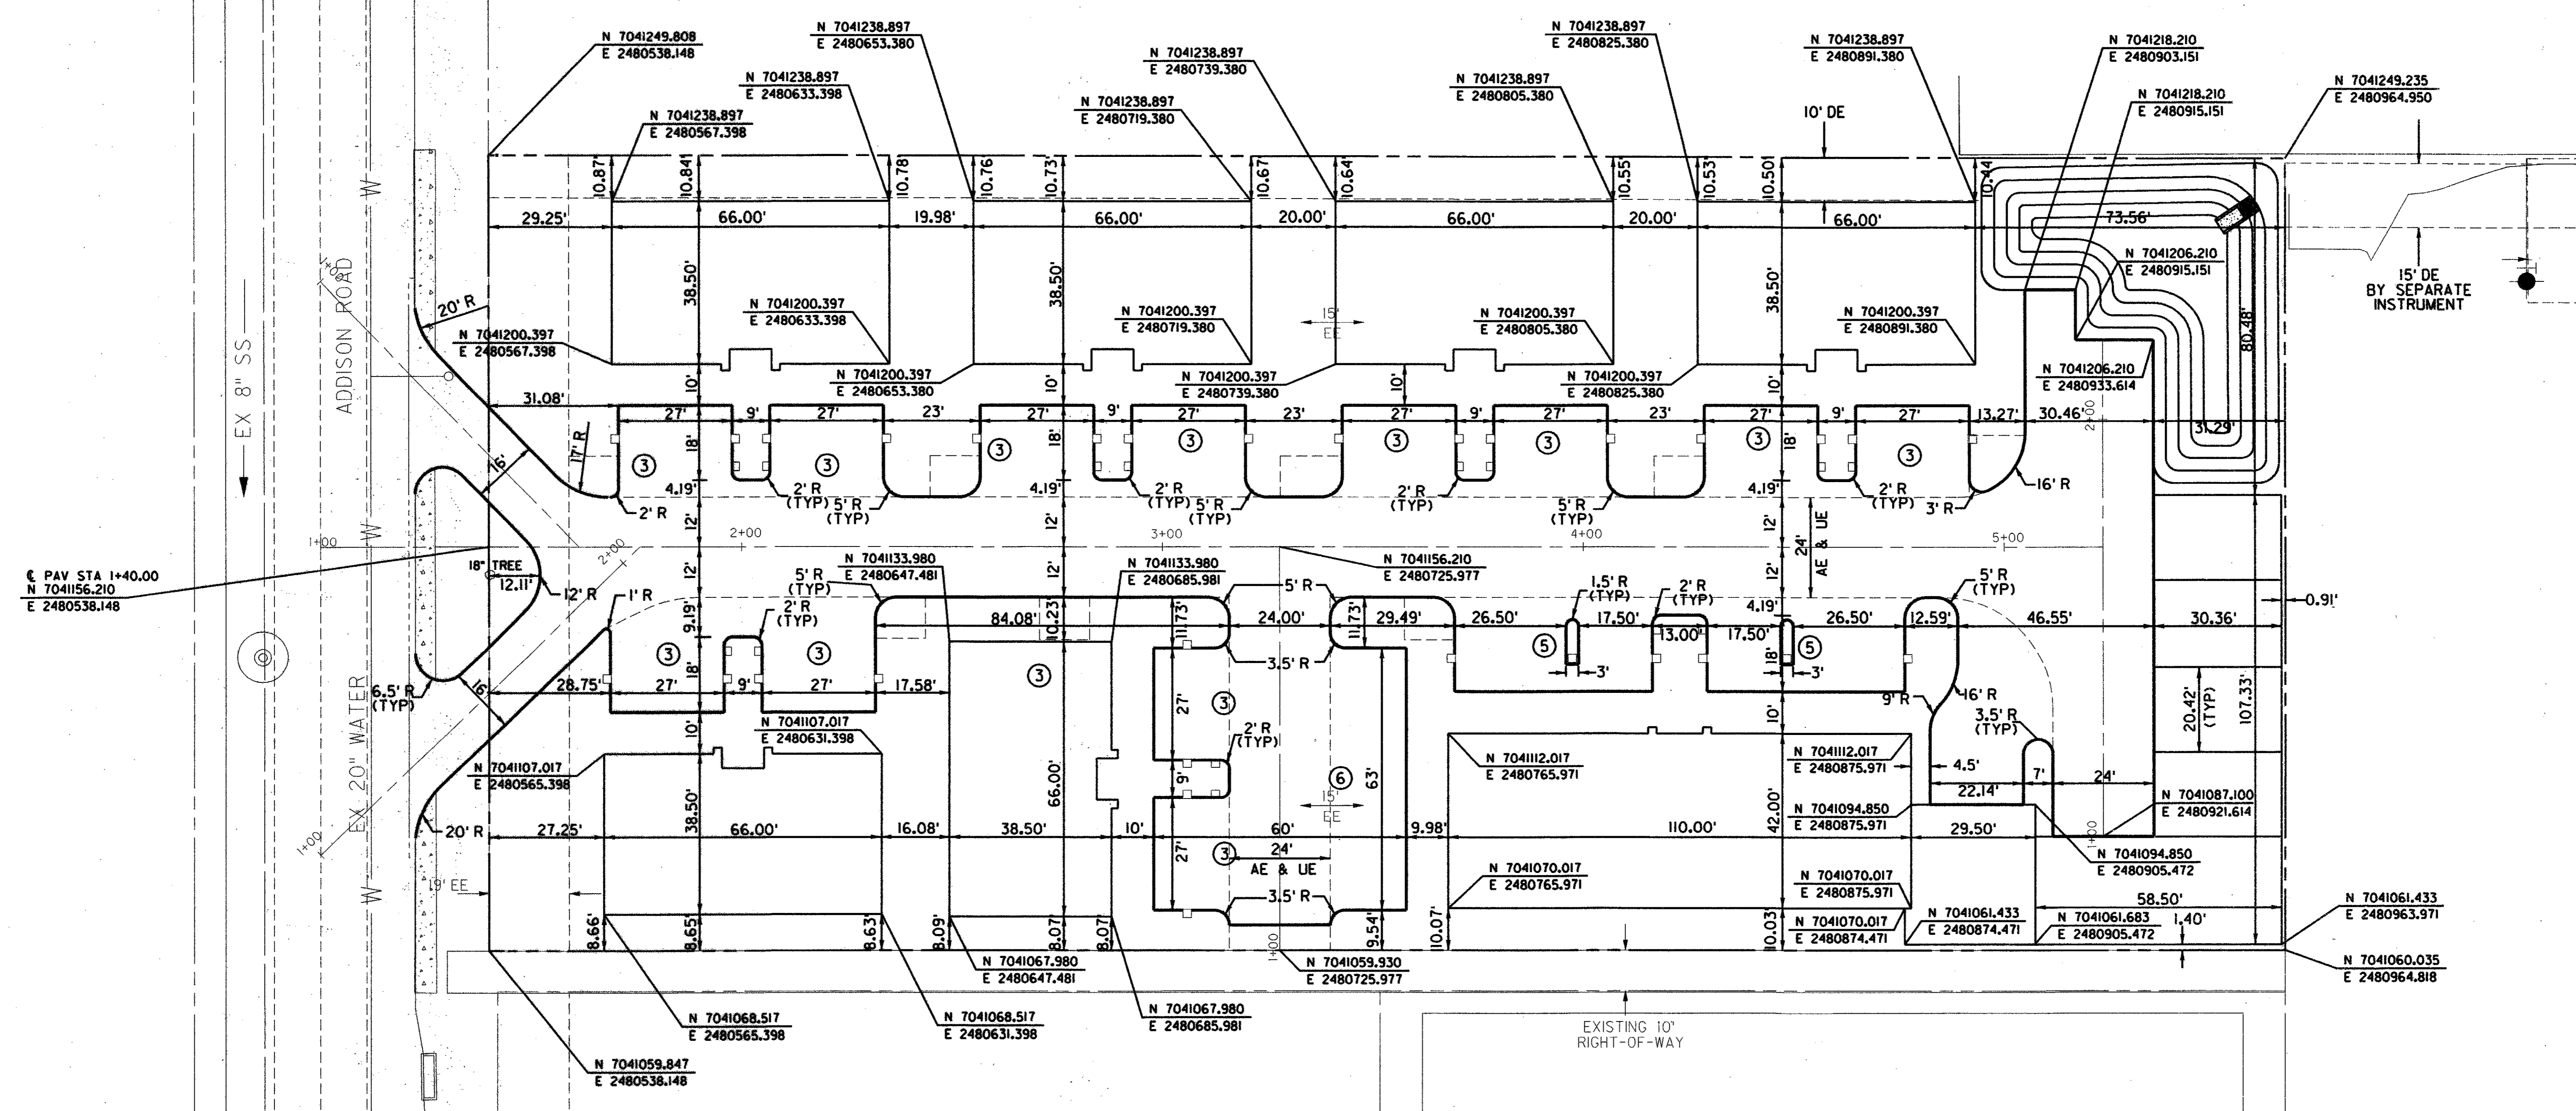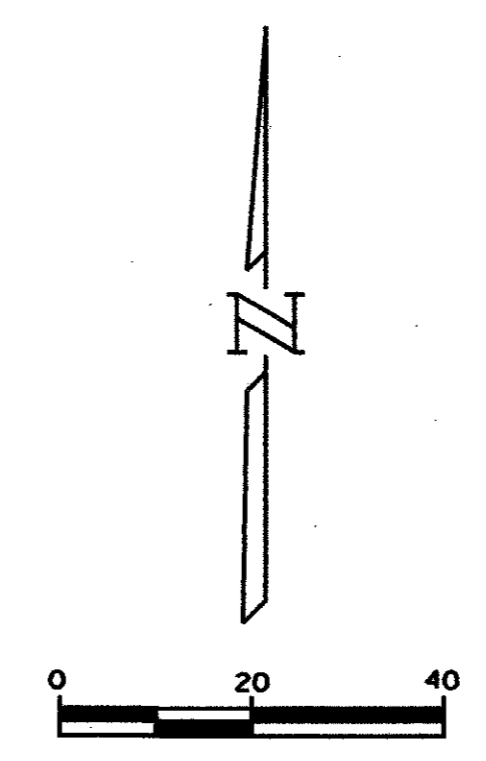

C PAV STA 1+40.00  
N 7041156.210  
E 2480538.148

NOTE:  
ALL DIMENSIONS ARE TO FACE OF CURB  
AND OUTSIDE EDGE OF BUILDING

**RECORD DRAWING**  
THIS DRAWING HAS BEEN MODIFIED  
TO REFLECT CONSTRUCTION RECORDS  
PROVIDED TO THE ENGINEER

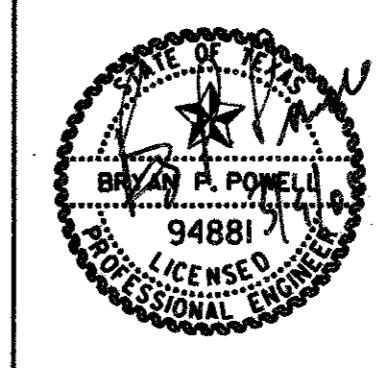

DATE	REVISION	MADE	CKD	APPD

**Carter-Burgess**  
Carter & Burgess, Inc. 7950 Elmbrook Drive Dallas, Texas 75247-4961  
(214) 638-0145 Metro (214) 263-2019 Fax (214) 638-0447

### DIMENSION CONTROL PLAN ADDISON OFFICE CONDOS

TOWN OF ADDISON, DALLAS COUNTY, TEXAS

DESIGN	DRAWN	CHECKED	SCALE	DATE	FILE	NO.
TIPTON	POWELL	1" = 20'	MARCH'06	01-6628	4 OF 17	