



I:\PROJECTS\2006\ADDISON OFFICE CONDOS\DWG\01-WATER.DWG - 01-06-06 - 10:00:00 AM
 I:\PROJECTS\2006\ADDISON OFFICE CONDOS\DWG\02-SEWER.DWG - 01-06-06 - 10:00:00 AM
 I:\PROJECTS\2006\ADDISON OFFICE CONDOS\DWG\03-STORM.DWG - 01-06-06 - 10:00:00 AM
 I:\PROJECTS\2006\ADDISON OFFICE CONDOS\DWG\04-SITE.DWG - 01-06-06 - 10:00:00 AM
 I:\PROJECTS\2006\ADDISON OFFICE CONDOS\DWG\05-PLAN.DWG - 01-06-06 - 10:00:00 AM
 I:\PROJECTS\2006\ADDISON OFFICE CONDOS\DWG\06-SECTION.DWG - 01-06-06 - 10:00:00 AM
 I:\PROJECTS\2006\ADDISON OFFICE CONDOS\DWG\07-GENERAL.DWG - 01-06-06 - 10:00:00 AM
 I:\PROJECTS\2006\ADDISON OFFICE CONDOS\DWG\08-FOUNDATION.DWG - 01-06-06 - 10:00:00 AM
 I:\PROJECTS\2006\ADDISON OFFICE CONDOS\DWG\09-ROOF.DWG - 01-06-06 - 10:00:00 AM
 I:\PROJECTS\2006\ADDISON OFFICE CONDOS\DWG\10-FLOOR.FINISHES.DWG - 01-06-06 - 10:00:00 AM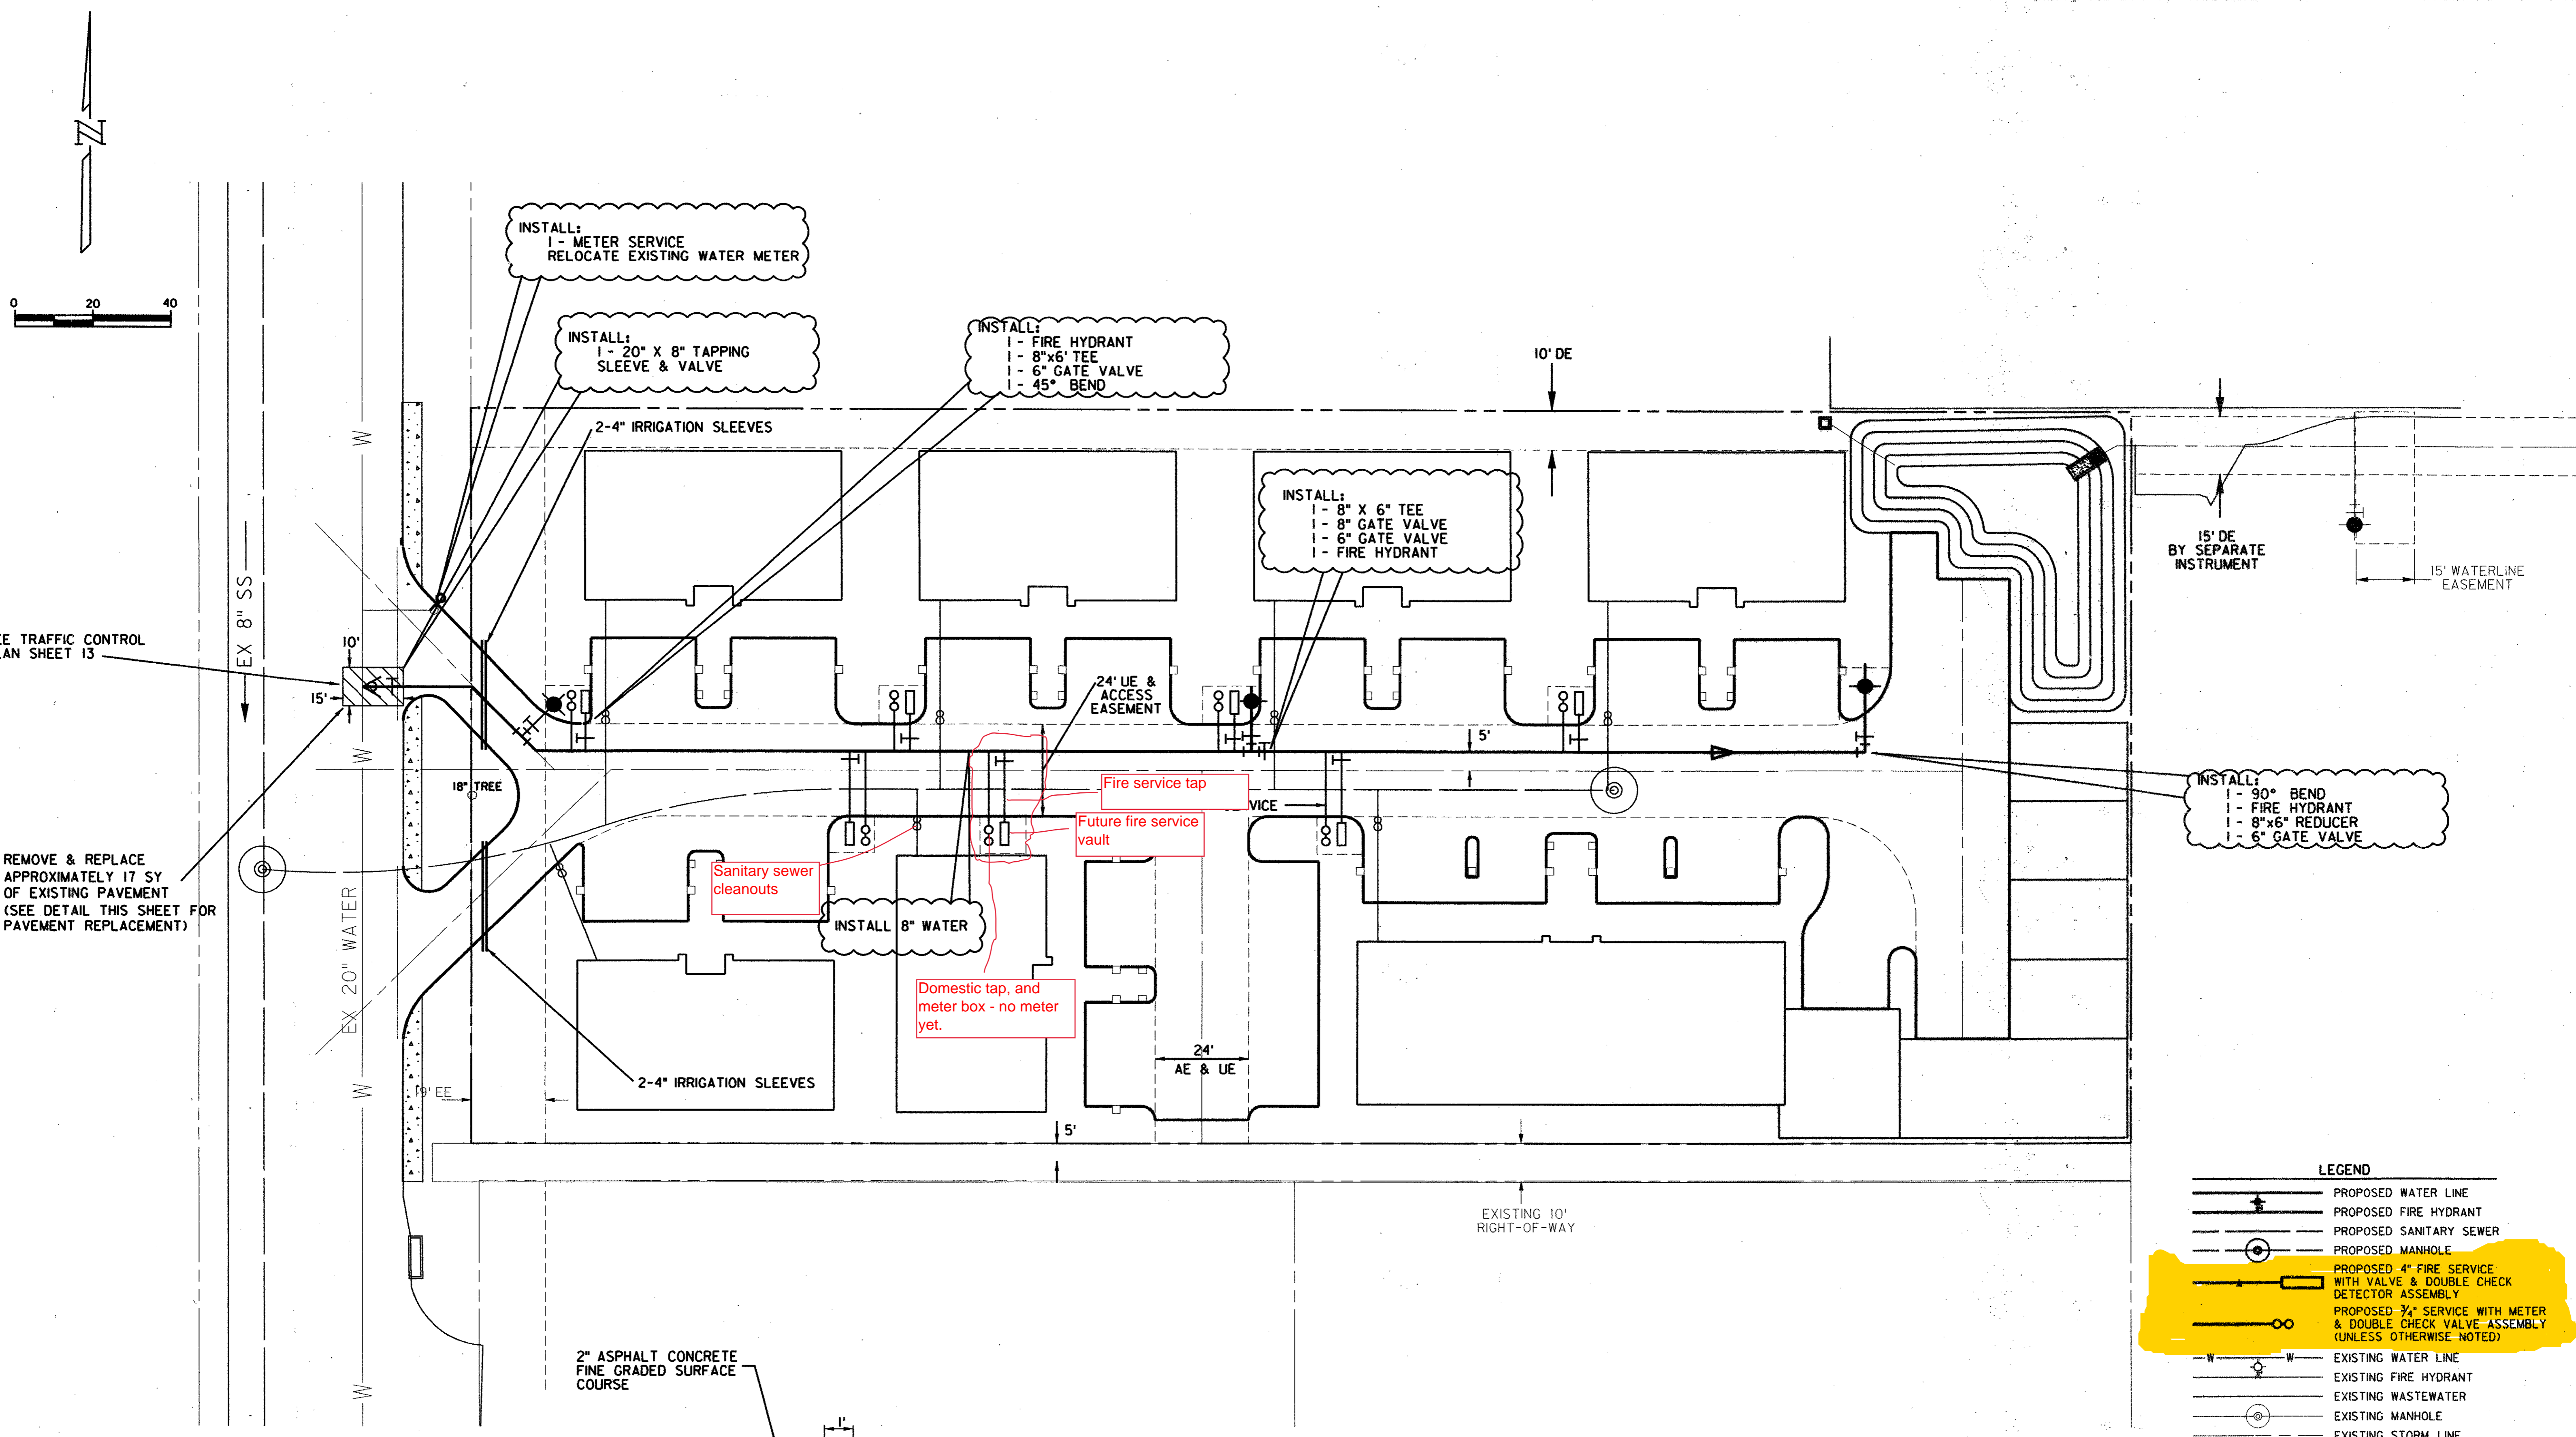
RECORD DRAWING

THIS DRAWING HAS BEEN MODIFIED TO REFLECT CONSTRUCTION RECORDS PROVIDED TO THE ENGINEER

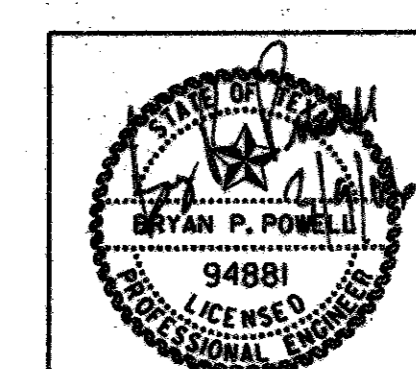

DATE	REVISION	MADE	CKD	APPD
Carter=Burgess				
Carter & Burgess, Inc. 7950 Embrook Drive Dallas, Texas 75247-4961 (214) 638-0445 Metro (214) 263-2019 Fax (214) 638-0447				
WATER LAYOUT				
ADDISON OFFICE CONDOS				
TOWN OF ADDISON, DALLAS COUNTY, TEXAS				
DESIGN	DRAWN	CHECKED	SCALE	DATE
TIPTON	SPONSEL	POWELL	1" = 20'	MARCH'06
FILE	NO.			
01-6628	11 OF 17			