



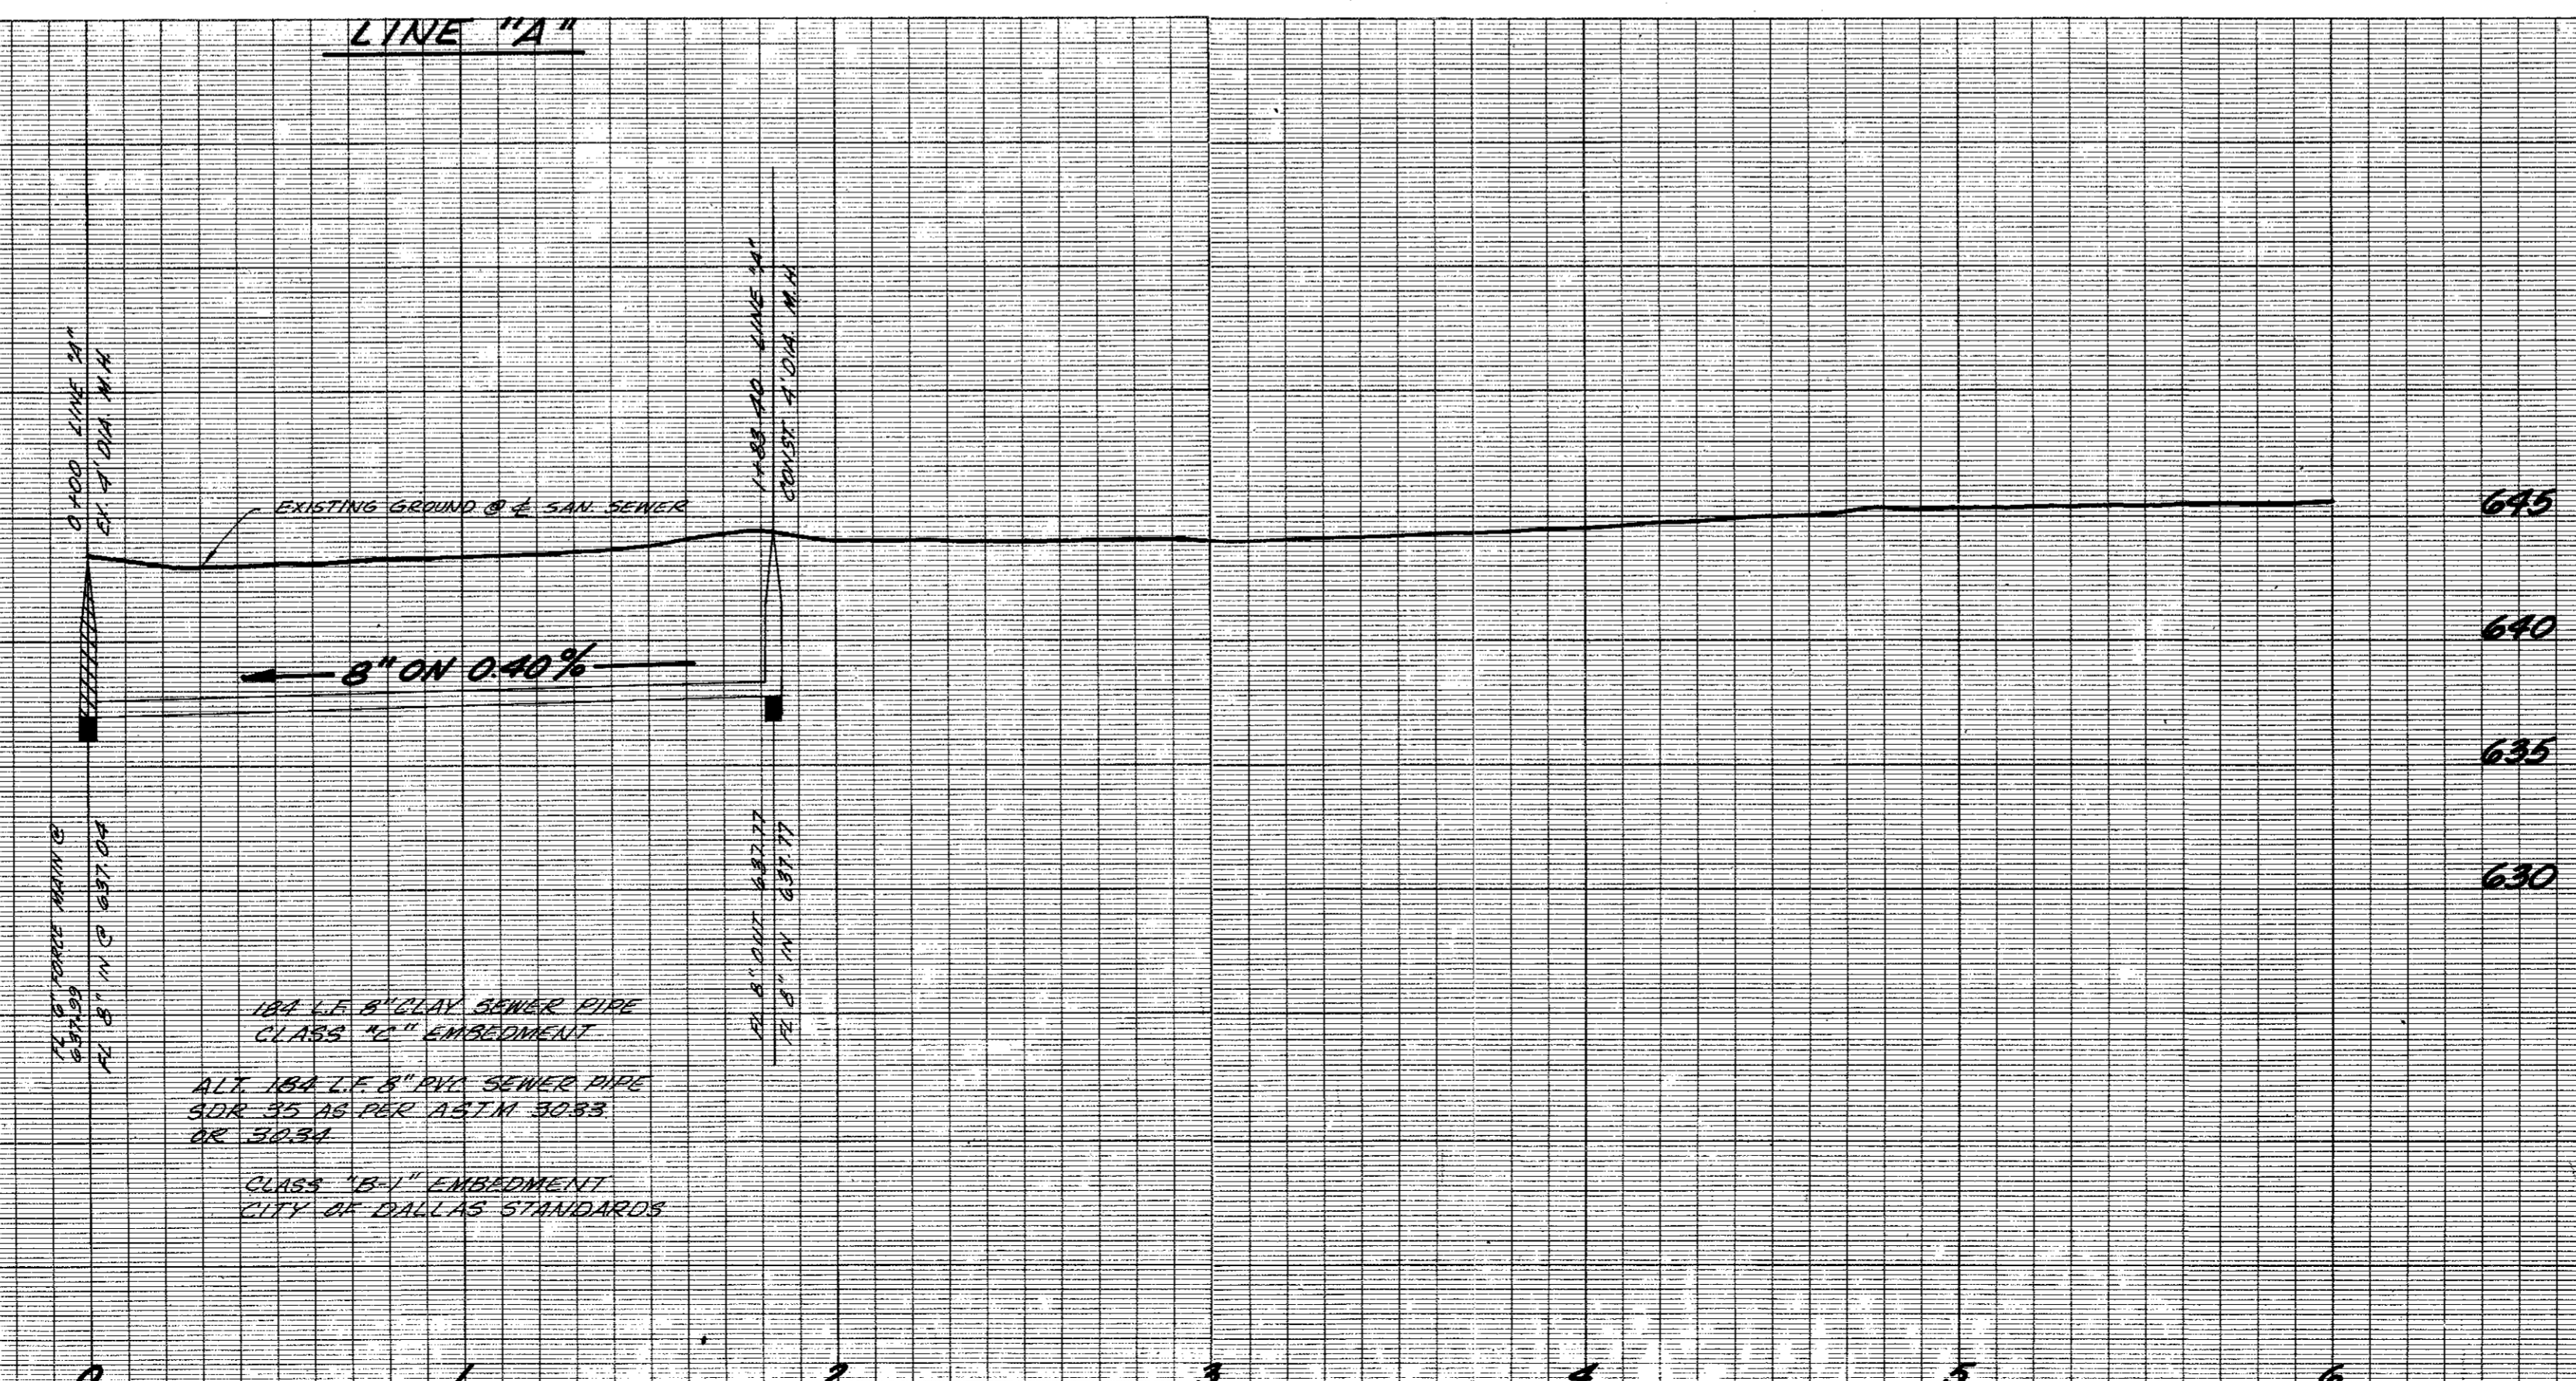

SCALE: 1"=100'

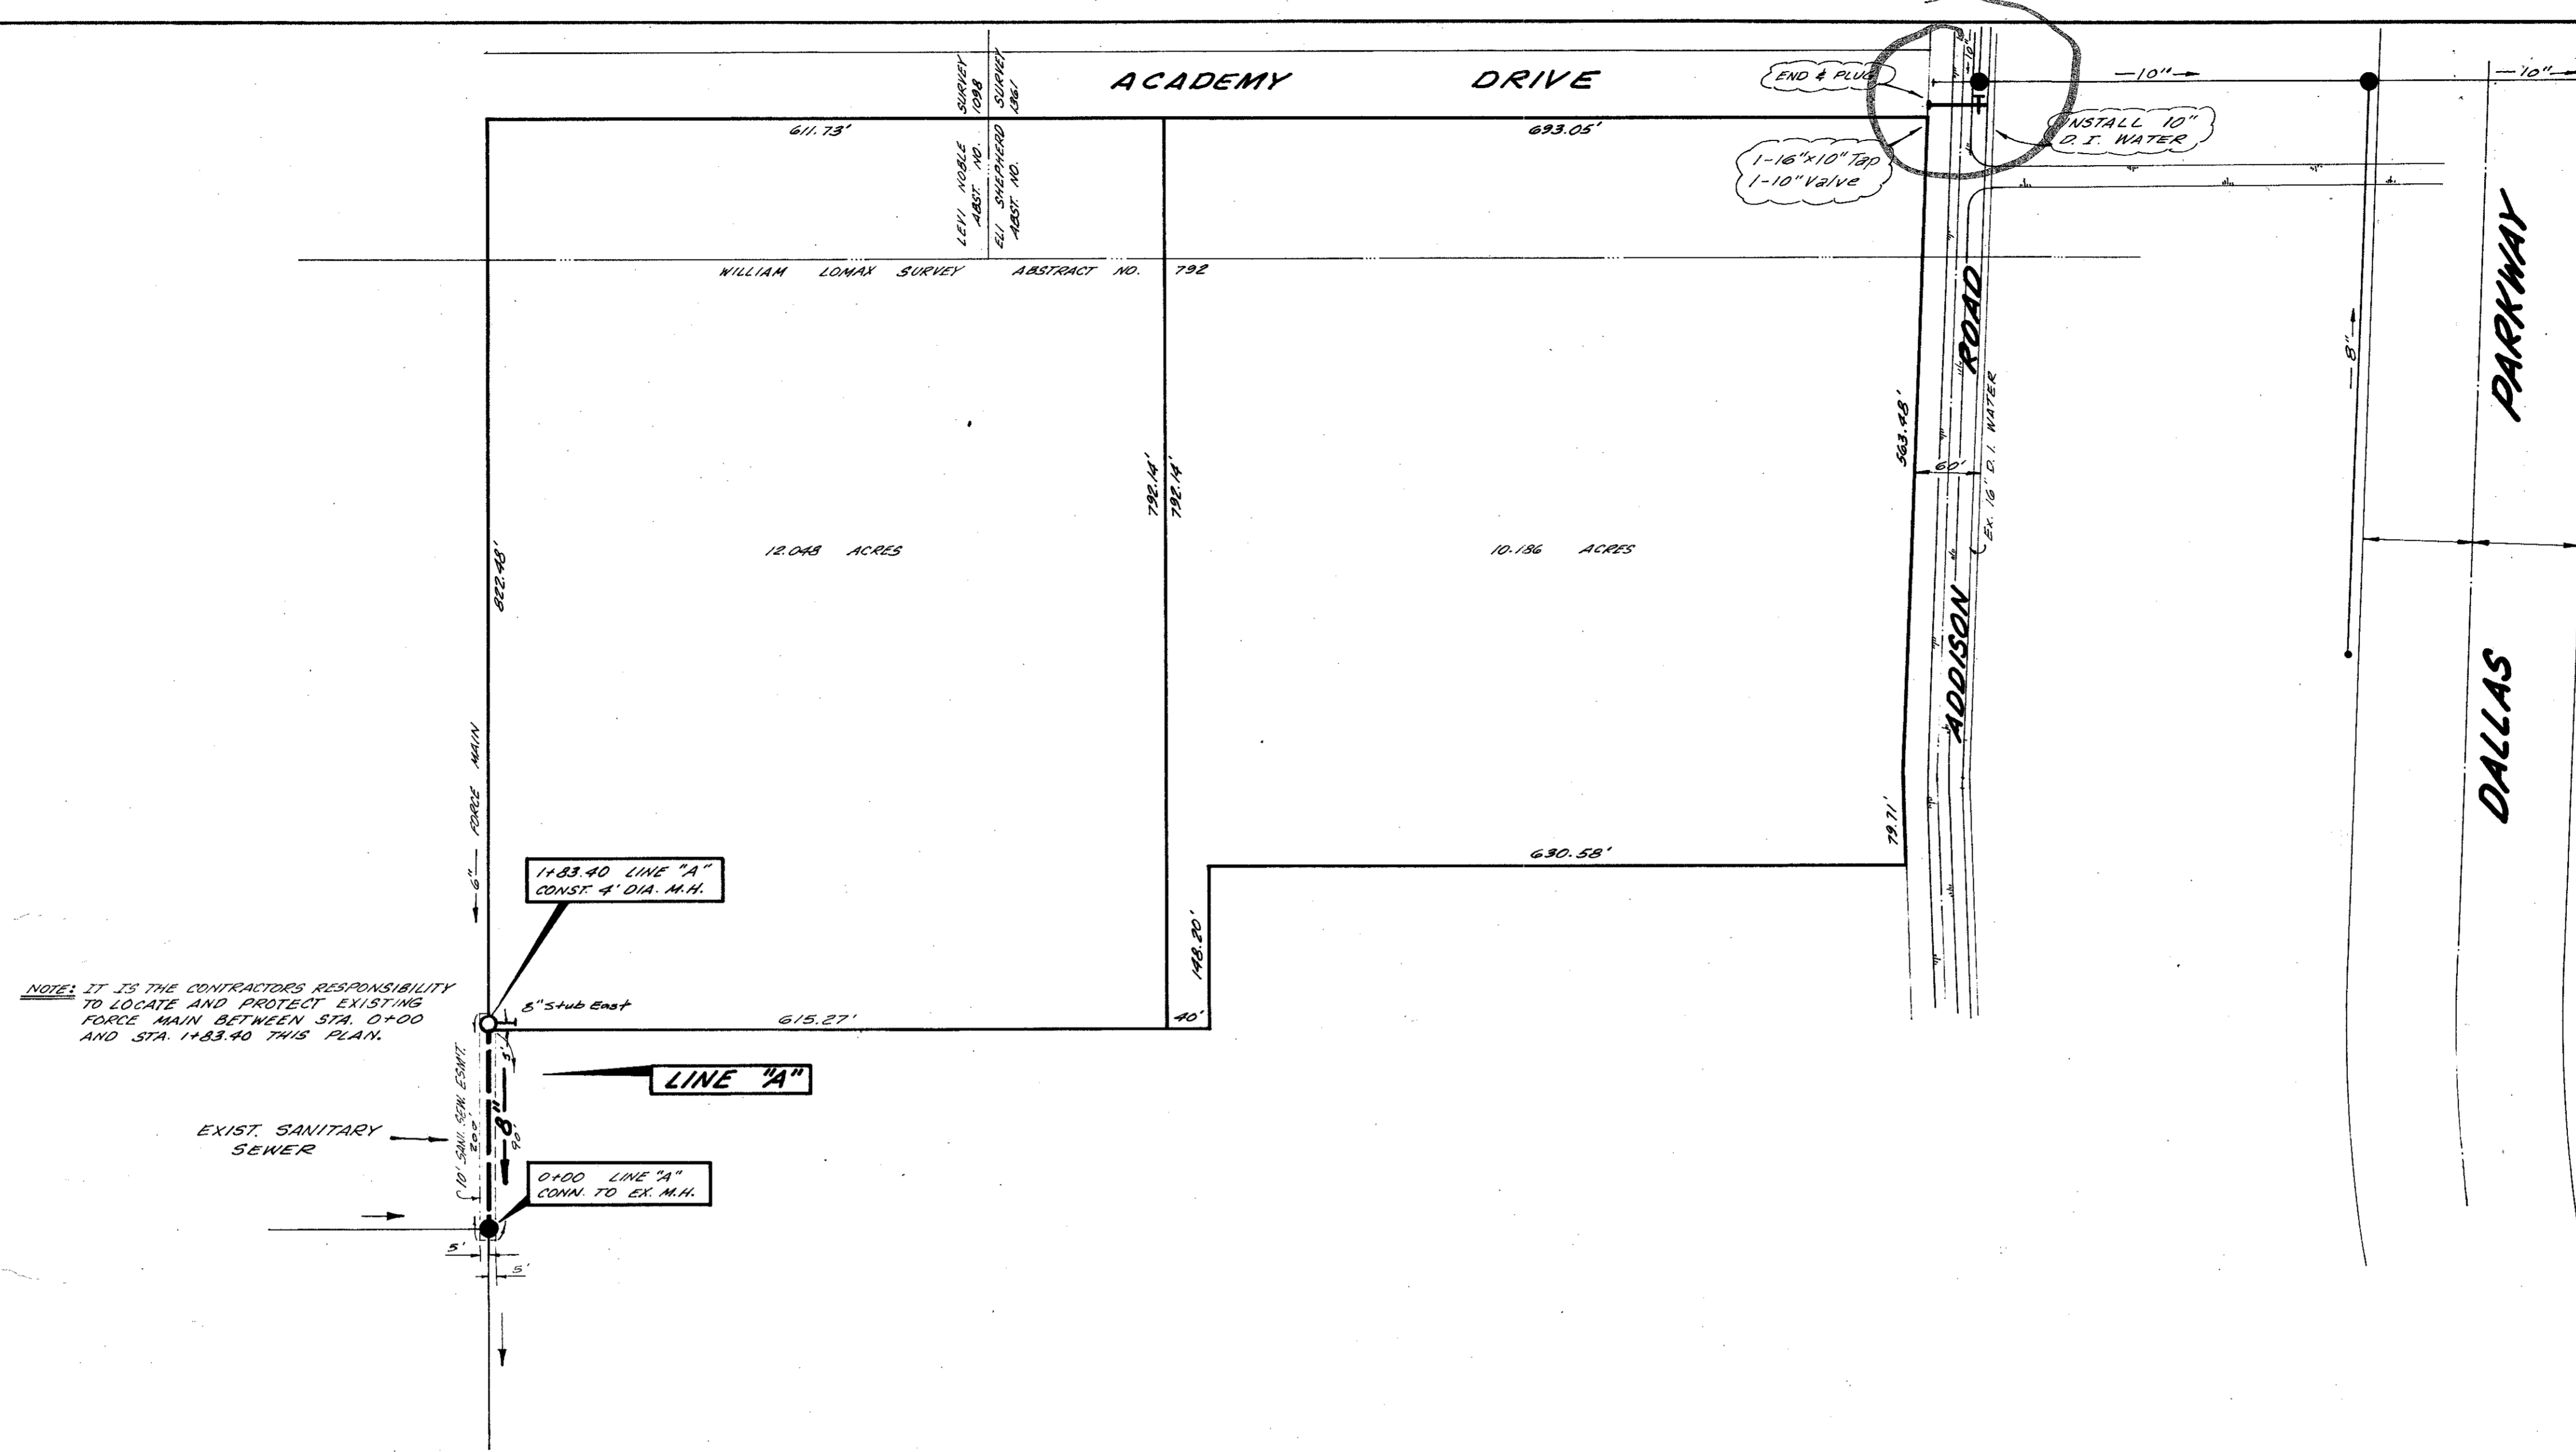

NOTE: IT WILL BE THE CONTRACTOR'S RESPONSIBILITY TO VERIFY THE LOCATION AND TO PROTECT ALL EXISTING UTILITIES.

BENCH MARK: NAIL IN THE WEST SIDE OF DOORWAY  
CORNER AND 4.0000' S& 2.5' NORTH  
OF SOUTHWEST CORNER OF THE  
TEXAS CHRISTIAN ACADEMY TRACT  
FILE 640.88



**WATER & SEWER PLANS**  
**BENT TREE TOWERS APARTMENTS**  
 ADDISON ROAD  
 ADDISON WATER UTILITIES  
 CITY OF ADDISON, TEXAS

DESIGN	DRAWN	DATE	SCALE	NOTES	FILE	NO.
T.F.D.	T.O.K.	AUG. '77	1" = 6'-4"	T.F.D.		