


LEGEND NOTES


- ① BUILDING SIGN, VERIFY EXACT LOCATION AND ROUGH-IN REQUIREMENTS WITH ARCHITECT
- ② (2) 4" PVC CONDUITS FROM PROPERTY LINE TO 2ND FLOOR TELEPHONE ROOM (TOTAL OF 4)

GENERAL NOTES

- 1. REFER TO AND COORDINATE WITH ARCHITECTURAL DRAWING FOR EXACT LOCATIONS OF ALL DEVICES, FIXTURES AND EQUIPMENT.

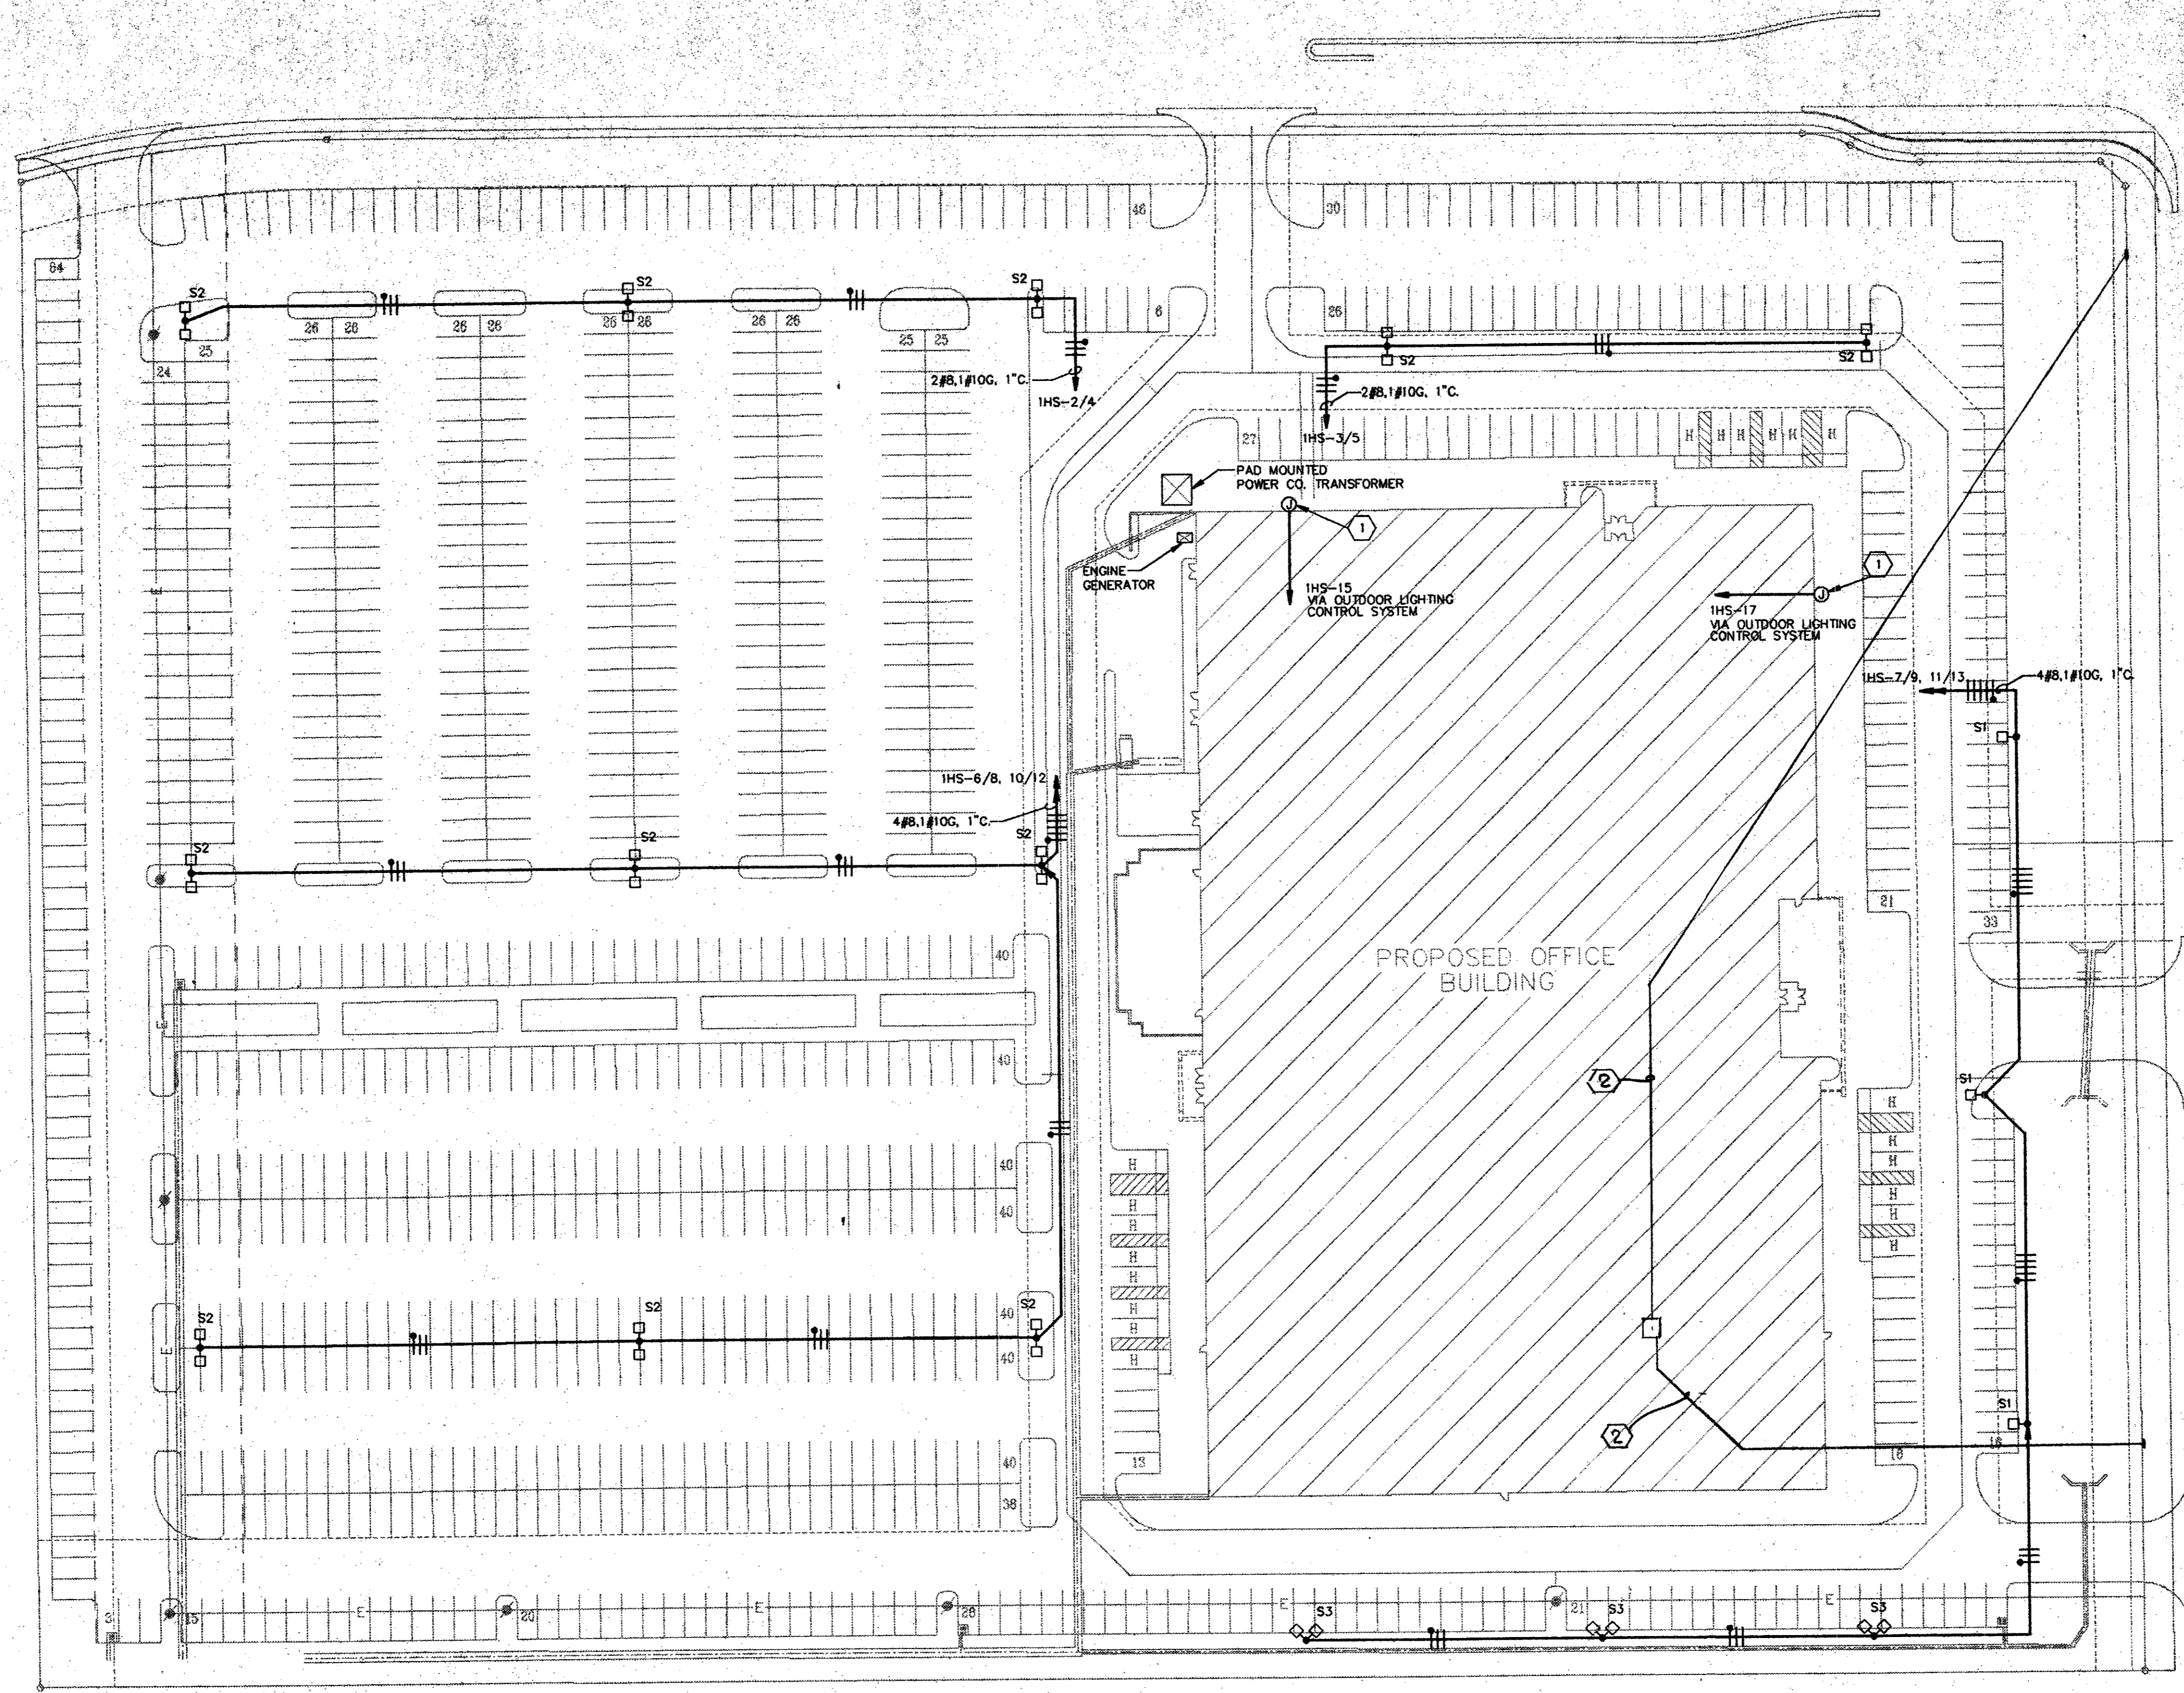

LIGHTNING PLAN MUST BE APPROVED BY ADDISON PD
CALL BOB McKITTRICK AT 450 7146

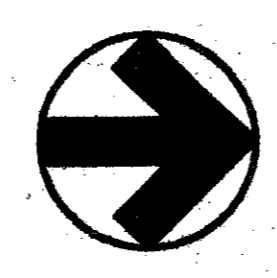

01 SITE PLAN - MEP
SCALE: 1" = 40'-0"

JOB # 285307
ccrd partners
Professional and consulting engineers
DALLAS - HOUSTON
4311 OAK LAWN AVENUE
SUITE 400, LB 15
DALLAS, TEXAS 75219
(214) 521-1661
FAX (214) 521-1664

LET IT GO... WSI ARCHITECTS... 12/20/95... 3:30 PM

NO.	REVISIONS / SUBMISSIONS	DATE

DEVELOPER
WILCOX / CMC
Dallas, Texas


EXCEL TELECOMMUNICATIONS SERVICE CENTER
Addison, Texas

EXCEL

WSI ARCHITECTS 12750 MERIT DRIVE SUITE 1202 DALLAS, TEXAS (214) 458 - 9999

SITE PLAN - MEP

SCALE 1"=40'-0"
DATE 04 DEC 95

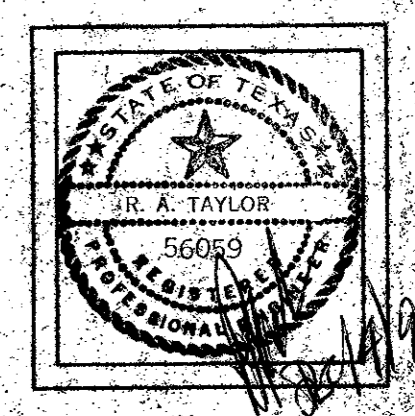

PROJECT NO. 9521
SHEET NUMBER
MEP-101
PAGE 07