


- GENERAL NOTES**
- Sanitary Sewer to be PVC SDR 35 Sewer Pipe.
  - Water Mains to be PVC SDR 18 Water Pipe.
  - Fire Hydrants to be Mueller Centurian Only.
  - Air Test Acceptable Per City of Dallas Standard.
  - All Valves to be Mueller.

Note: Verify Elevations In Field Prior to Construction

Note: All Sanitary Sewer Manholes to be Poured in Place


- ~ Indicates Test Borings Location
- Boring Legend**
- A = Reddish Brown sand
  - B = Dark Brown Clay
  - C = Tan Clay
  - D = Tan Weathered Limestone
  - E = Gray Limestone
  - F = Brown Clay

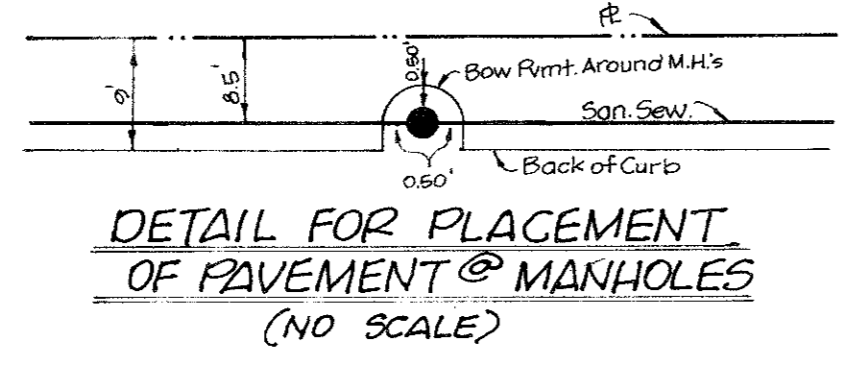


0'00" A" = Ex. 8" San. Sew. Const. 4.0' Dia. M.H. Over Ex. 8" San. Sew.

3'50" A" Const. 4.0' Dia. M.H.

7'40" A" Const. 4.0' Dia. M.H.

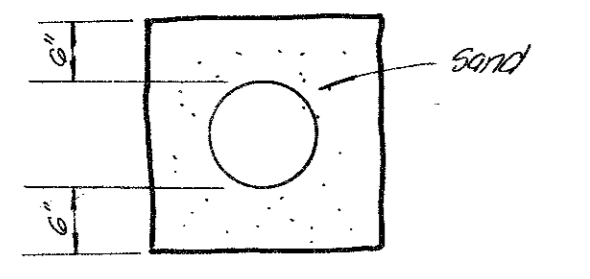

**TYPICAL EMBEDMENT FOR WATER & SANITARY SEWER**  
No Scale

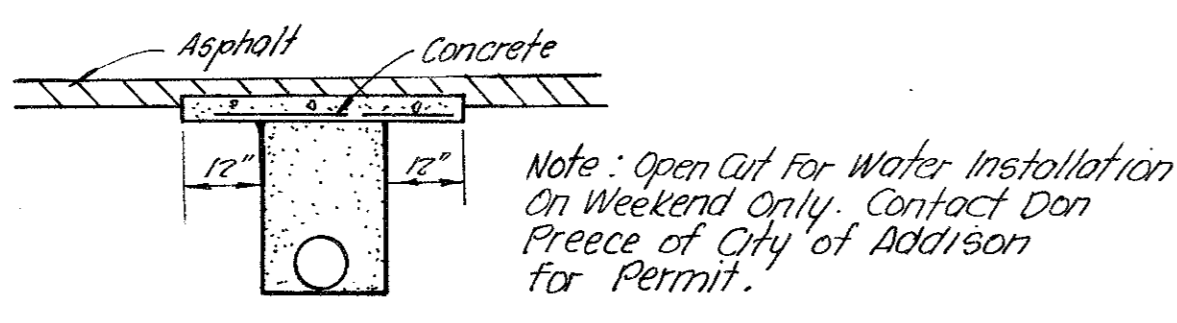

**DETAIL OF CONCRETE CAP FOR OPEN CUT**  
No Scale

Note: Open Cut for Water Installation on Weekend Only. Contact Don Preece of City of Addison for Permit.

Talon Construction Co.  
Lot 18

Bent Tree Gardens Addn.  
Phase II

Lot 5

Lot 5

Lot 19

Lot 19

Prop. Bldg.  
F.F. 649.70


NOTE: Shaded Areas Indicate Exist. or As Built Utilities

Caution: Underground tele. Cable In Area. Contact S.W. Bell Tele. Co. 2 Working Days Prior to Construction in Area.

Corral Estates Addn.

Bent Addison Joint Venture  
Lot 20

Utility: The engineer accepts no responsibility for the location, vertical or horizontal, of manholes, inlets, fire hydrants, cleanouts or valve boxes, unless inspected by the engineer prior to the final placement. It shall be the responsibility of the contractor to notify the engineer when ready for inspection.

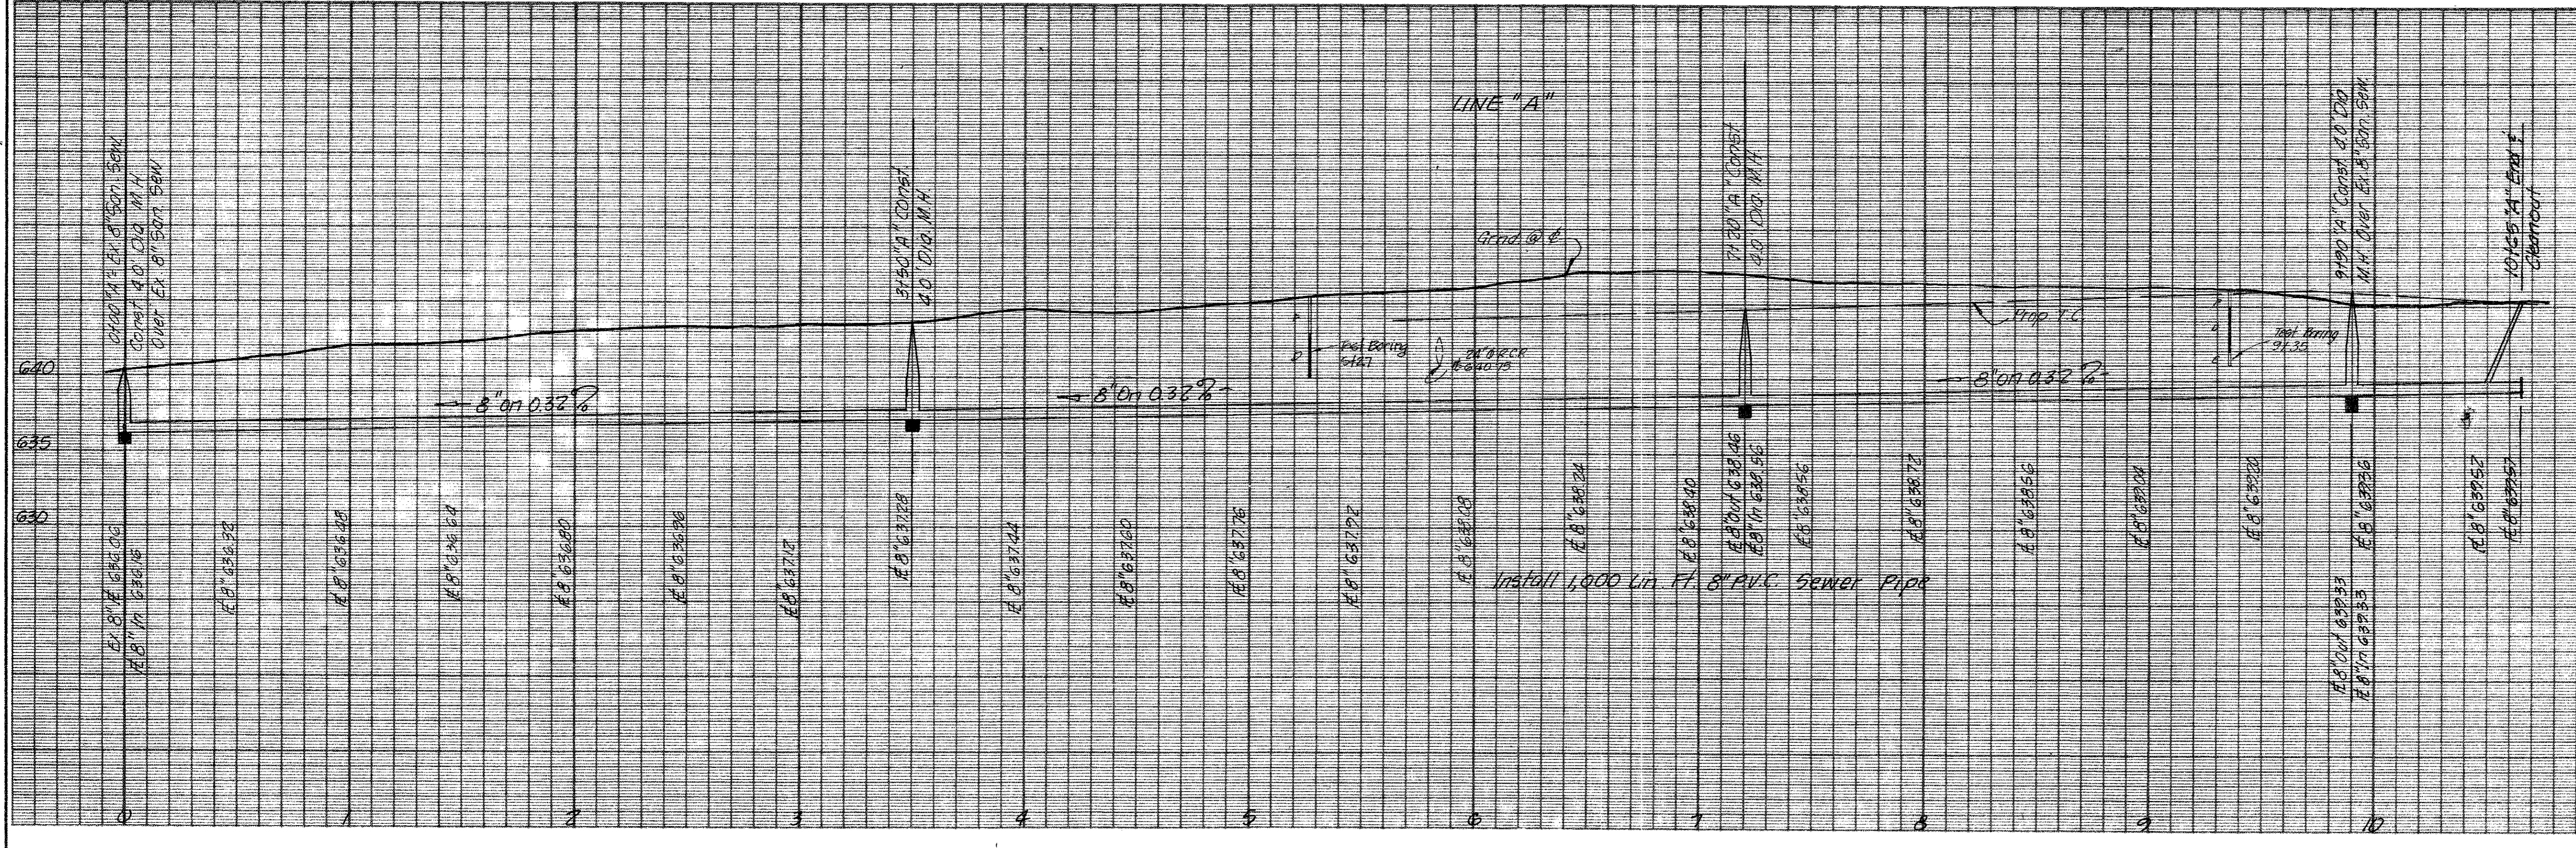

B.M. 20" on I.C. 60' east of Wilson St. North Side of Westgate Elev. 641.96  
B.M. 20" on I.C. 100' North of South Property Corner West Side of Wilson St. Elev. 642.49

**WATER & SANITARY SEWER**  
**THE ATRIUM**  
**VANTAGE CO. - DEVELOPER**  
**ACREY, ROBERTS & PIERSON-ENGINEERS**  
**CITY OF ADDISON, TEXAS**

DESIGN	DRAWN	DATE	SCALE	NOTES	FILE	NO.
A.R.P.	G.L.S.	DEC. 1981	1"=40' H 1"=6' V	A.R.P.		