




SAWCUT DETAIL SCALE: 1 1/2"=1'-0" 1.112

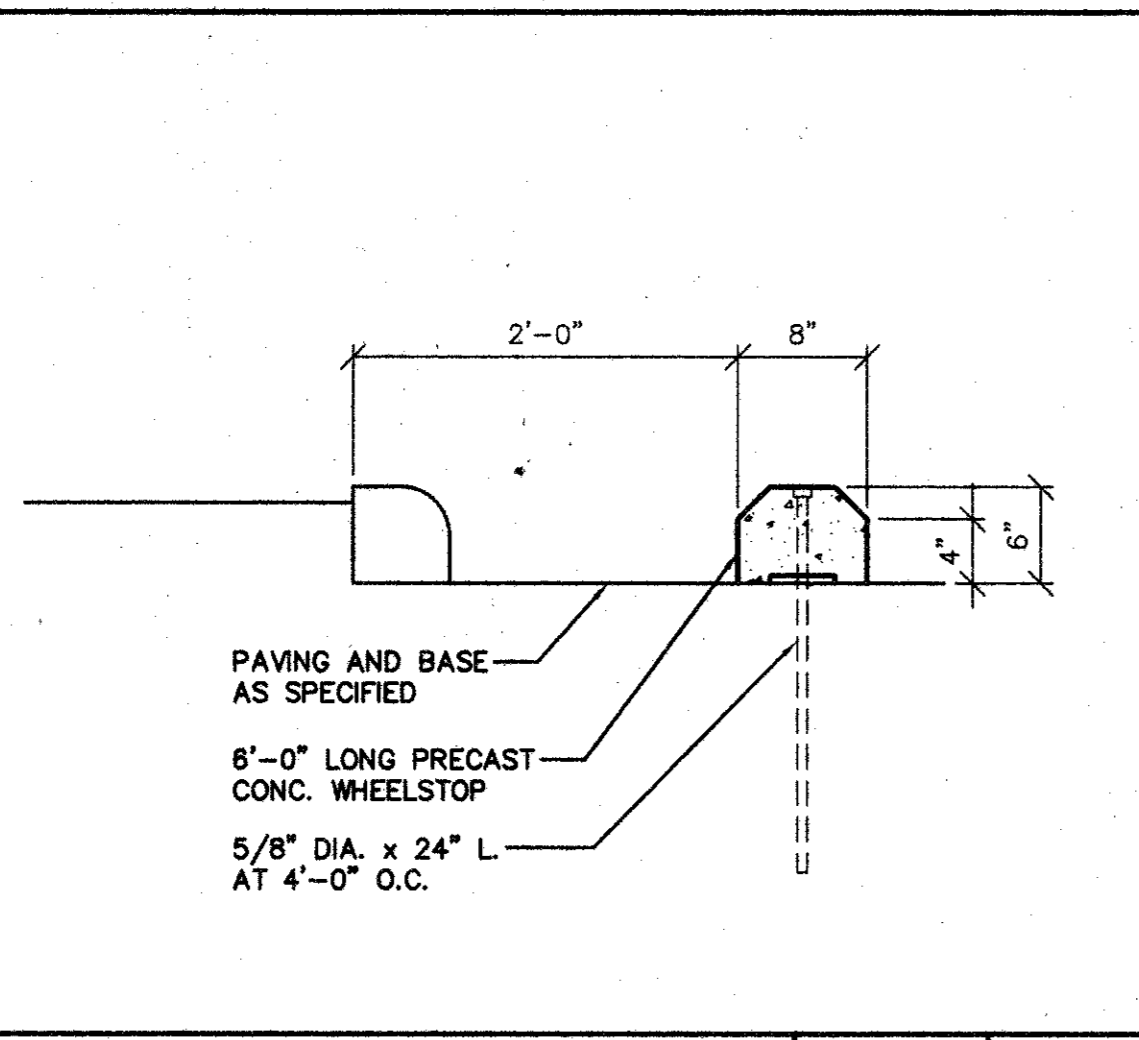


WHEELSTOP SCALE: 1"=1'-0" 1.110

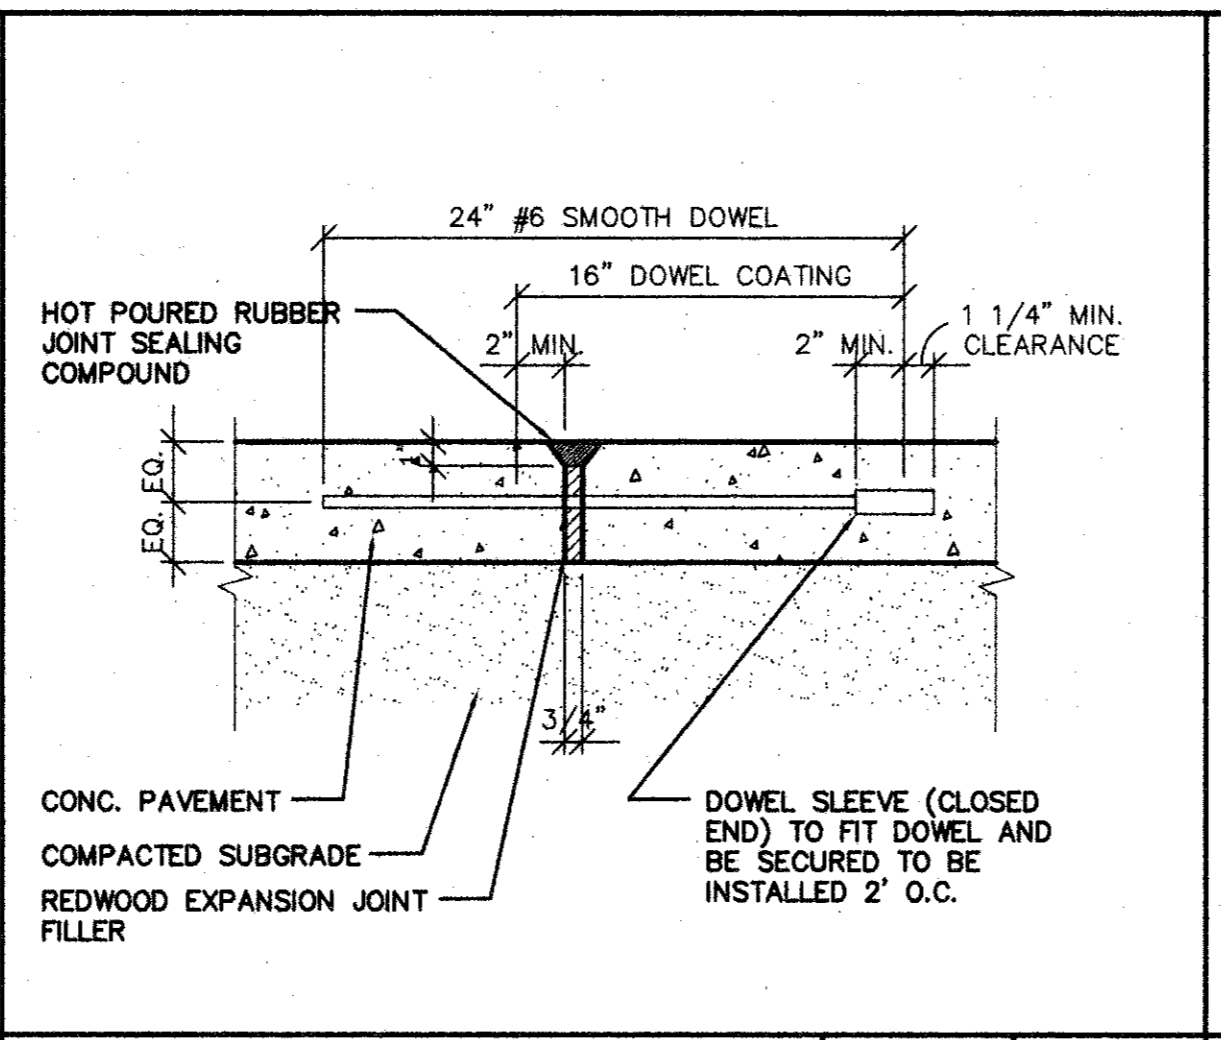


EXPANSION JOINT SCALE: 1 1/2"=1'-0" 1.108

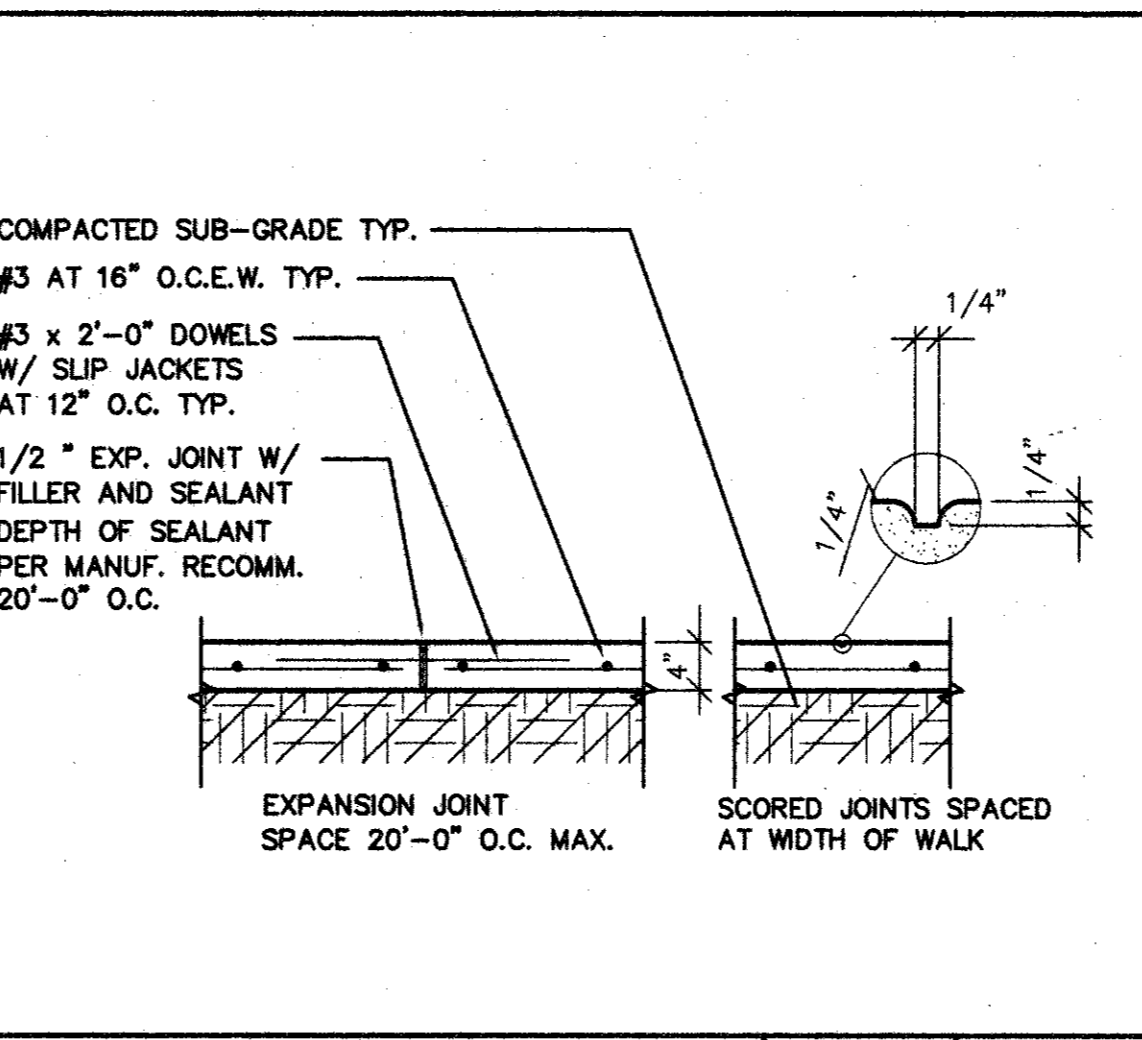


CONC. WALK SCALE: 3/4"=1'-0" 1.106

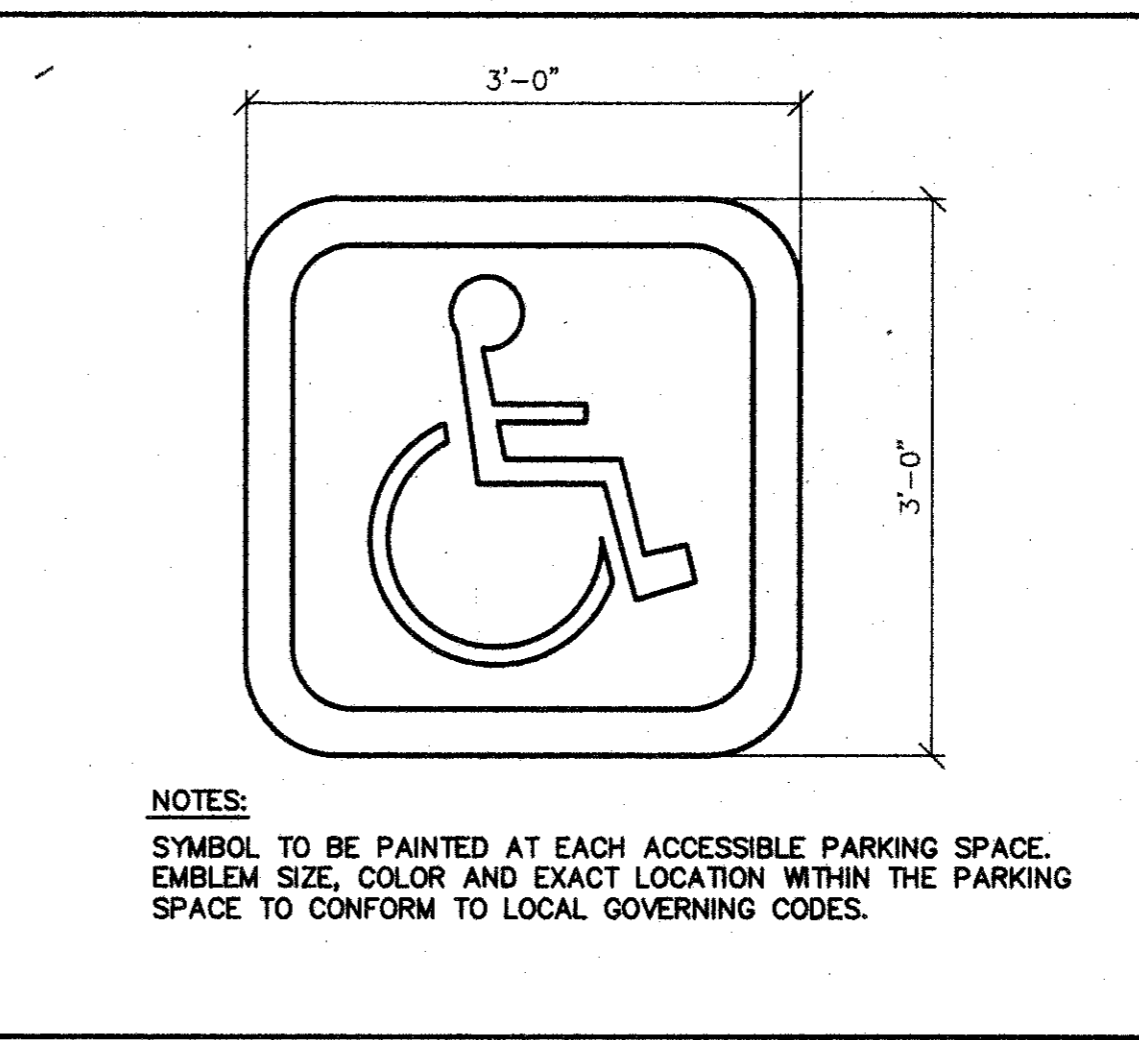


HANDICAP SYMBOL SCALE: 1"=1'-0" 1.104

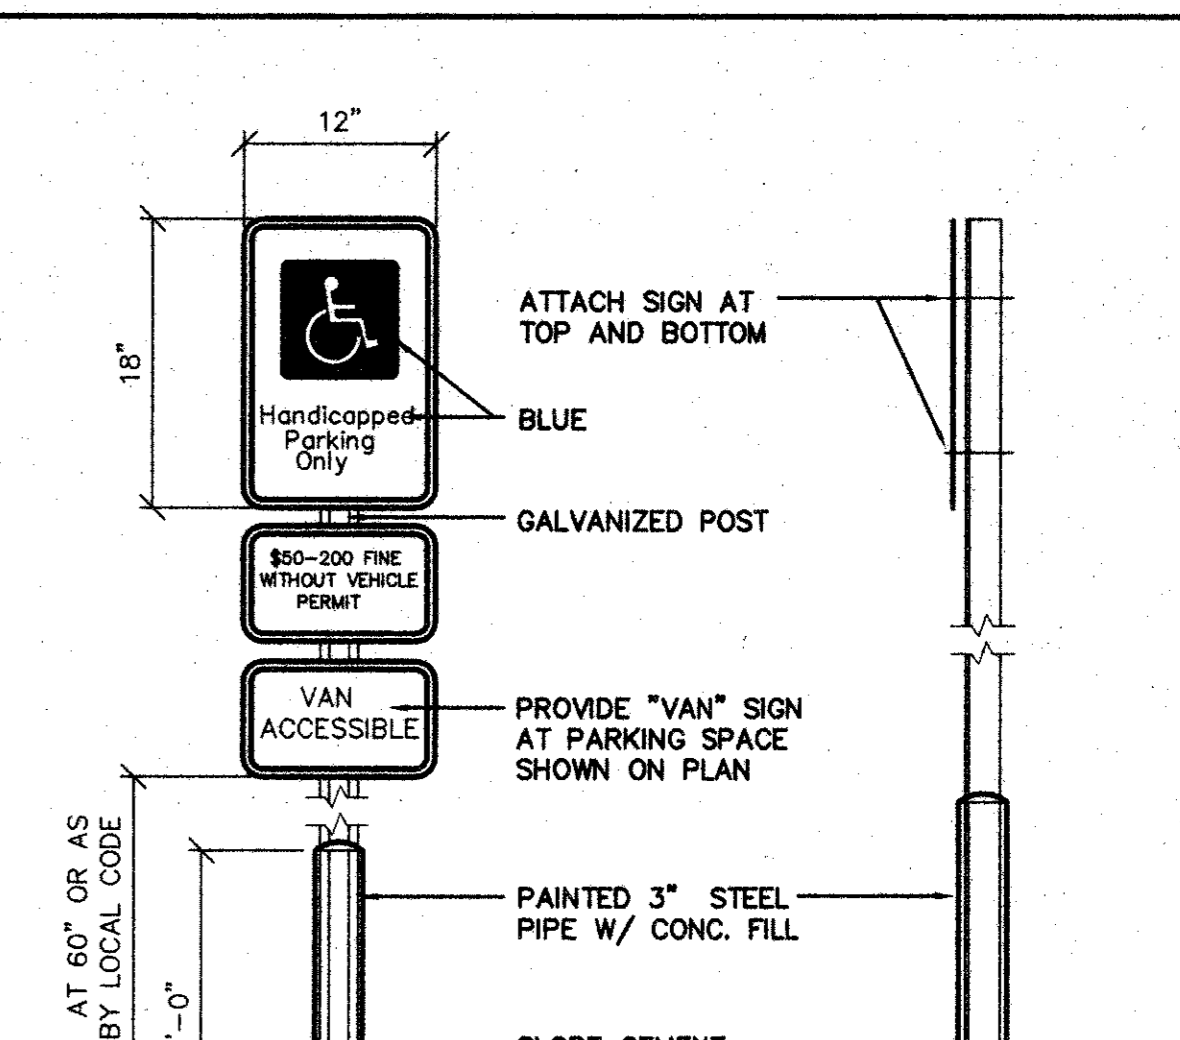


HANDICAP SIGN SCALE: 1"=1'-0" 1.102

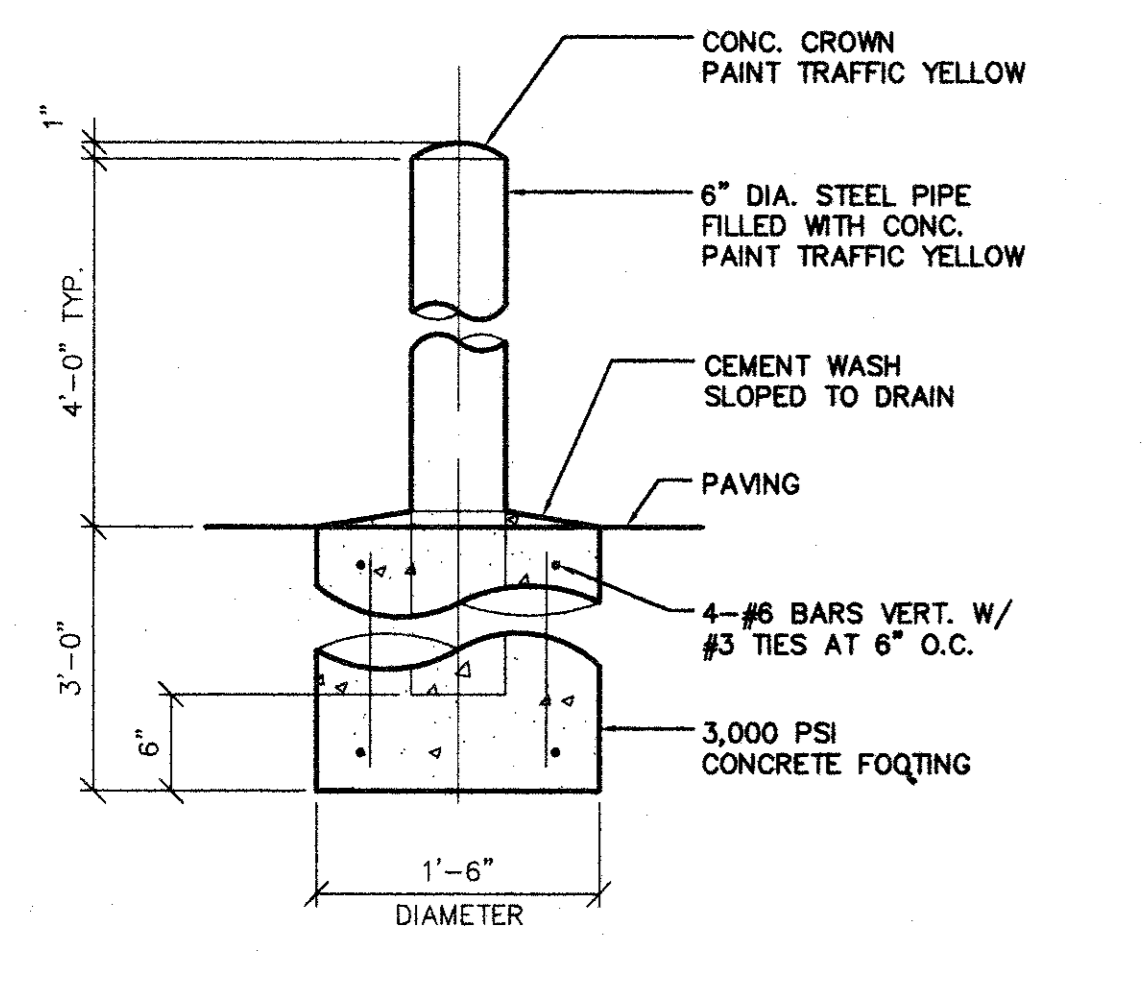



PIPE BOLLARD SCALE: 1"=1'-0" 1.109

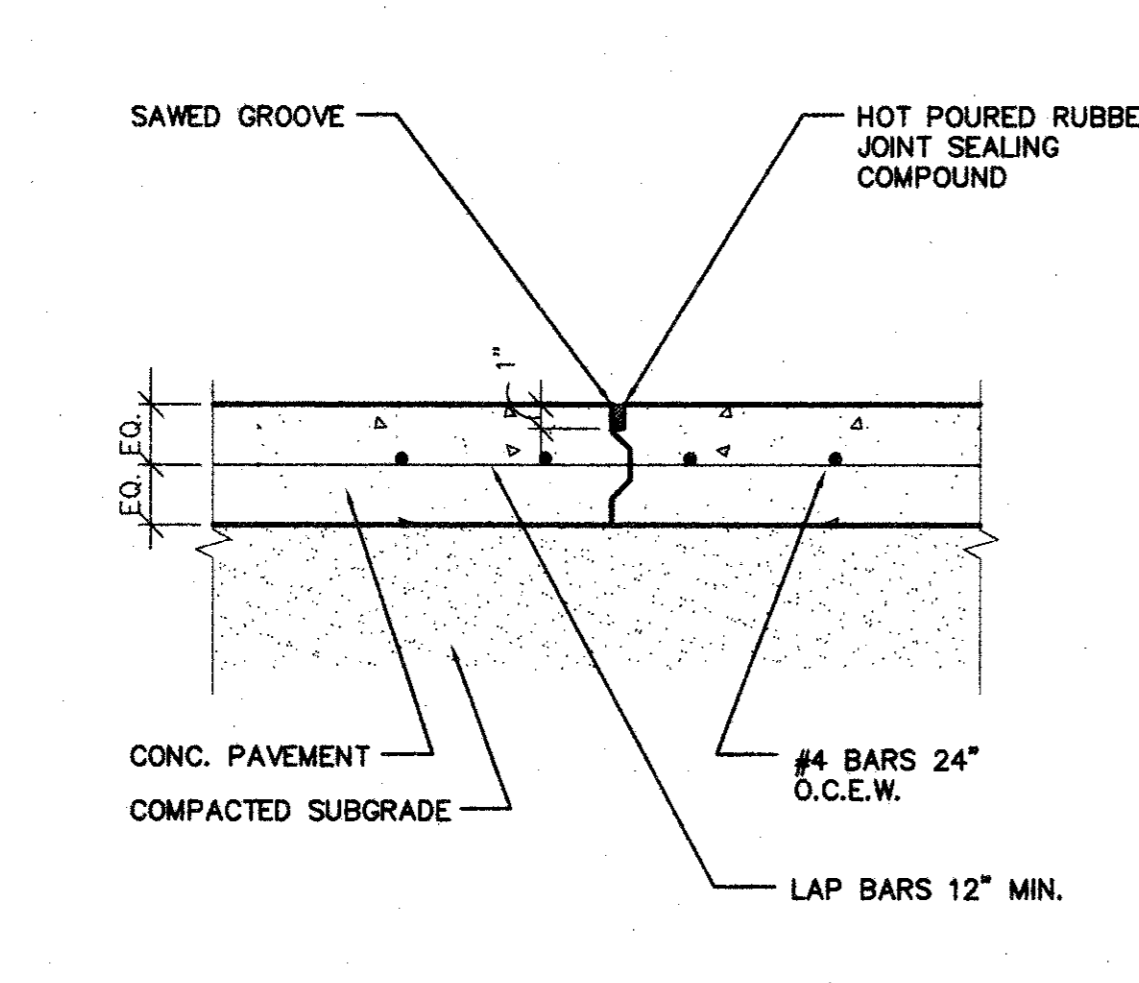


KEYWAY JOINT SCALE: 1 1/2"=1'-0" 1.107

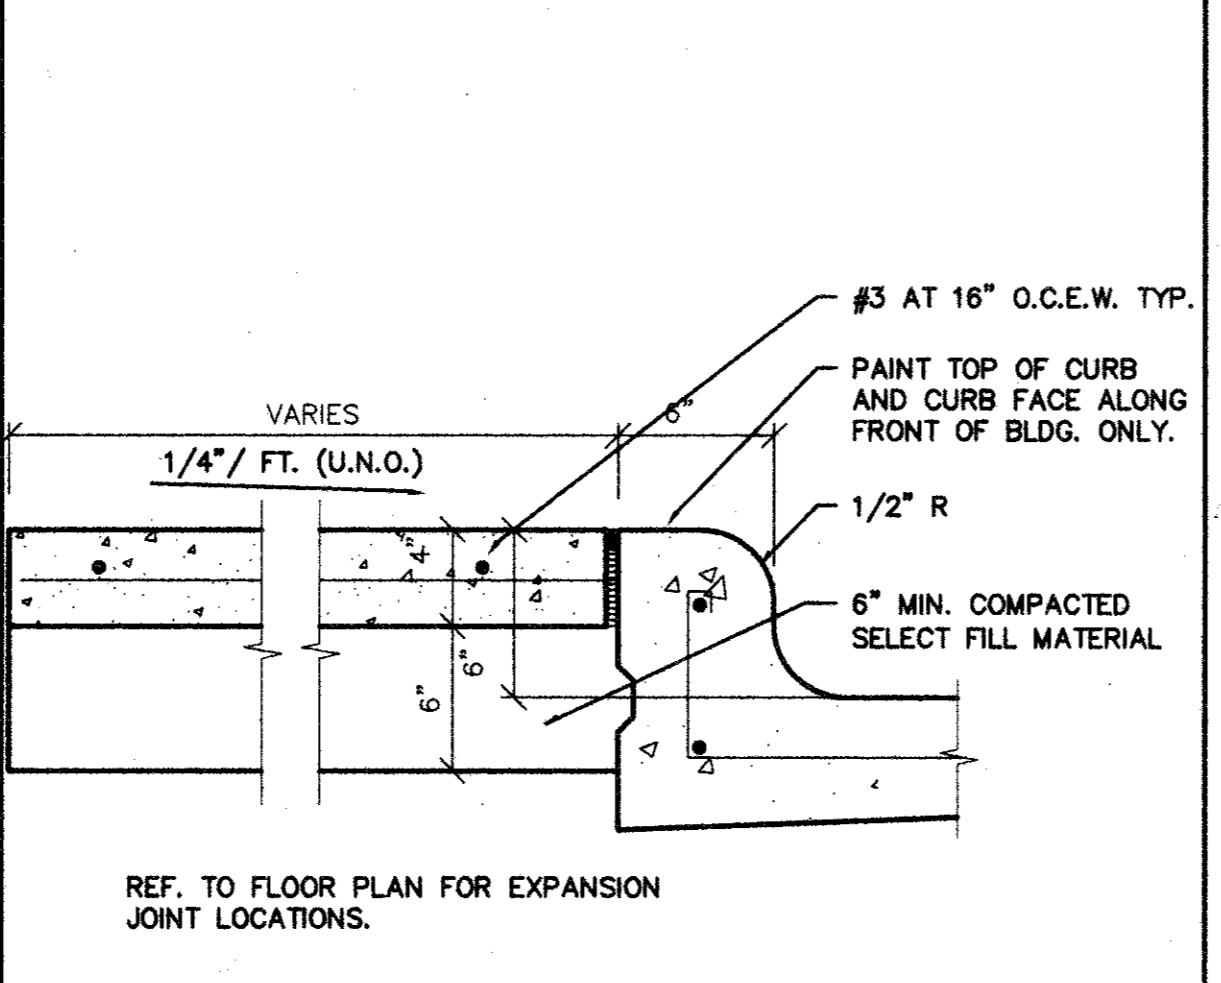


CURB DETAIL SCALE: 1 1/2"=1'-0" 1.105

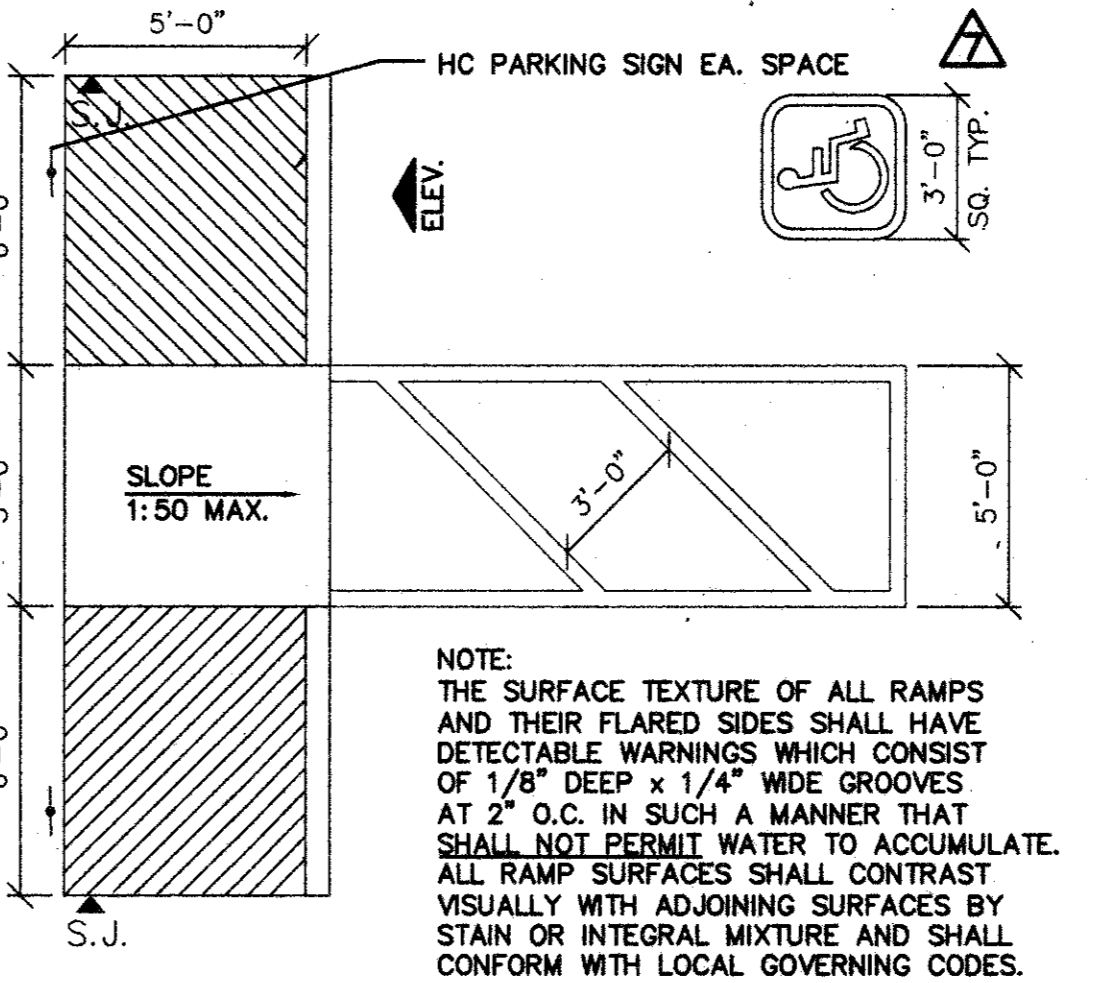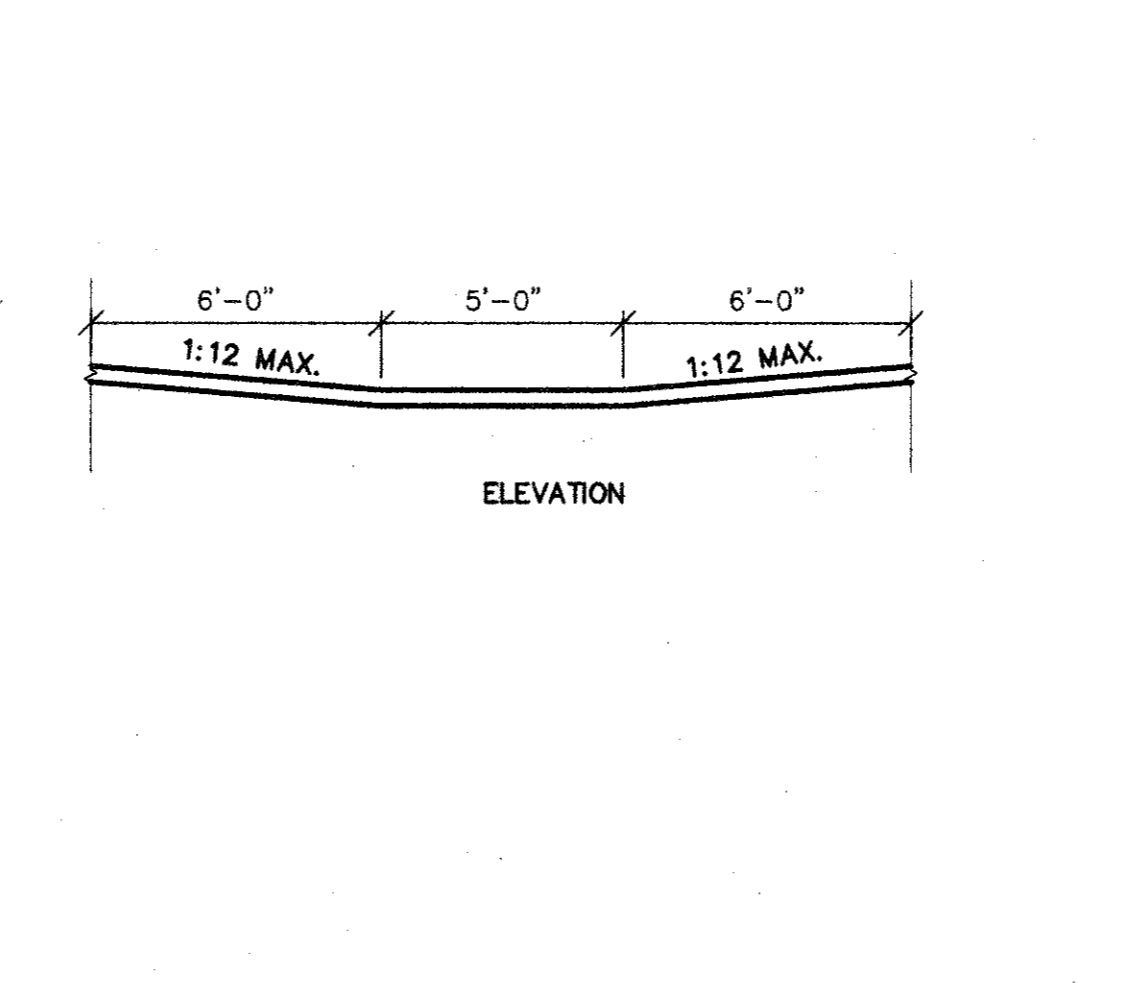


HANDICAP PARKING SCALE: 1/4"=1'-0" 1.103

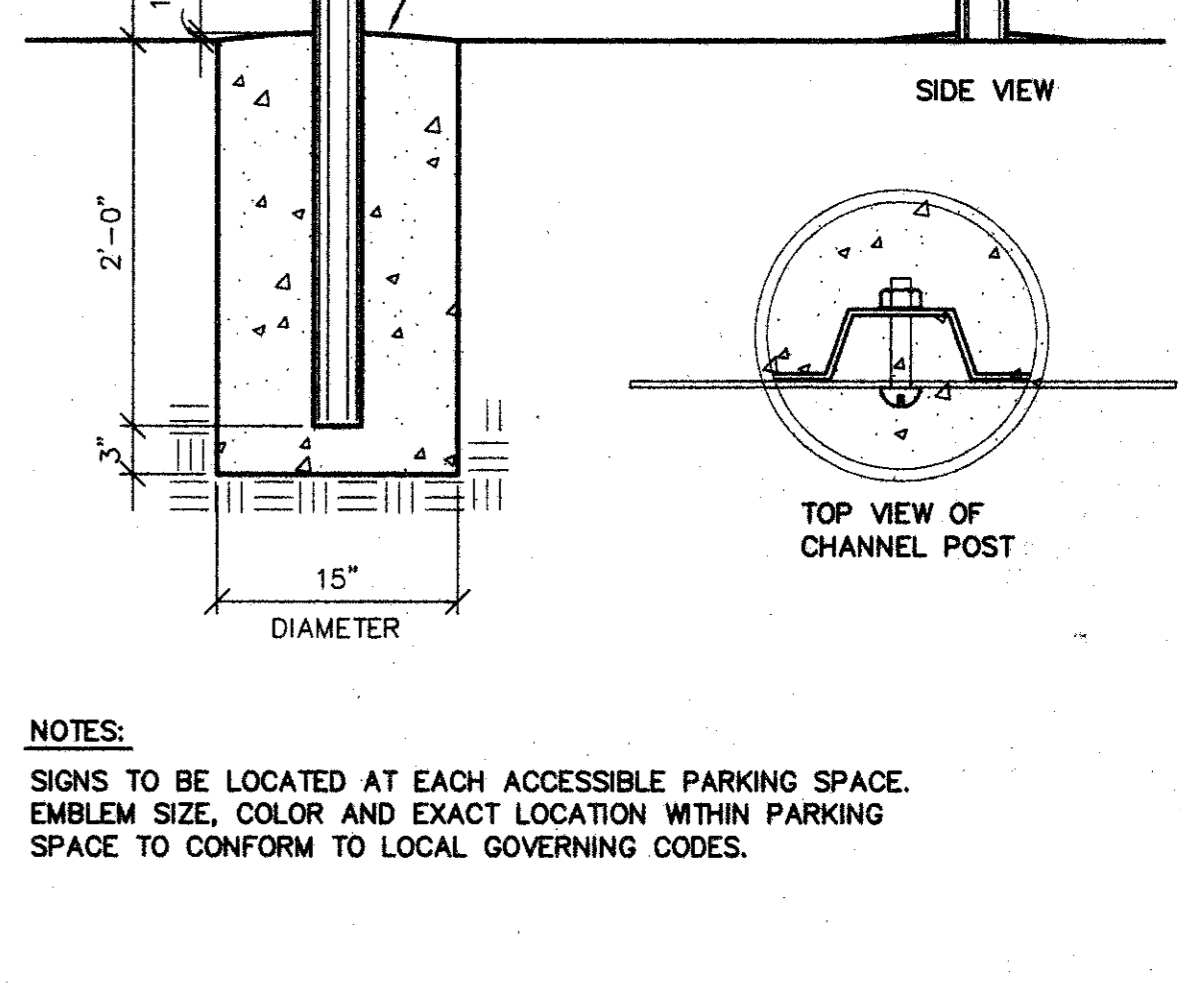

HANDICAP SIGN SCALE: 1"=1'-0" 1.102

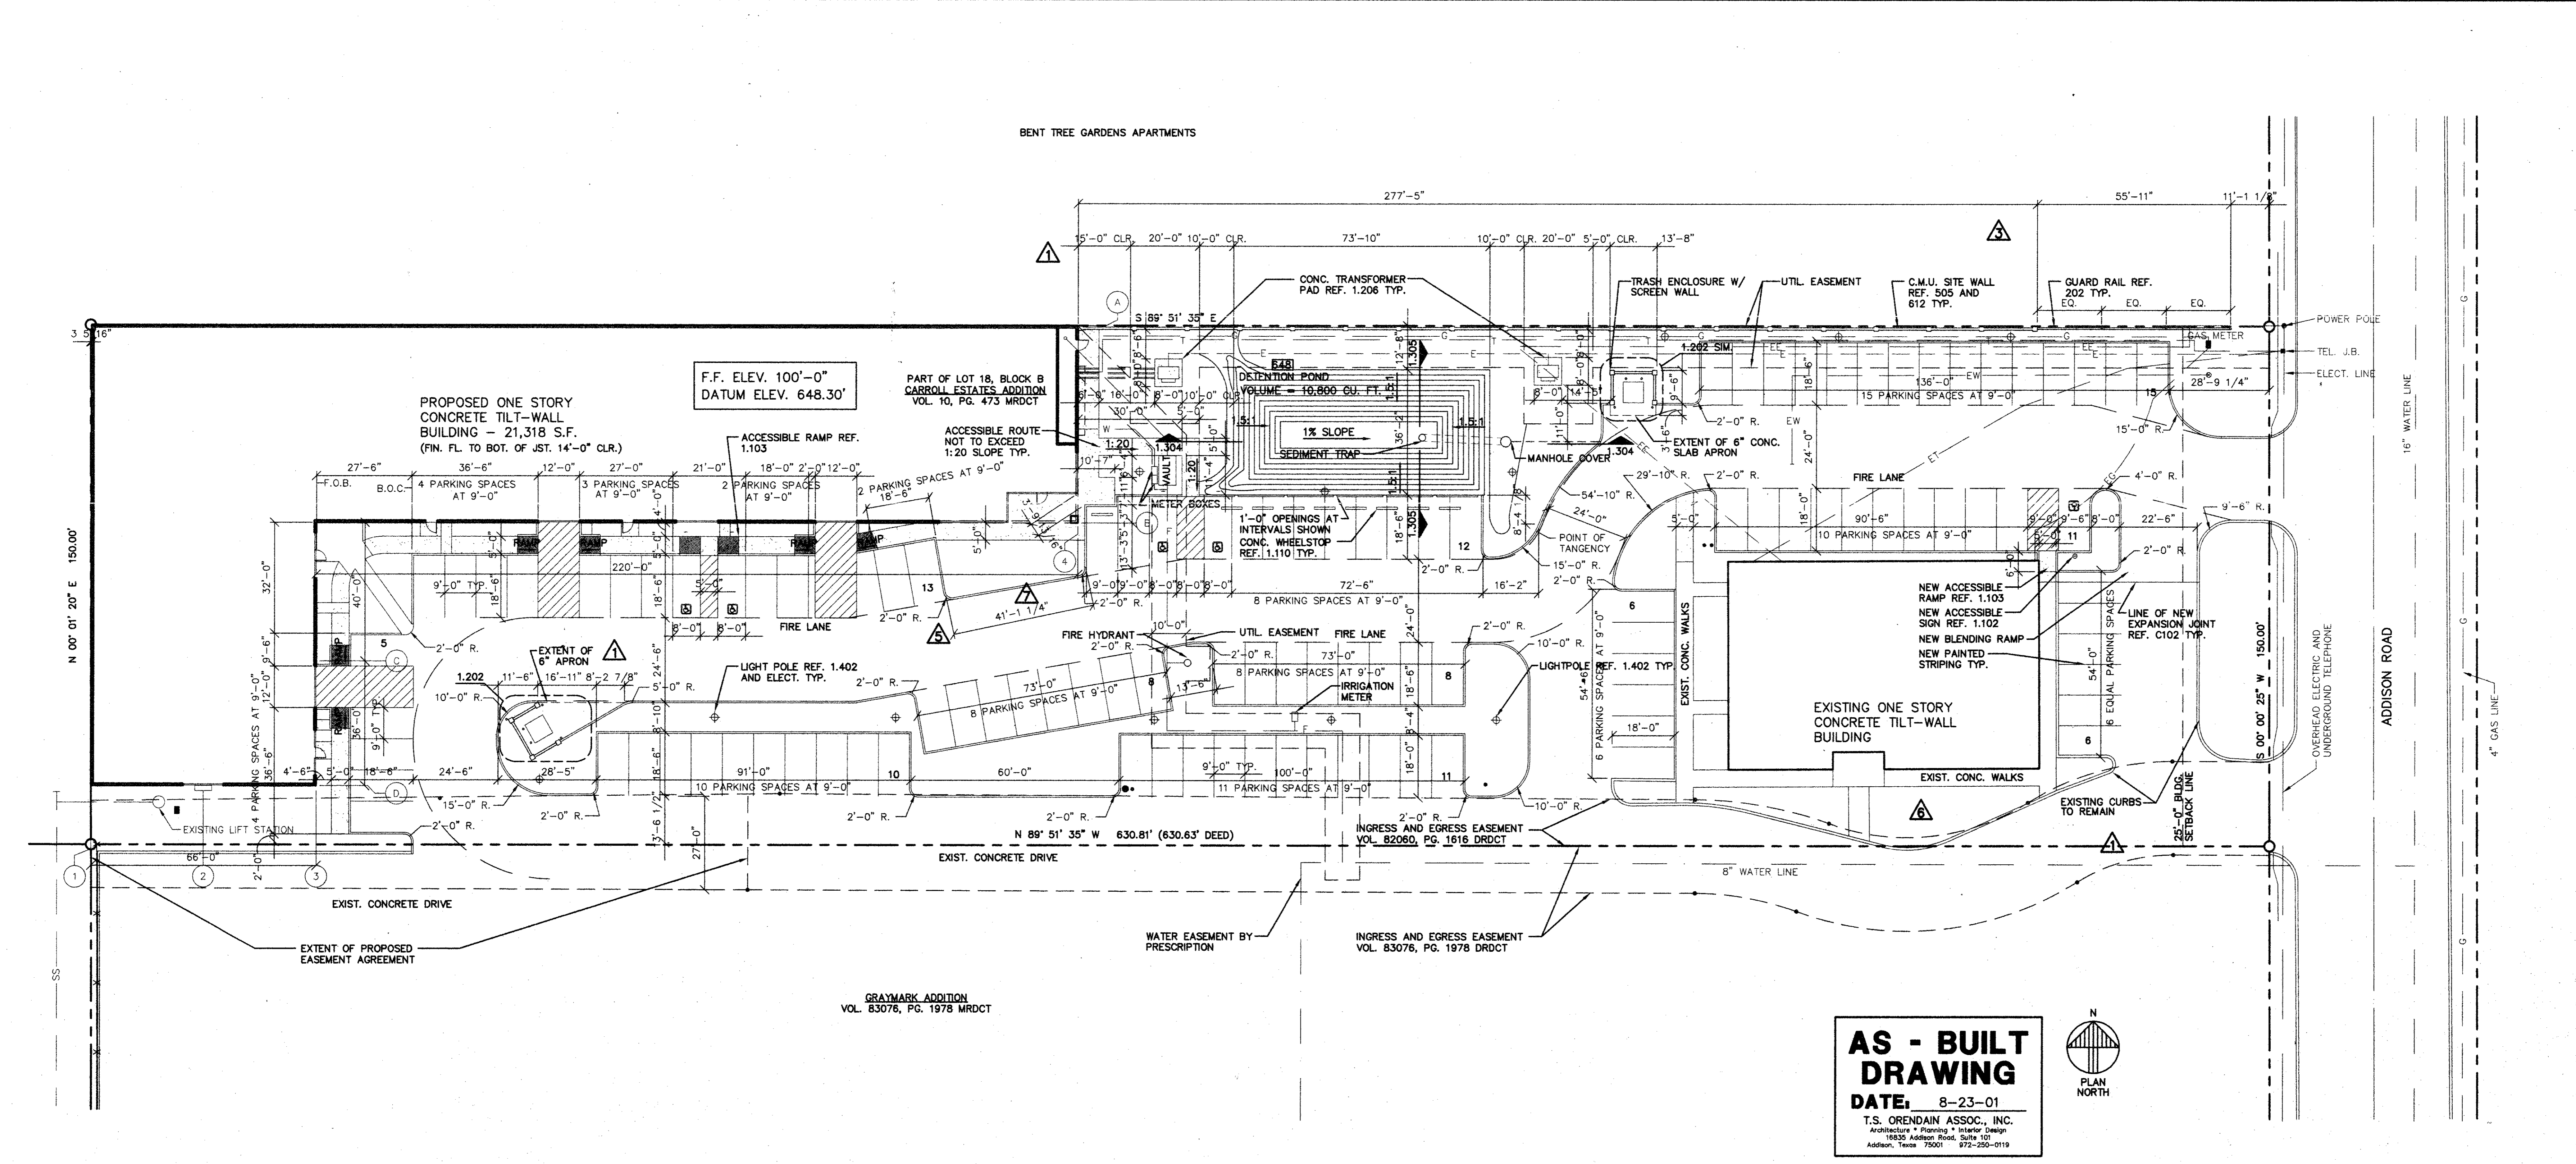


AS - BUILT DRAWING
 DATE: 8-23-01
 T.S. OREDAIN ASSOC., INC.
 Architecture • Planning • Interior Design
 16835 Addison Road, Suite 101
 Addison, Texas 75001 972-250-0119

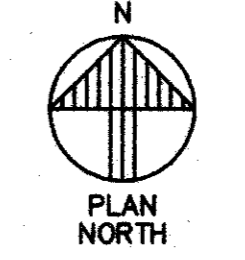

SITE PLAN SCALE: 1"=20'-0" 1.101

AMO
 16835 ADDISON ROAD
 ADDISON, TX 75001
 TEL: 972-250-0119
 FAX: 972-250-3157

**ADDISON PARK CENTRE
 OFFICE/TECH./FLEX.
 PHASE 1**
 16835 ADDISON ROAD ADDISON, TEXAS

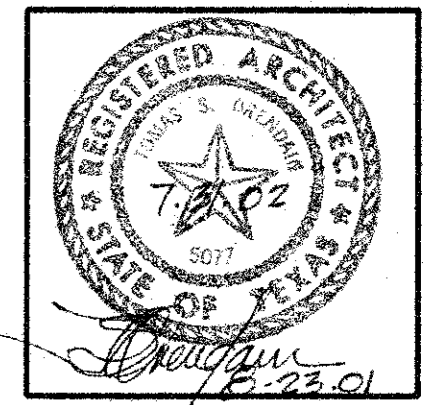

T.S. Orendain Associates Inc.
 Architecture • Planning • Interior Design
 16835 Addison Road
 Suite 101
 Addison, Texas 75001
 (972) 250-0119

JOB: 8396 DATE: 2/25/2000
 DRAWN: T.S.O. CHECKED: T.S.O.

Date	Issued For / Description
2-25-2000	100% ISSUED FOR CONSTRUCTION
8-9-2000	GENERAL REVISION
9-13-2000	SITE WALL REVISION
11-20-2000	DRIVE ADDED
12-8-2000	EXIST. PARKING REVISION
2-9-2001	GENERAL REVISION

SITE PLAN AND DETAILS