


CEILING DETAIL SCALE: 3/8"=1'-0" 206

CEILING DETAIL SCALE: 3/8"=1'-0" 205

CEILING DETAIL SCALE: 3/8"=1'-0" 204

REFLECTED CEILING SCALE: 1/4"=1'-0" 203

NOT USED SCALE: NONE 202

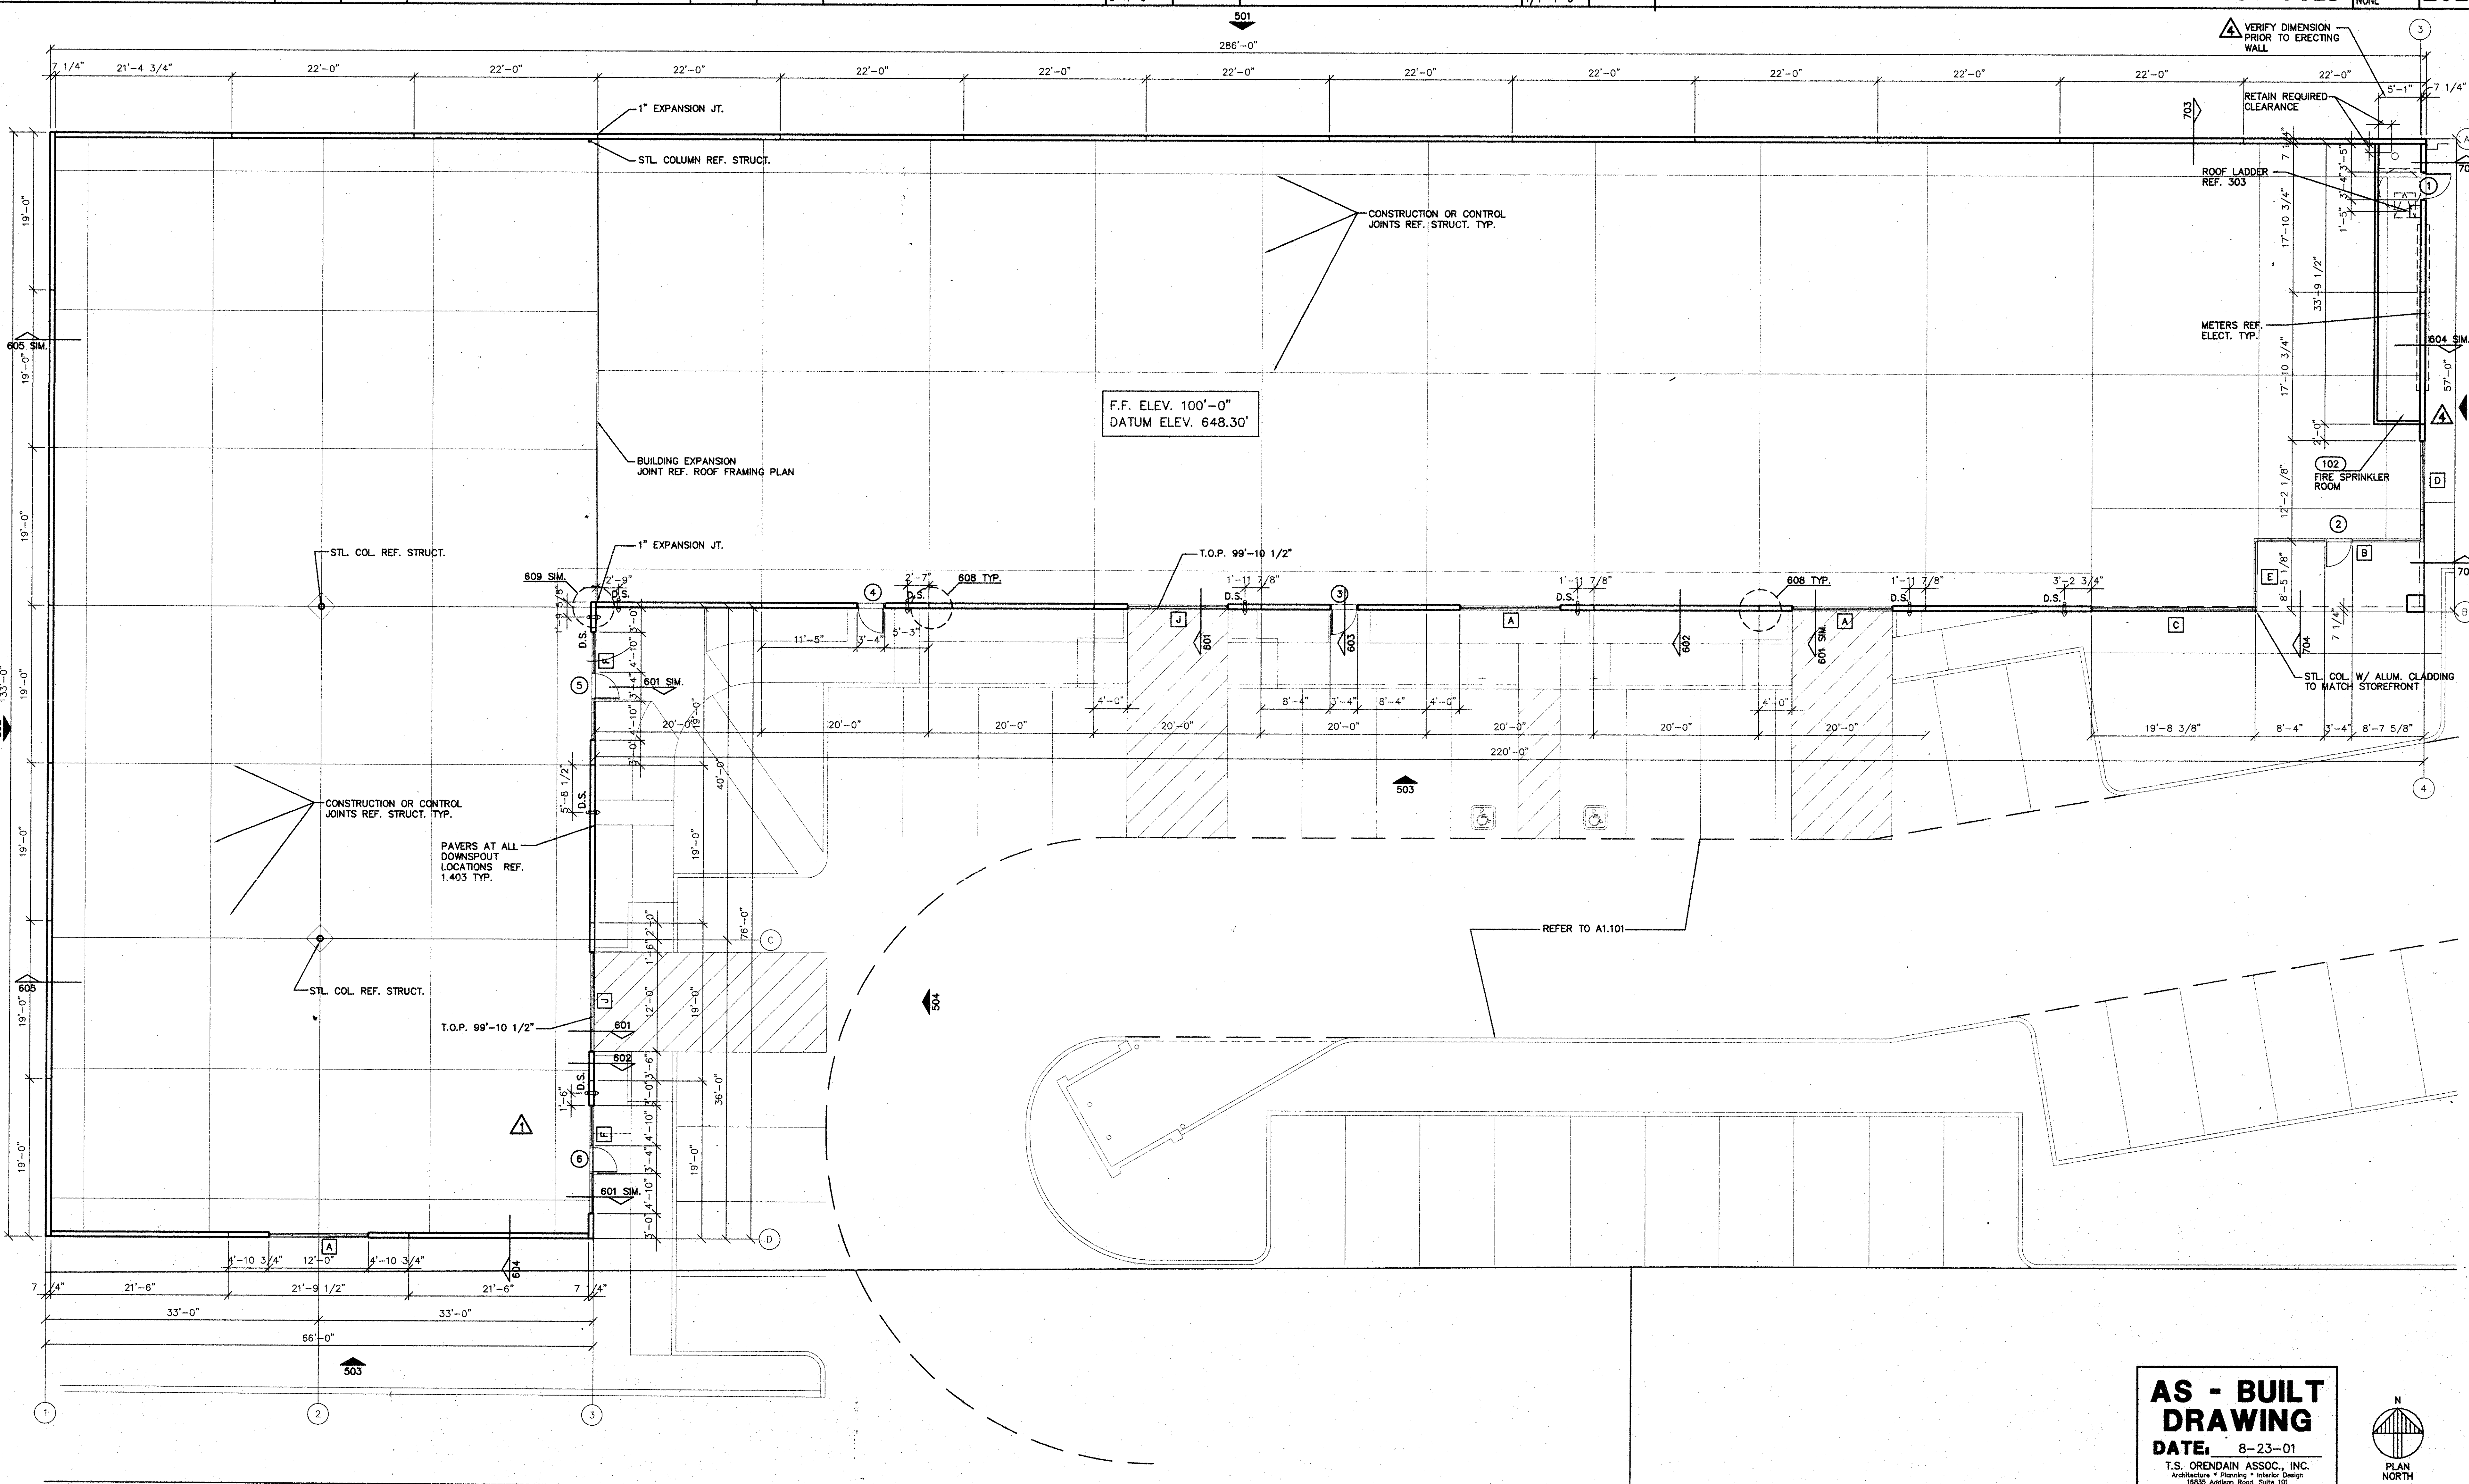


**AS - BUILT DRAWING**  
 DATE: 8-23-01  
 T.S. ORENDAIN ASSOC., INC.  
 ARCHITECTURE • PLANNING • INTERIOR DESIGN  
 16835 Addison Road, Suite 101  
 Addison, Texas 75001 972-250-0119

FLOOR PLAN SCALE: 1/8"=1'-0" 201

**AMO**  
 16835 ADDISON ROAD  
 SUITE 101  
 ADDISON, TX 75001  
 TEL: 972-250-3157  
 FAX: 972-250-3157

**ADDISON PARK CENTRE  
 OFFICE/TECH./FLEX.  
 PHASE 1**  
 16835 ADDISON ROAD ADDISON, TEXAS

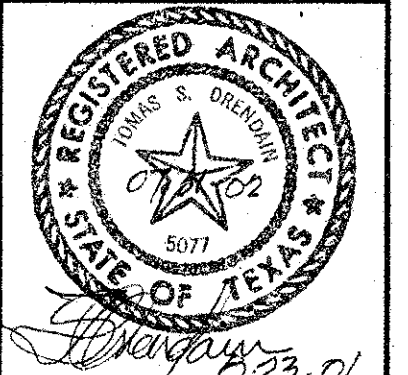

**to**  
 T.S. Orendain Associates Inc.  
 Architecture • Planning • Interior Design  
 16835 Addison Road  
 Suite 101  
 Addison, Texas 75001  
 (972) 250-0119

JOB: 8396 DATE: 2/25/2000  
 DRAWN: T.S.O. CHECKED: T.S.O.

Date	Issued For / Description	By
8-5-97	SCHEMATIC CITY REVIEW	
9-30-98	PERMIT ISSUE	
11-1-99	T.D.L.R.	
2-25-2000	100% ISSUED FOR CONSTRUCTION	
6-9-2000	GENERAL REVISION	
11-3-2000	FIRE SPRINKLER ROOM REVISION	

FLOOR PLAN

A-2