




DOWNSPOUT DETAIL SCALE: 1/2"=1'-0" 307

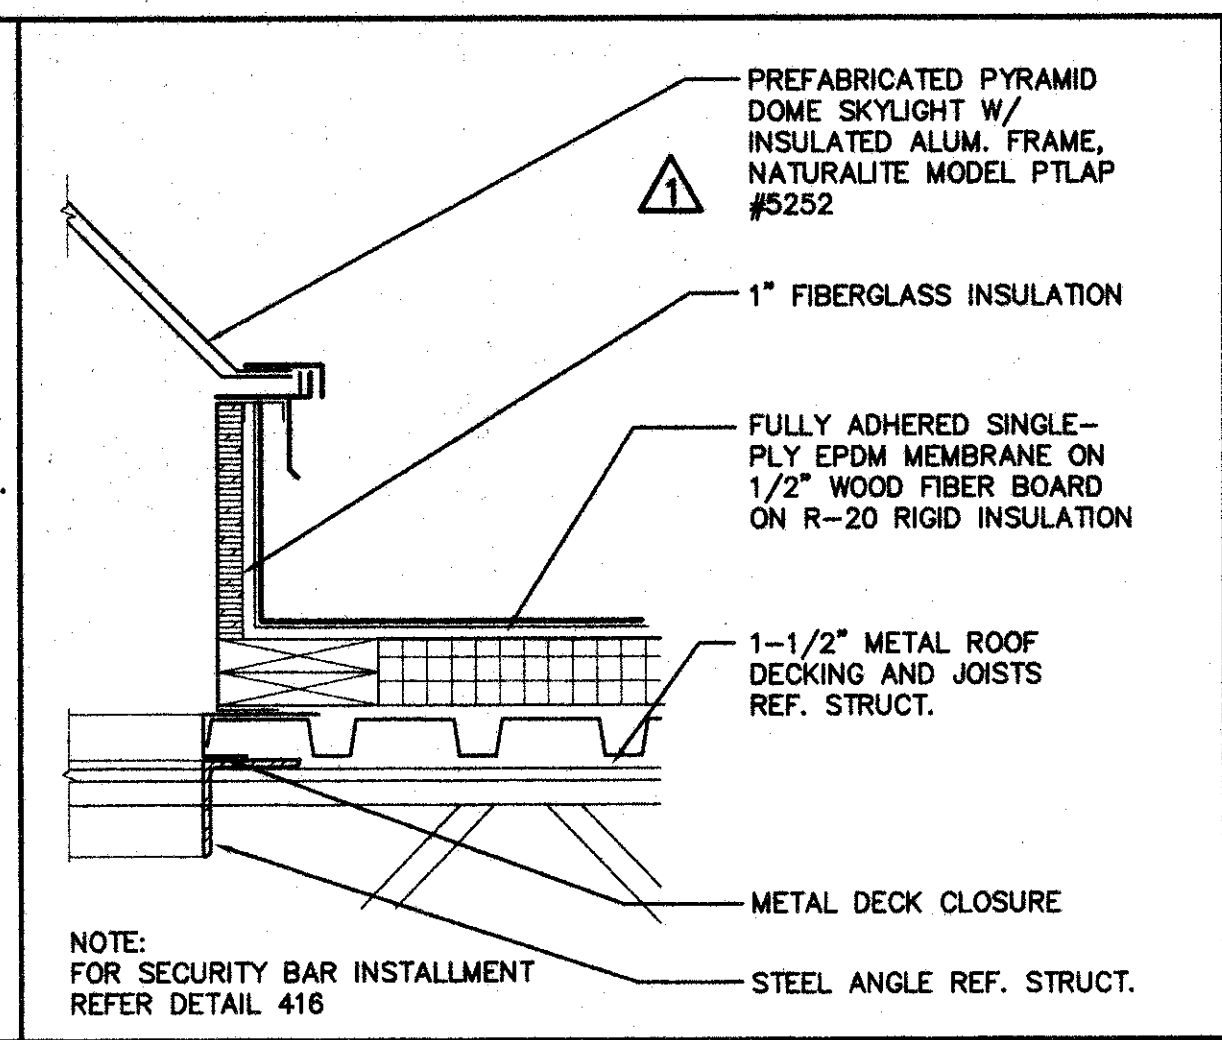


SKYLIGHT DETAIL SCALE: 1/2"=1'-0" 306

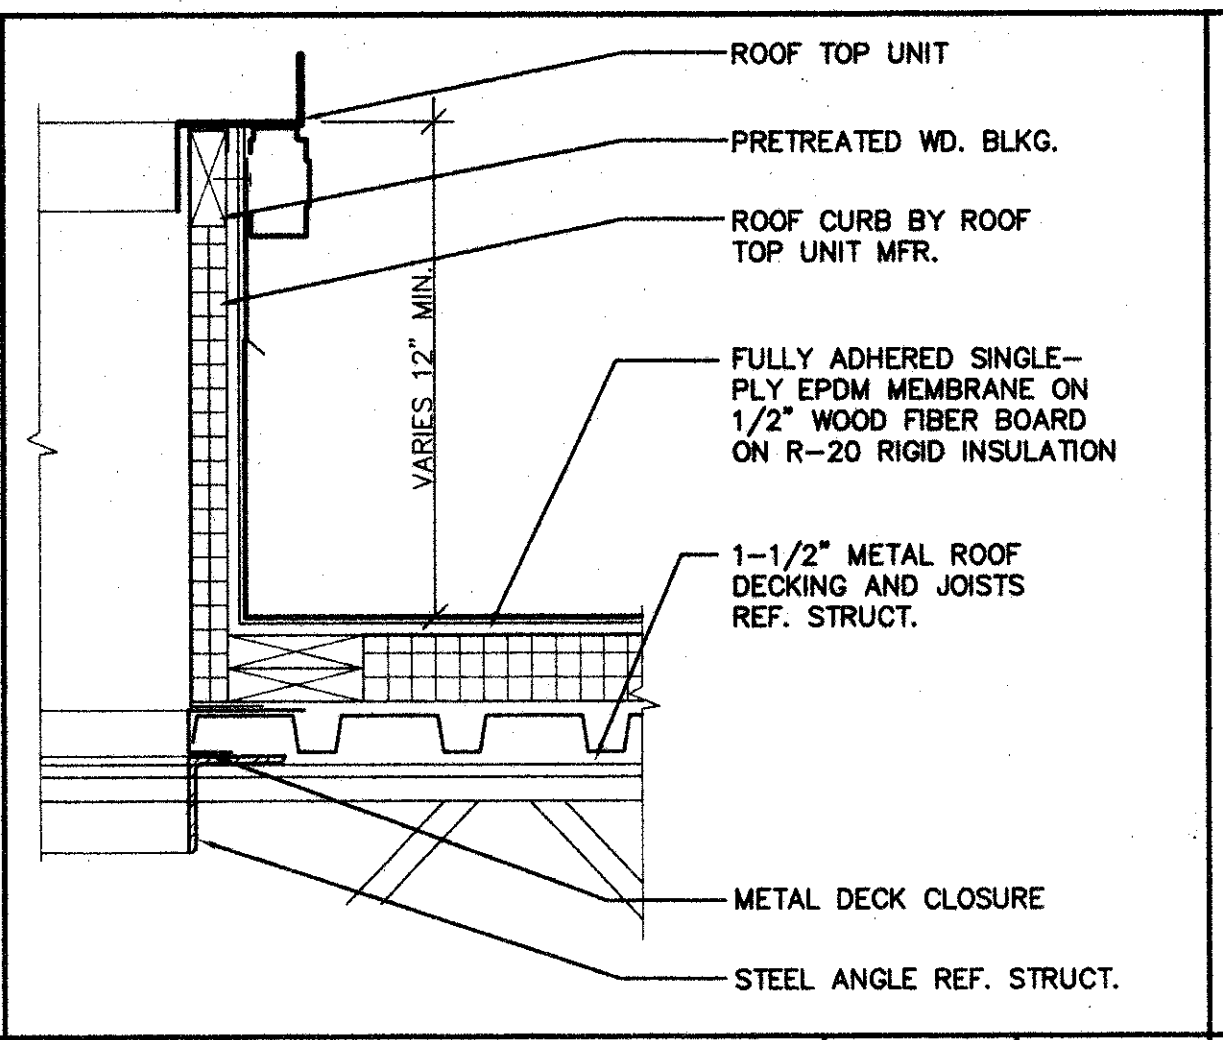


MECH. CURB DETAIL SCALE: 1/2"=1'-0" 305

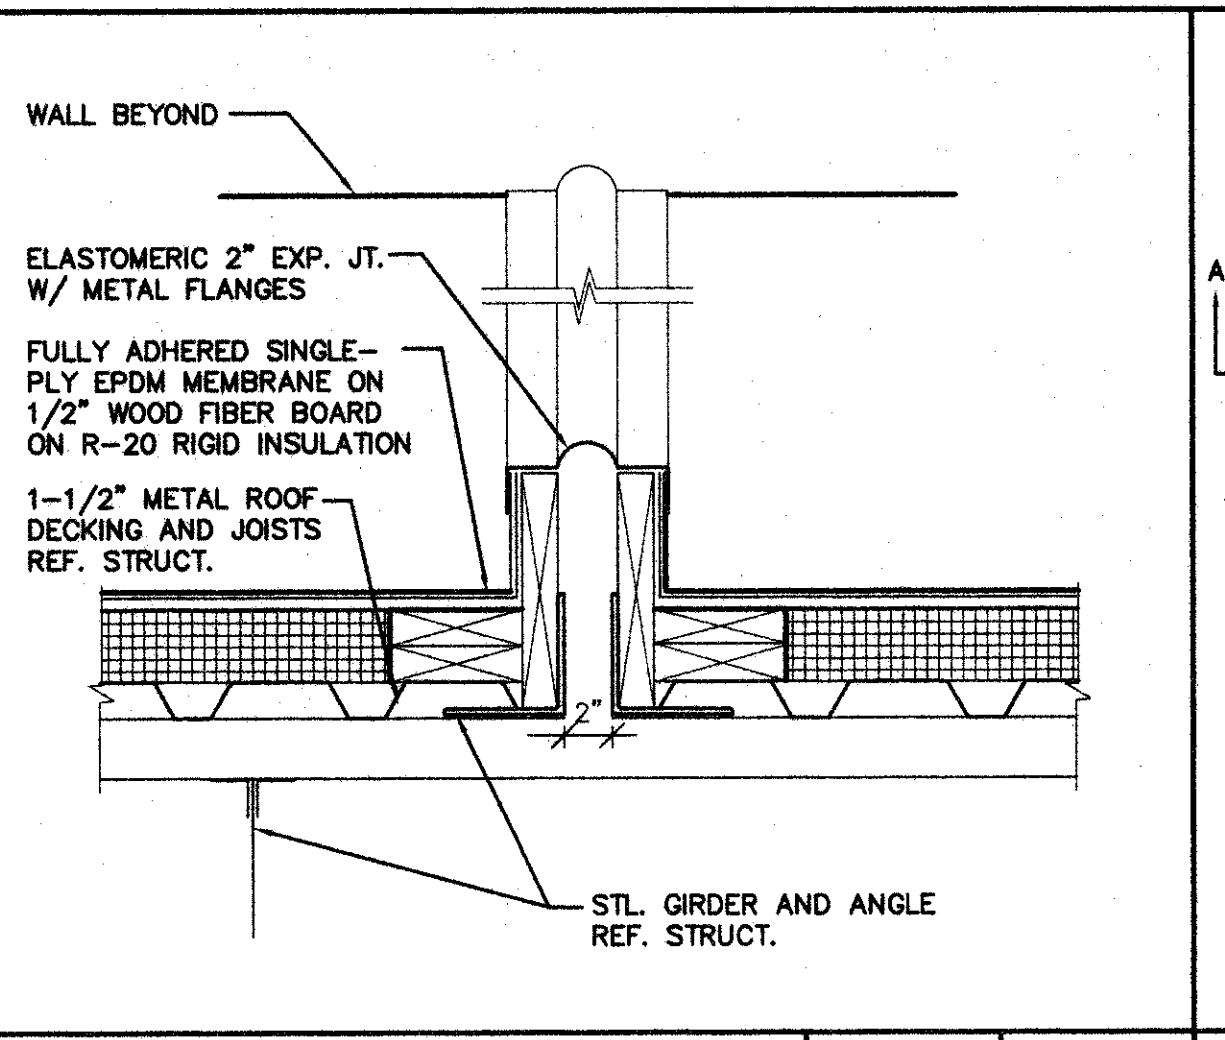


ROOF EXPANSION JT. SCALE: 1/2"=1'-0" 304

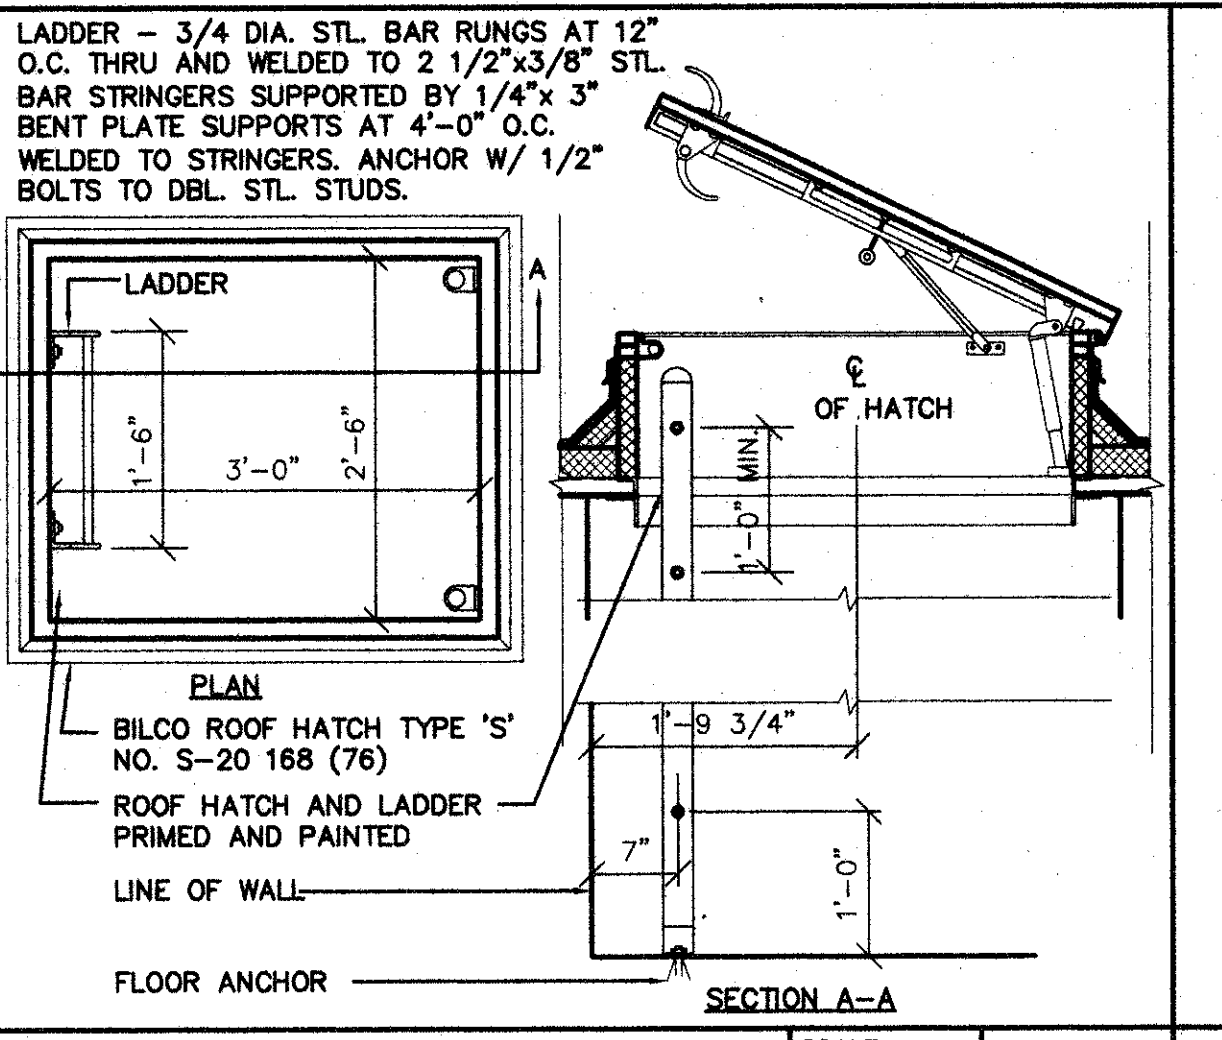

ROOF HATCH DETAIL SCALE: 3/4"=1'-0" 303

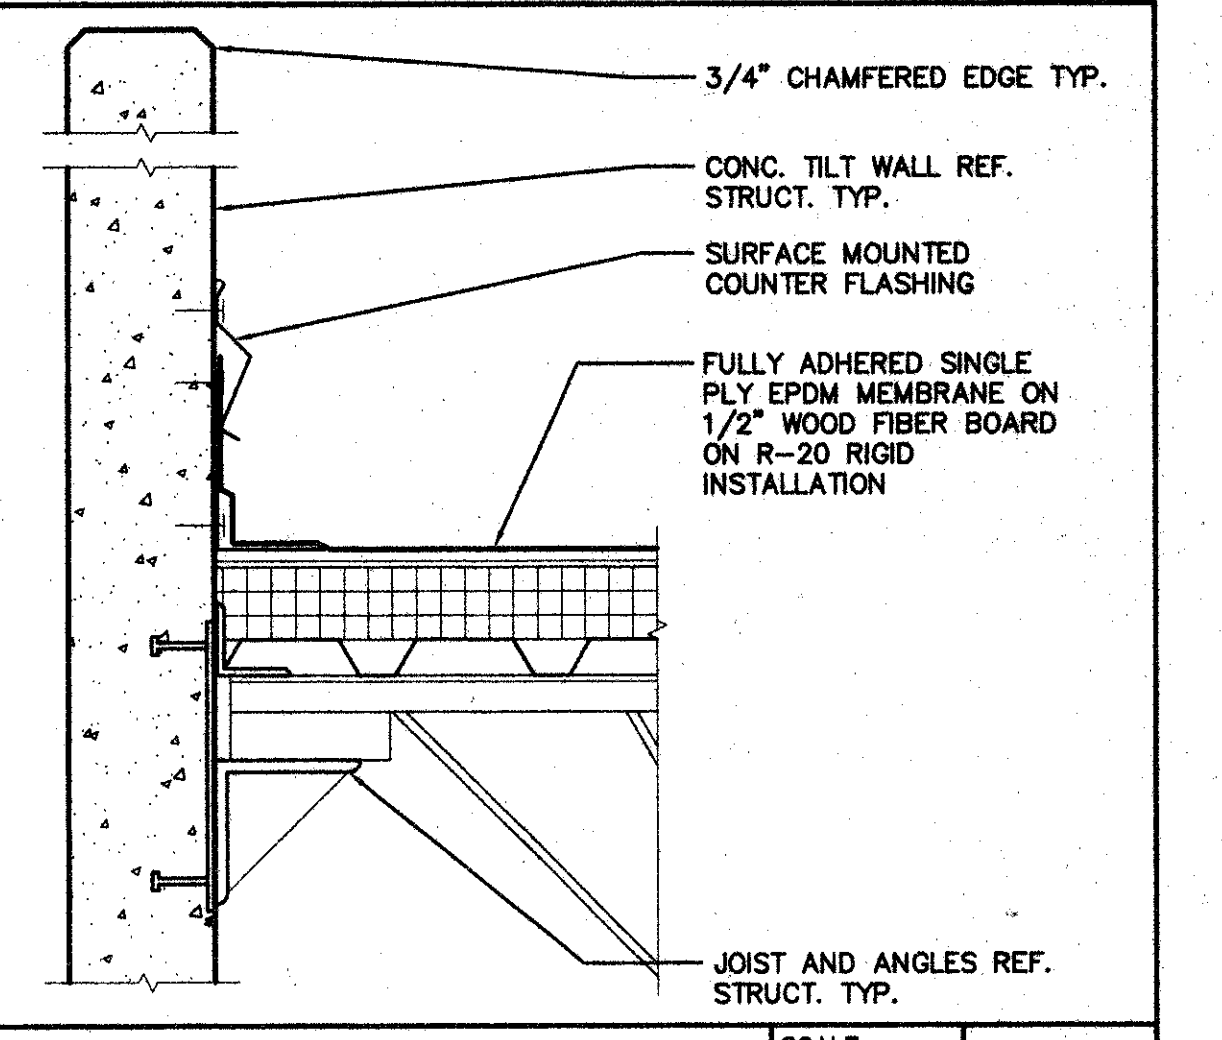


ROOF DETAIL SCALE: 1/2"=1'-0" 302

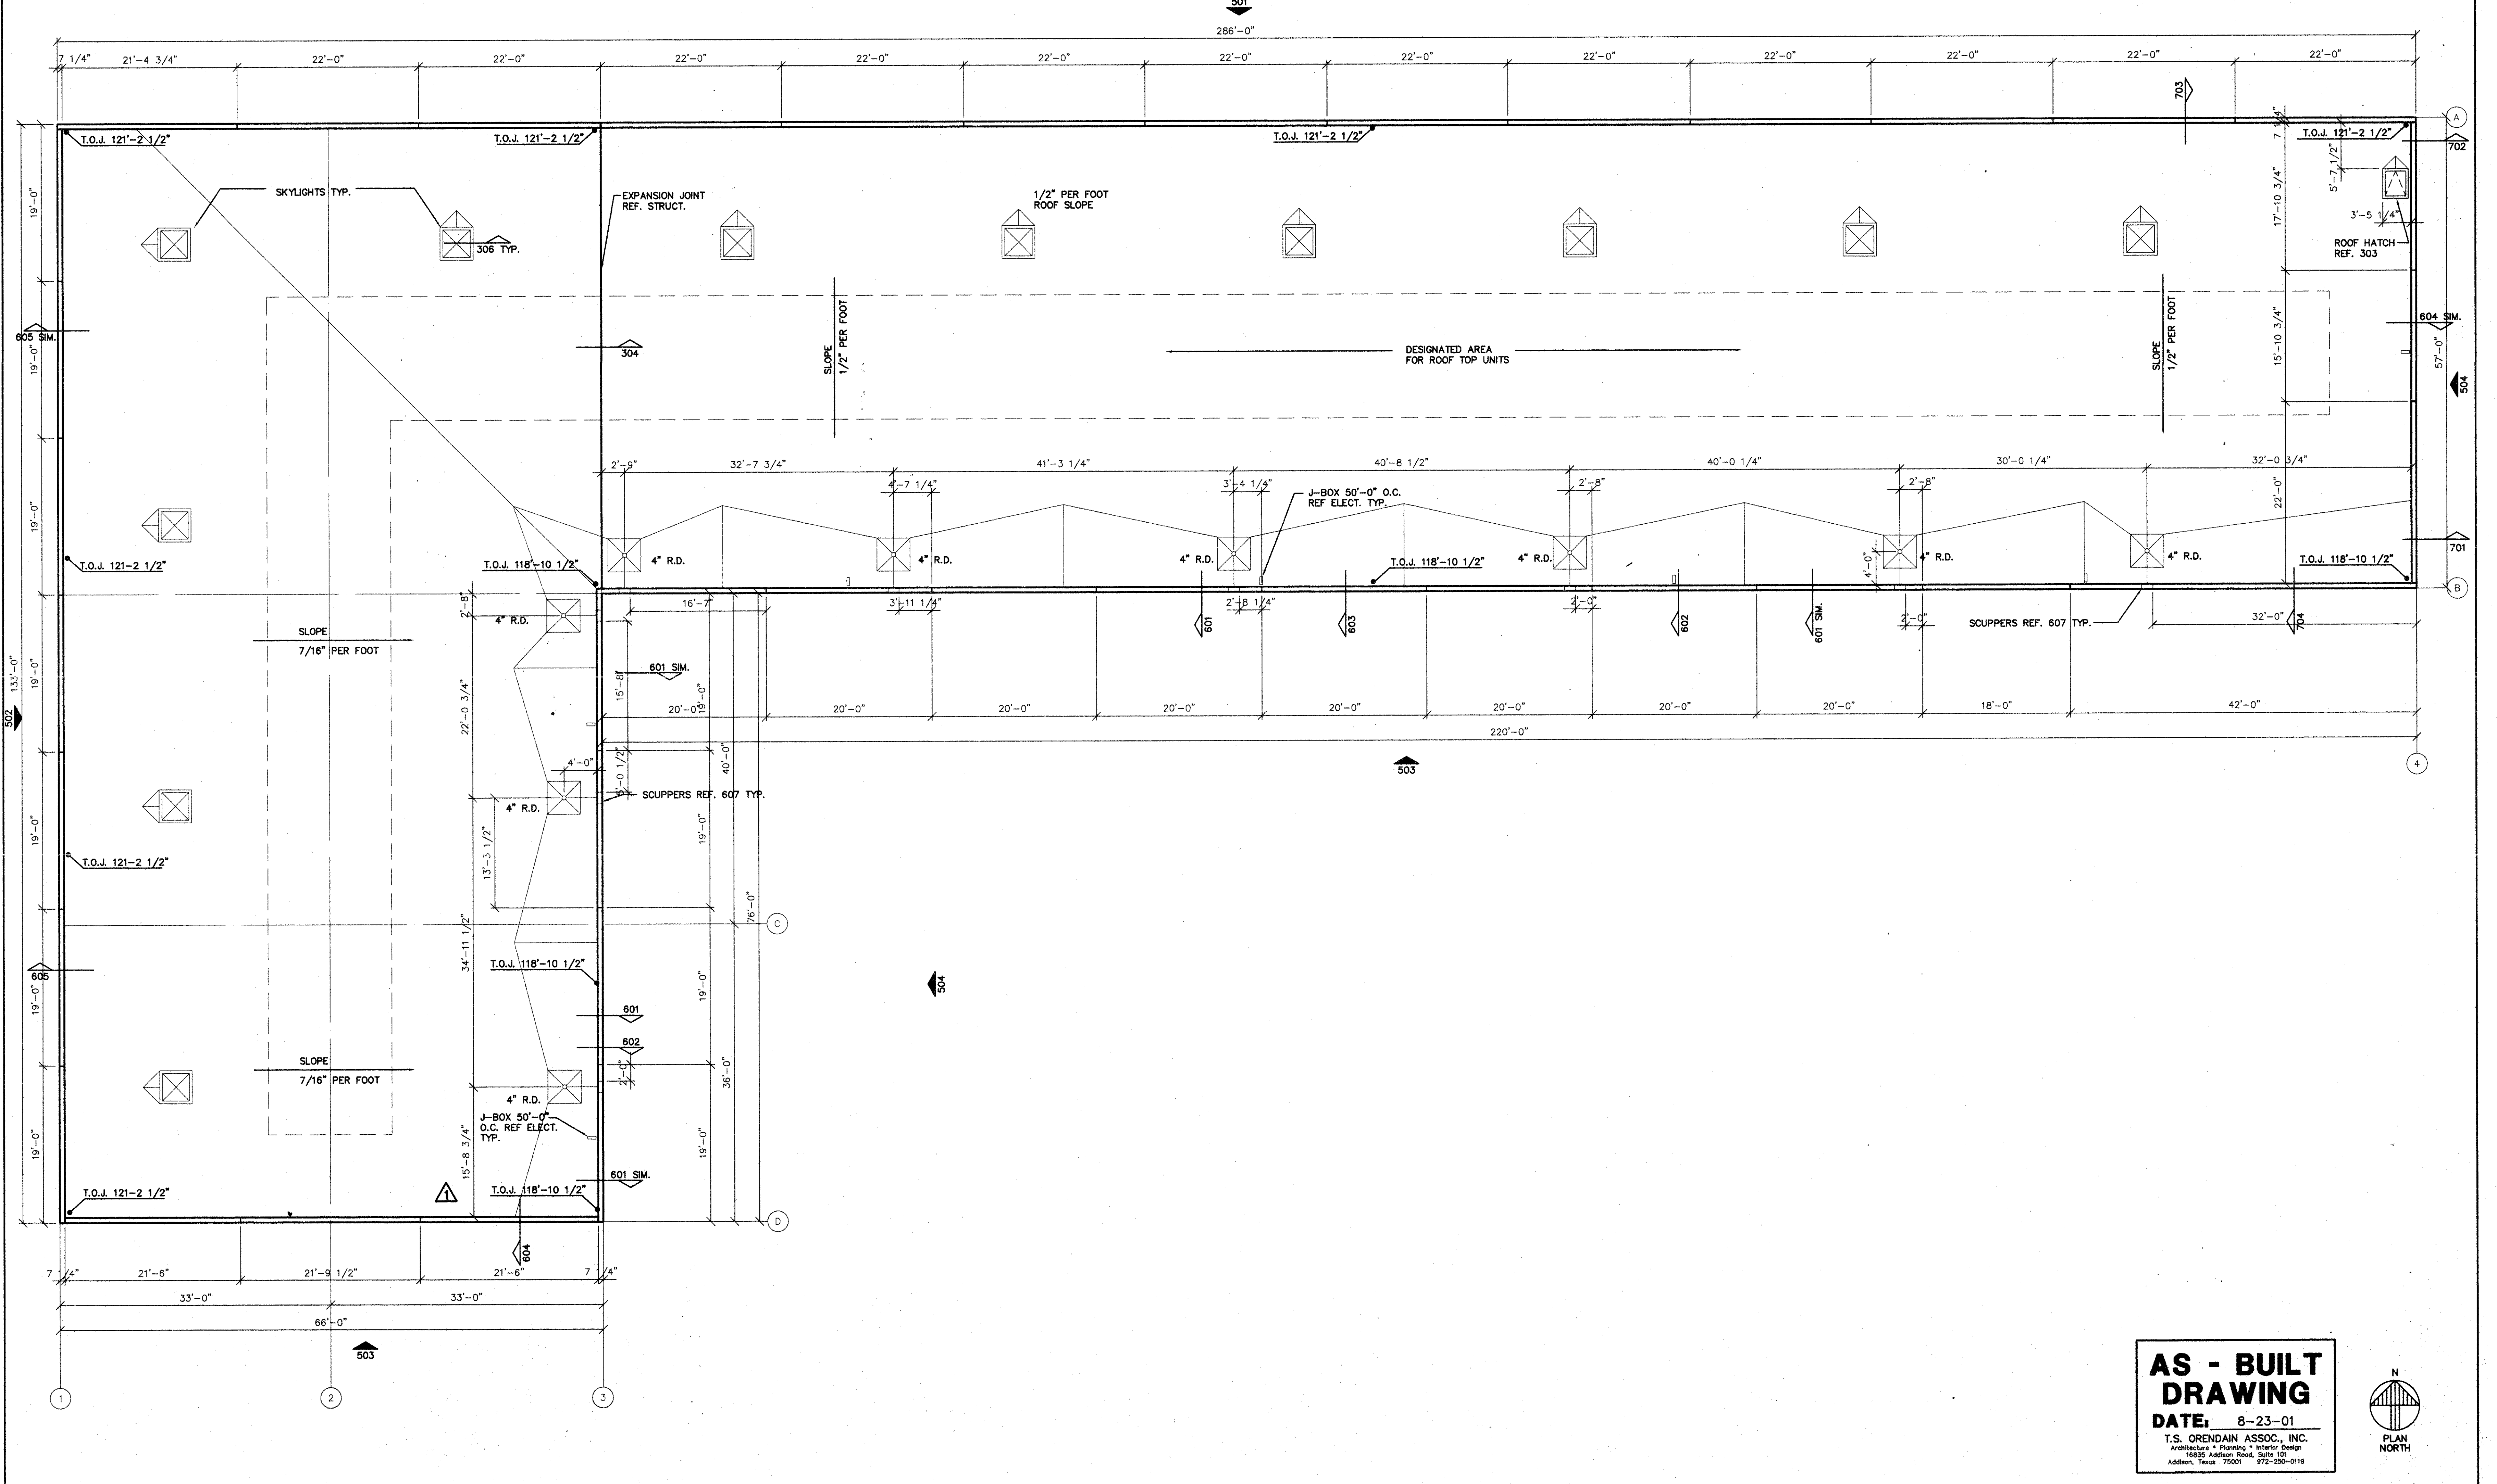


ROOF PLAN SCALE: 1/8"=1'-0" 301

AS - BUILT DRAWING
 DATE: 8-23-01
 T.S. ORENDAIN ASSOC., INC.
 Architecture • Planning • Interior Design
 16835 Addison Road, Suite 101
 Addison, Texas 75001
 (972) 250-0119

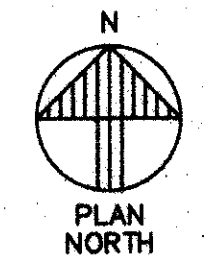

AMO
 16835 ADDISON ROAD
 ADDISON, TX 75001
 TEL: 972-250-0119
 FAX: 972-250-3151

**ADDISON PARK CENTRE
 OFFICE/TECH./FLEX.
 PHASE 1**
 16835 ADDISON ROAD ADDISON, TEXAS

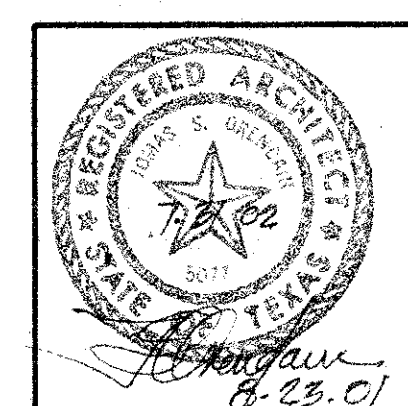

to
 T.S. Orendain Associates Inc.
 Architecture • Planning • Interior Design
 16835 Addison Road
 Suite 101
 Addison, Texas 75001
 (972) 250-0119

JOB: 8396 DATE: 2/25/2000
 DRAWN: T.S.O. CHECKED: T.S.O.

| Date | Issued For / Description |
|----------|------------------------------|
| 8-5-97 | SCHEMATIC CITY REVIEW |
| 9-30-98 | PERMIT ISSUE |
| 11-1-99 | T.O.L.R. |
| 2-9-2000 | 100% ISSUED FOR CONSTRUCTION |
| 6-9-2000 | GENERAL REVISION |

ROOF PLAN AND DETAILS

A-3