


**AS - BUILT  
DRAWING**  
DATE: 8-23-01  
T.S. ORENDAIN ASSOC., INC.  
Architecture • Planning • Interior Design  
16835 Addison Road, Suite 101  
Addison, Texas 75001 972-250-0119

**AMO**  
16835 ADDISON ROAD  
SUITE 101  
ADDISON, TX 75001  
PHONE: 972-250-3177  
FAX: 972-250-3177

**ADDISON PARK CENTRE  
OFFICE/TECH./FLEX.  
PHASE 1**  
16835 ADDISON ROAD ADDISON, TEXAS

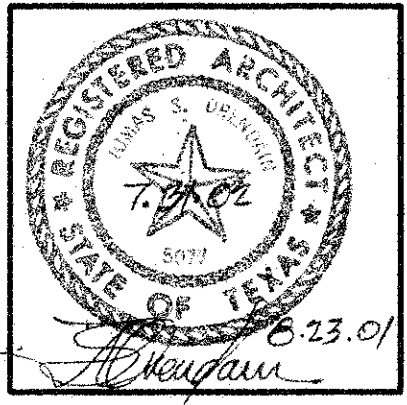

**to**  
T.S. Orendain Associates Inc.  
Architecture • Planning • Interior Design  
16835 Addison Road  
Suite 101  
Addison, Texas 75001  
(972) 250-0119  
JOB: 8396 DATE: 2/25/2000  
DRAWN: T.S.O. CHECKED: T.S.O.

Date	Issued For / Description	By
6-5-97	SCHEMATIC CITY REVIEW	
9-30-98	PERMIT ISSUE	
11-1-99	T.D.L.R.	
2-25-00	100% ISSUED FOR CONSTRUCTION	
6-9-2000	GENERAL REVISION	
9-13-2000	SITE WALL REVISION	

EXTERIOR ELEVATIONS  
A-5