




SITE WALL ELEVATION SCALE: 1/8"=1'-0" 612

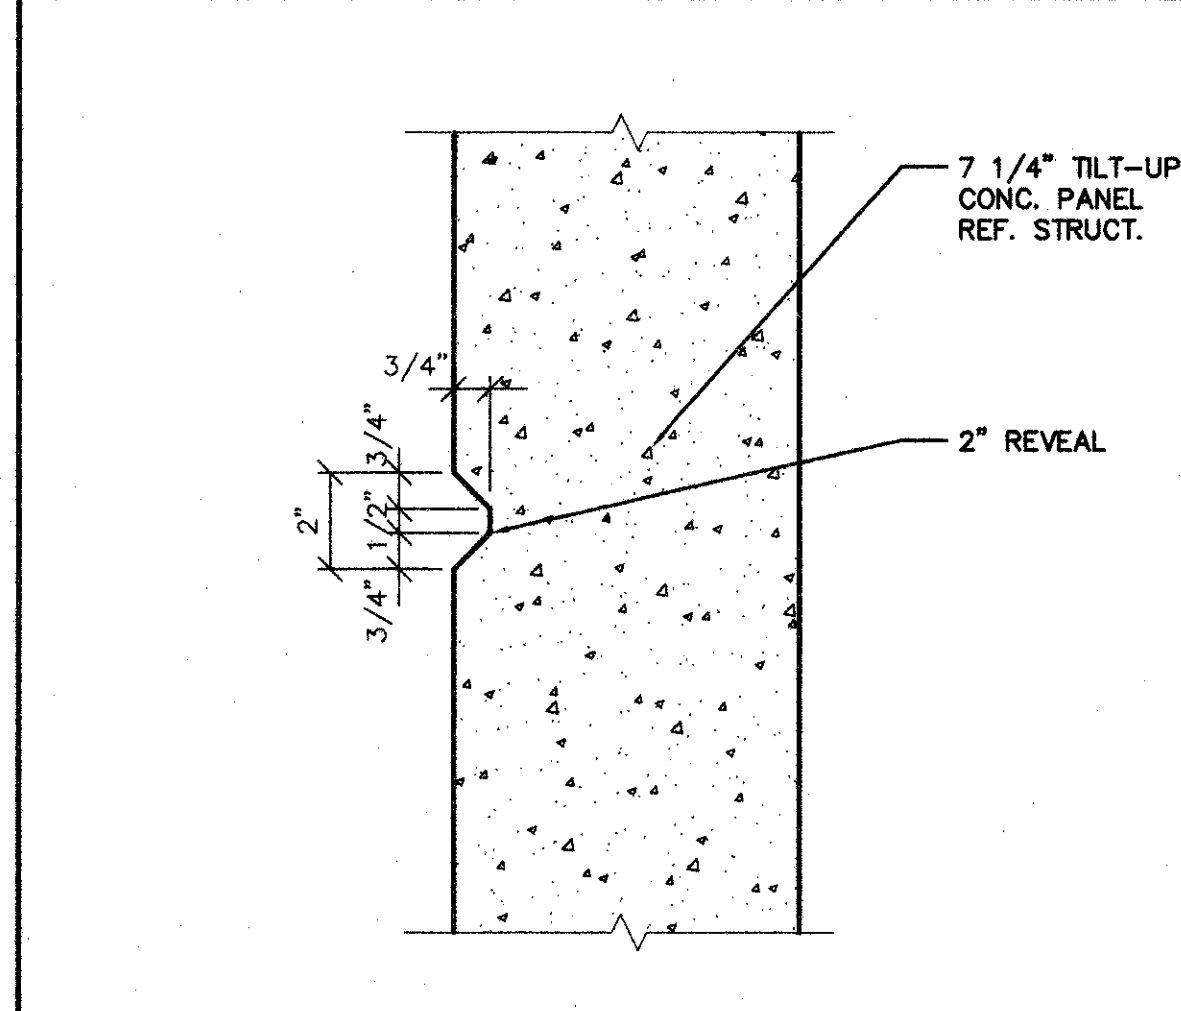


REVEAL DETAIL SCALE: 3/8"=1'-0" 611

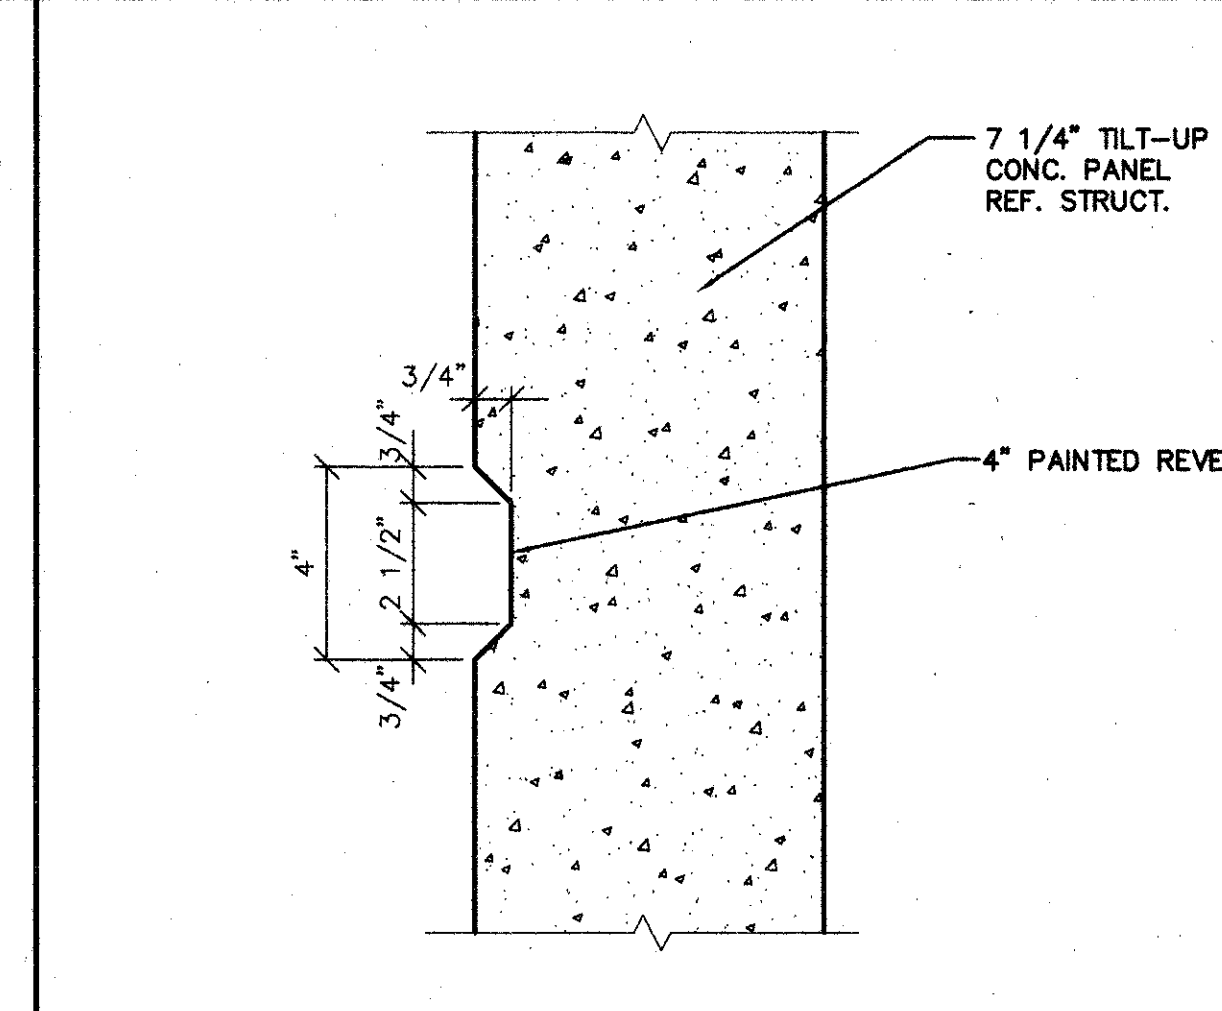


REVEAL DETAIL SCALE: 3/8"=1'-0" 610

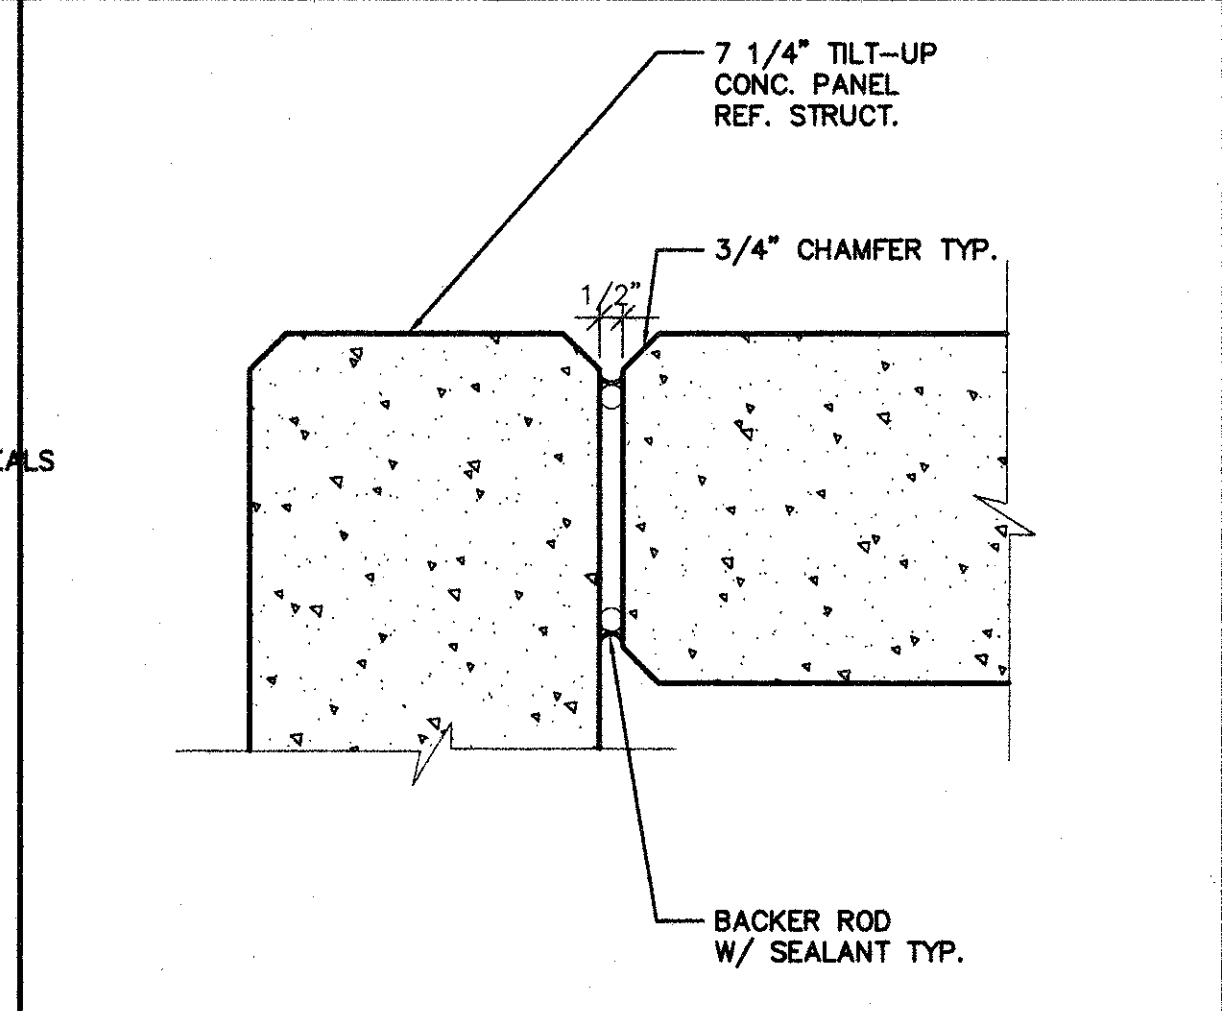


PANEL JOINT DETAIL SCALE: 3/8"=1'-0" 609

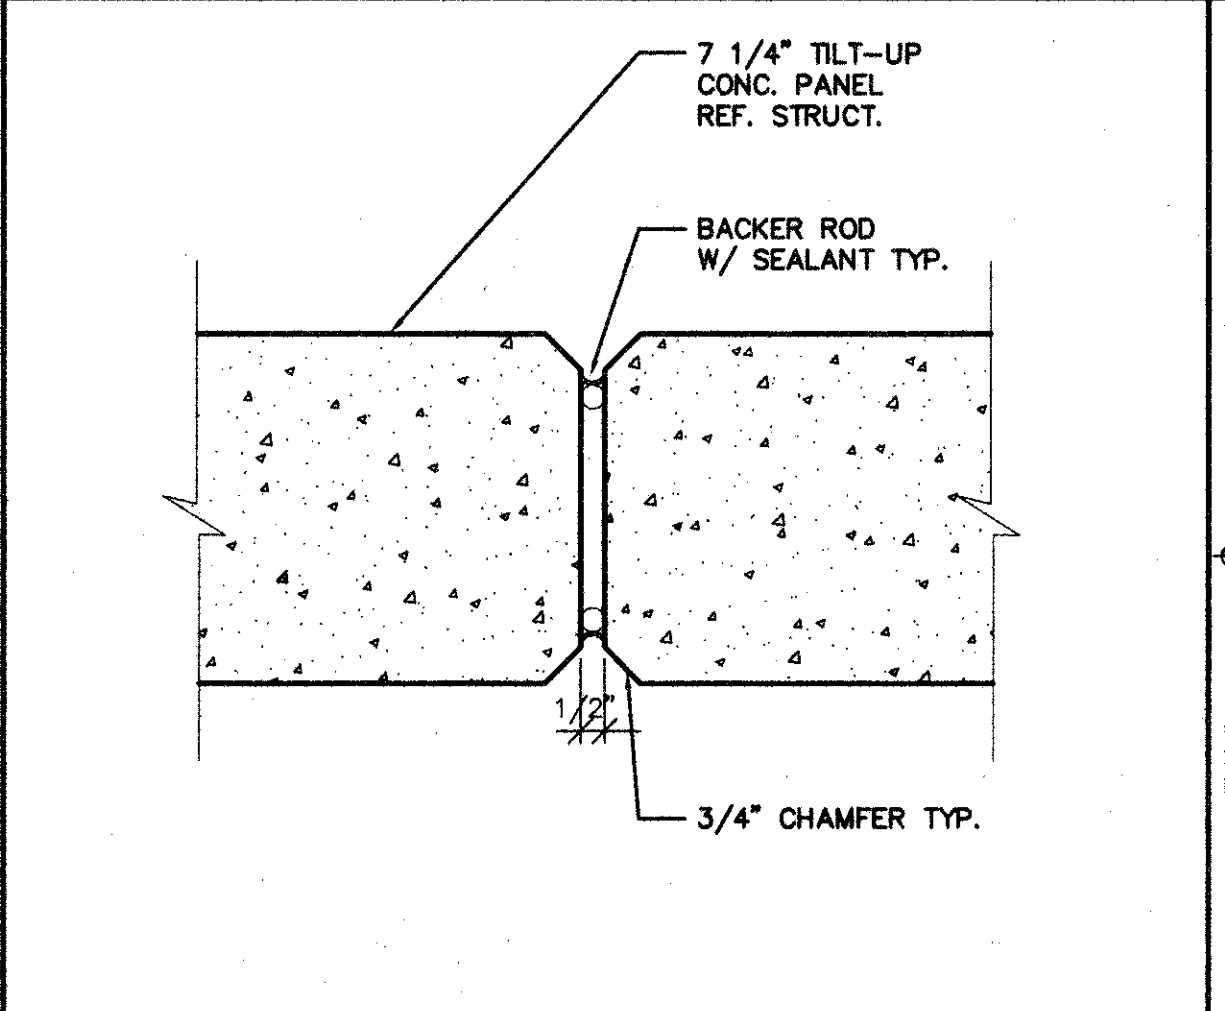


PANEL JOINT DETAIL SCALE: 3/8"=1'-0" 608

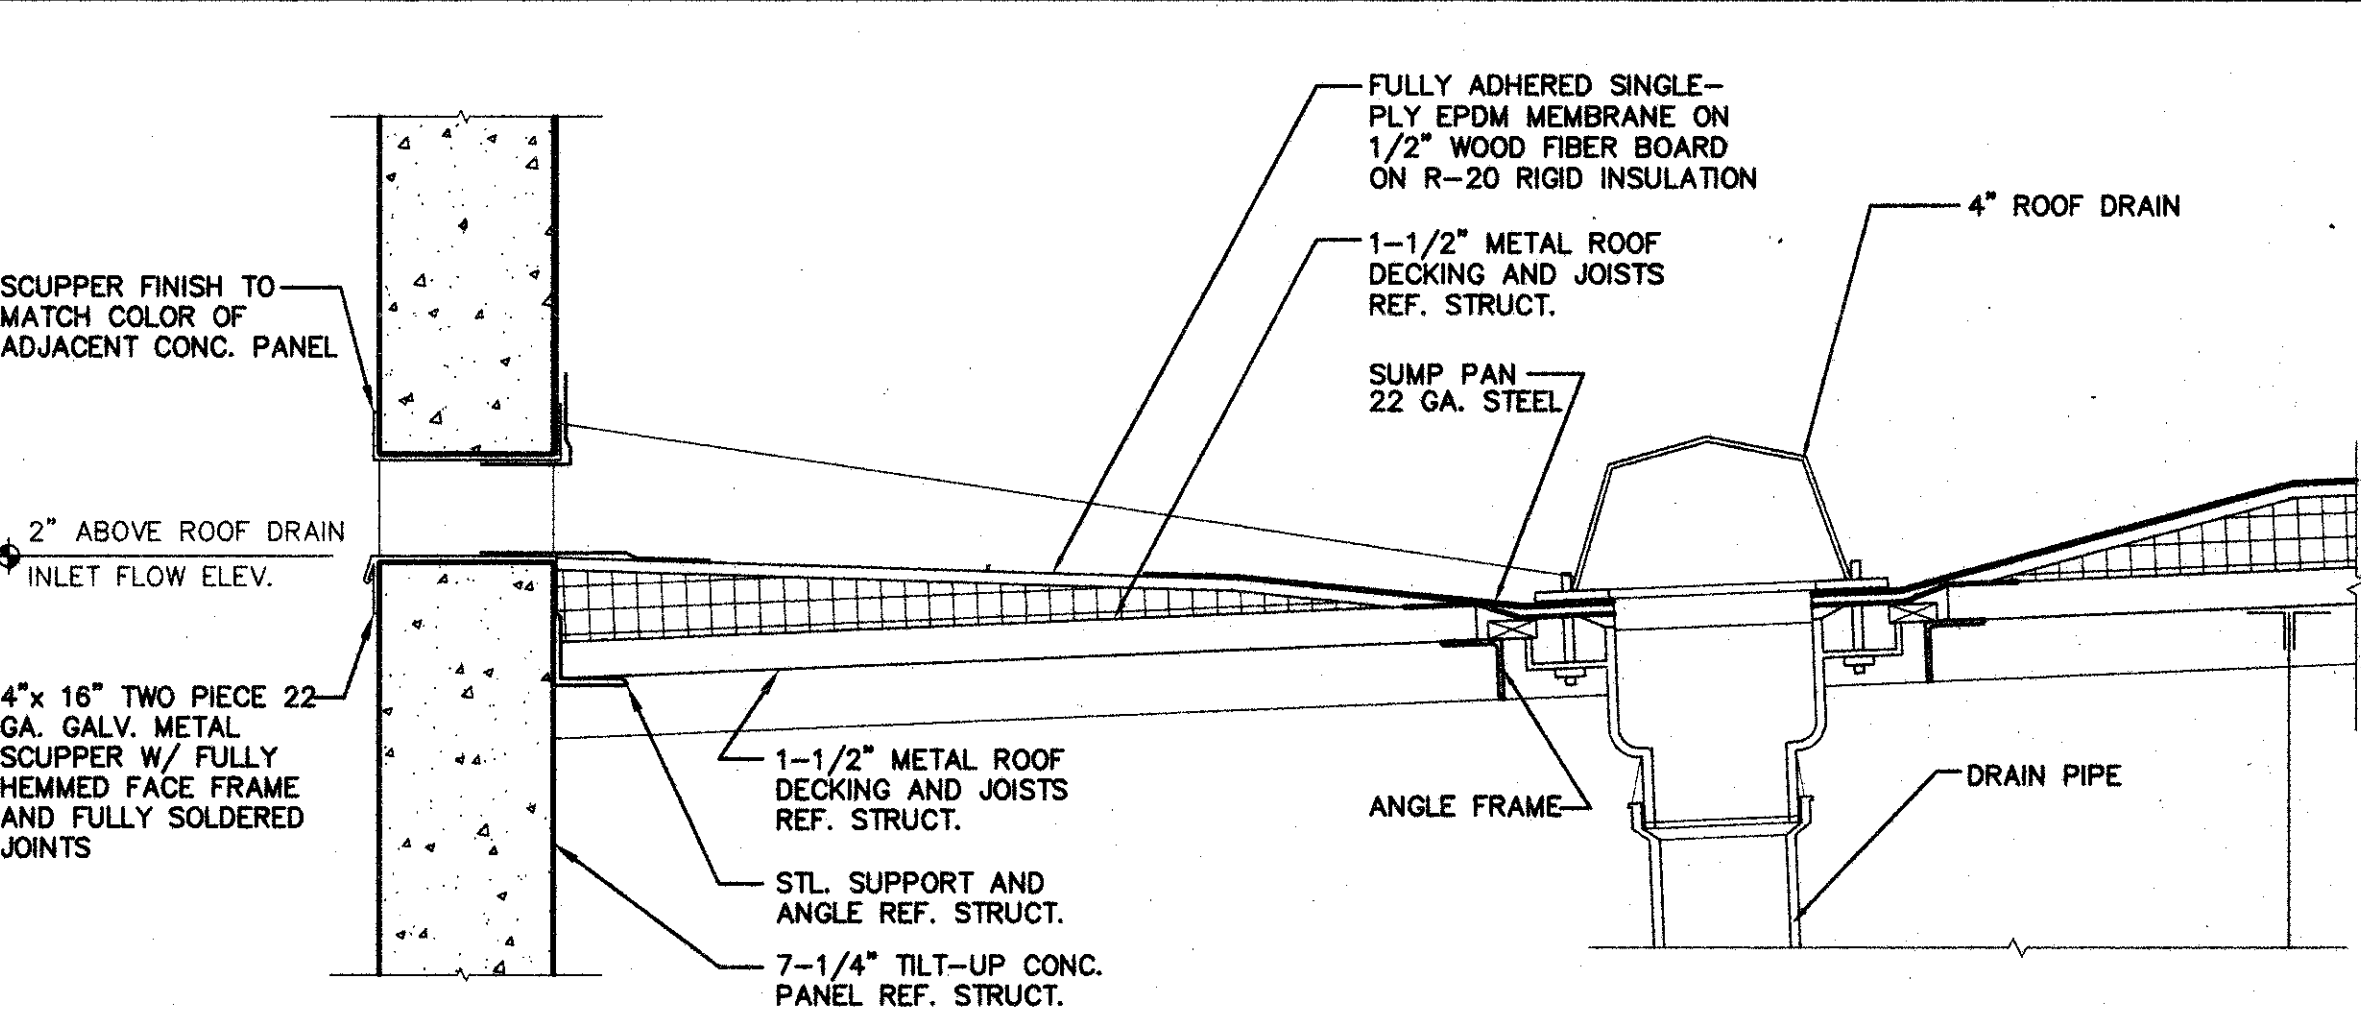


DETAIL SCALE: 1 1/2"=1'-0" 607

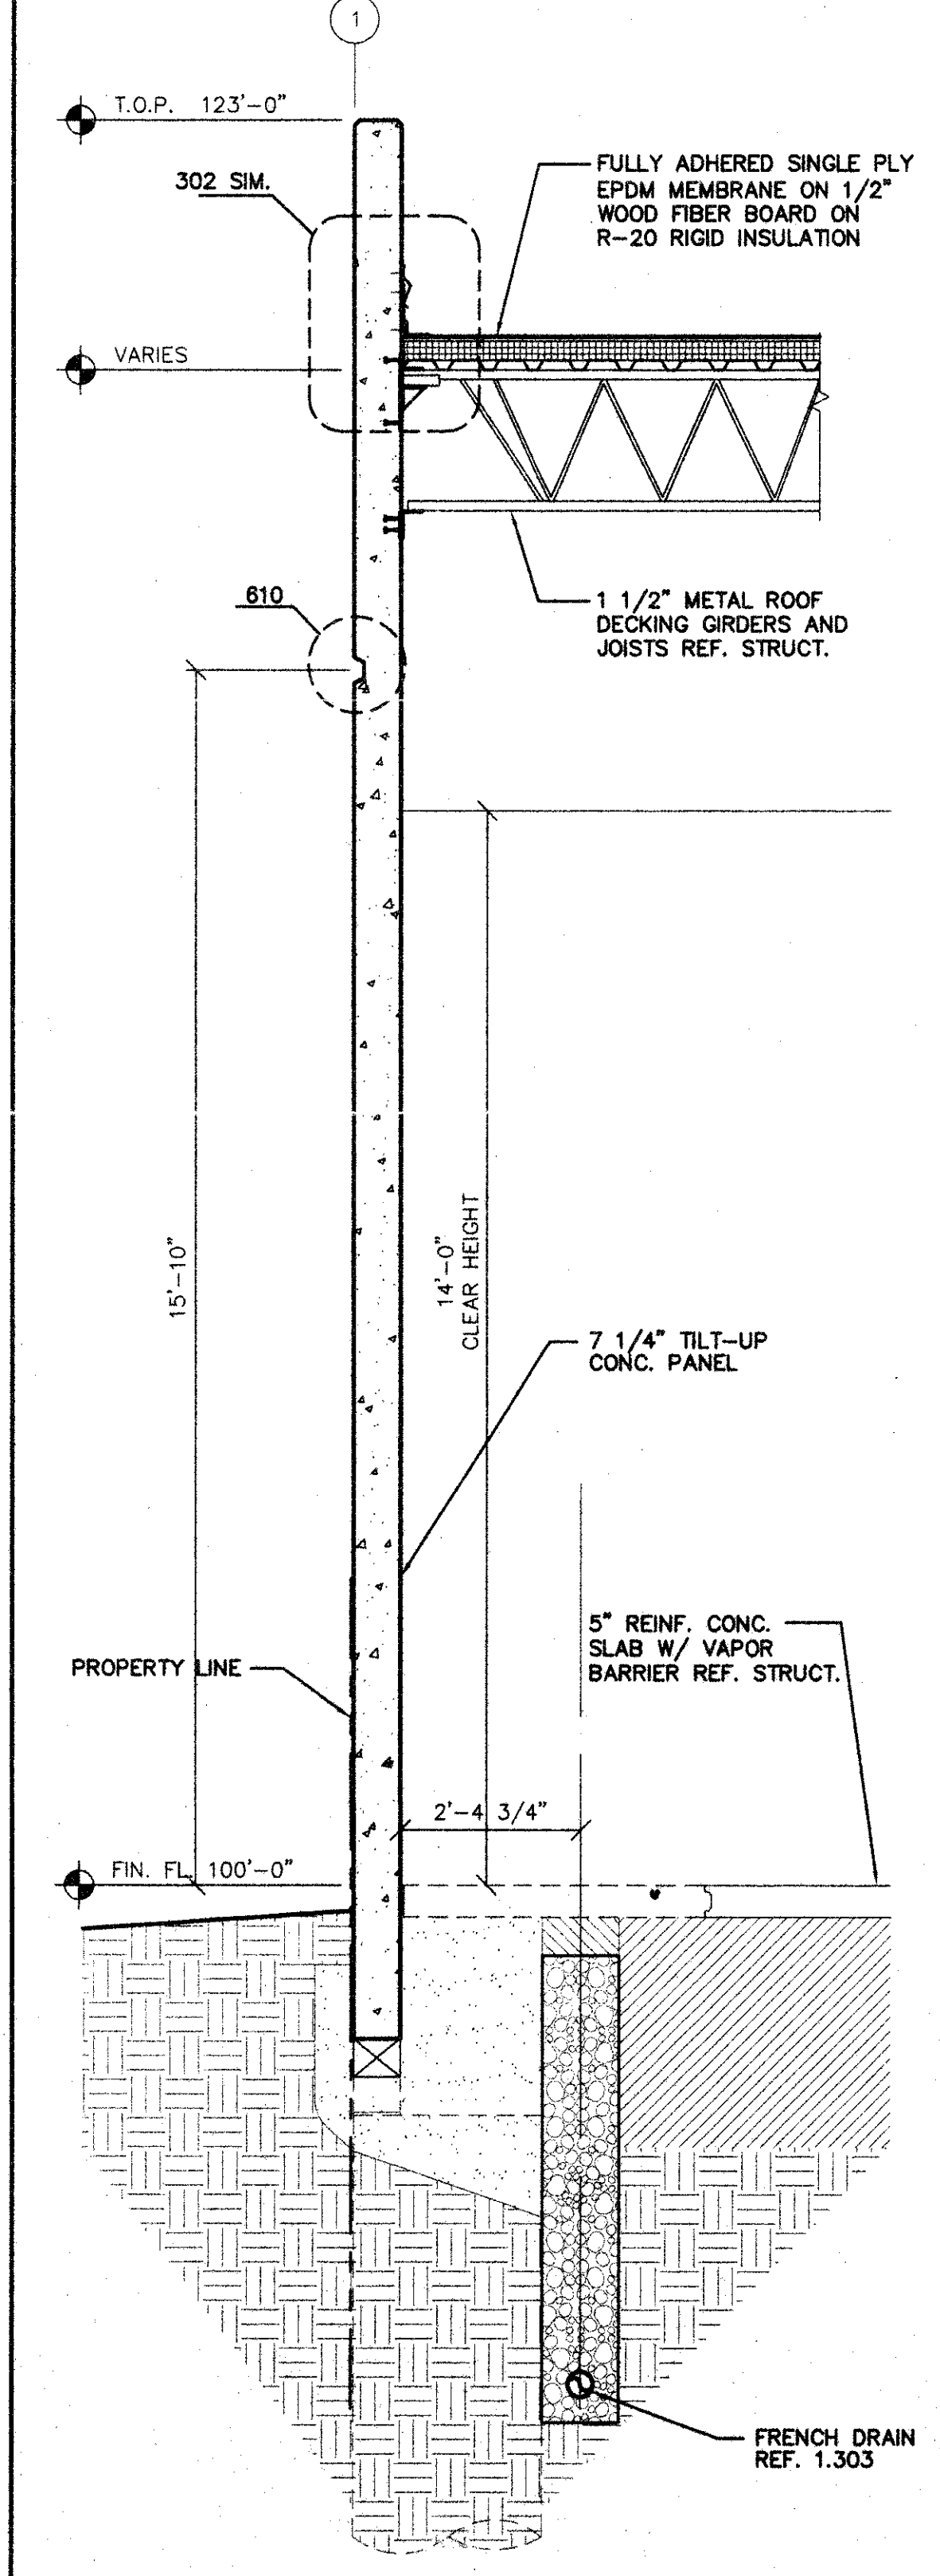


WALL SECTION SCALE: 1/2"=1'-0" 606

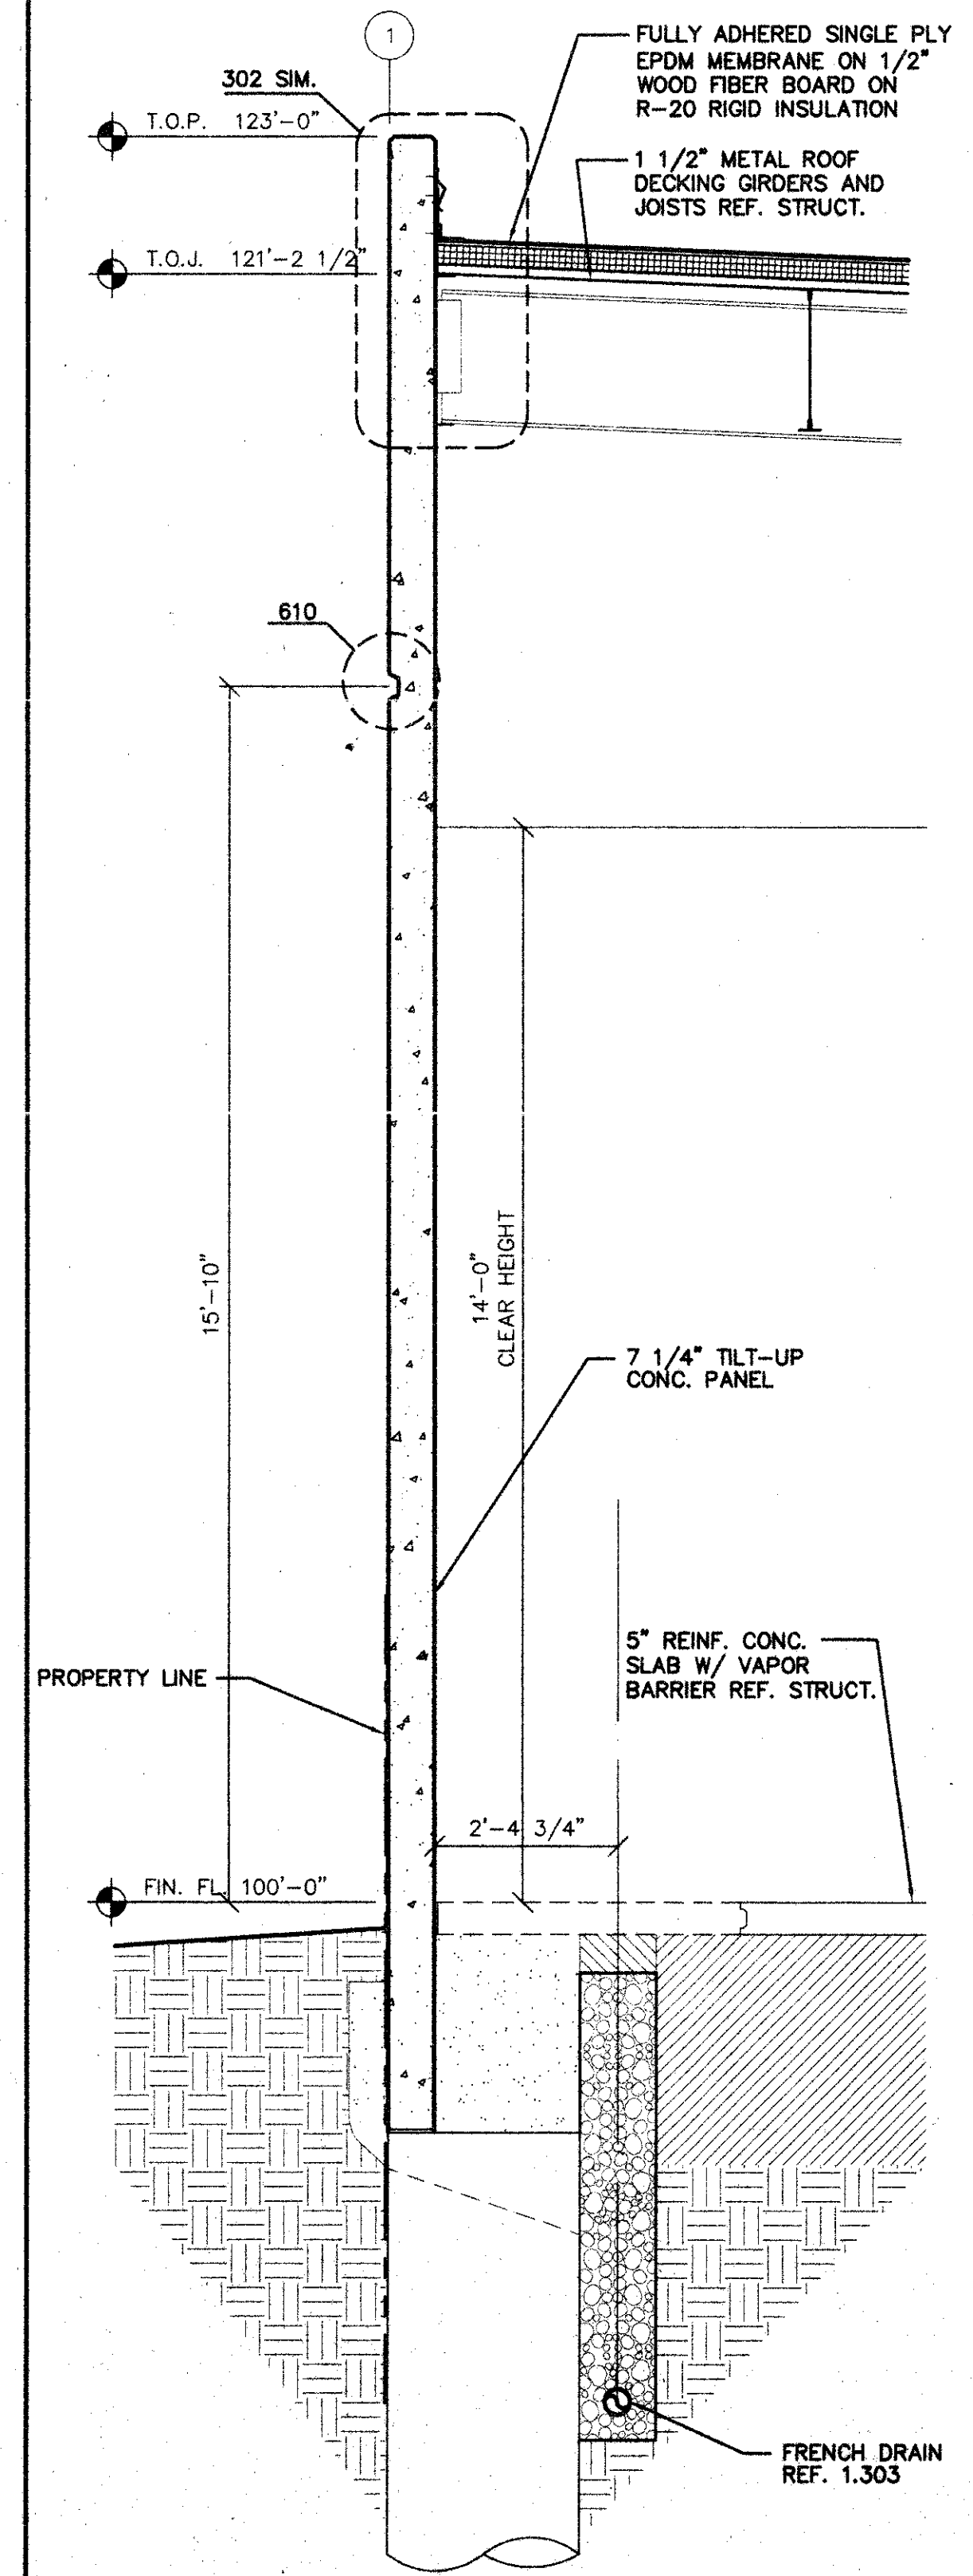


WALL SECTION SCALE: 1/2"=1'-0" 605

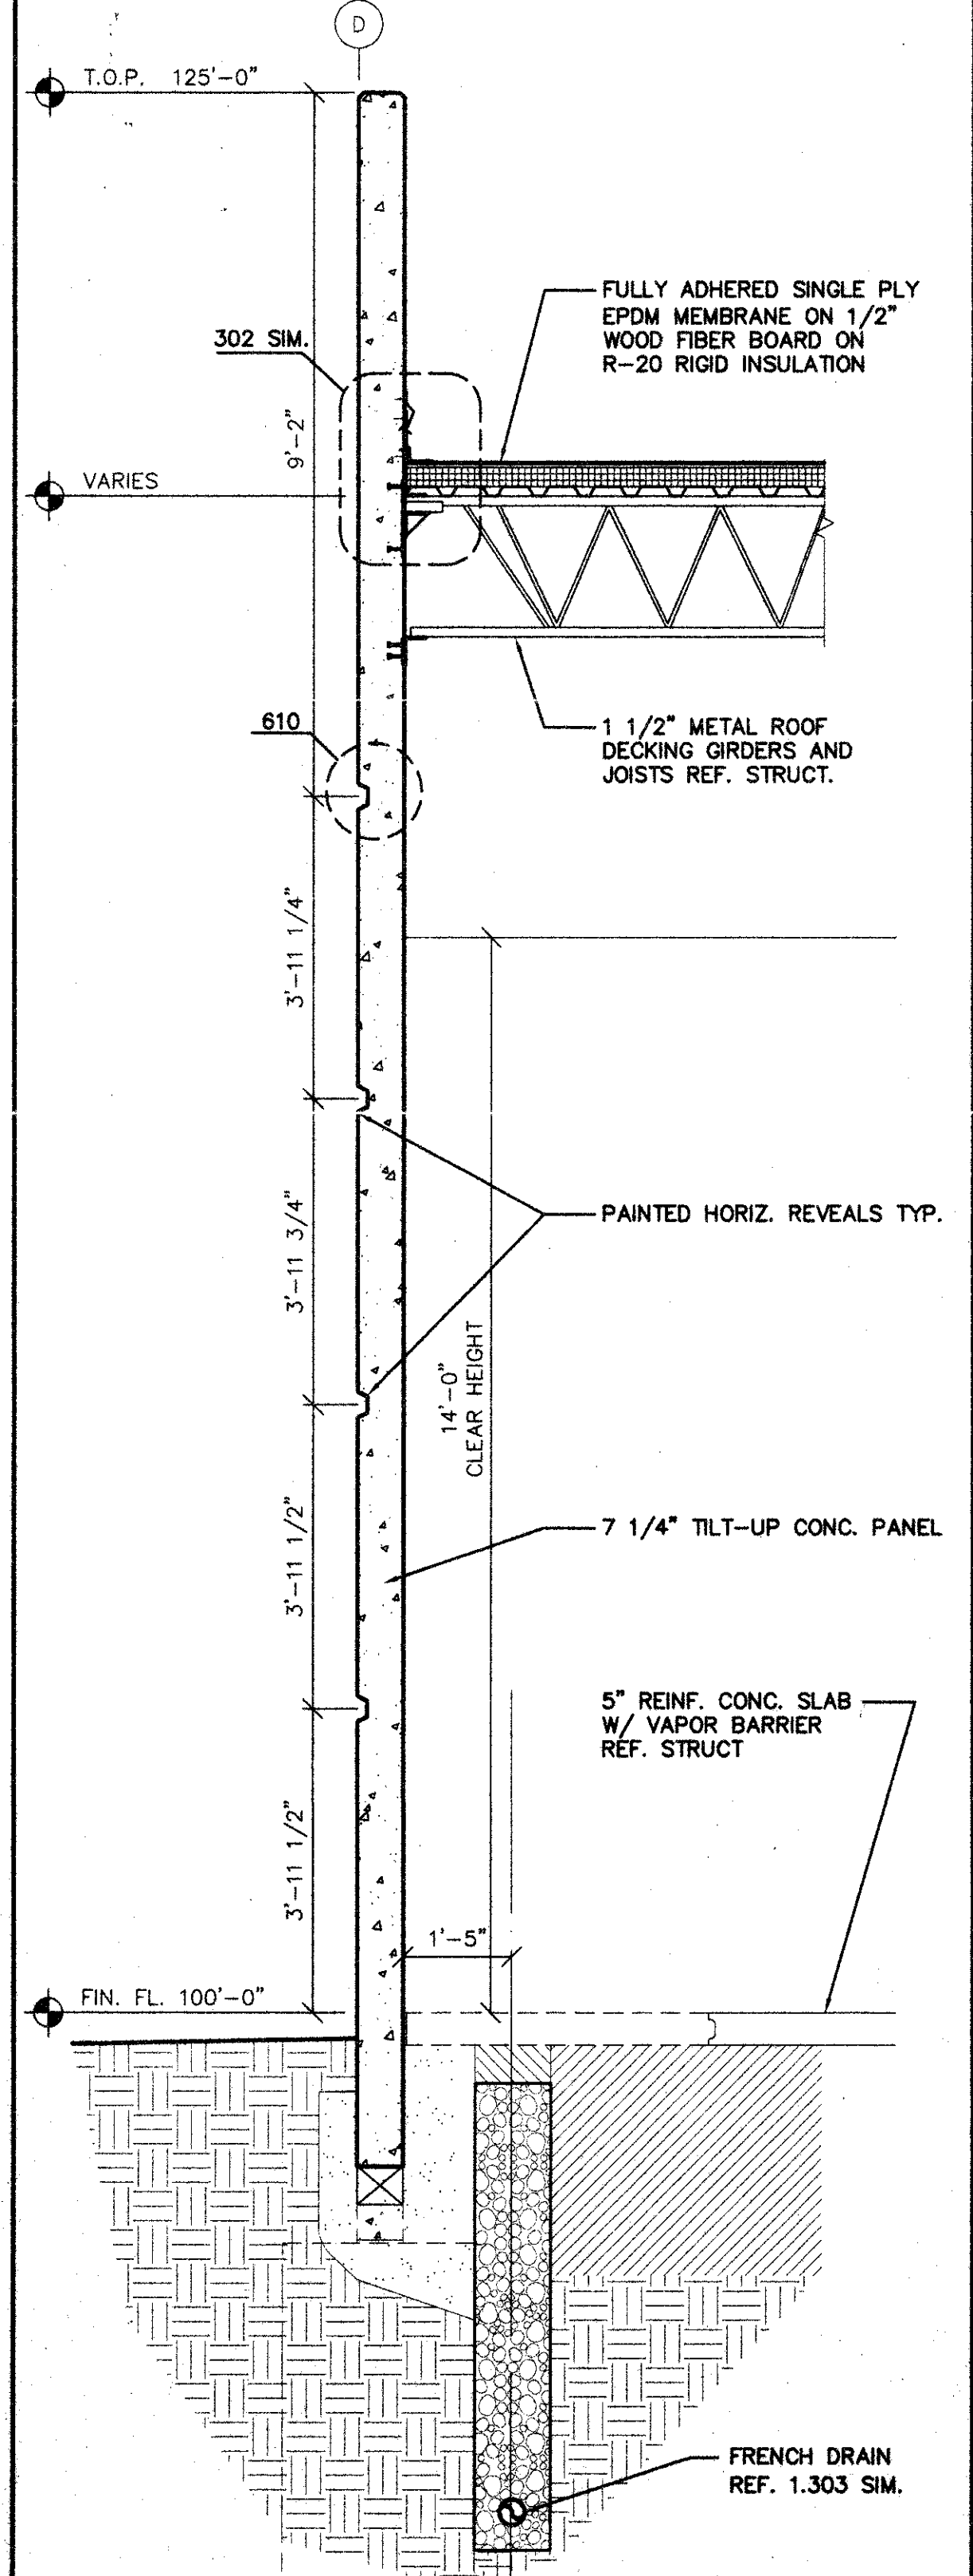


WALL SECTION SCALE: 1/2"=1'-0" 604

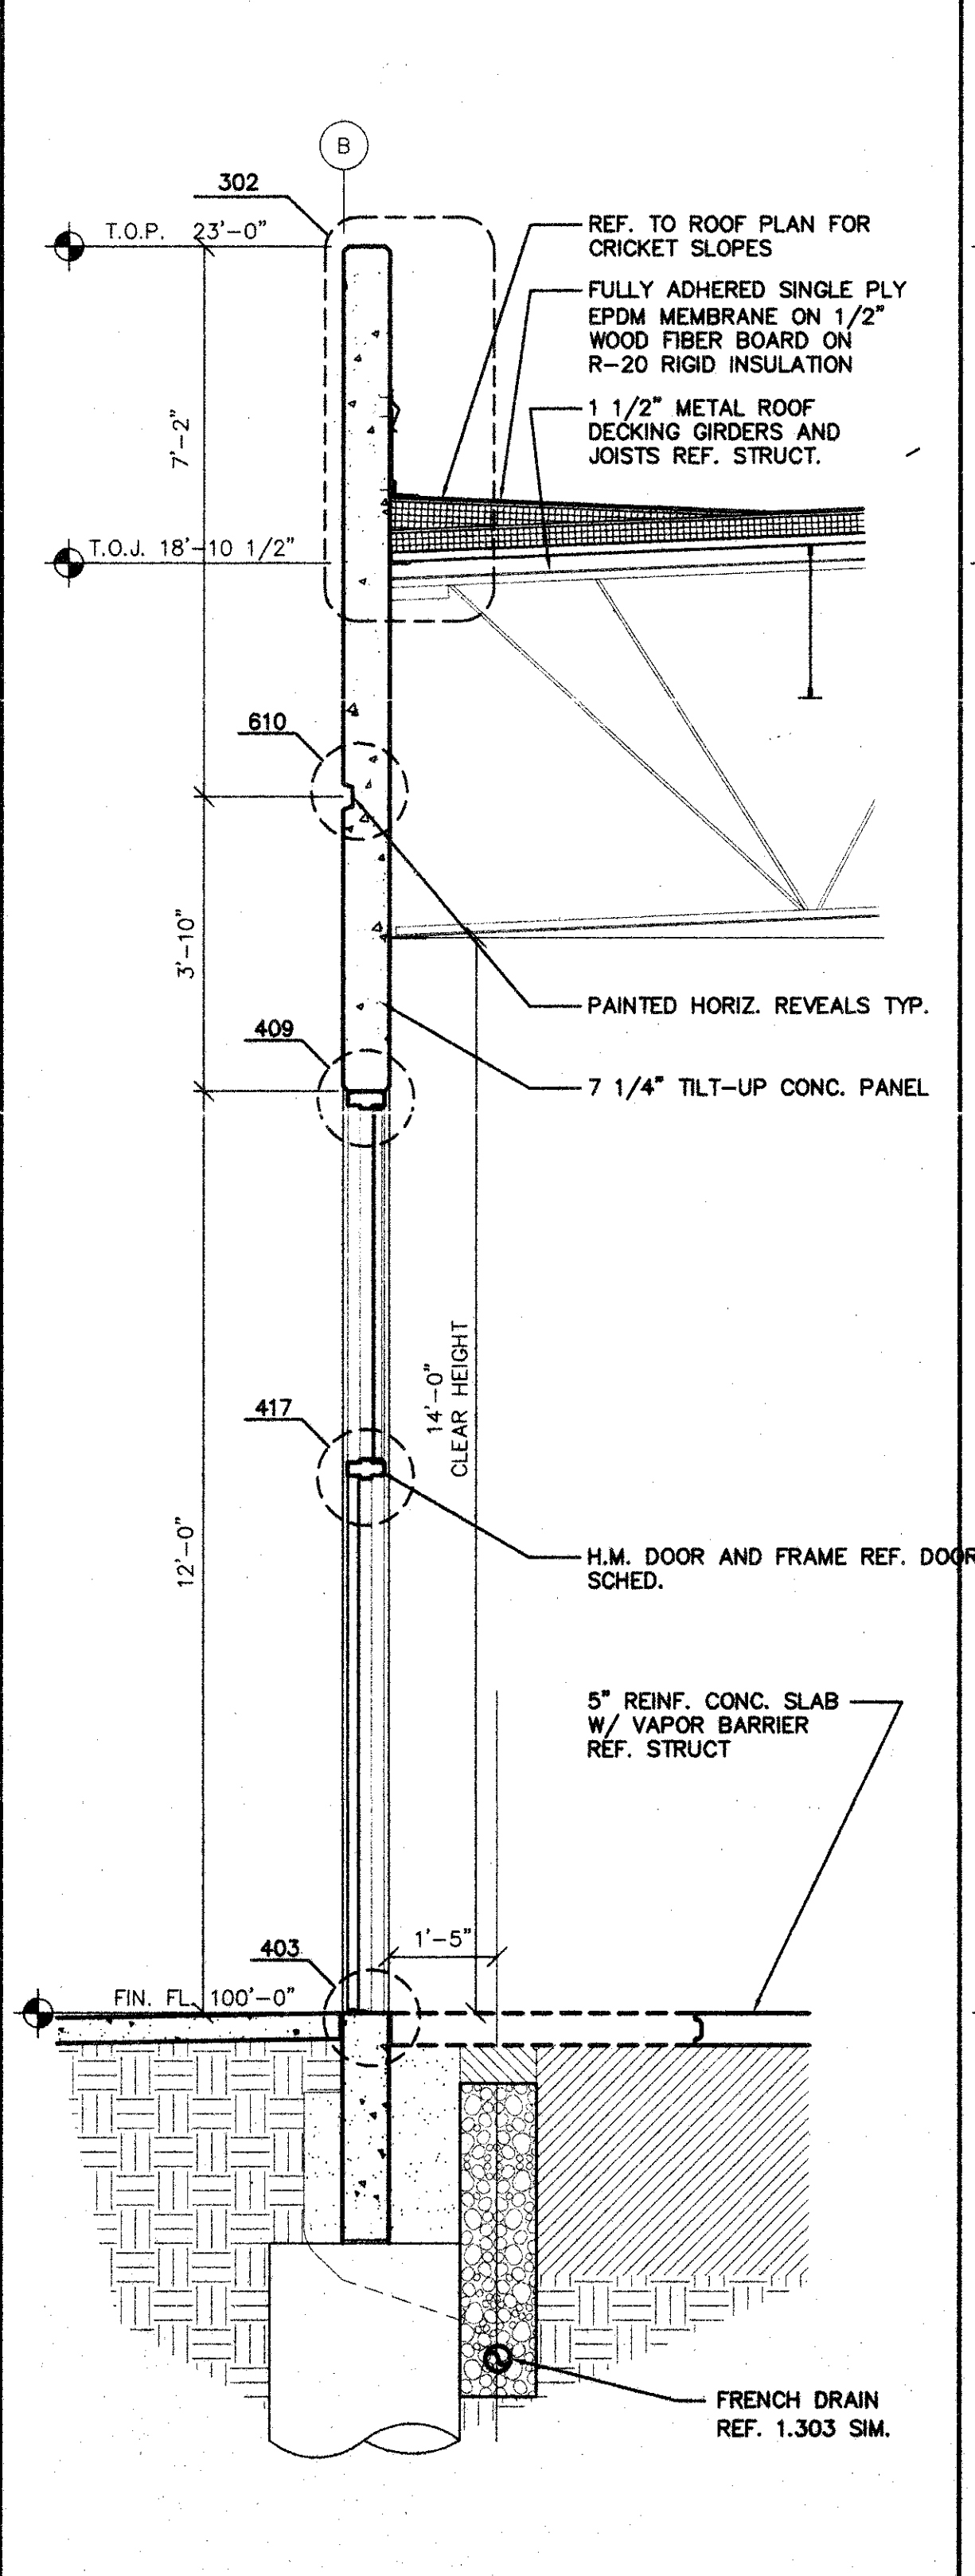

WALL SECTION SCALE: 1/2"=1'-0" 603

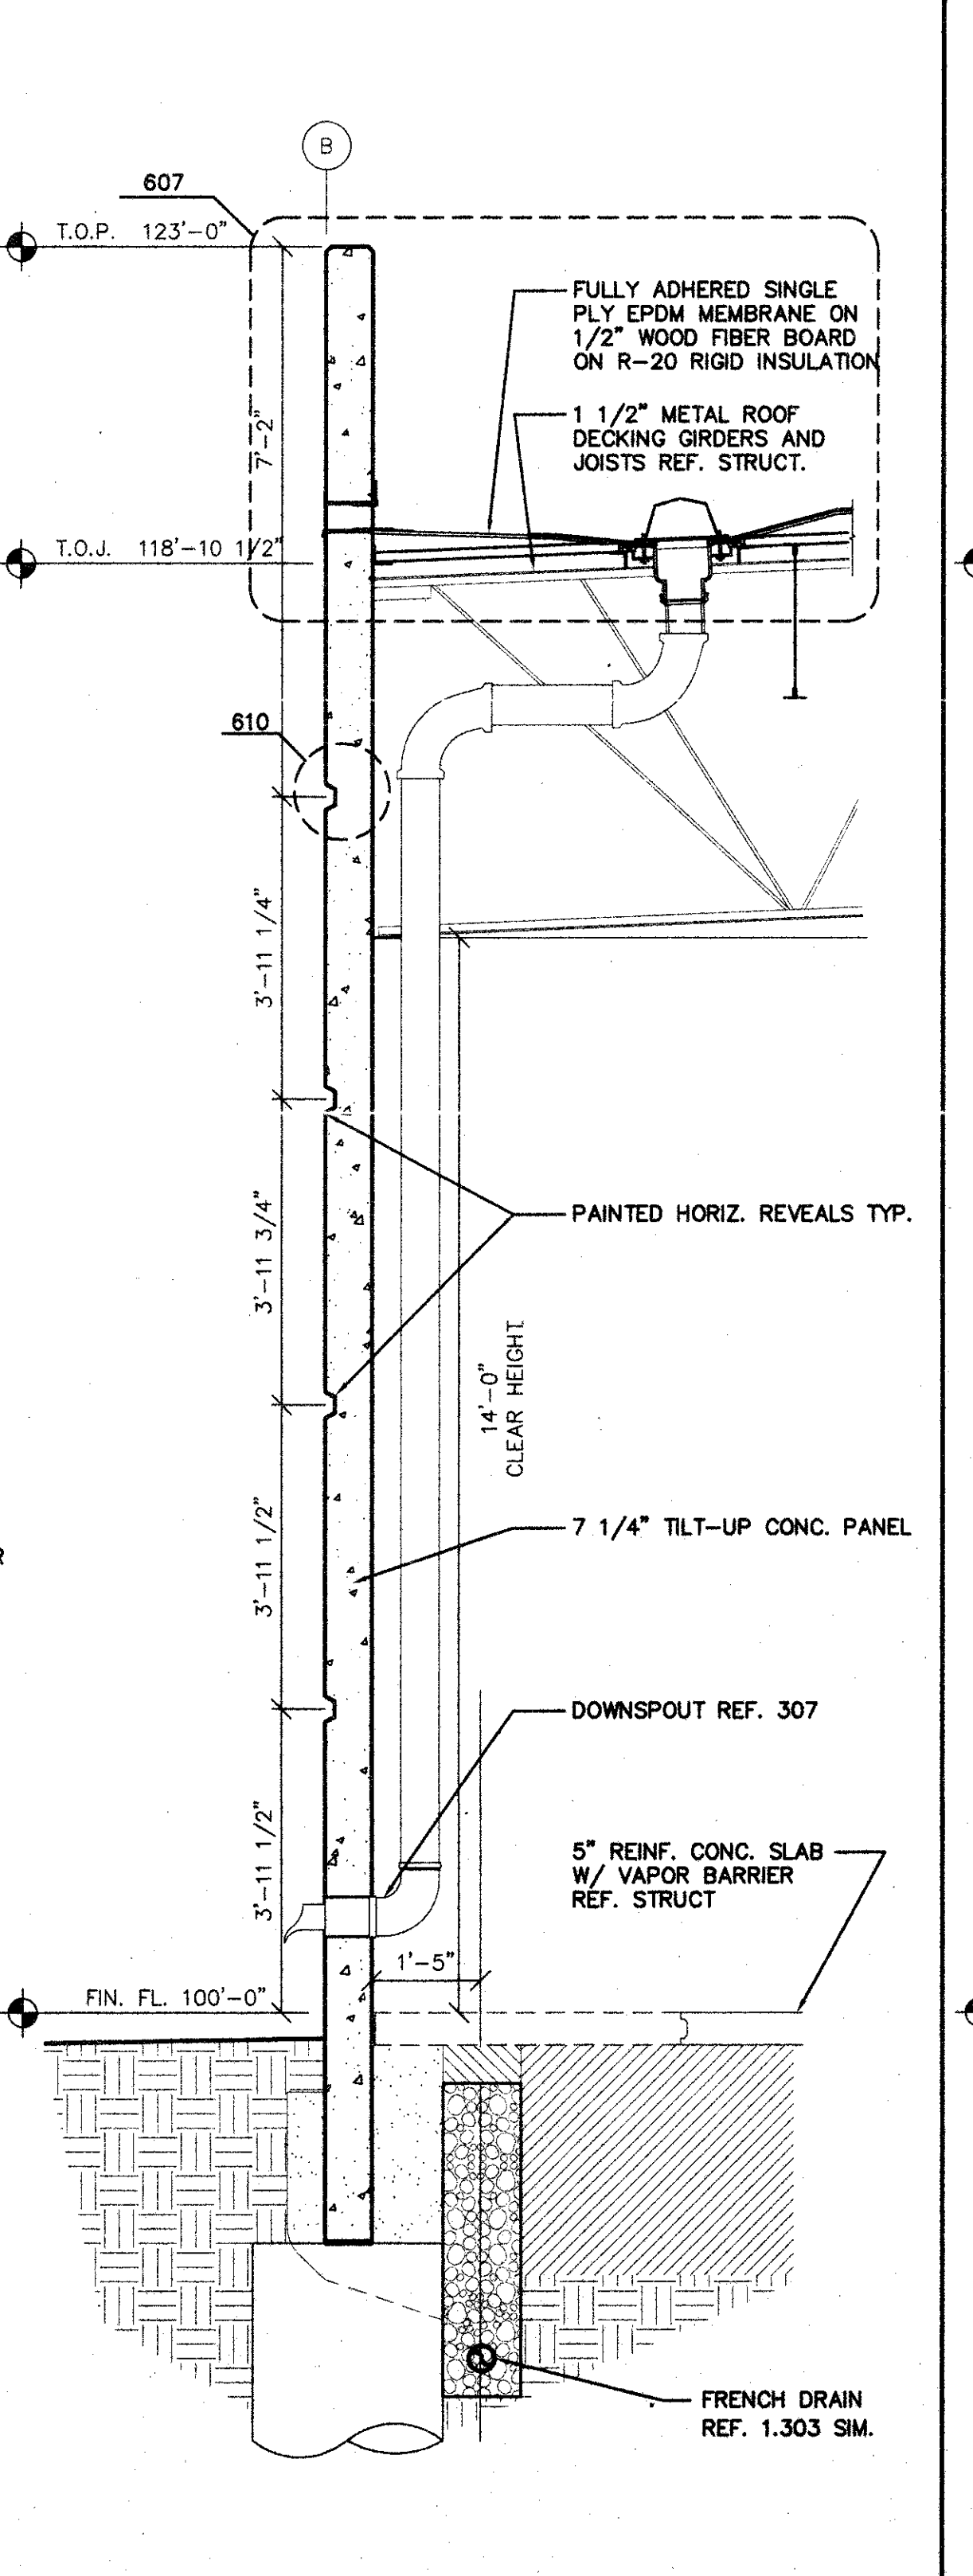

WALL SECTION SCALE: 1/2"=1'-0" 602

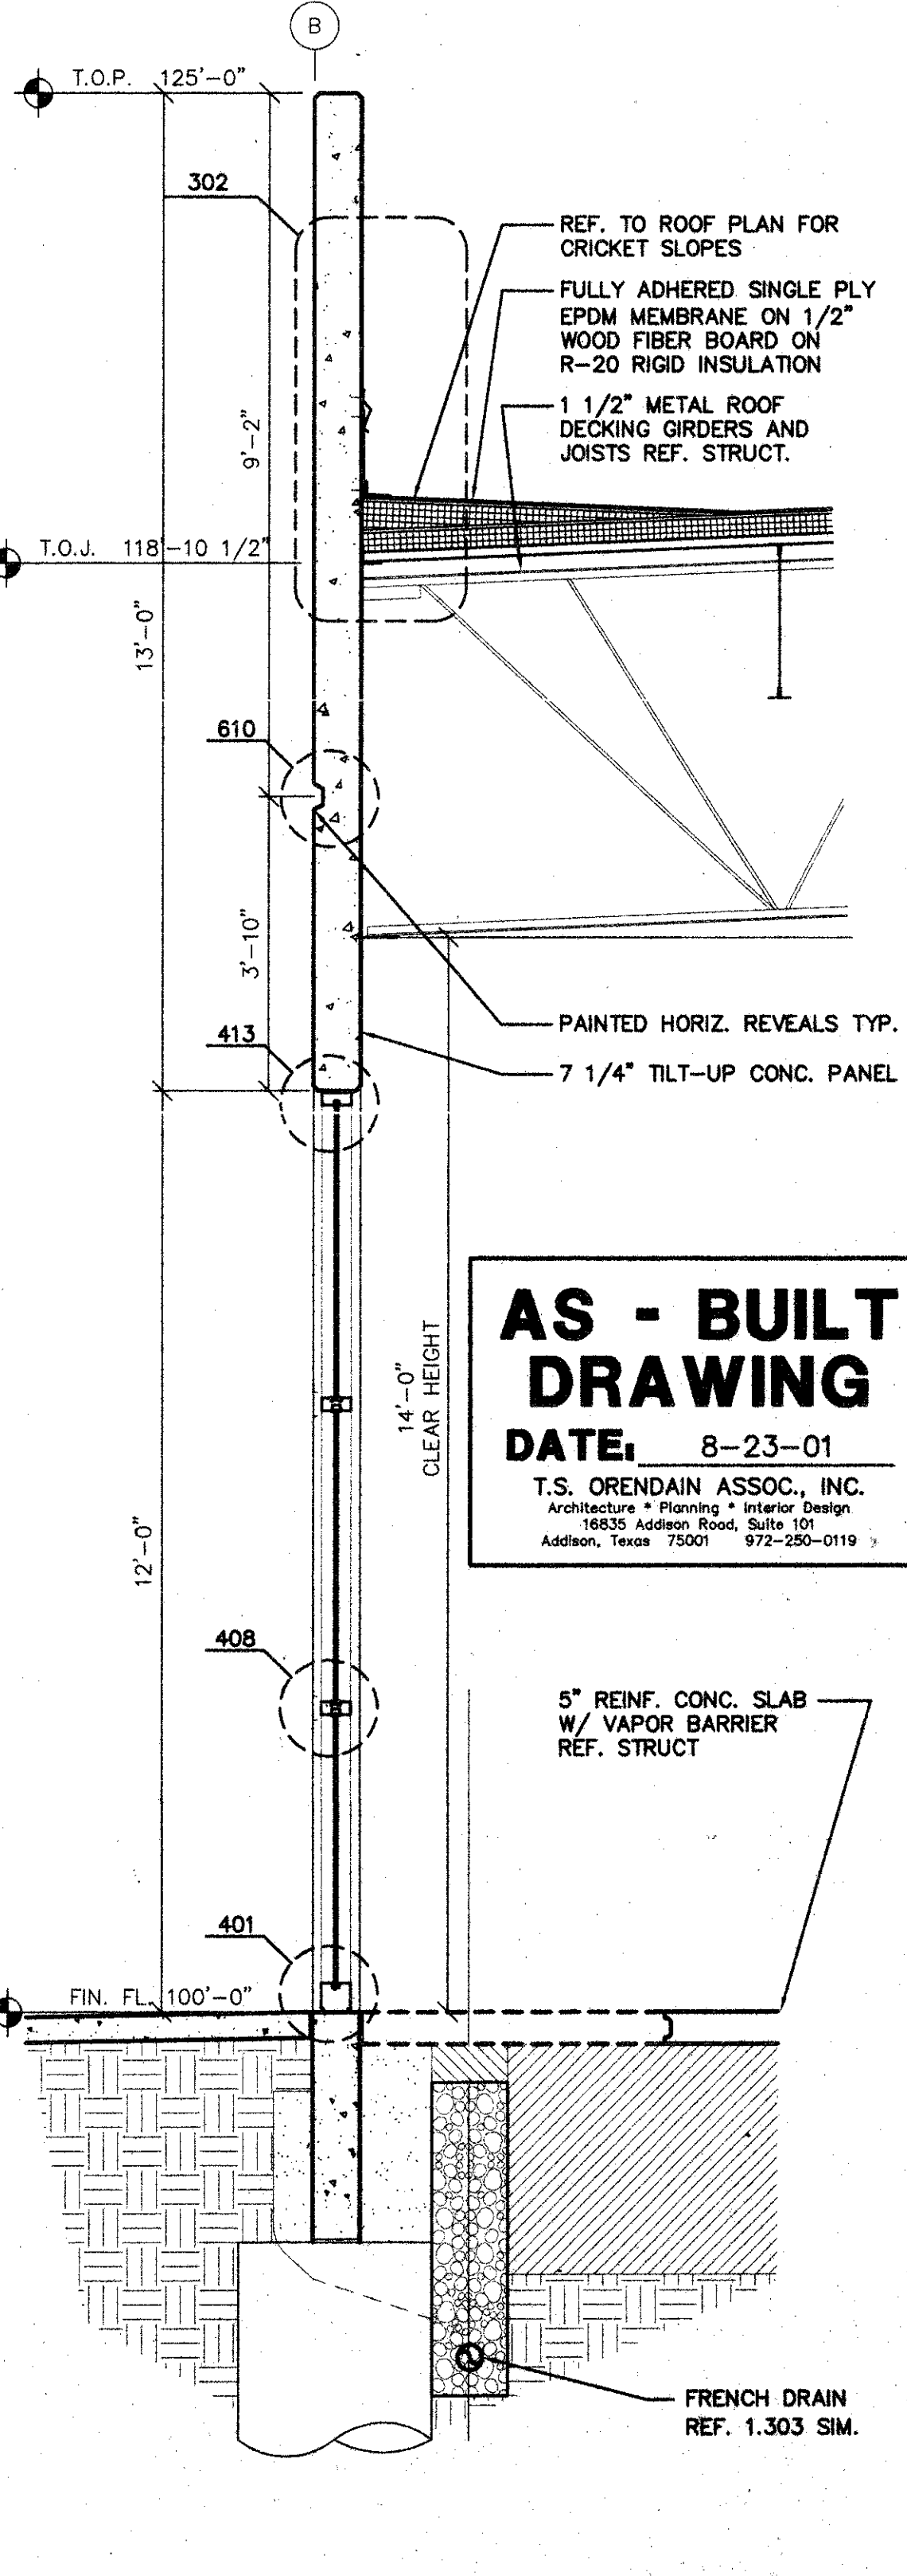


WALL SECTION SCALE: 1/2"=1'-0" 601

AS - BUILT DRAWING
 DATE: 8-23-01
 T.S. ORENDAIN ASSOC., INC.
 ARCHITECTURE • PLANNING • INTERIOR DESIGN
 16835 Addison Road, Suite 101
 Addison, Texas 75001 972-250-0119

AMO
 16835 ADDISON ROAD
 SUITE 101
 ADDISON, TX 75001
 TEL: 972-250-0119
 FAX: 972-250-3157

ADDISON PARK CENTRE
 OFFICE/TECH./FLEX.
 PHASE 1
 16835 ADDISON ROAD ADDISON, TEXAS

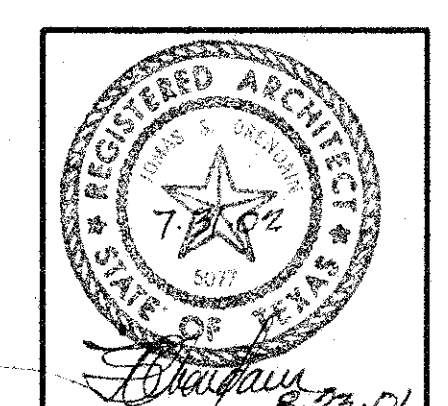

T.S. Orendain Associates Inc.
 Architecture • Planning • Interior Design
 16835 Addison Road
 Suite 101
 Addison, Texas 75001
 (972) 250-0119

JOB: 8396 DATE: 2/25/2000
 DRAWN: T.S.O. CHECKED: T.S.O.

Date	Issued For / Description	By
9-25-97	SCHEMATIC CITY REVIEW	T.S.O.
9-30-98	T.D.L.R.	T.S.O.
11-1-99	T.D.L.R.	T.S.O.
2-25-2000	100% ISSUED FOR CONSTRUCTION	T.S.O.
6-9-2000	GENERAL REVISION	T.S.O.
9-13-2000	AS-BUILT REVISION	T.S.O.

WALL SECTIONS AND DETAILS