


DRAINAGE DATA TABLE

DRAINAGE AREA NO.	AREA ACRES	C	$\frac{1}{100}$	Q_{100} CFS	T_c	REMARKS
A	.48	.95	8.76	4.00	10	ROOF DRAIN TO DETENTION POND
B	.36	.90	8.76	3.00	10	TO DETENTION POND
C	.02	.50	8.76	.09	10	SHEET FLOW
D	.34	.90	8.76	2.68	10	SHEET FLOW TO PARKING LOT

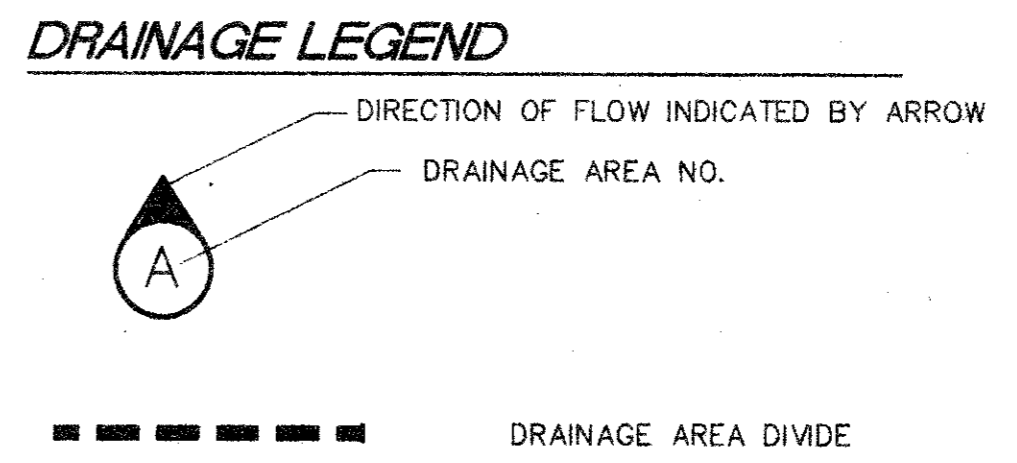


DRAINAGE CRITERIA

Q = CIA
C = 0.90
I_{avg} = 8.76 in/hr
t_c = 10 min.

AS - BUILT DRAWING
DATE: 8-23-01
T.S. OREDAIN ASSOC., INC.
Architecture • Planning • Interior Design
16835 Addison Road, Suite 101
Addison, Texas 75001 972-250-0119

AMO
16835 ADDISON ROAD
SUITE 101
DALLAS, TEXAS 75248
TEL: 972-250-0119
FAX: 972-250-3157

OFFICE WAREHOUSE PHASE I
16835 ADDISON ROAD ADDISON, TEXAS

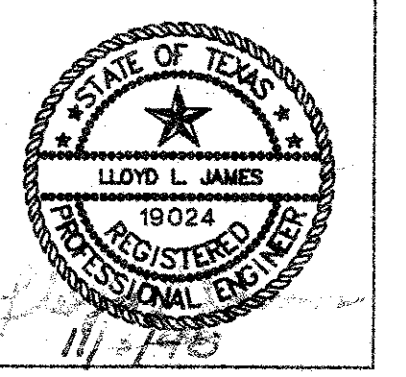

to
T.S. OREDAIN Associates Inc.
Architecture • Planning • Interior Design

16835 Addison Road
Suite 101
Dallas, Texas 75248
(972) 250-0119

JOB: 8396	DATE: 10-26-98
DRAWN:	CHECKED:

Date	Issued For / Description
11-1-99	TRDR
10-1-98	TRDR
10-1-98	TRDR
10-1-98	TRDR
10-1-98	TRDR

DRAINAGE PLAN