




WALL DETAIL SCALE: 1/2"=1'-0" 1.207

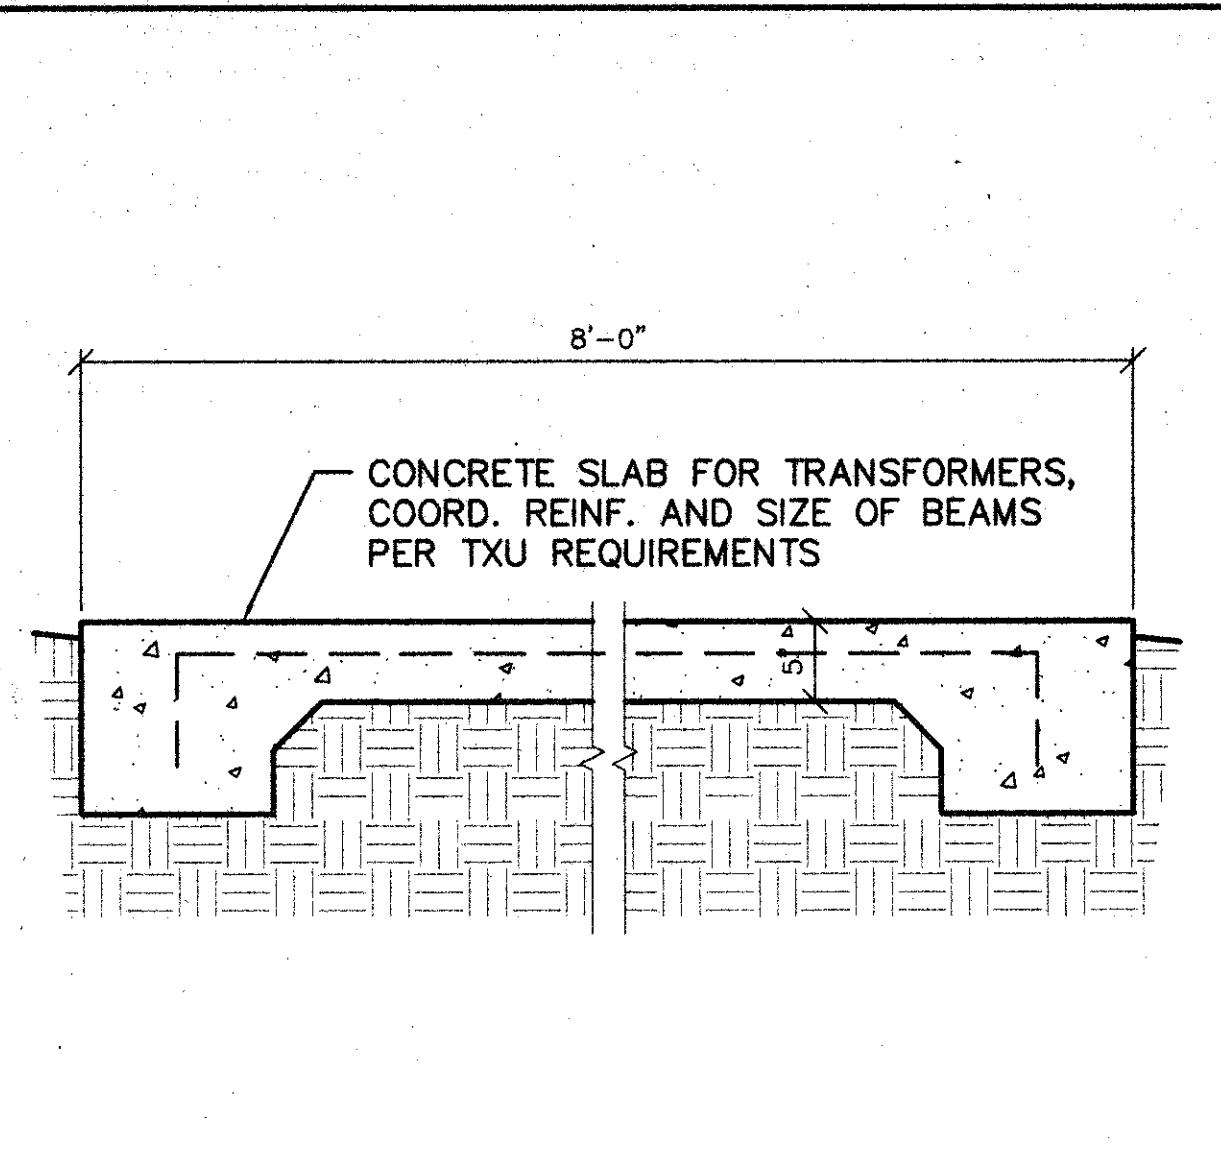


DIKE DETAIL SCALE: 1"=1'-0" 1.206

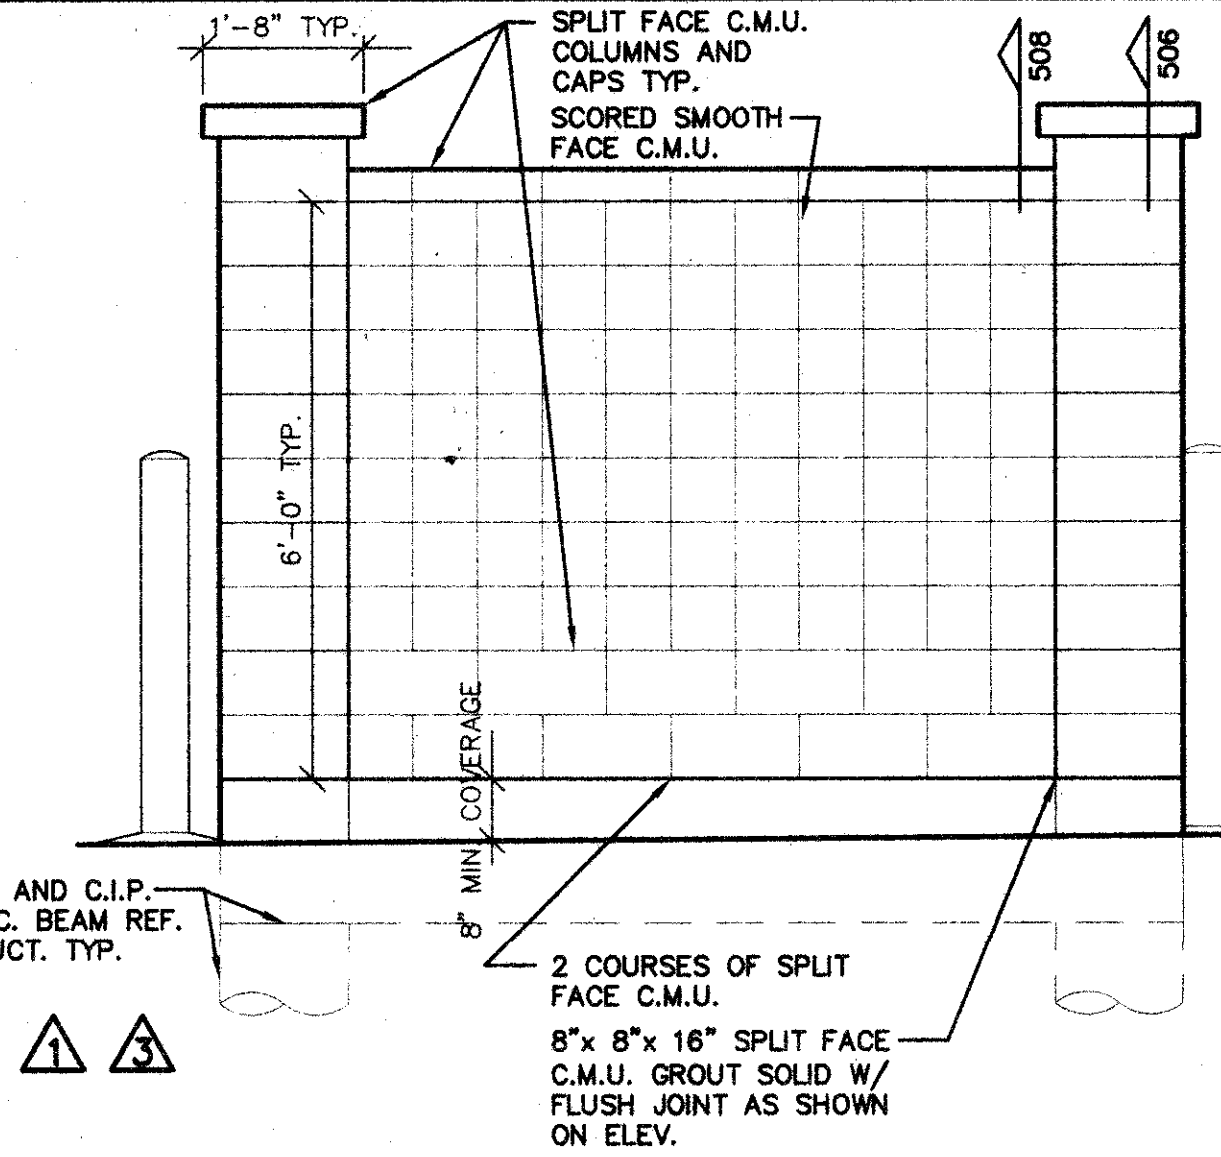


SCREEN ELEVATION SCALE: 1/2"=1'-0" 1.204

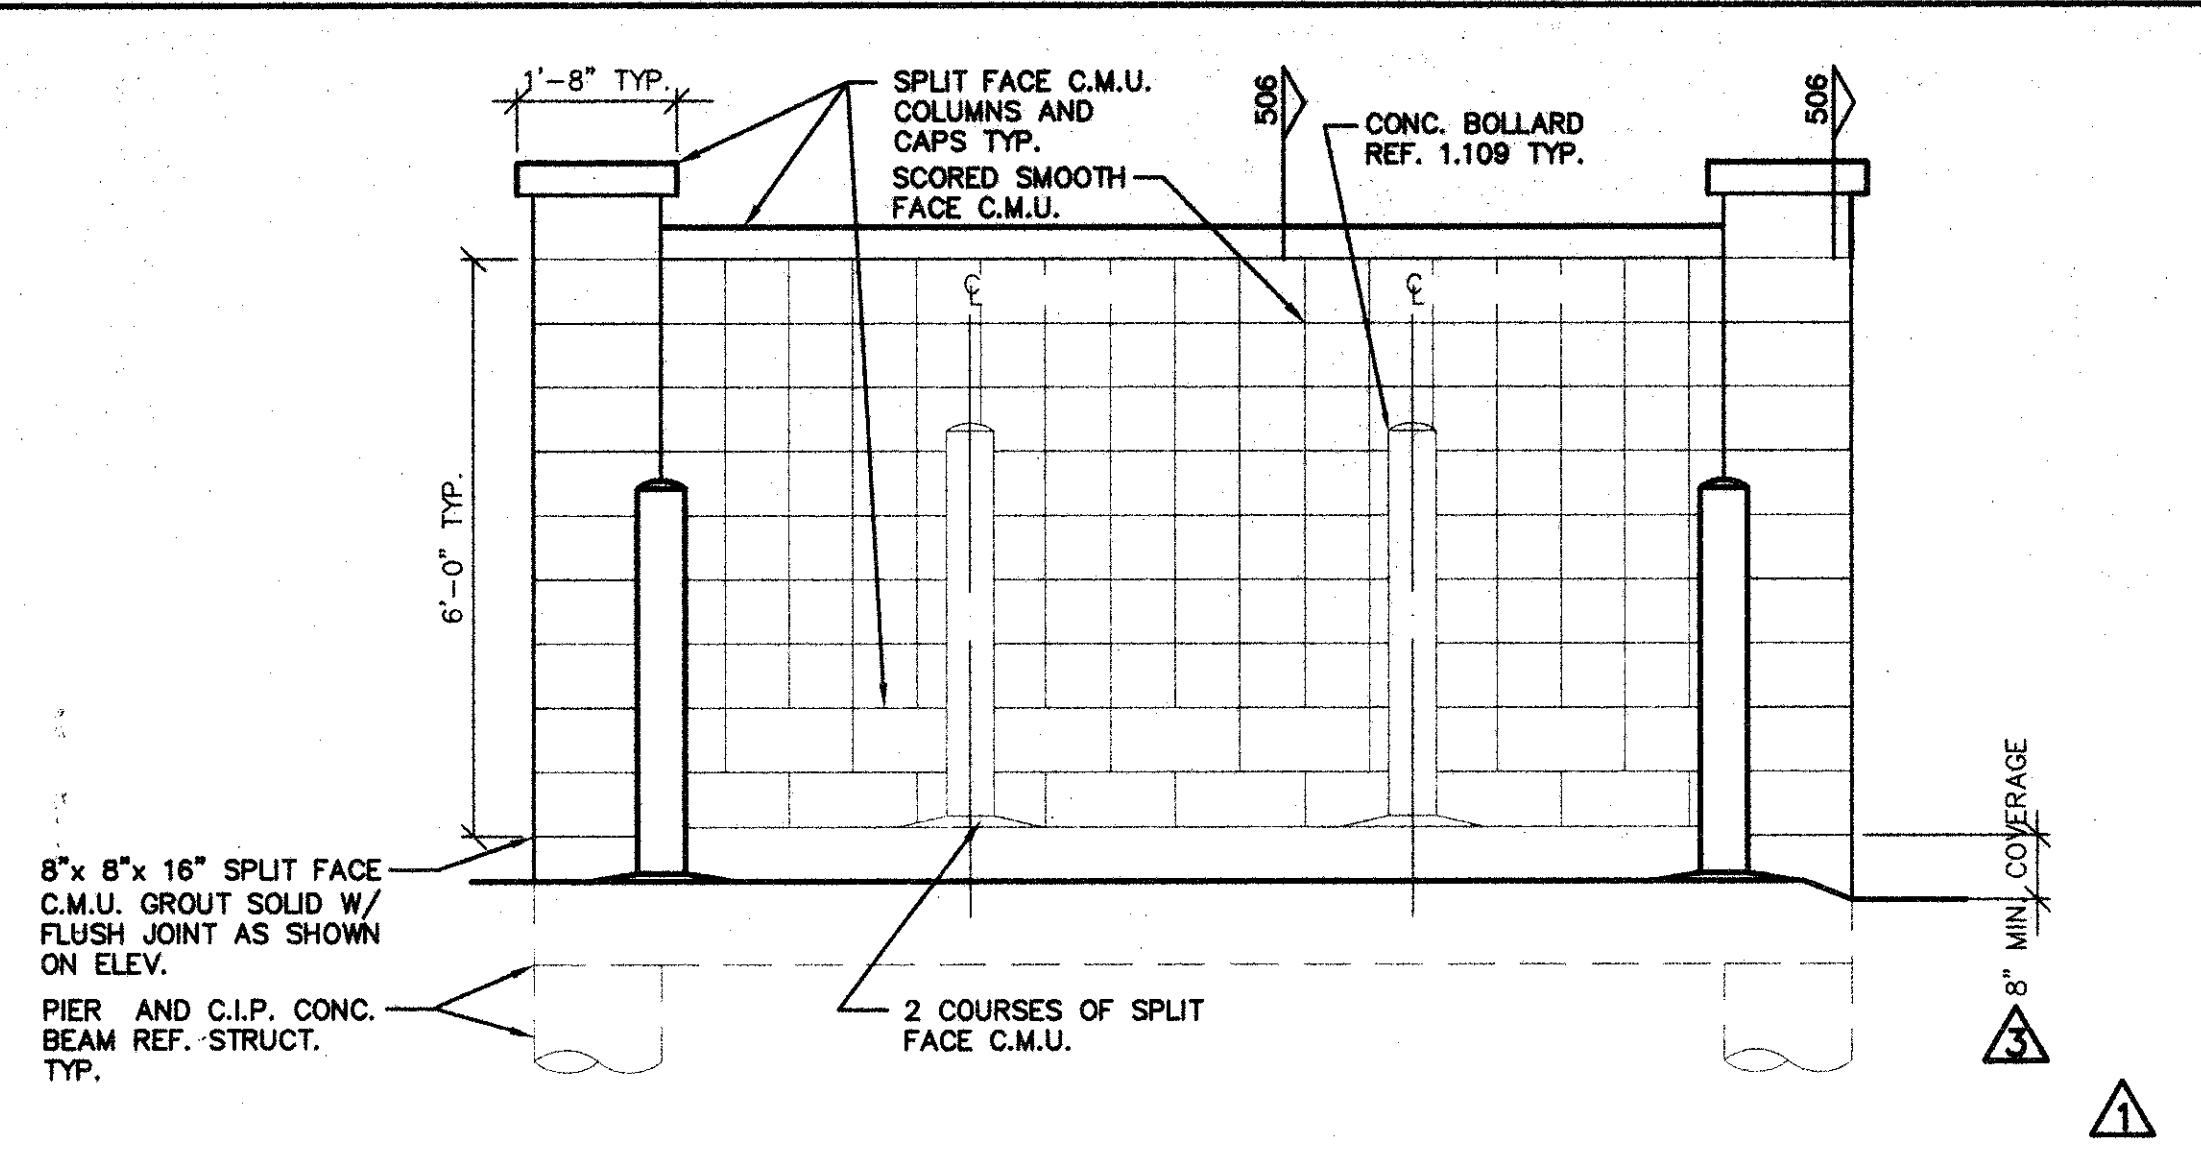


SCREEN ELEVATION SCALE: 1/2"=1'-0" 1.205

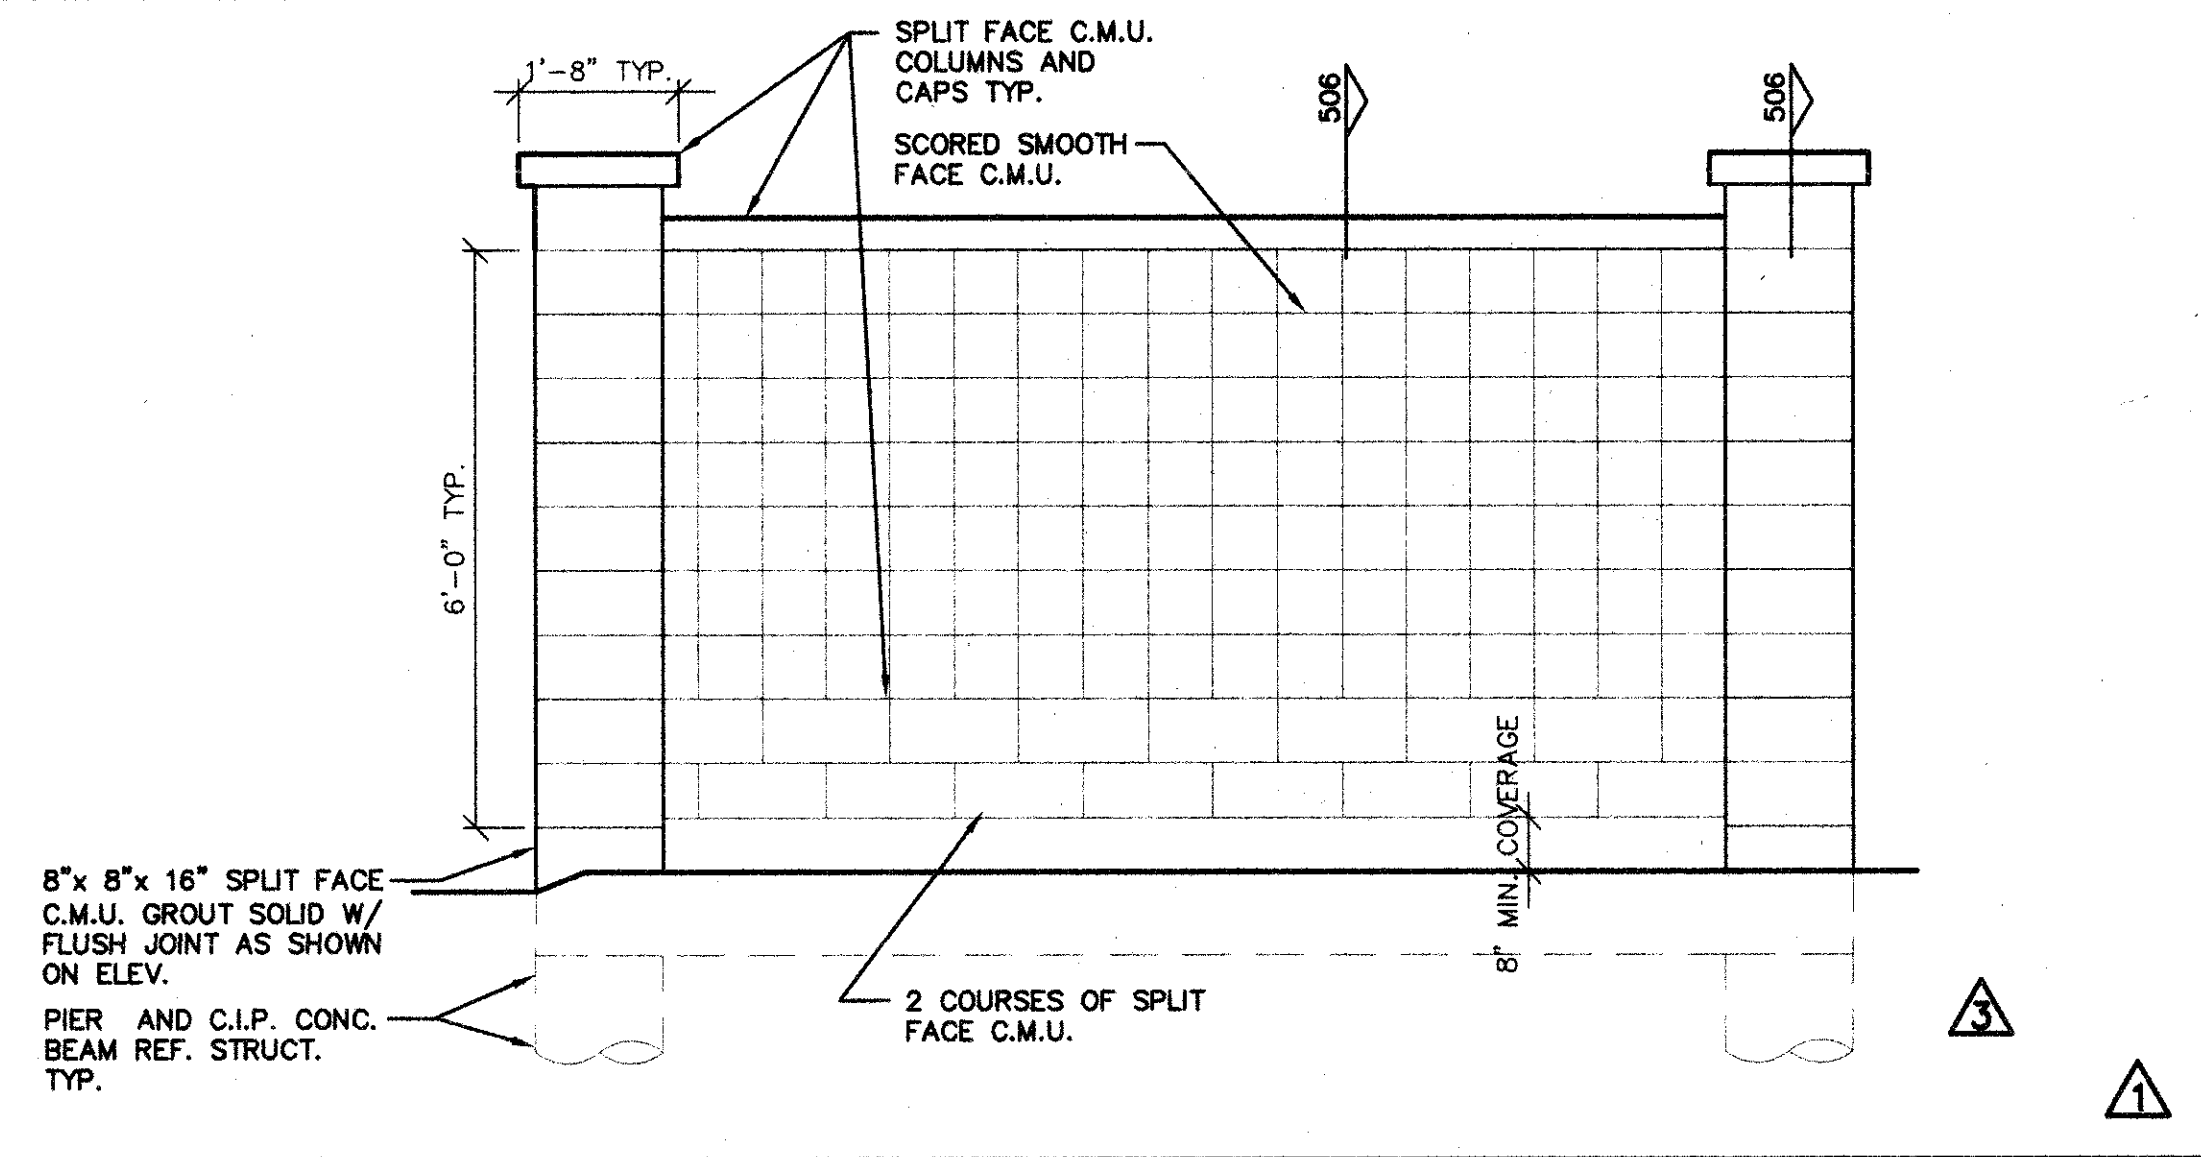

SCREEN ELEVATION SCALE: 1/2"=1'-0" 1.203

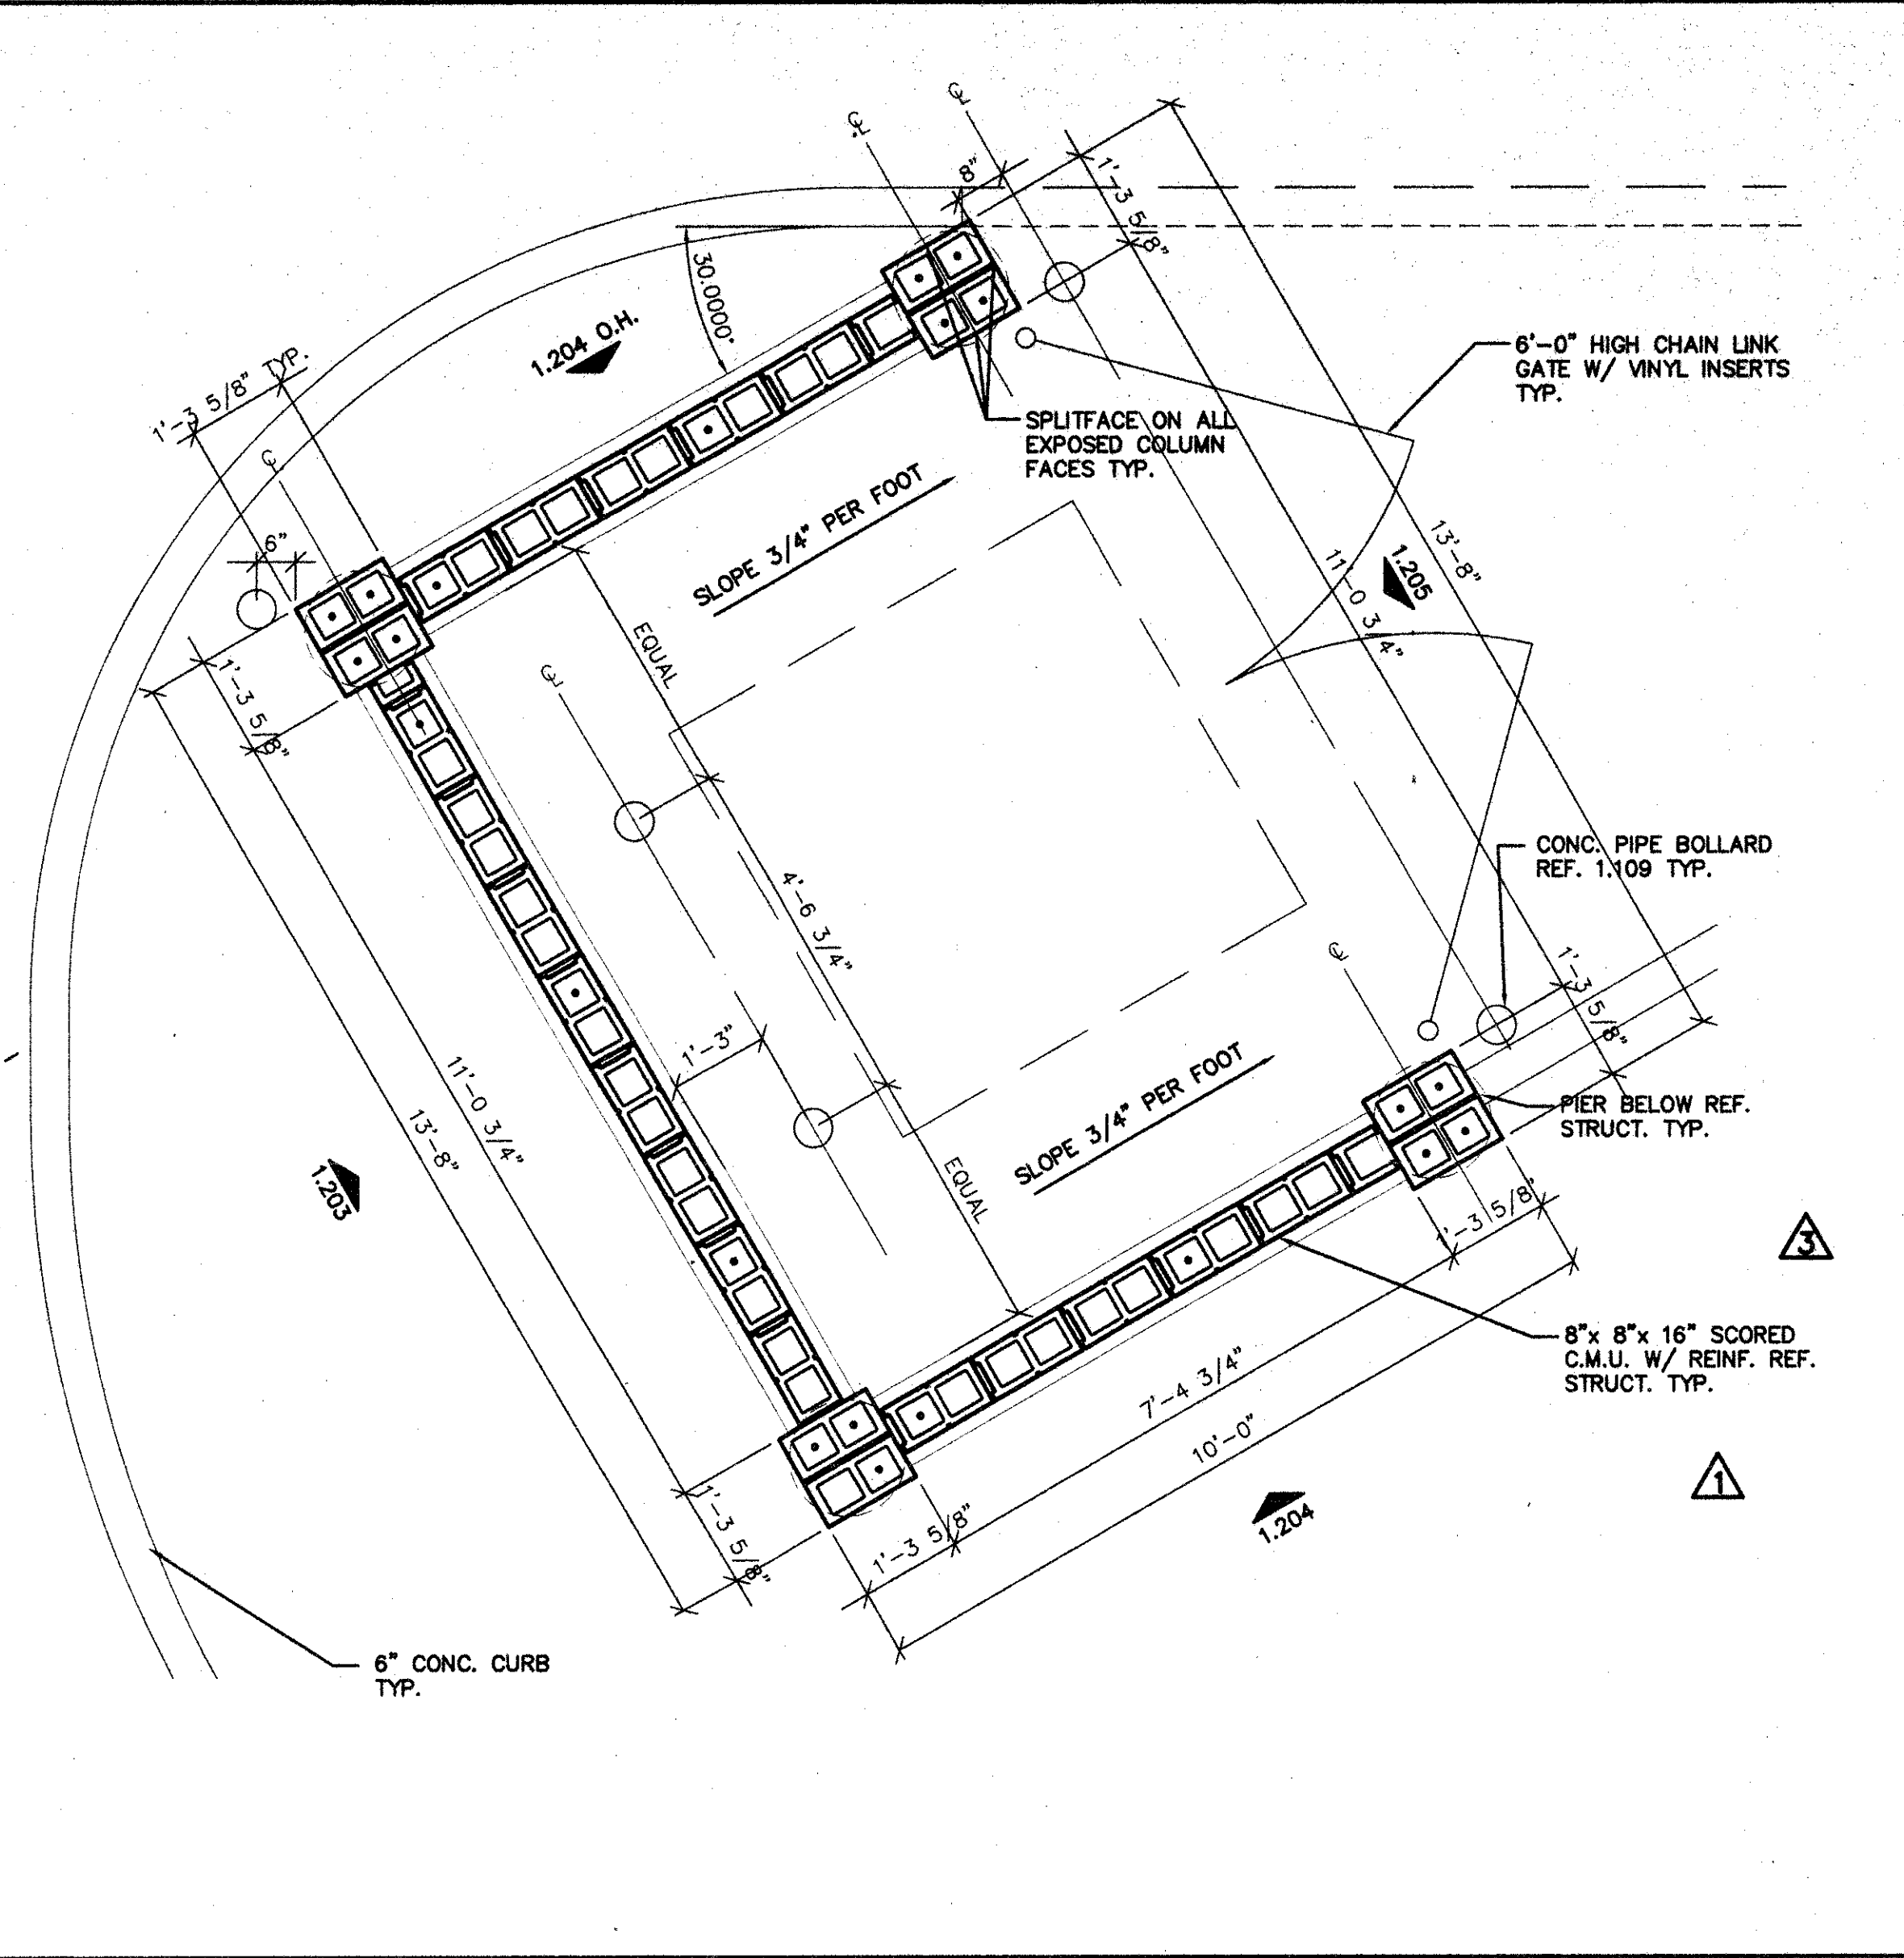

DUMPSTER PLAN SCALE: 1/2"=1'-0" 1.202

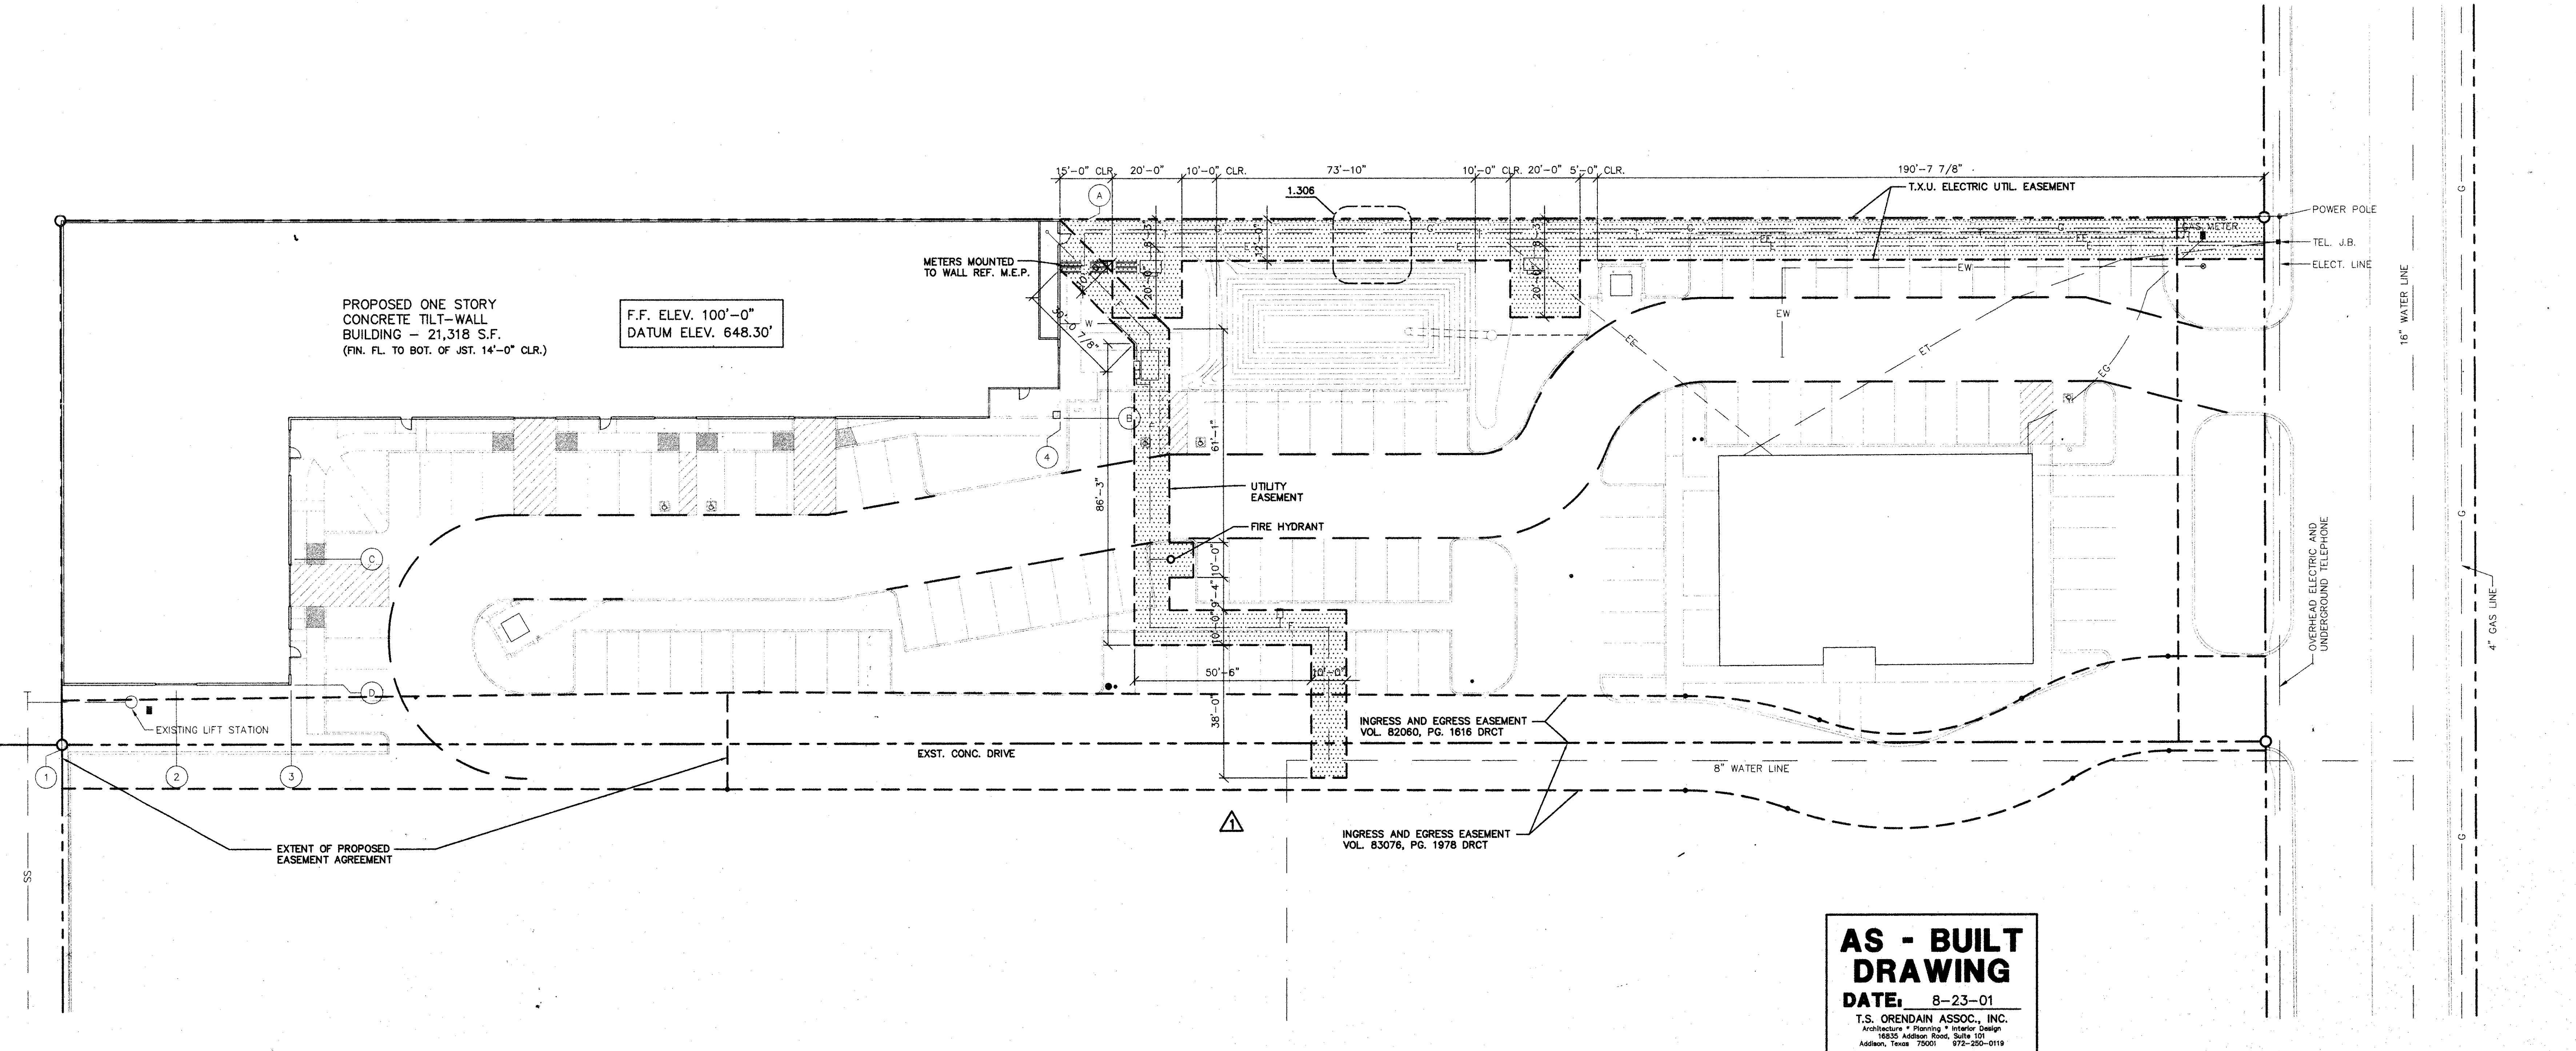


AS - BUILT DRAWING
 DATE: 8-23-01
 T.S. ORENDAIN ASSOC., INC.
 Architecture • Planning • Interior Design
 16835 Addison Road, Suite 101
 Addison, Texas 75001 972-250-0119

UTILITY EASEMENT LAYOUT SCALE: 1"=20'-0" 1.201

AMO
 16835 ADDISON ROAD
 SUITE 101 ADDISON, TX 75001
 ADDISON, TEXAS 75001
 FAX: 972-250-3157

**ADDISON PARK CENTRE
 OFFICE/TECH./FLEX.
 PHASE 1**
 16835 ADDISON ROAD ADDISON, TEXAS

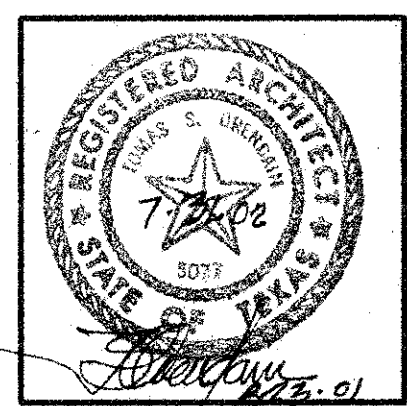

to
 T.S. Orendain Associates Inc.
 Architecture • Planning • Interior Design
 16835 Addison Road
 Suite 101 Addison, Texas 75001
 (972) 250-0119

JOB: 8396 DATE: 2/25/2000
 DRAWN: T.S.O. CHECKED: T.S.O.

Date	Issued For / Description
3-22-99	UTILITY EASEMENT REVISION
2-25-2000	100% ISSUED FOR CONSTRUCTION
8-9-2000	GENERAL REVISION
9-13-2000	△ SITE WALL REVISION

UTILITY EASEMENT LAYOUT