


AMO
 16835 ADDISON ROAD
 SUITE 101
 ADDISON, TX 75001
 PHONE: 972-250-3157
 FAX: 972-250-3157

**ADDISON PARK CENTRE
 OFFICE/TECH./FLEX.
 PHASE 1**
 16835 ADDISON ROAD ADDISON, TEXAS

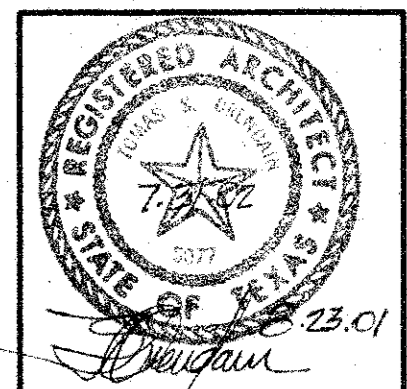

to
 T.S. Orendain Associates Inc.
 Architecture • Planning • Interior Design


16835 Addison Road
 Suite 101
 Addison, Texas 75001
 (972) 250-0119

JOB: 8396 DATE: 2/25/2000
 DRAWN: T.S.O. CHECKED: T.S.O.


Date	Issued For / Description	By
9-30-98	PERMIT ISSUE	
11-1-99	T.O.L.R.	
2-25-2000	100% ISSUED FOR CONSTRUCTION	
6-9-2000	GENERAL REVISION	
12-4-2000	EAST PARKING REVISION	

SITE DEMOLITION PLAN

D-1

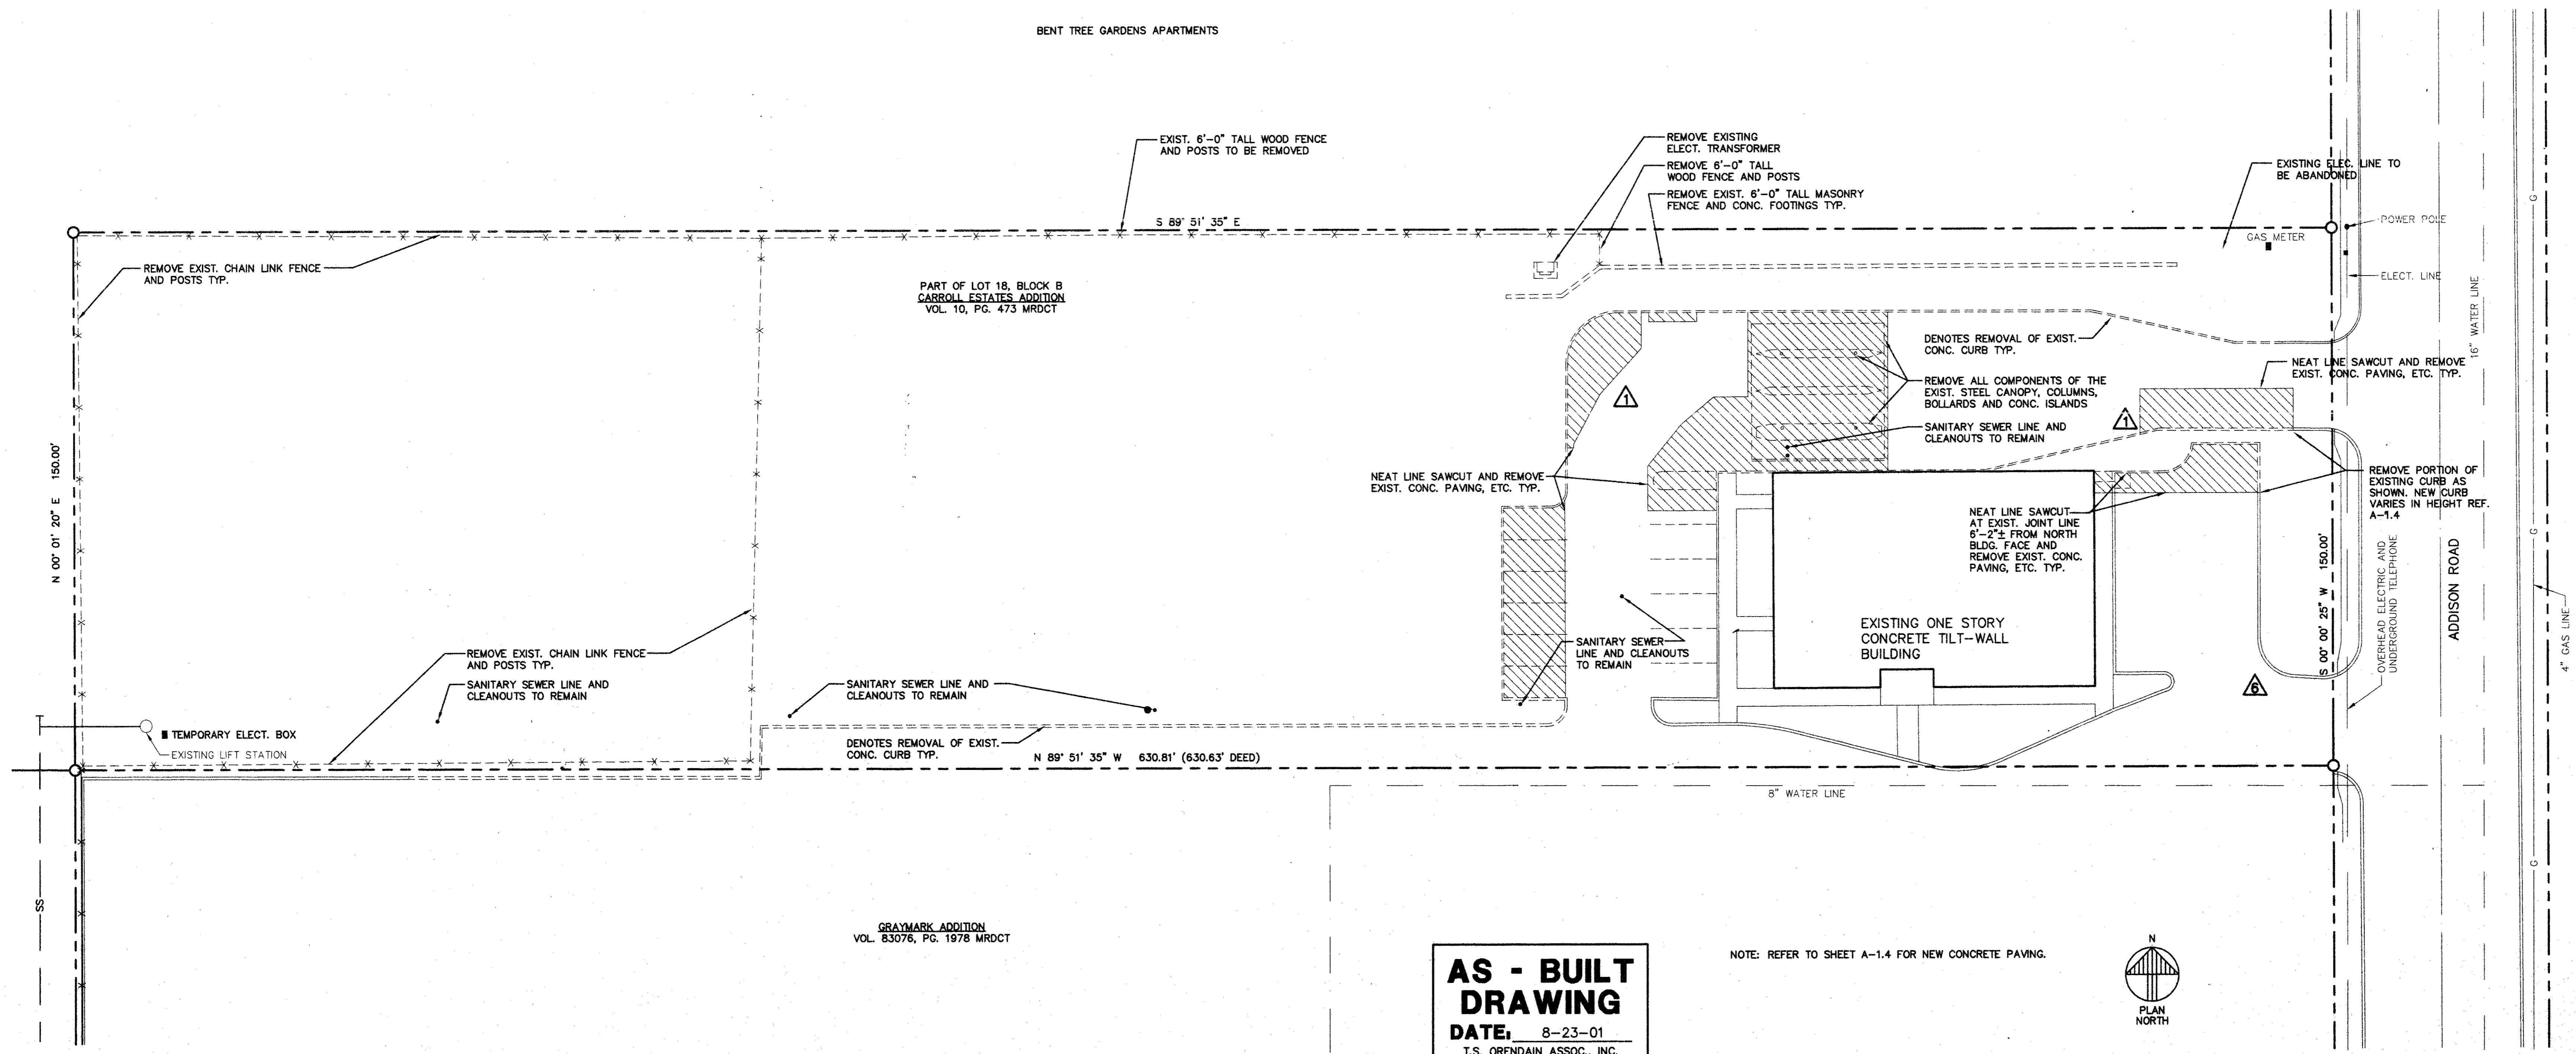

**AS - BUILT
 DRAWING**
 DATE: 8-23-01
 T.S. OREDAIN ASSOC., INC.
 Architecture • Planning • Interior Design
 16835 Addison Road, Suite 101
 Addison, Texas 75001 972-250-0119

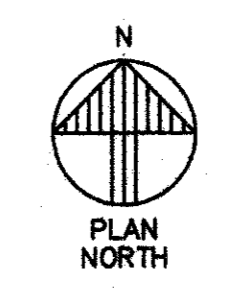

SITE DEMOLITION PLAN SCALE: 1"=20'-0" D101