SHEET

DESCRIPTION

IRRIGATION

PLAN

用数据证明

10 to 2 to 1886 A MARIE ALLEGA

David C. Baldwin, Inc. Landscape Architecture and Planning

AS - BUILT

DRAWING

T.S. ORENDAIN ASSOC., INC.

Architecture * Planning * Interior Design 16835 Addison Road, Suite 101 Addison, Texas 75001 972-250-0119

DATE: 8-23-01


STAMP CONCRETE WITH "S" AT SLEEVE LOCATION

PVC SOLVENT WELD


SCH. 40 IRRIGATION H2O AND WIRE SLEEVES.

IRRIGATION SERVICE SLEEVES

HO SCALE INSTALLATION DETAIL

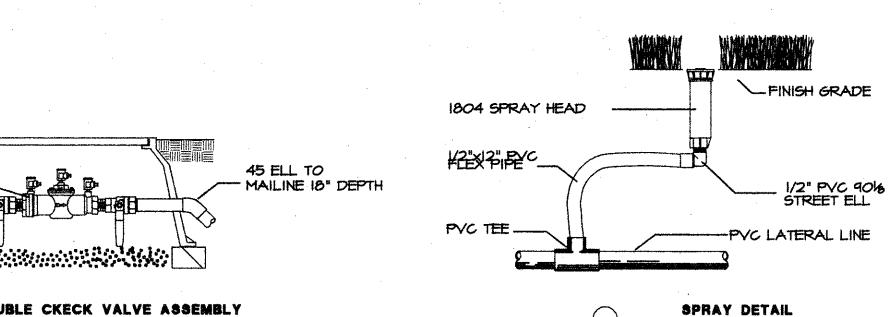


HO SCALE INSTALLATION DETAIL

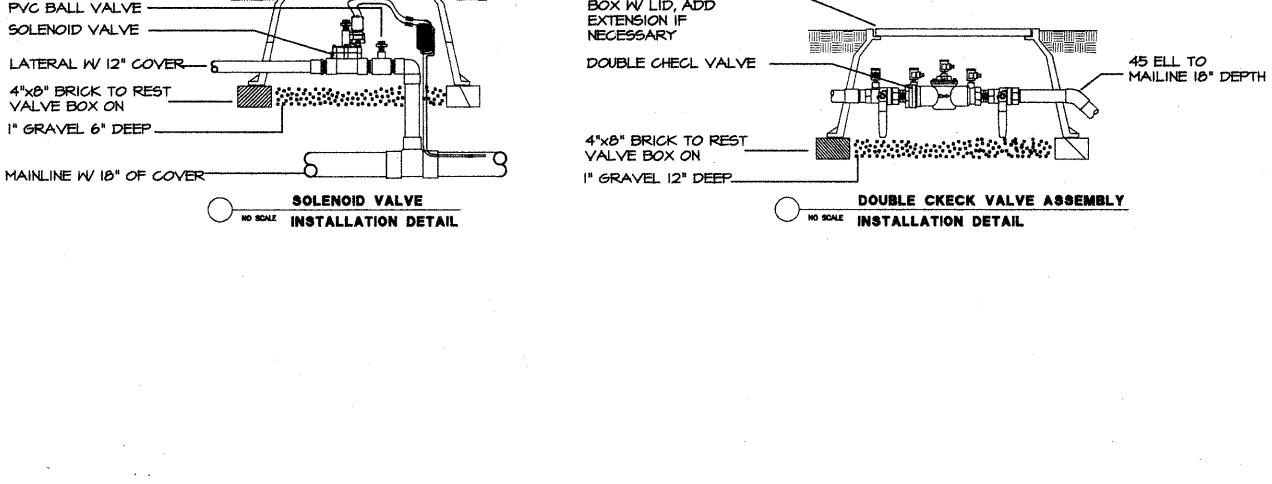

18" RECTANGLE

BOX W LID, ADD

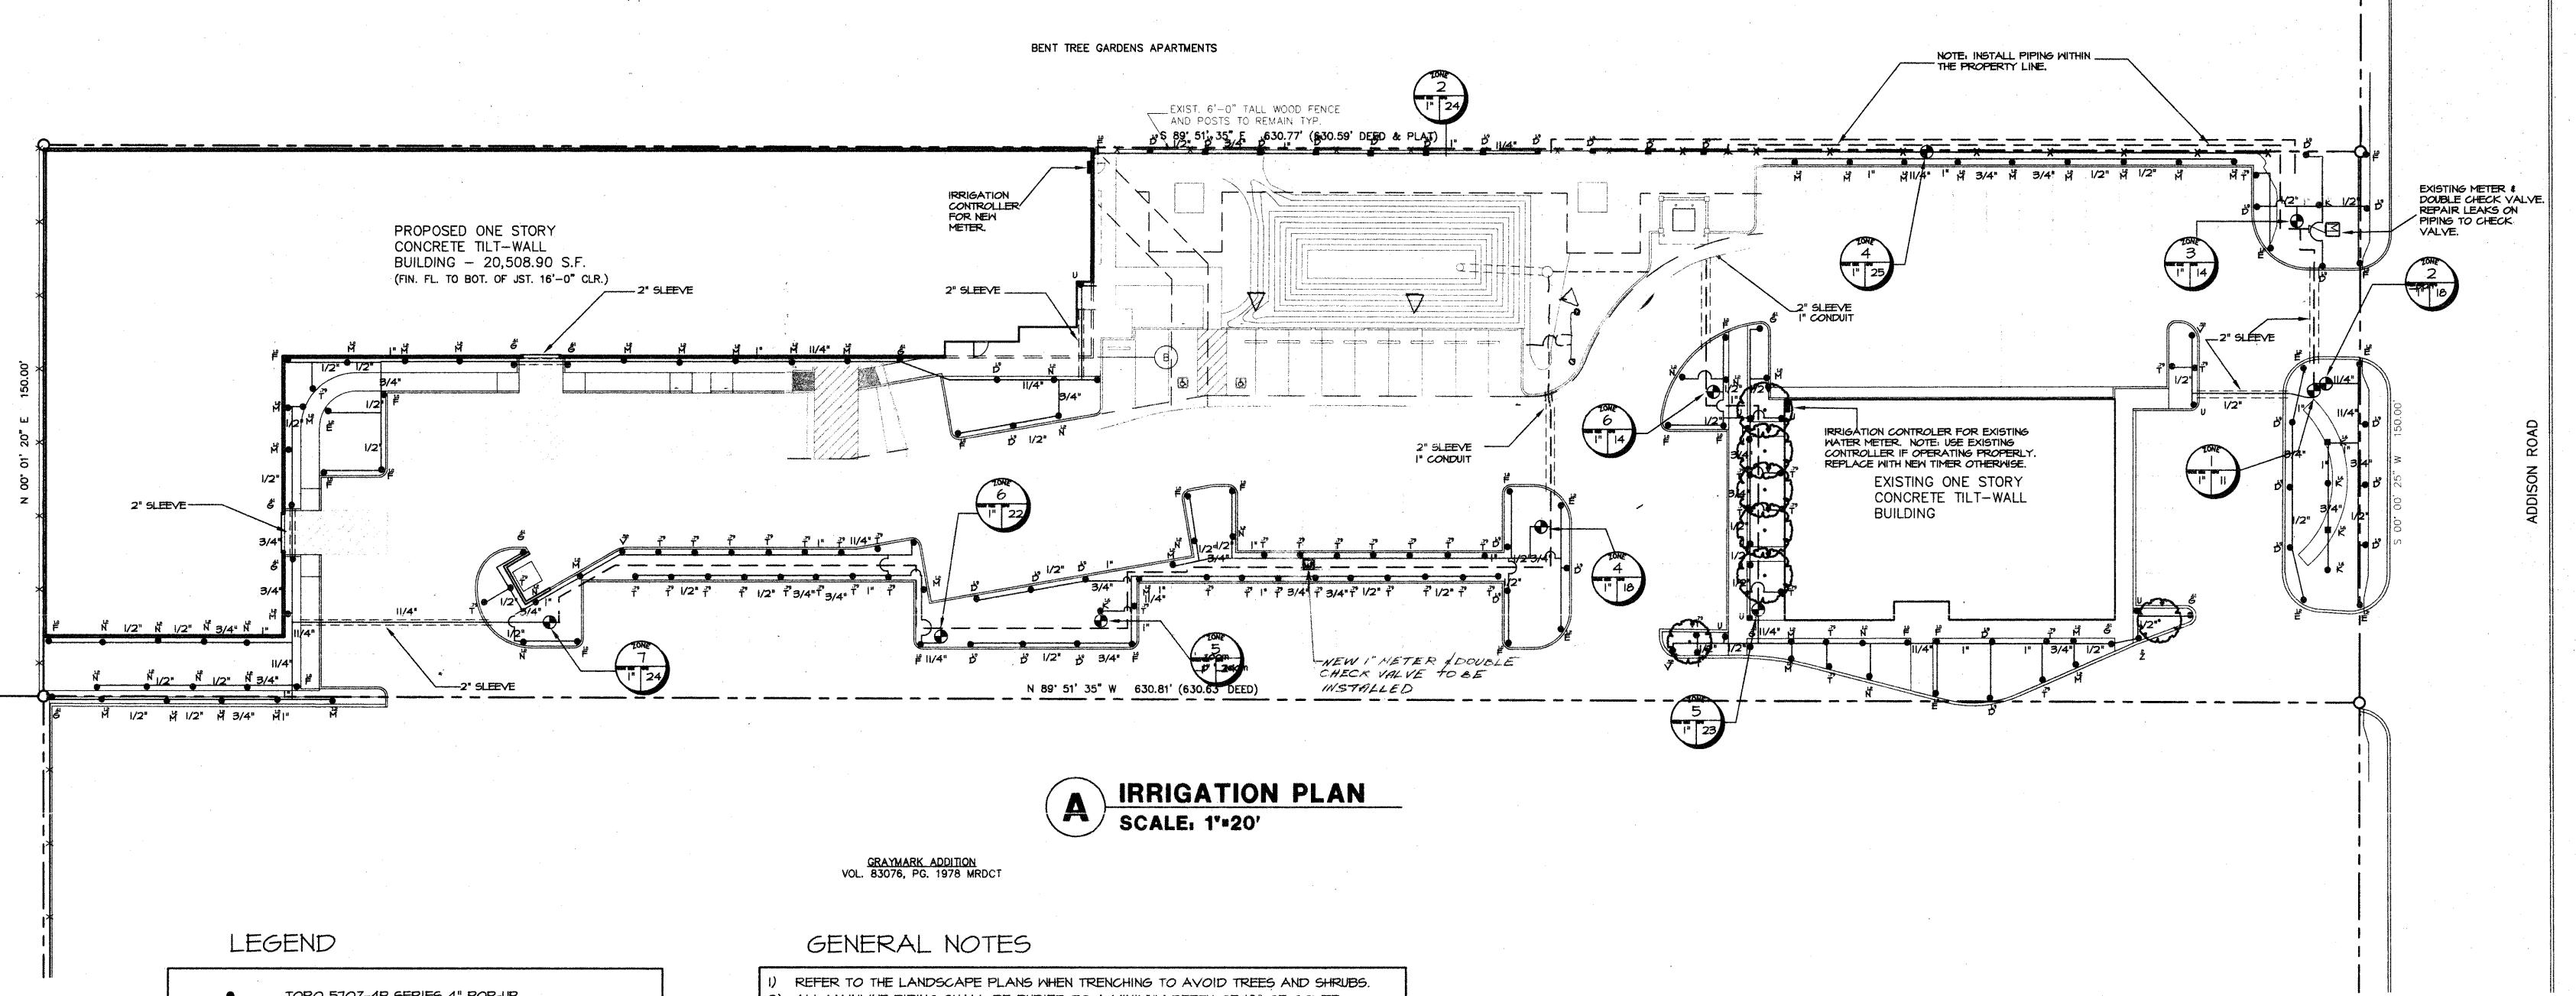

TORO 570Z-4P SERIES 4" POP-UP TORO 570Z-12P SERIES 12" POP-UP

-MOUNT CONTROLLER

SECURELY TO WALL

METAL CONDUIT

-SLEEVING WITH ELECTRIC

SWEEP AND PULL WIRE

C WALL MOUNT CONTROLLER
NO SCALE INSTALLATION DETAIL

18" RECTANGLE VALVE-

BOX W/ LID, ADD EXTENSION IF

NECESSARY

120 VOLT SOURCE METAL CONDUIT OR LIQUID TIGHT FLEXIBLE CONDUIT \$

JUNCTION BOX.

- HUNTER PGP-ADJ-07 POP-UP PART CIRCLE ROTOR IRRI-TROL 700 SERIES ELECTRIC VALVE
- SIZED AS SHOWN ON THE PLAN. - CLASS 200 21/2" PVC MAINLINE PIPING
- CLASS 200 PVC LATERAL LINE- SIZE AS SHOWN UNTIL A SMALLER SIZE IS SHOWN.
- ____ PVC SCH. 40 PIPE SLEEVES- SIZE AS SHOWN ON THE DRAWING.
- CONTROLLER-IRRI-TROL RD900-INT-9 STATION WALL MOUNT IRRIGATION CONTROLLER AS SHOWN INSTALL A MINI-CLIK RAIN AND FREEZE SENSOR, GROUND AS RECOMMENDED BY THE MANUFACTURE. SLEEVE TO AS REQUIRED.
 - BACKFLOW PREVENTER-3/4" DOUBLE CHECK VALVE TYPE.
- METER I"-SYSTEM DEMAND IS 25 GPM AT 60 PSI.

- 2) ALL MAINLINE PIPING SHALL BE BURIED TO A MINIMUM DEPTH OF 18" OF COVER.
- ALL LATERAL PIPING SHALL BE BURIED TO A MINIMUM DEPTH OF 12" OF COVER. 3) ALL POP-UP ROTORS AND SPRAYS SHALL BE INSTALLED USING AN 18" PVC FLEX
- PIPE CONNECTION. DO NOT USE FUNNY PIPE. 4) ADJUST ALL NOZZLES TO REDUCE WATER WASTE ON HARD SURFACES & BLDG. WALLS.
- 5) THROTTLE ALL VALVES ON SHRUB LINES AS REQUIRED TO PREVENT FOGGING.
- 6) ALL CONTROL WIRE SHALL BE UF-14/1 DIRECT BURIAL CABLE, ALL SPLICES SHALL BE MADE USING DBY-3M WATER-PROOF CONNECTORS. THE CONTRACTOR SHALL PREPARE AN AS-BUILT DRAWING ON A REPRODUCIBLE
- PAPER (SEPIA OR MYLAR) SHOWING ALL IRRIGATION INSTALLATION. A MYLAR OR SEPIA OF THE ORIGINAL PLAN MAYBE OBTAINED FROM THE LANDSCAPE ARCHITECT FOR A FEE. THE DRAWING SHALL LOCATE ALL MAINLINE AND VALVES BY SHOWING EXACT MEASUREMENTS FROM HARD SURFACES.
- 8) ALL VALVES, GATE VALVES AND QUICK COUPLERS SHALL BE INSTALLED IN VALVE
- 9) ANY PIPING SHOWN OUTSIDE THE PROPERTY LINE OR RUNNING OUTSIDE A LANDSCAPE AREA IS SHOWN THERE FOR CLARITY ONLY. ALL LINES SHALL BE INSTALLED ON THE PROPERTY AND INSIDE THE LANDSCAPE AREAS.
- 10) ALL RISERS SHALL BE INSTALLED 12" FROM ANY WALL AND A MINIMUM OF 12' FROM ANY SIDEWALK, PATIO OR ROAD. 11) THE EXACT HEIGHT OF ANY 12" POP-UP THAT IS SHOWN IN A SHRUB BED SHALL BE
- DETERMINED BY THE LANDSCAPE ARCHITECT IN THE FIELD. 12) THE CONTRACTOR SHALL EXERCISE CARE SO AS NOT TO DAMAGE ANY EXISTING UTILITIES. THE CONTRACTOR SHALL BE RESPONSIBLE FOR THE IMMEDIATE REPAIRS
- AND COST OF ANY DAMAGE CAUSED BY HIS WORK. 13) ALL WORK SHALL BE GUARANTEED FOR ONE YEAR FROM THE DATE OF FINAL
- 14) ELECTRICAL SERVICE TO ALL EQUIPMENT SHALL BE PROVIDED TO A JUNCTION

BOX AT THE EQUIPMENT LOCATION BY OTHERS.

ACCEPTANCE AGAINST ALL DEFECTS IN EQUIPMENT AND WORKMANSHIP.

NOZZLE CHART

| LETTER | MODEL | GMP AT 30 PSI | RADIUS | PATTERN |
|------------|-------------------|------------------|-----------|---------------|
| Α | 15-F | 3.6 | 15' | FULL |
| В | 15-TQ | 2.6 | 15' | THREE QTR. |
| . 0 | 15-TT | 2.2 | 15' | TWO THIRD |
| · D | 15 -11 | 1.65 | .5 15' | HALF |
| E | 15-T | 1.1 | 15' | ONE THIRD |
| F | 15-Q | .e5 | 15' | QUARTER |
| 6 | 4-EST | .45 | 4' X 15' | END STRIP |
| H | 4-CST | .90 | 4' X 30' | CENTER STRIP |
| J | 513-2-180 | .86 | 5' | STRIP BUBBLER |
| K | 12-F | 2.19 | 12' | FULL |
| L | 9-55T | 1.2 | 4' XIB' | SIDE STRIP |
| М | 4-55T | .90 | 4' X 30' | SIDE STRIP |
| N | 12-H | 1.09 | 12' | LOW GALLONAGE |
| P | 12-T | .72 | 12' | LOW ONE THIRD |
| R | 12-Q | .50 | 12' | LOW QUARTER |
| 5 | 10-F | 1.49 | 10' | FULL |
| T | 10 -11 | .71 | 10' | HALF |
| Ü | 10-a | .30 | 101 | QUARTER |
| V | IO-T | <i>.</i> 52 | 10' | ONE THIRD |
| M | 8-F | .30 | ු ව' | FULL |
| × | 8-H | 50 | 8' | HALF |
| Y | 6-T | .30 | 8' | ONE THIRD |
| Z | V-15 | VARIES | 15' | ADJUSTABLE |
| | | 11/4/11 | | |

5744 Richmond Avenue Dallas, Texas 75206 Ph: 214/821-8100 Fax: 214/824-5562

rtela, ot varalitoti eta eriandaliaken etain allan aritakaken kalakian. Vetalakialiakala aritoteka kalakia