
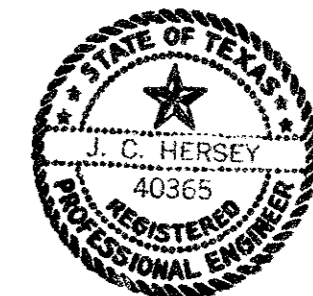



DATE: _____
 BY: _____
 SURVEYED: _____
 NOTED: _____
 NOTE BOOK No. _____
 CHECKED: _____
 SUBSTRUCTURE NOTATIONS CHECKED: _____

NOTE:
 1. All Construction Shall Conform To Standard Specifications And Requirements Of The City Of Addison Texas.
 2. Grade Elevations Of Existing Manholes Supplied By Talon Const. Co.

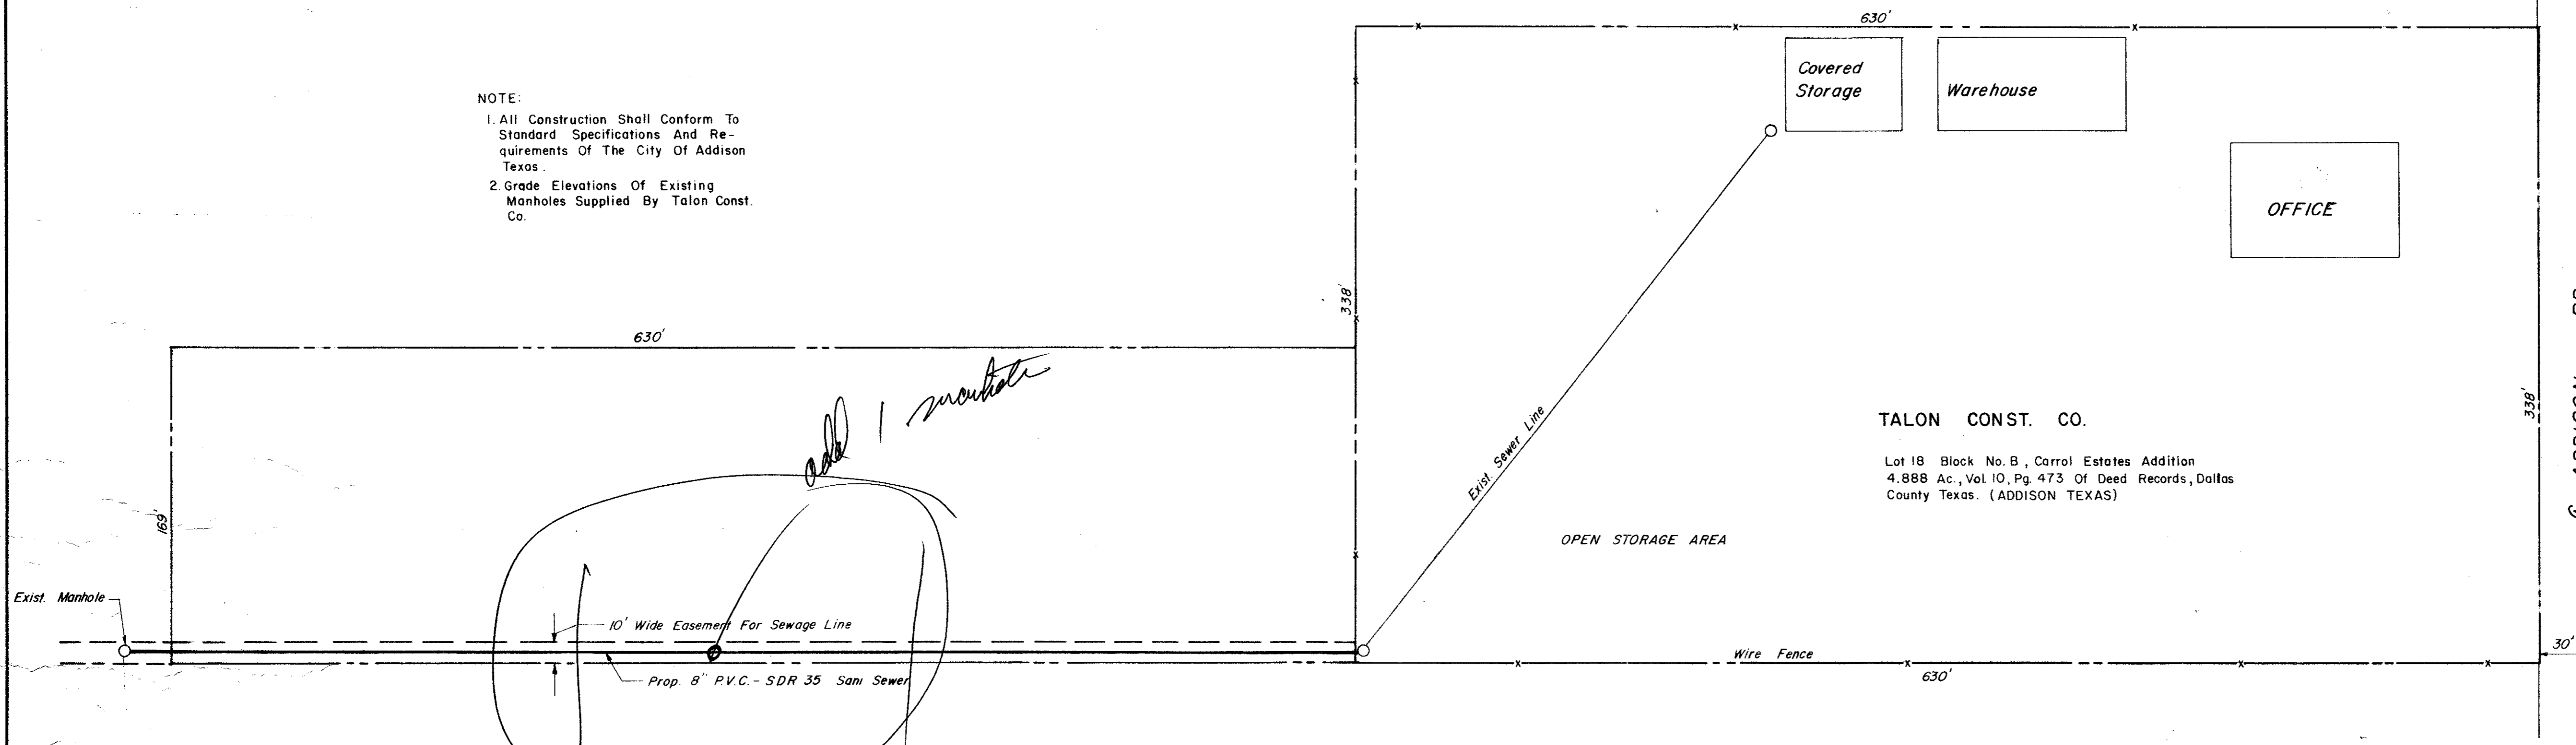

TALON CONST. CO.
 8" SEWER LINE
 Designed By: HERSEY & ASSOCIATES
 Scale: Hor. = 1" = 50', Ver. = 1" = 5' Date: 5/14/80 SH_1 of 1

DATE: _____
 BY: _____
 SURVEYED: _____
 NOTED: _____
 NOTE BOOK No. _____
 CHECKED: _____
 SUBSTRUCTURE NOTATIONS CHECKED: _____

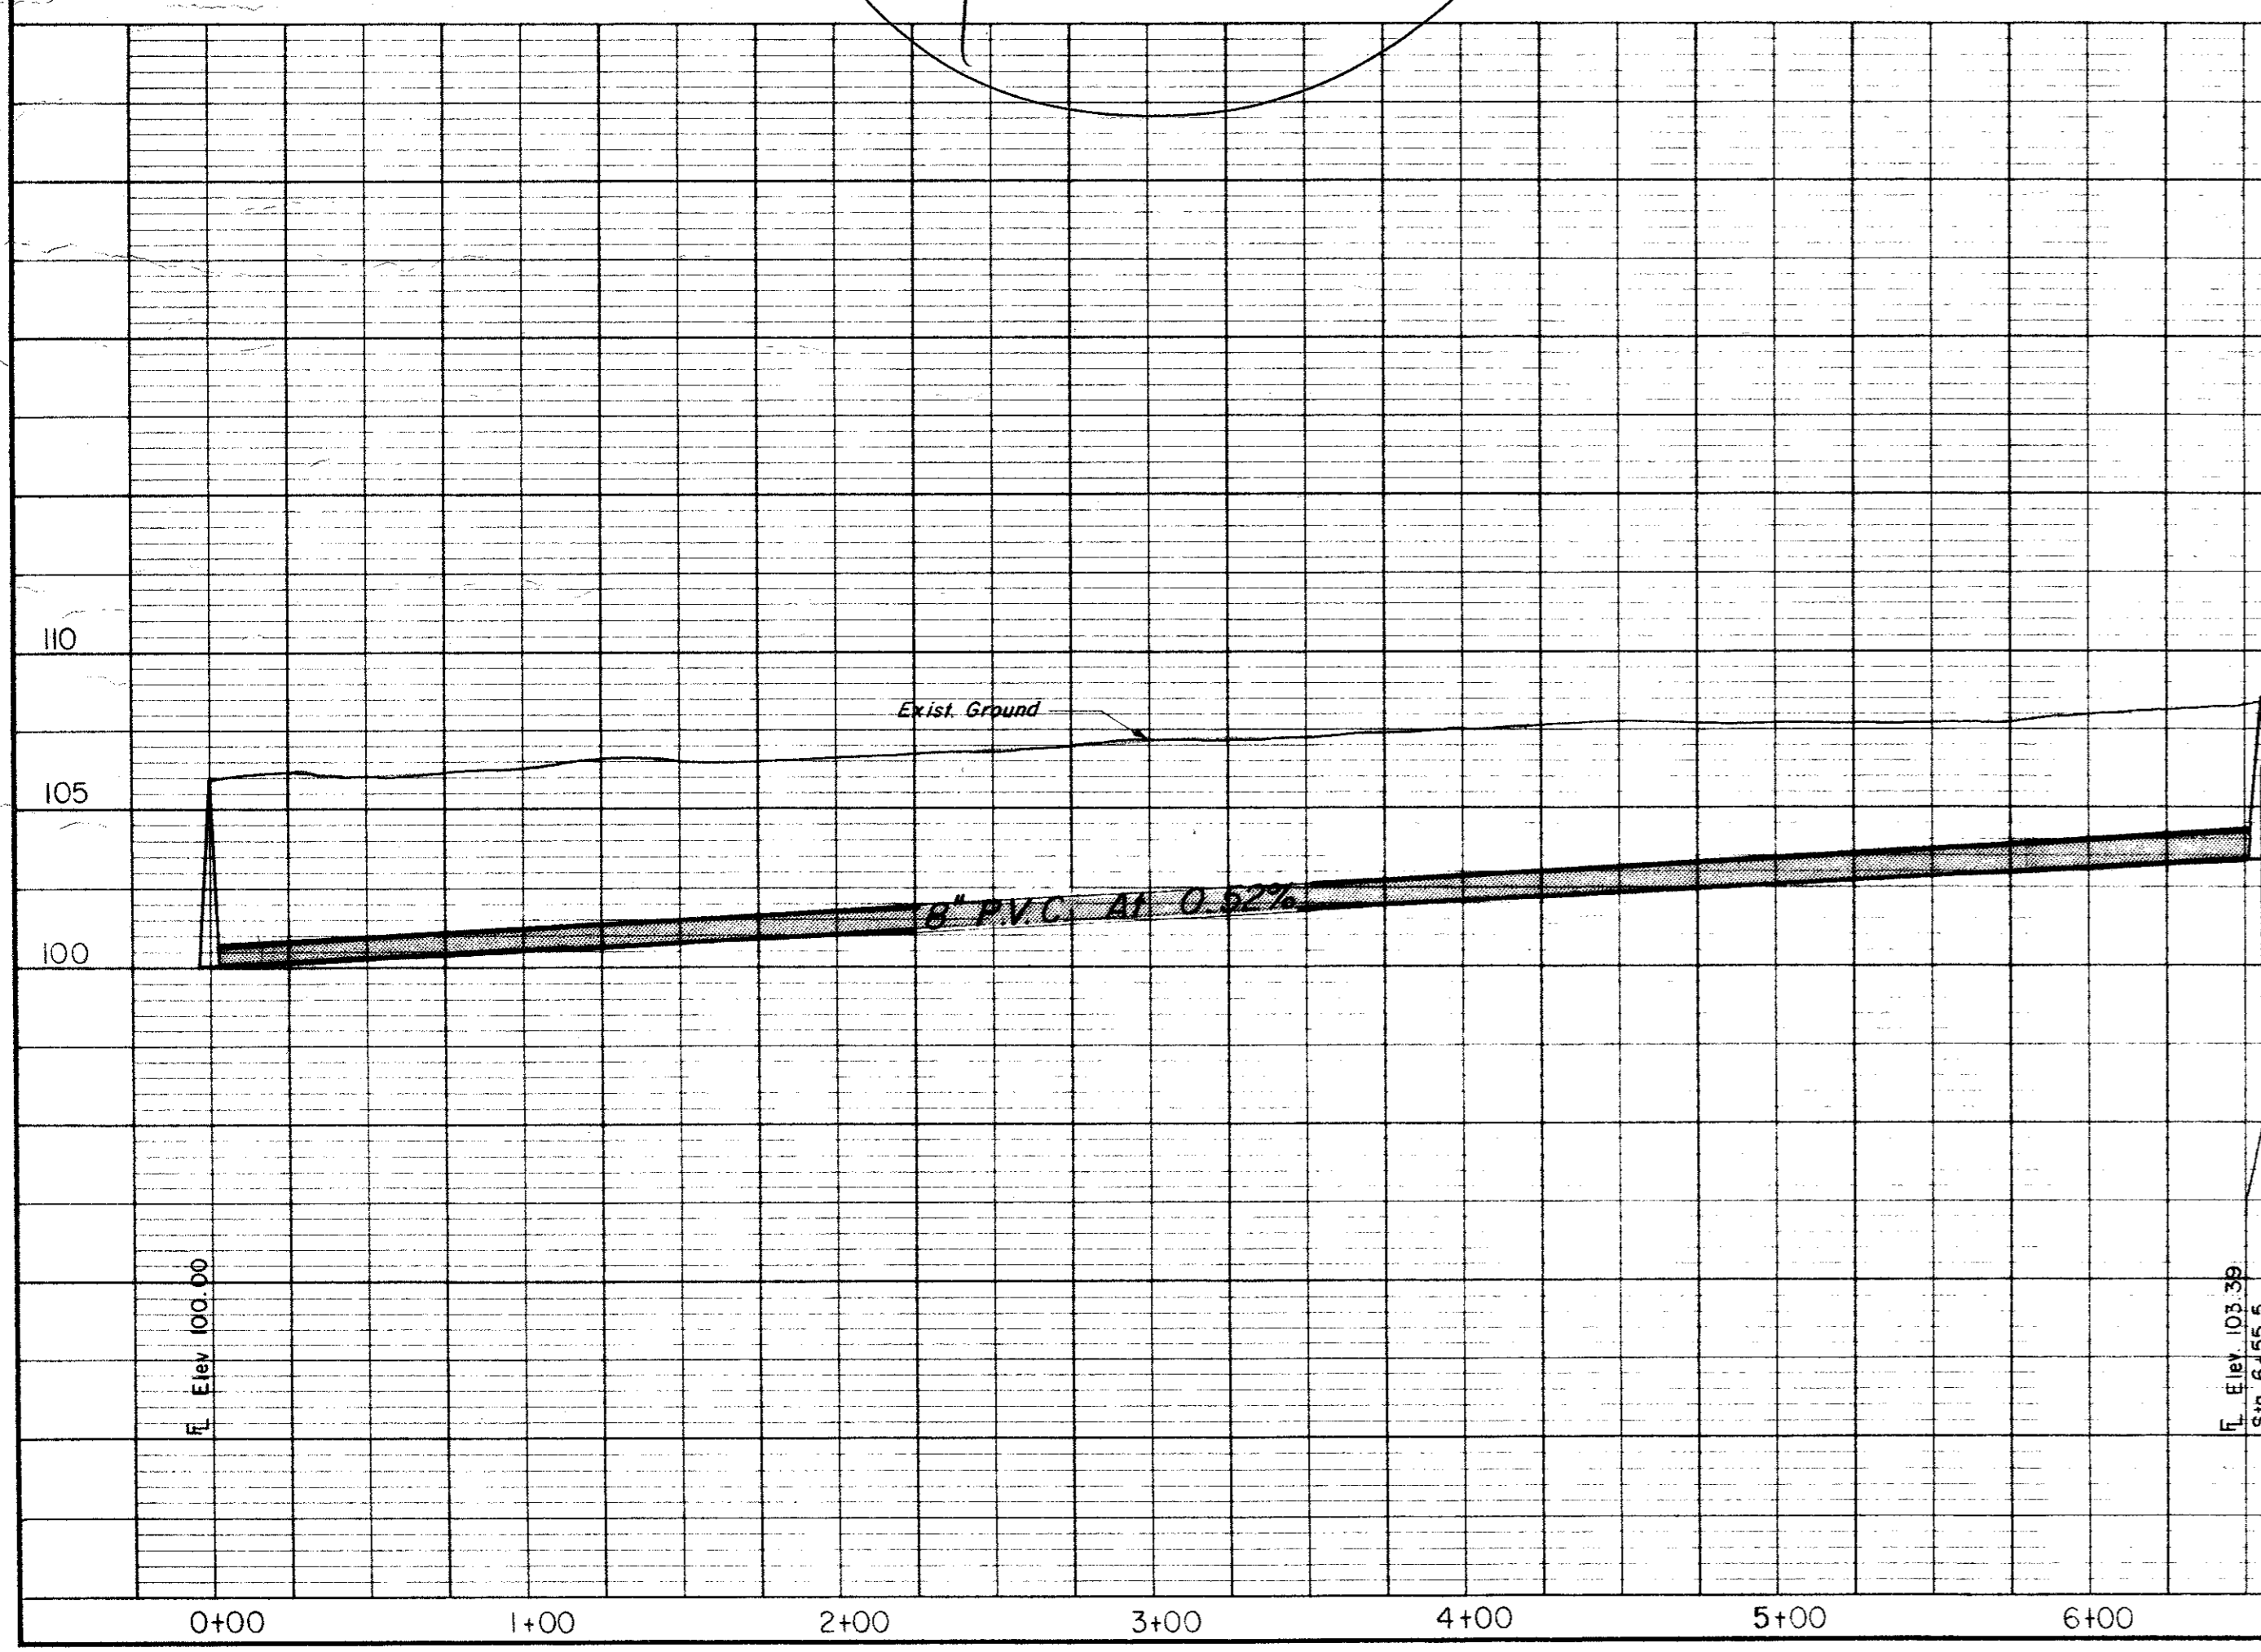

CITY OF ADDISON APPROVED
 5-15-80
 BUILDING DEPARTMENT
 DATE: _____
 NOTE: CONTRACTOR SHALL BE RESPONSIBLE FOR OBTAINING ALL NECESSARY PERMITS AND APPROVALS FROM ALL AFFECTED AGENCIES.
 EXEMPTION FROM THE CITY OF ADDISON BUILDING DEPARTMENT SHALL BE THE RESPONSIBILITY OF THE CONTRACTOR.
 ALL WORK SHALL BE IN ACCORDANCE WITH THE CITY OF ADDISON STANDARD SPECIFICATIONS FOR SEWER CONSTRUCTION.