
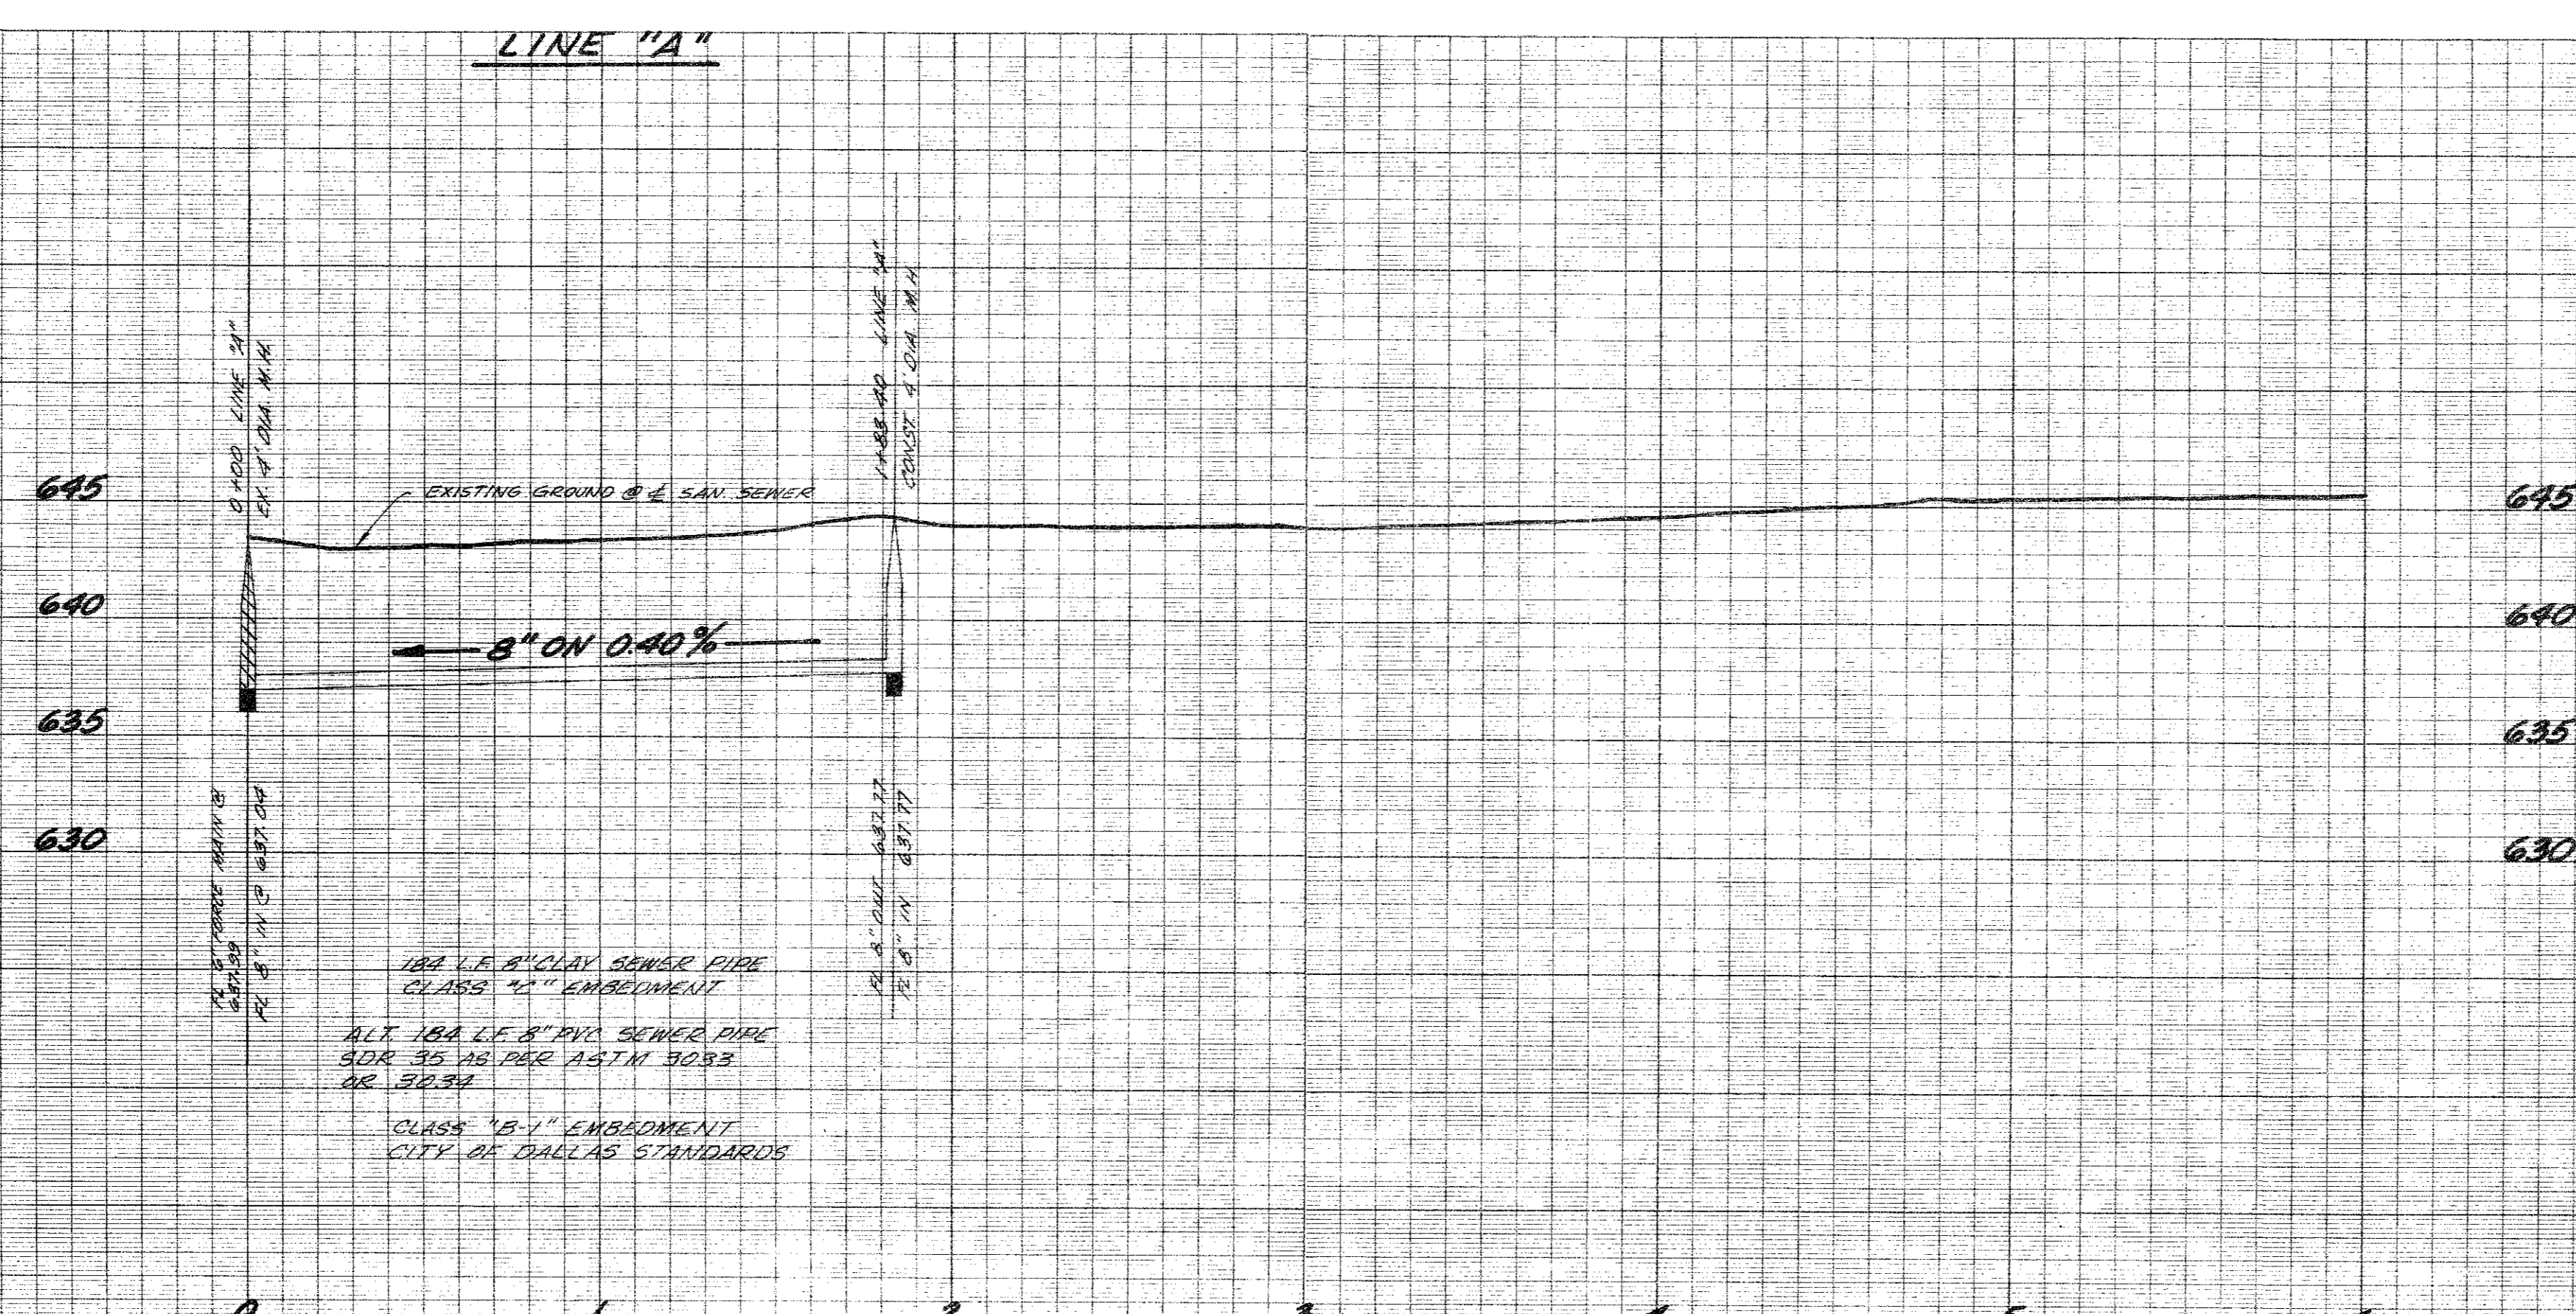



SCALE: 1"=100'

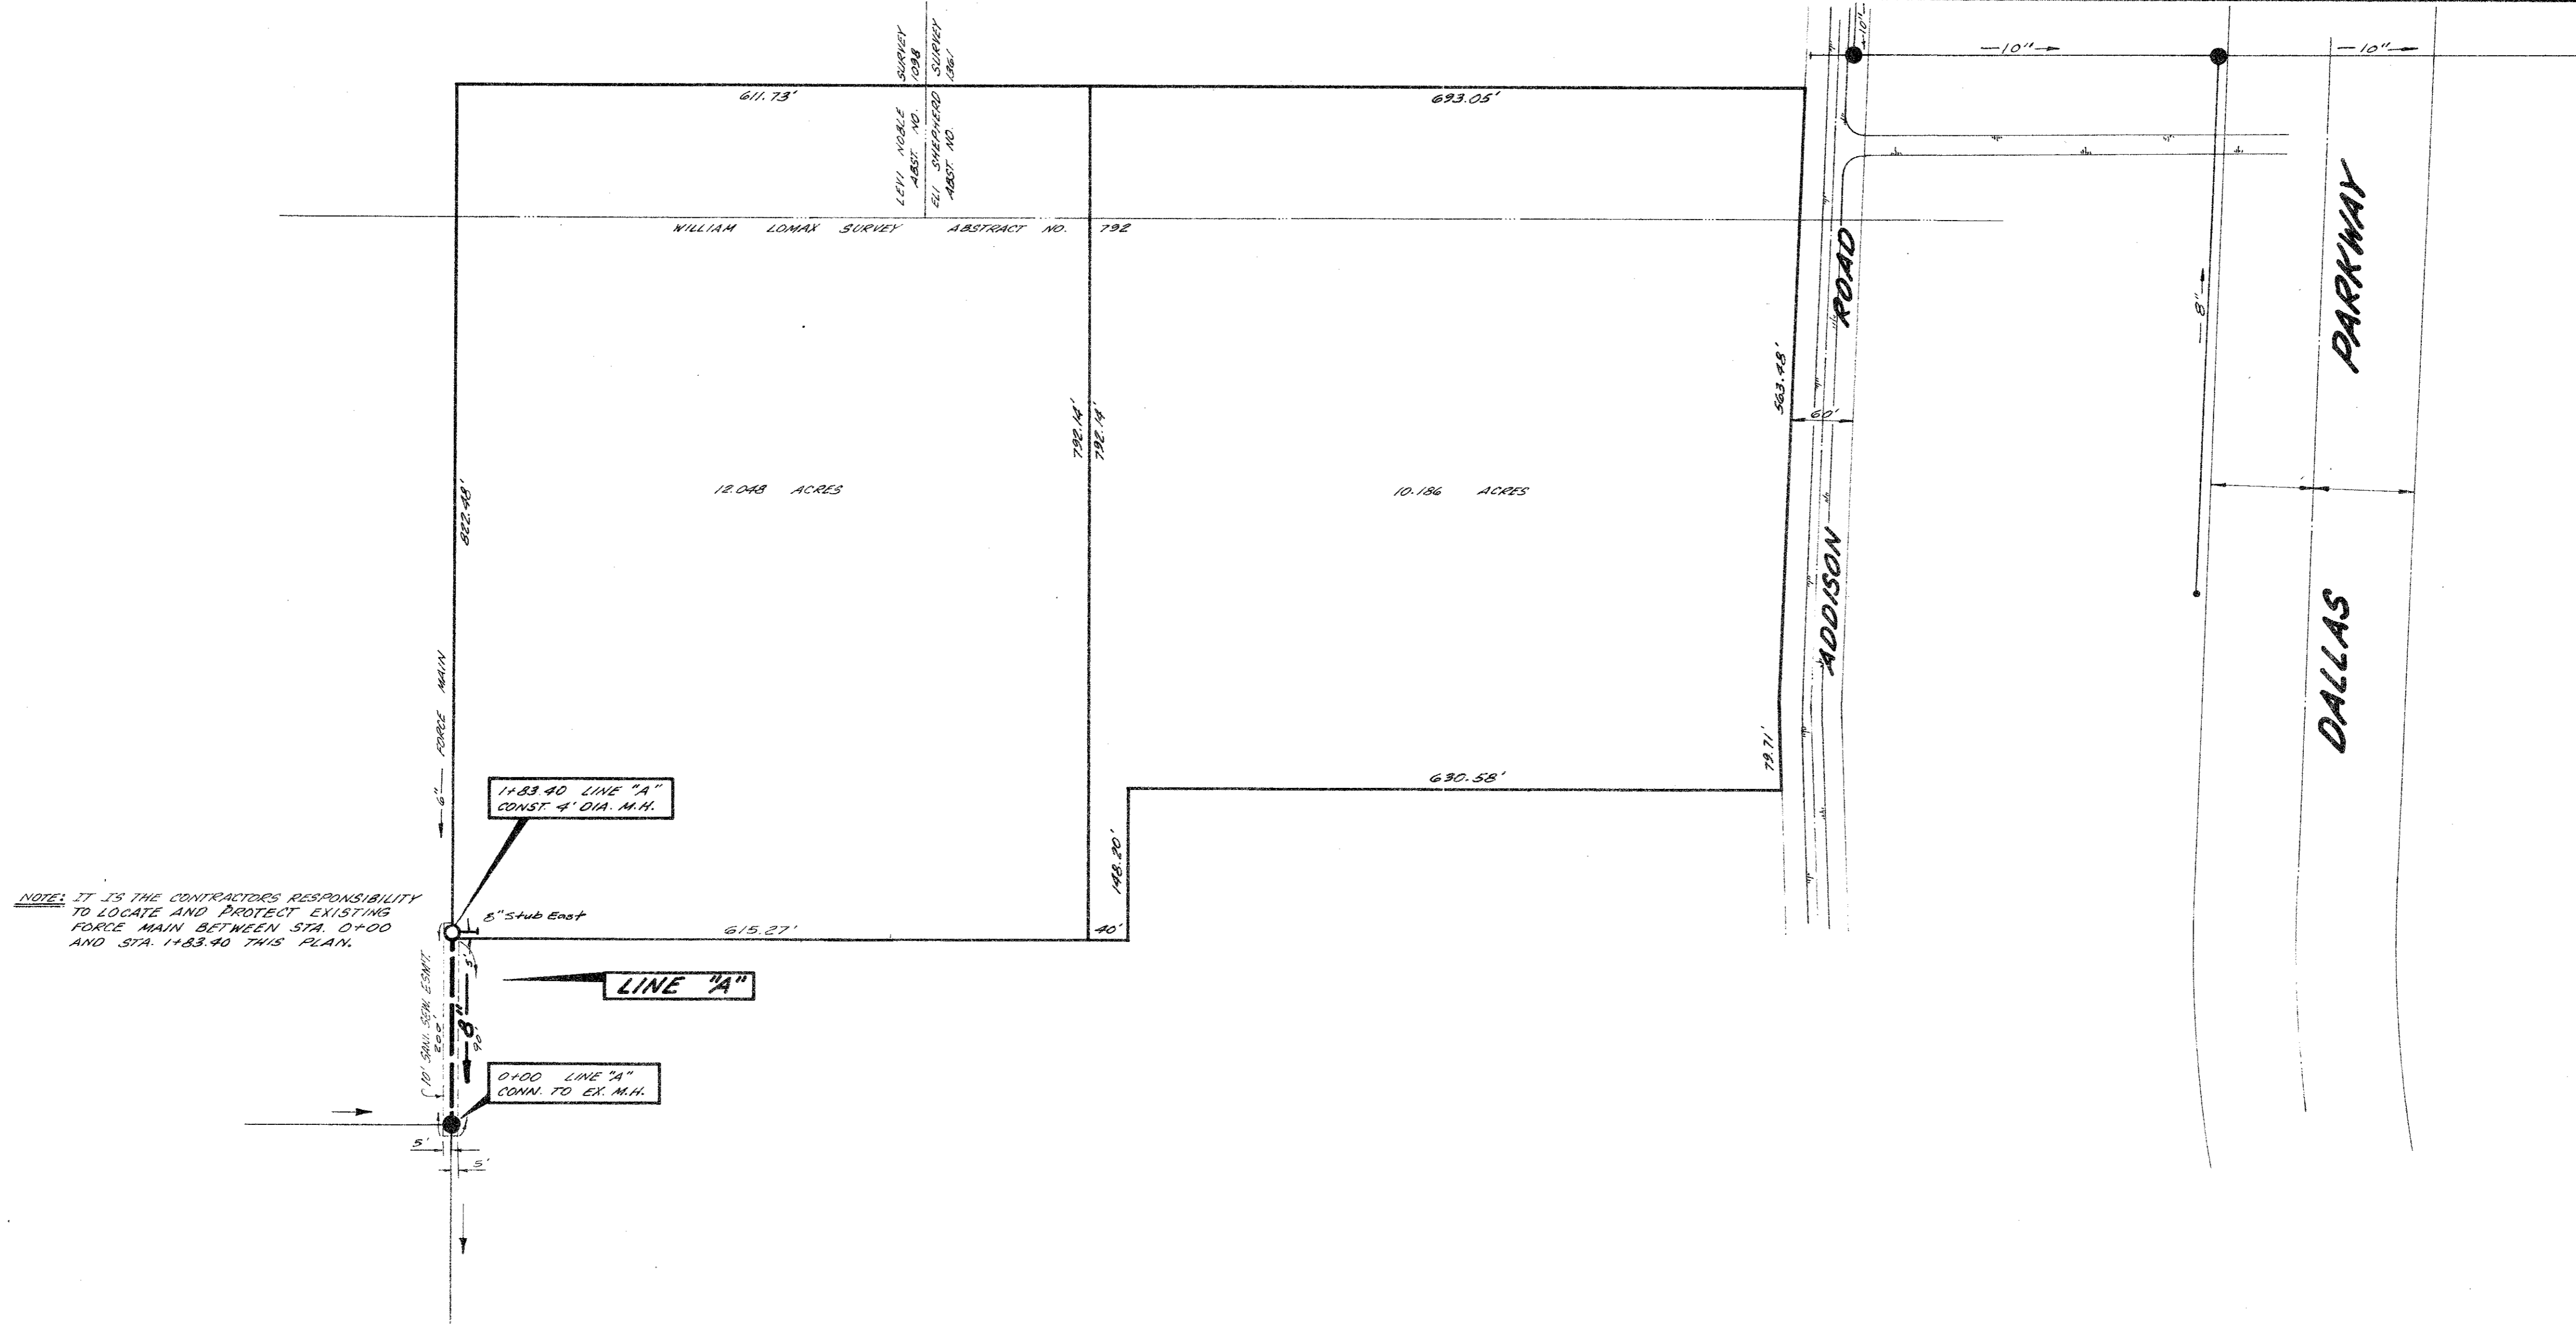

NOTE: IT WILL BE THE CONTRACTOR'S RESPONSIBILITY TO VERIFY THE LOCATION AND TO PROTECT ALL EXISTING UTILITIES.

UTILITY MARK: MARK IN THE WEST SIDE OF DUDLEY ROAD AND APPROX. 230' NORTH OF SOUTHWEST CORNER OF THE TEXAS CHRISTIAN ACADEMY TRACT. ELEV. 640.24

18" I.E. 8" CLAY SEWER PIPE CLASS 2" EMBELEMNT
 ALL 18" I.E. 8" PVC SEWER PIPE SDR 35 AS PER ASTM 9003 OR 9004
 CLASS "B-1" EMBELEMNT CITY OF DALLAS STANDARDS

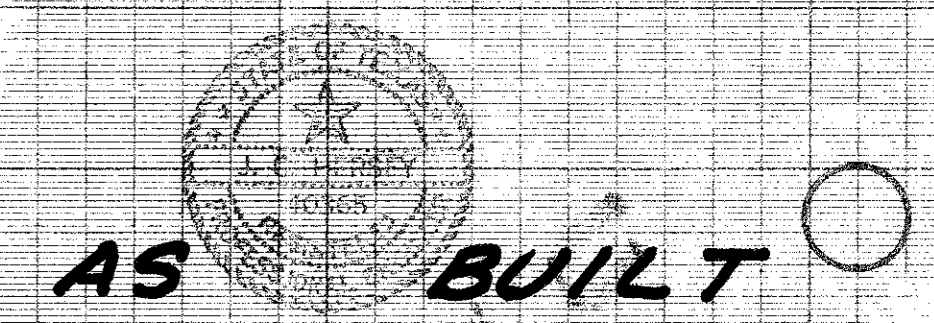

WATER & SEWER PLANS
 BENT TREE TOWERS APARTMENTS
 ADDISON ROAD
 ADDISON WATER UTILITIES
 CITY OF ADDISON, TEXAS

MAY 17, 1978

DESIGN	DRAWN	DATE	SCALE	NOTES	FILE	NO.
T.F.D.	T.O.K.	AUG. 77	1"=60'	T&D		

2017