



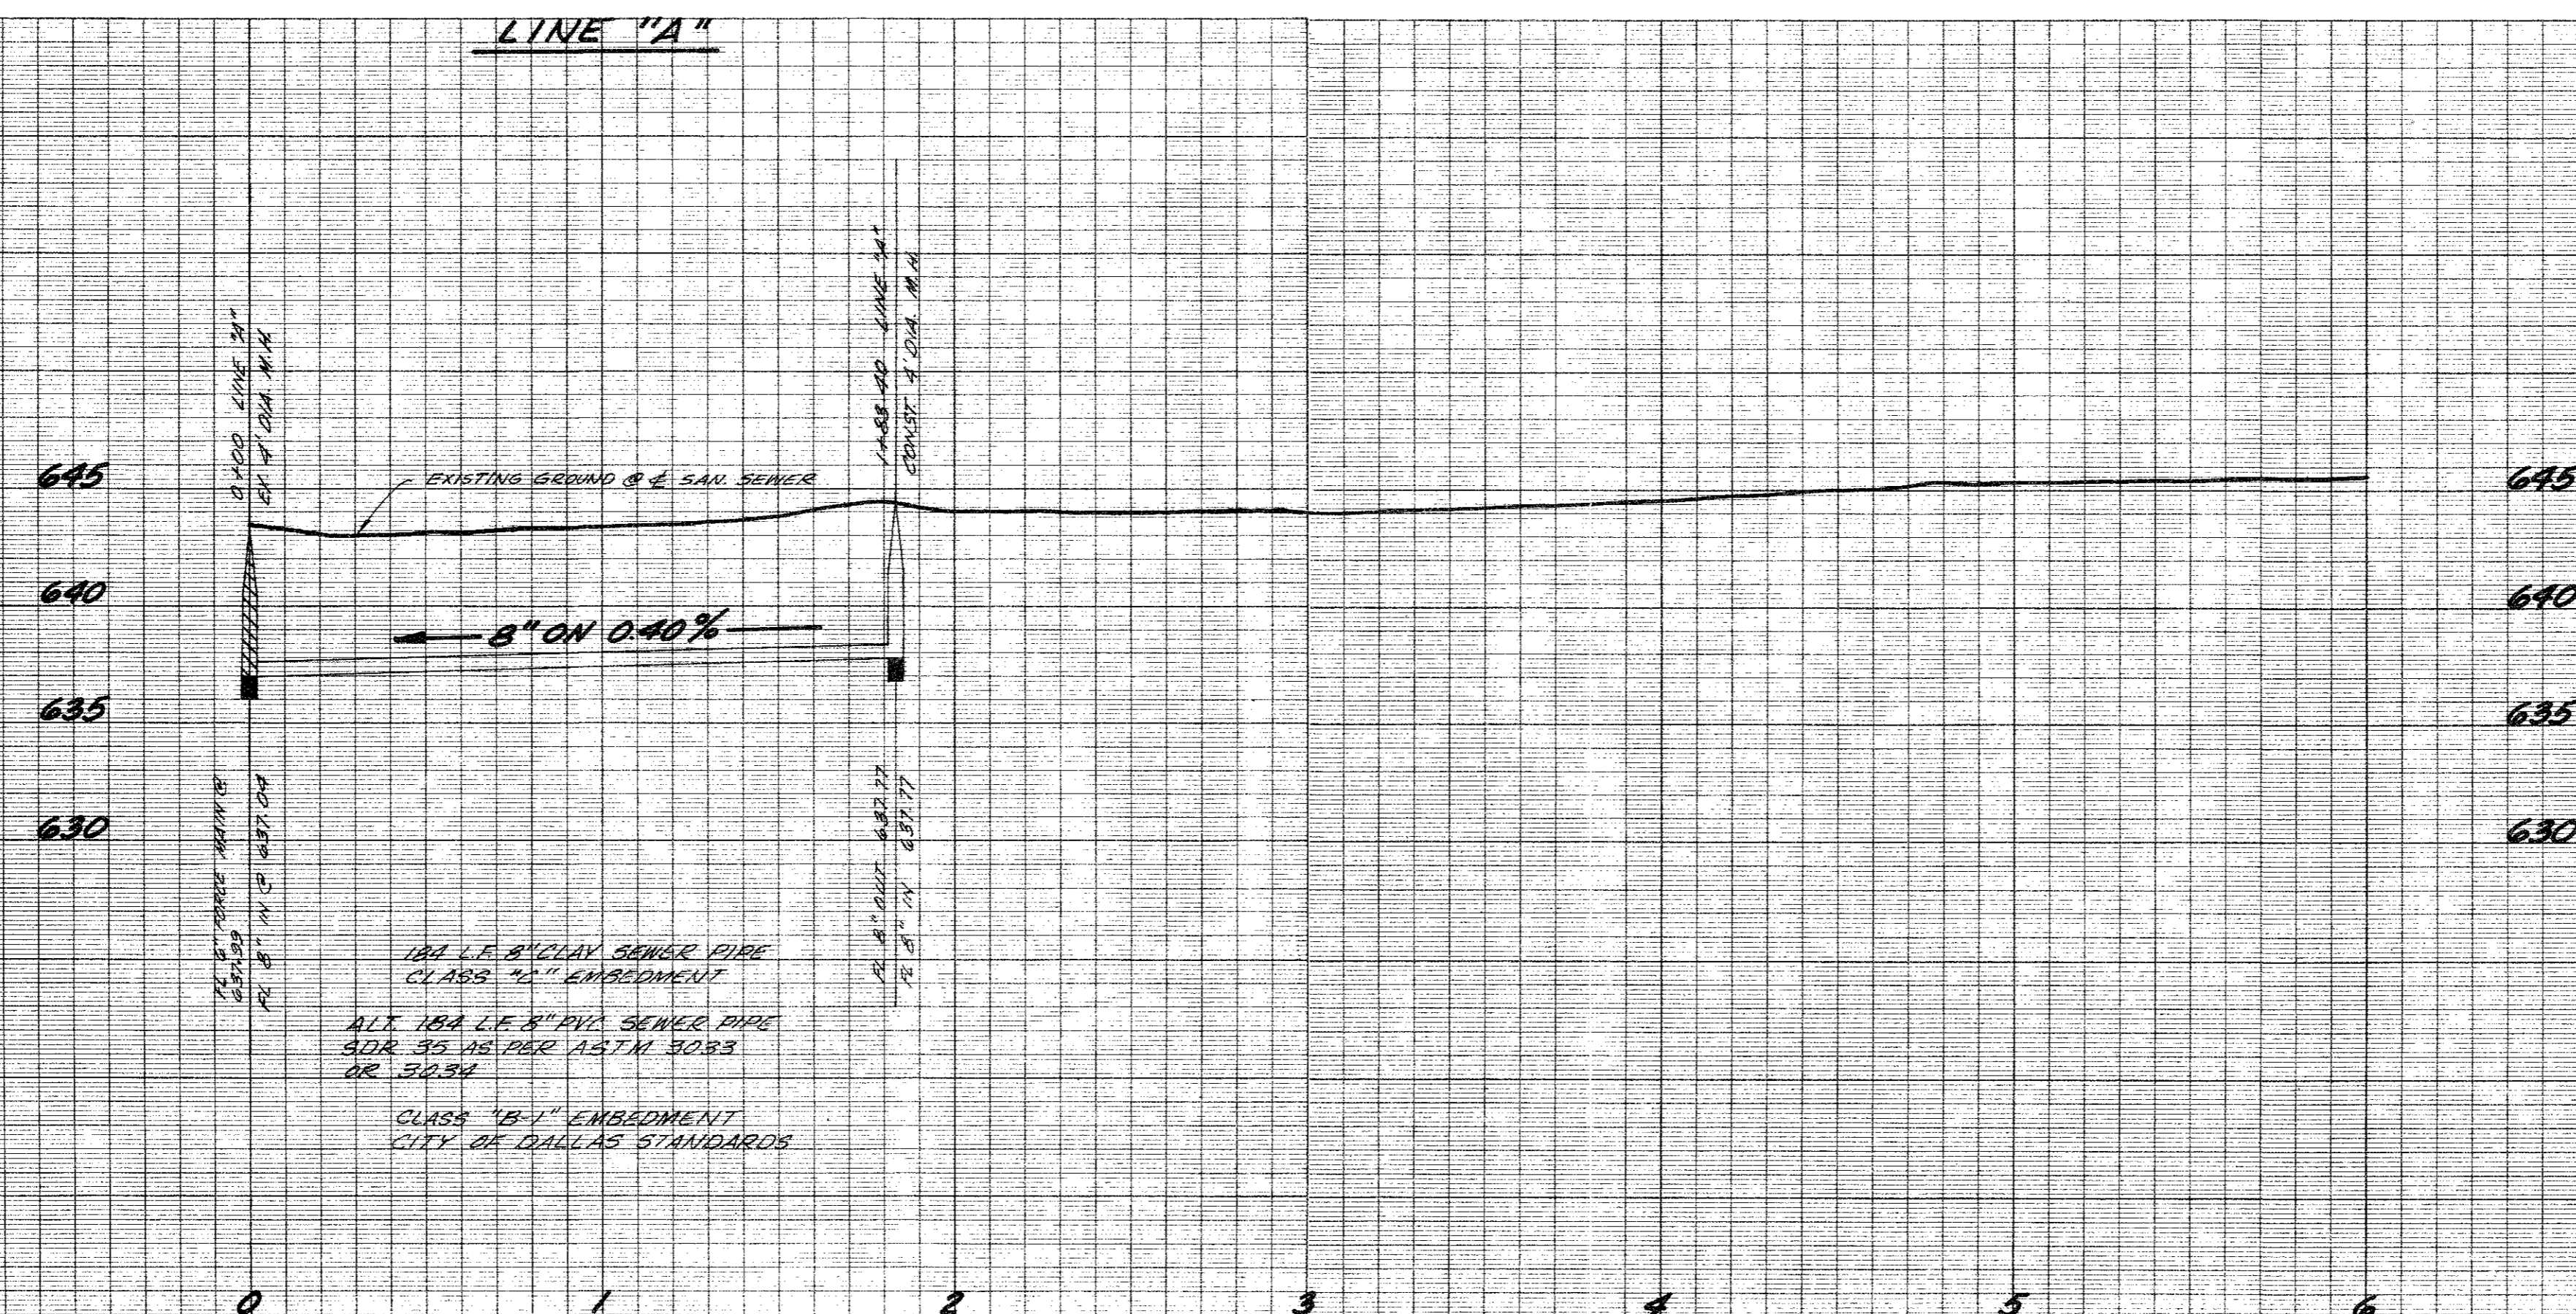

SCALE: 1"=100'

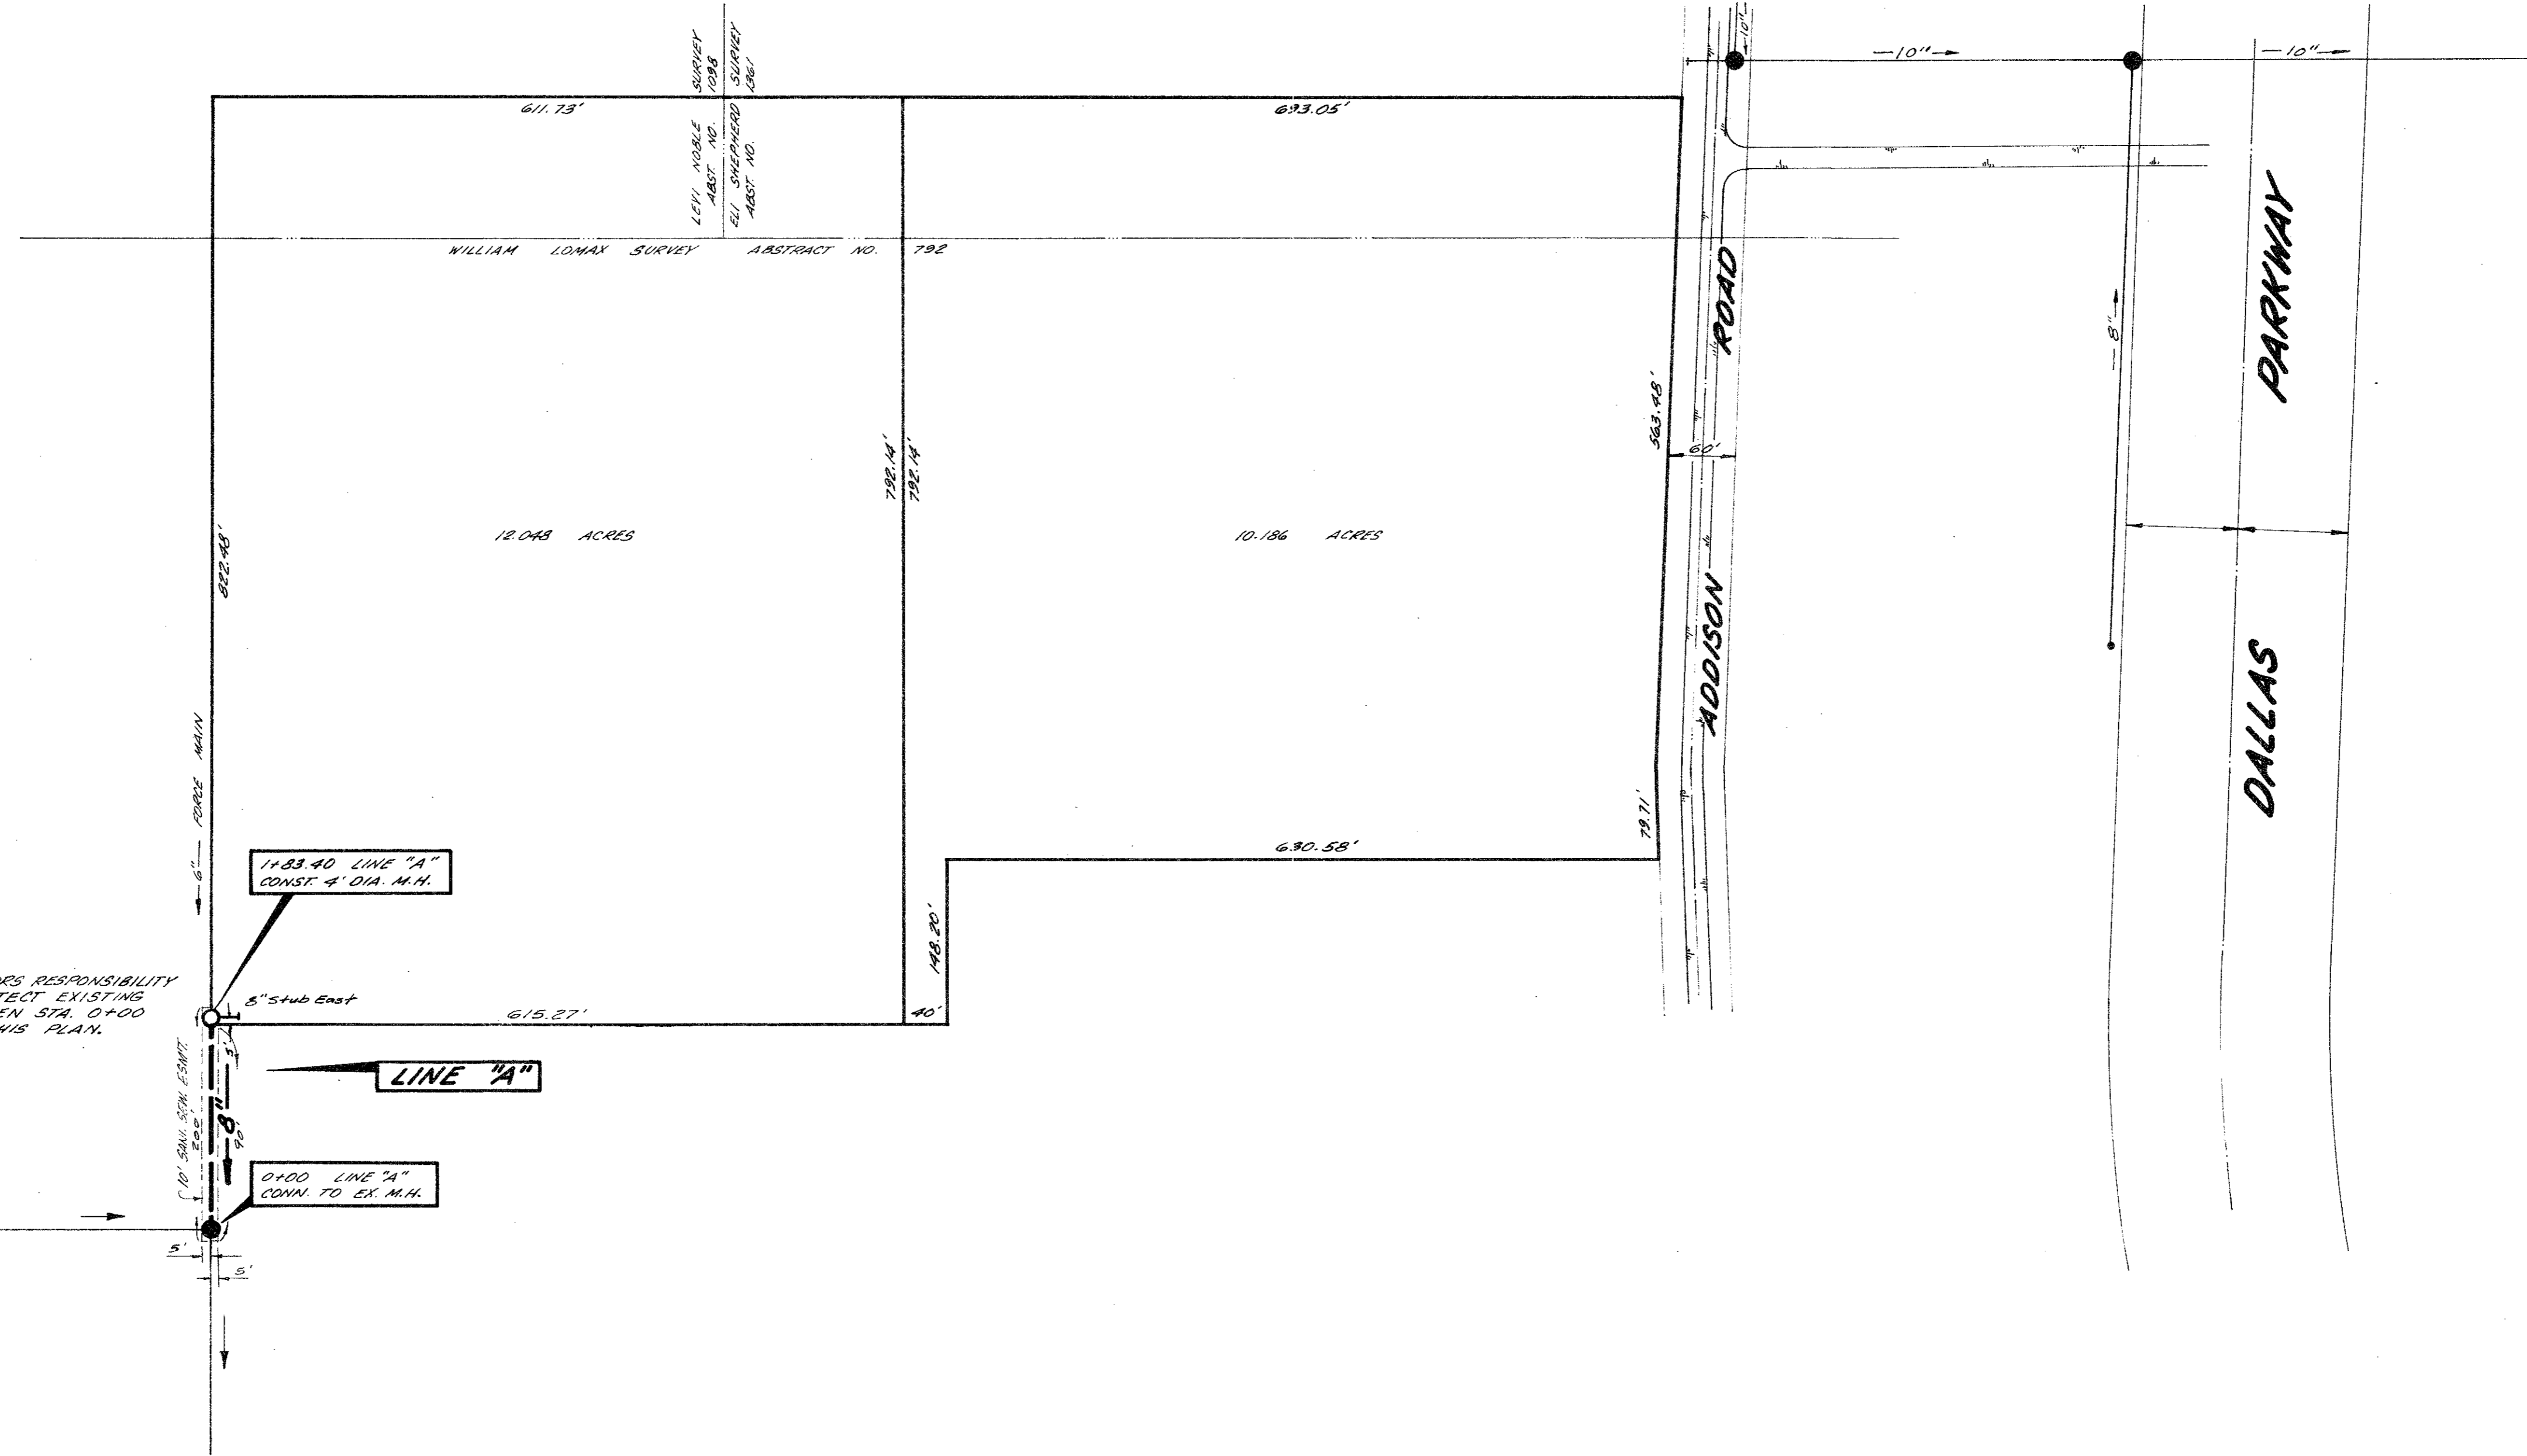

NOTE: IT WILL BE THE CONTRACTOR'S RESPONSIBILITY TO VERIFY THE LOCATION AND TO PROTECT ALL EXISTING UTILITIES.

BEERY MARK: NAD IN RD WEST SIDE OF DOOLEY ROAD AND APPROX 240'-S NORTH OF SOUTHWEST CORNER OF THE TEXAS CHRISTIAN ACADEMY TRACT. ELEV. 660.15'

18\"/>

AS BUILT

WATER & SEWER PLANS

BENT TREE ~~XXXX~~ ^{Granders} APARTMENTS

ADDISON ROAD

ADDISON WATER UTILITIES
CITY OF ADDISON, TEXAS

DESIGN	DRAWN	DATE	SCALE	NOTES	FILE	NO.
T&D	T&D	AUG. '77	1"=8' V	T&D		