

# PAVING, DRAINAGE, AND UTILITY CONSTRUCTION PLANS FOR METHODIST HOSPITAL FOR SURGERY

WEST OF DALLAS NORTH TOLLWAY,  
EAST OF ADDISON ROAD,  
NORTH OF SOJOURN DRIVE  
ADDISON, TEXAS

### PLANS SUBMITTAL/REVIEW LOG

FIRST SUBMITTAL TO TOWN OF ADDISON - NOT FOR CONSTRUCTION.	5/1/09
SECOND SUBMITTAL TO TOWN OF ADDISON - NOT FOR CONSTRUCTION.	6/17/09
THIRD SUBMITTAL TO TOWN OF ADDISON - NOT FOR CONSTRUCTION.	7/29/09
FOURTH SUBMITTAL TO TOWN OF ADDISON - NOT FOR CONSTRUCTION.	8/14/09
SUBMITTAL FOR CONSTRUCTION	8/25/09
CITY OF DALLAS COMMENTS	09/09/09
RESUBMITTAL TO TOWN OF ADDISON - NOT FOR CONSTRUCTION. MODIFICATIONS BASED ON CHANGE TO THE CENTRAL UTILITY PLANT.	10/21/09
RESUBMITTAL TO TOWN OF ADDISON	11/03/09


### INDEX OF SHEETS

SHEET NO.	DESCRIPTION	DATE	REVISION			
			△	△	△	△
C-01	COVER SHEET	8/25/09				
1 of 1	FINAL PLAN					
C-02	GENERAL NOTES	8/25/09		11/03/09		
C-03	DEMOLITION PLAN	8/25/09		11/03/09		
C-04	DIMENSION CONTROL AND PAVING PLAN	8/25/09		11/03/09	12/21/09	3/10/10
C-05	GRADING PLAN	8/25/09		11/03/09	12/21/09	3/10/10
C-06	DRAINAGE AREA MAP	8/25/09		11/03/09		
C-07	STORM SEWER CALCULATIONS	8/25/09		11/03/09		
C-08	DETENTION CALCULATIONS	8/25/09		11/03/09		
C-09	STORM SEWER PLAN	8/25/09		11/03/09	12/21/09	
C-10	STORM SEWER PROFILES	8/25/09		11/03/09		
C-11	STORM SEWER PROFILES	8/25/09		11/03/09		
C-12	DETENTION PROFILES	8/25/09		11/03/09		
C-13	DETENTION PROFILES	8/25/09		11/03/09		
C-14	UTILITY PLAN	8/25/09		11/03/09	12/21/09	
C-14A	UTILITY EXHIBIT	8/25/09		11/03/09		
C-15	WATER LINE PROFILES	8/25/09		11/03/09		
C-16	DALLAS NORTH TOLLWAY FRONTAGE ROAD TURN LANE #1	8/25/09		11/03/09		12/21/09
C-17	DALLAS NORTH TOLLWAY FRONTAGE ROAD TURN LANE #2	8/25/09		11/03/09		12/21/09
C-18	EROSION CONTROL PLAN	8/25/09		11/03/09		
C-19	EROSION CONTROL DETAILS	8/25/09		11/03/09		
C-20	CONSTRUCTION DETAILS	8/25/09		11/03/09		
C-21	CONSTRUCTION DETAILS	8/25/09		11/03/09		
C-22	CONSTRUCTION DETAILS	8/25/09		11/03/09		
C-23	TRAFFIC CONTROL PLAN	8/25/09		11/03/09		
SCP-4	TXDOT SINGLE BOX CULVERT - PRECAST - 4'-0" SPAN					
SCP-MD	TXDOT SINGLE BOX CULVERT - PRECAST - MISC. DETAILS					
MC-6-16	TXDOT MULTIPLE BOX CULVERTS CAST IN PLACE 6'-0" SPAN					
MC-8-13	TXDOT MULTIPLE BOX CULVERTS CAST IN PLACE 8'-0" SPAN					
MC-MD	TXDOT MULTIPLE BOX CULVERTS C.I.P. MISC. DETAILS					

- △ REVISION FROM CENTRAL UTILITY PLANT RELOCATION
- △ REVISION TO DOCTOR PARKING AND DOCK LAYOUT
- △ APPROVED CITY OF DALLAS TURN LANE PLANS
- △ MODIFIED SITE PLAN: SHIFTED 2 LANDSCAPE ISLANDS IN N. PARKING, ADDED PARKING TO DR. AREA, MODIFIED DOCK AREA, ADJUSTED RADIUS PAVING & SIDEWALK COMING CUT SOUTH SIDE OF MOTOR COURT, ADDED MOW STRIP, MODIFIED SIDEWALK AND PATIO AREA, INCREASED SIDEWALK FROM ELECTRICAL ROOM, MODIFIED CURB TO ALLOW FOR E-CALL BOXES

**APPROVED FOR CONSTRUCTION**  
Town of Addison  
Public Works Department  
APPROVED BY: CLAY BARNEY  
DATE: 3-16-2010

All responsibility for the adequacy of these plans remains with the Engineer who prepared them. In approving these plans, the Town of Addison makes no representation of adequacy of the work of the Design Engineer.

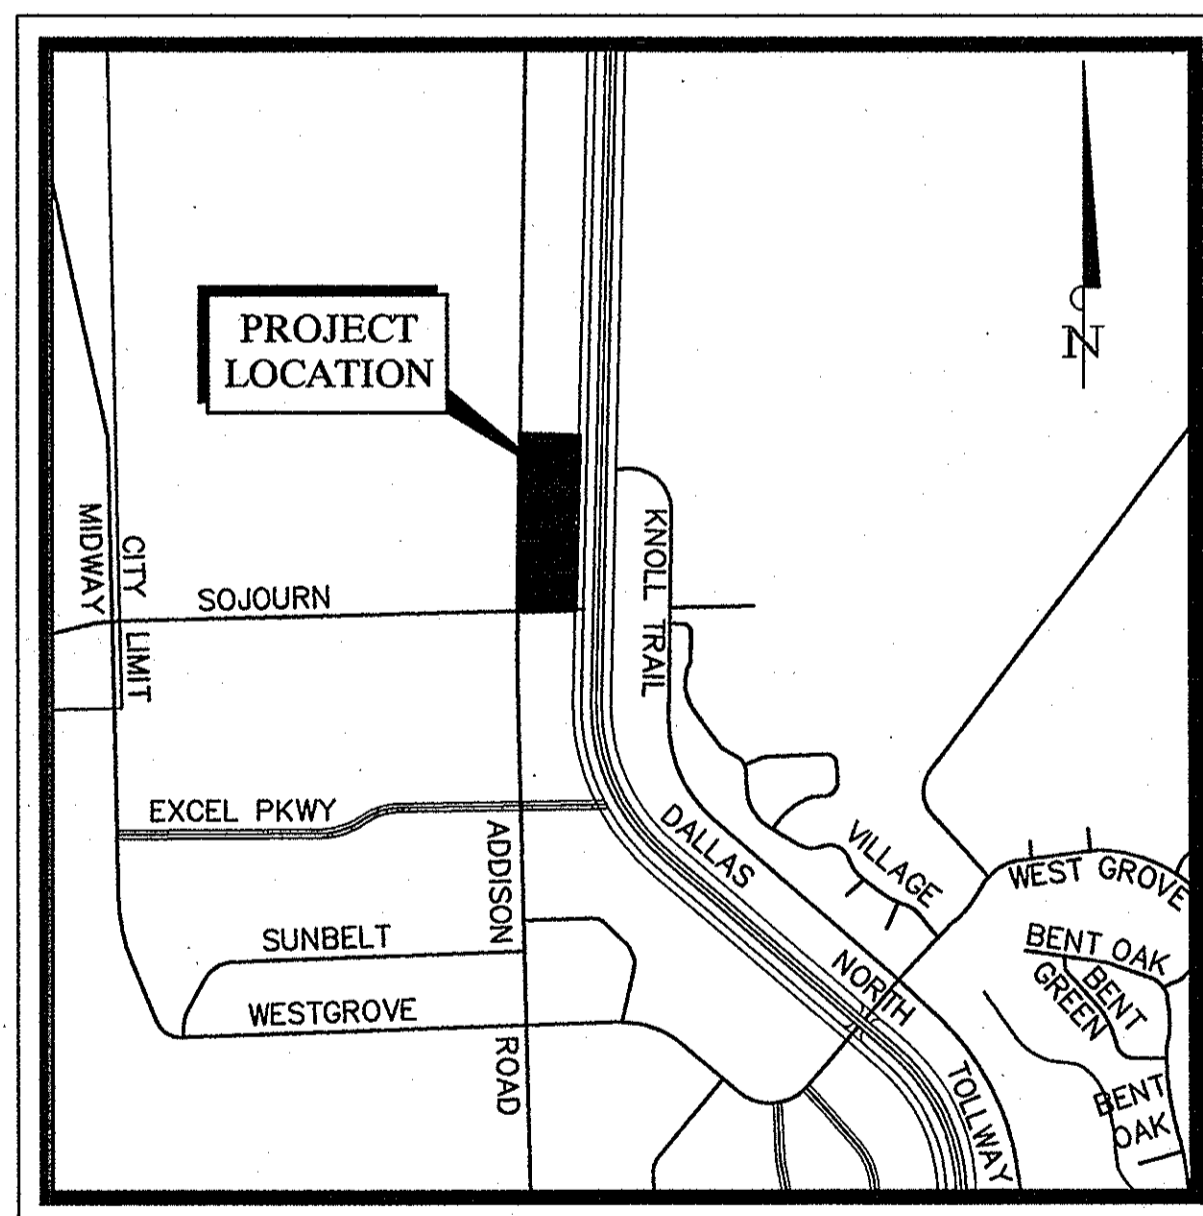


VICINITY MAP  
N.T.S.

RECORD DWG  
UPDATED  
9/30/10

RECORD DWG  
UPDATED  
10/15/10

NOT  
UPDATED  
FOR RECORD  
DRAWINGS

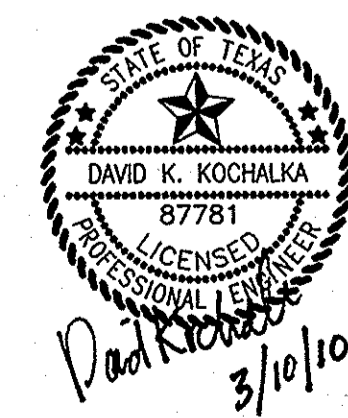

**RECORD DRAWINGS  
(SEPTEMBER 2010)**  
INFORMATION PROVIDED BY:  
Rogers-O'Brien Construction Company


**STOP!  
CALL BEFORE YOU DIG**  
DIG TESS  
1-800-DIG-TESS  
(@ least 72 hours prior to digging)


**AUGUST 25, 2009  
PW#2008-18**

PLOTTED BY: KOCHALKA, DAVID J. 09/09/09 AM  
 FILED: 10/15/10  
 LAST SAVED: 10/15/10

**DEVELOPER**  
ADVANTA MEDICAL DEVELOPMENT, LLC.  
5225 VILLAGE CREEK DRIVE  
PLANO, TX 75093  
TEL: 972-499-6302

**ARCHITECT**  
BOKA POWELL, LLC  
8070 PARK LANE, SUITE 300  
DALLAS, TX 75231  
TEL: 972-701-9000  
FAX: 972-991-3008

**ENGINEER**  
 **Kimley-Horn  
and Associates, Inc.**  
5750 GENESIS COURT  
SUITE 200  
FRISCO, TEXAS 75034  
TEL: (972) 335-3580  
FAX: 972-335-3779  
CONTACT: DAVID KOCHALKA, P.E.  
STATE OF TEXAS REGISTRATION NO. F-928

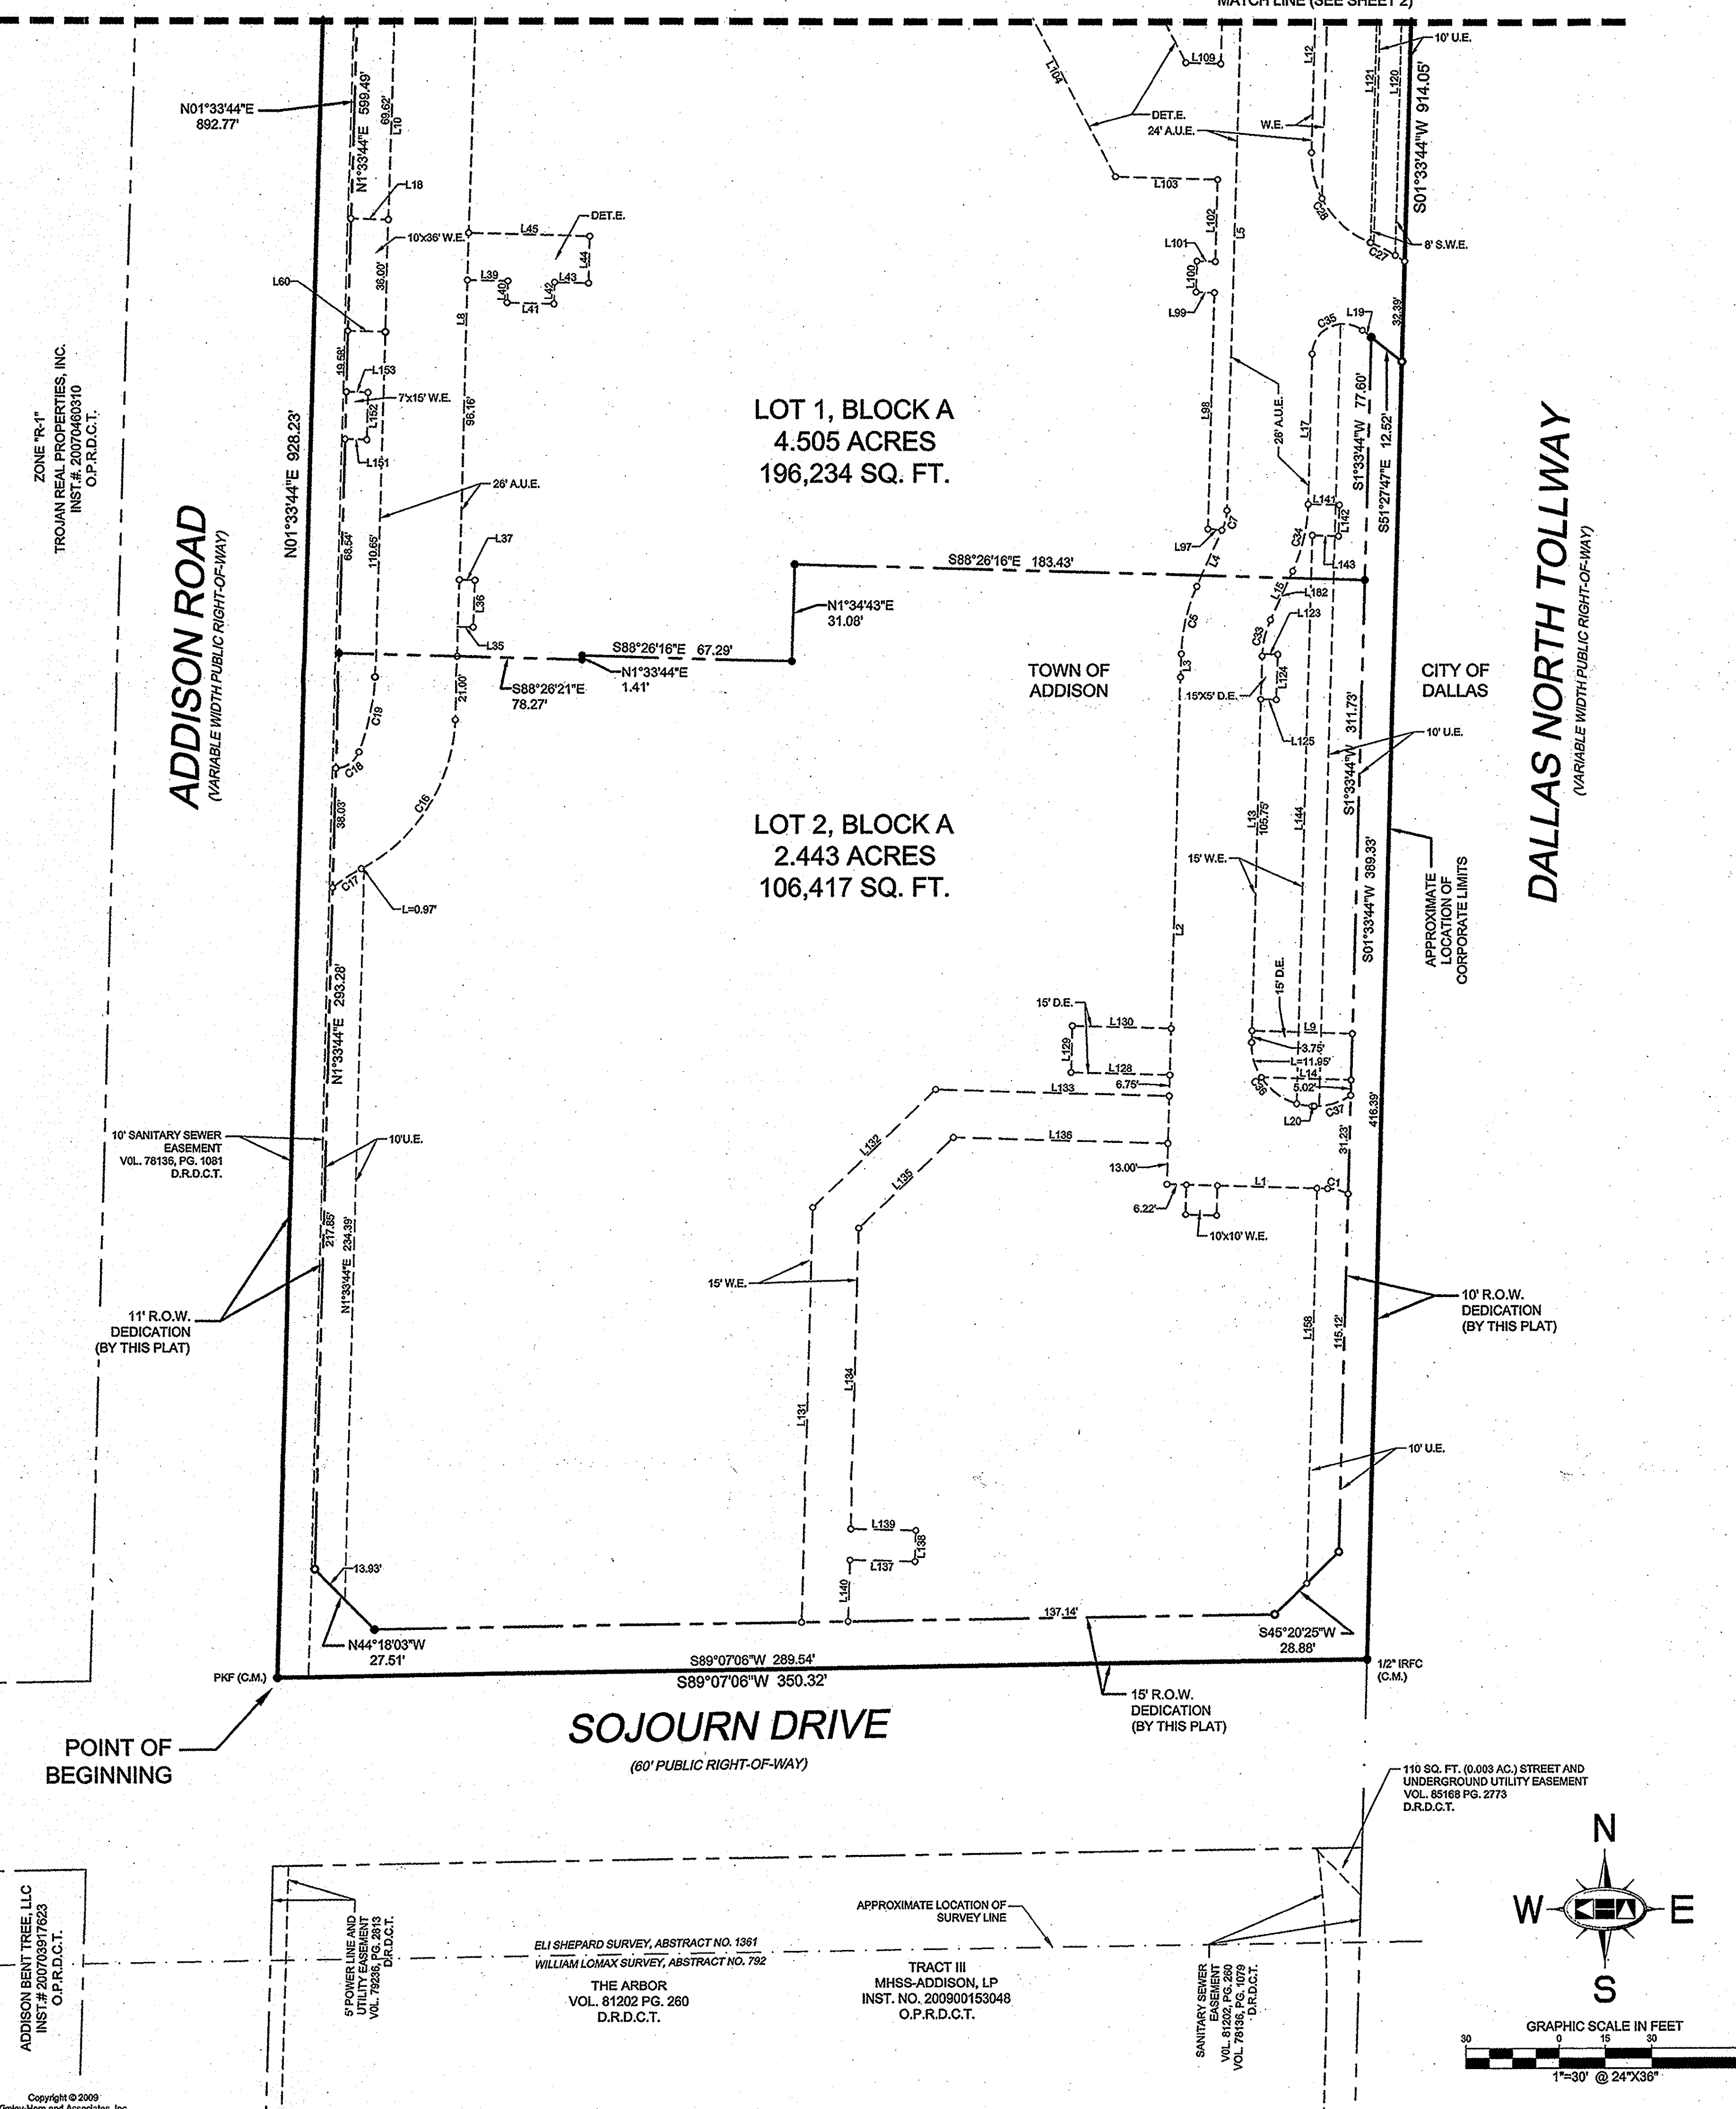

ZONE "R-1"  
TROJAN REAL PROPERTIES, INC.  
INST. # 20070460310  
O.P.R.D.C.T.

ADDITION BENT TREE LLC  
INST. # 20070817623  
O.P.R.D.C.T.

SPONGE LINE AND  
UTILITY EASEMENT  
VOL. 7828, PG. 2813  
D.R.D.C.T.


ELI SHEPARD SURVEY, ABSTRACT NO. 1361  
WILLIAM LOMAX SURVEY, ABSTRACT NO. 782

THE ARBOR  
VOL. 81202 PG. 260  
D.R.D.C.T.

TRACT III  
MHSS-ADDISON, LP  
INST. NO. 200900153048  
O.P.R.D.C.T.

SANITARY SEWER  
EASEMENT  
VOL. 7818, PG. 1077  
D.R.D.C.T.

110 SQ. FT. (0.003 AC) STREET AND  
UNDERGROUND UTILITY EASEMENT  
VOL. 82168 PG. 2773  
D.R.D.C.T.

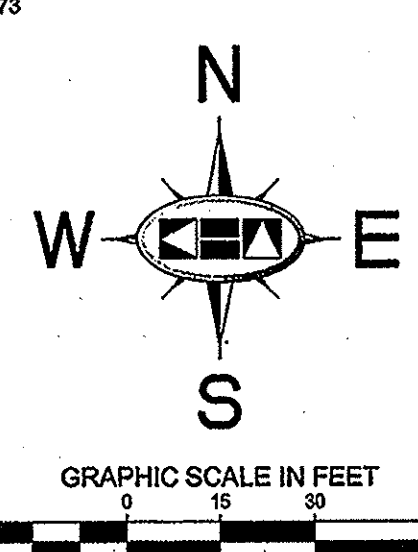

**OWNER'S CERTIFICATE**

STATE OF TEXAS         \$  
COUNTY OF DALLAS    \$

WHEREAS MHSS-ADDISON, LP, is the owner of a tract of land out of the Eli Shepard Survey, Abstract No. 1361, Town of Addison, Dallas County, Texas, being all of a tract of land described as "Tract F" and "Tract I" in Special Warranty Deed to MHSS-ADDISON, LP, recorded in Instrument No. 200900153048, Official Public Records of Dallas County, Texas and being more particularly described as follows:

**BEGINNING** at a PK nail found at the intersection of the north right-of-way line of Sojourn Drive (a 60-foot wide right-of-way) and the east right-of-way line of Addison Road (a variable width right-of-way);

**THENCE** with said east right-of-way line, North 01°33'44" East, a distance of 928.23 feet to a 5/8" iron rod with cap found for corner;

**THENCE** with a jog in said east right-of-way line, South 88°33'43" East, at a distance of 12.00 feet, passing the southwest corner of Two Rows Restaurant, an addition to the Town of Addison, Texas according to the plat recorded in Volume 2004081, Page 208, Deed Records of Dallas County, Texas, continuing with the south line of said Addition, at a distance of 338.00 feet, passing the southeast corner of said Addition and a point in the west right-of-way line of the Dallas North Tollway (a variable width right-of-way), continuing with a jog in said west right-of-way line, in all a total distance of 350.00 feet to a "X" cut in concrete found for corner;

**THENCE** with said west right-of-way line, South 01°33'44" West, a distance of 914.05 feet to a 1/2" iron rod with cap found for corner at the intersection of said west right-of-way line and the said north right-of-way line of Sojourn Drive;

**THENCE** with said north right-of-way line of Sojourn Drive, South 89°07'06" West, a distance of 350.32 feet the **POINT OF BEGINNING** and containing 7.4013 acres or 322,400 square feet of land.

**SURVEYORS CERTIFICATION**

**KNOW ALL MEN BY THESE PRESENTS:**

I, DANA BROWN, a Registered Professional Land Surveyor in the State of Texas, do hereby declare that I have prepared this plat from an actual on the ground survey of the land, and that the corner monuments shown thereon were properly placed under my personal supervision in accordance with Subdivision Regulations of the Town of Addison, Texas.


Dana Brown  
Registered Professional Land Surveyor #5836  
Kimley-Horn and Associates, Inc.  
12700 Park Central Drive, Suite 1800  
Dallas, Texas 75251  
972-770-1300

STATE OF TEXAS         \$  
COUNTY OF COLLIN    \$

**BEFORE ME**, the undersigned authority, a Notary Public, on this day personally appeared Dana Brown, known to me to be the person whose name is subscribed to the foregoing instruments, and acknowledged to me that he executed the same for the purpose and considerations therein expressed and in the capacity therein stated.

GIVEN UNDER MY HAND AND SEAL OF OFFICE this 4th day of August, 2010.

*Alison Wylie*  
NOTARY PUBLIC in and for the STATE OF TEXAS

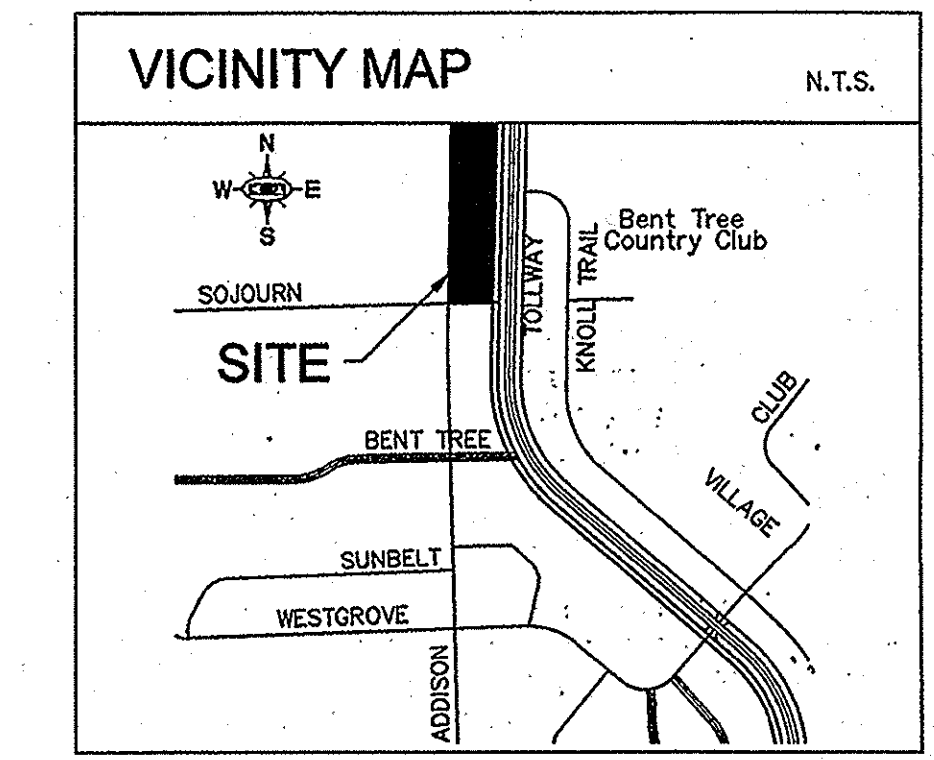

**AREA TABLE**

LOT	ACRES	SQUARE FEET
ROW	0.4534	19,748
LOT 1	6.9479	302,692
TOTAL	7.4013	322,400

**LEGEND**

IRF	IRON ROD FOUND
IRFC	CAPPED IRON ROD FOUND
IRS	5/8" IRON ROD WITH "KH" CAP SET
(C.M.)	CONTROL MONUMENT
X	"X" IN CONCRETE FOUND
PKF	PK NAIL FOUND
A.U.E.	ACCESS & UTILITY EASEMENT (BY THIS PLAT)
W.E.	WATER EASEMENT (BY THIS PLAT)
D.E.	DRAINAGE EASEMENT (BY THIS PLAT)
DET.E.	DETENTION EASEMENT (BY THIS PLAT)
S.E.	STREET EASEMENT (BY THIS PLAT)
N.I.E.	NON-EXCLUSIVE INGRESS/EGRESS EASEMENT (BY THIS PLAT)
S.W.E.	SIDE WALK EASEMENT (BY THIS PLAT)
U.E.	UTILITY EASEMENT (BY THIS PLAT)
O.P.R.D.C.T.	OFFICIAL PUBLIC RECORDS, DALLAS CO. TX.
D.R.D.C.T.	DEED RECORDS, DALLAS CO. TX.

**NOTES**

- The bearing system for this plat is based on grid north of the Texas Coordinate System of 1983 resulting in a bearing of North 01°33'44" East, for the east right-of-way line of Addison Road.
- All easements are by this plat unless otherwise noted.
- This plat is subject to restrictions contained in deeds recorded in Volume 79119, Page 2604, Volume 78243, Page 191, and Volume 81101, Page 2295, all of the Deed Records of Dallas County, Texas.

**NOW, THEREFORE, KNOW ALL MEN BY THESE PRESENTS:**

That MHSS-ADDISON, LP ("Owner") does hereby adopt this plat designating the hereinabove property as **MHS ADDITION**, an addition to the Town of Addison, Texas, and subject to the conditions, restrictions and reservations stated hereinafter, owner dedicates to the public use forever the streets and alleys shown thereon.

This plat is approved by the Town of Addison and accepted by the owner(s), subject to the following conditions which shall be binding upon the owner(s), his heirs, grantees and successors, and assigns:

The easement shown on this plat are hereby reserved for the purposes as indicated, including, but not limited to, the installation and maintenance of water, sanitary sewer, storm sewer, drainage, election, telephone, gas and cable television. Owner shall have the right to use these easements, provided, however, that it does not unreasonably interfere or impede with the provision of the services to others. Said utility easements are hereby being reserved by mutual use and accommodation of all public utilities using or desiring to use the same. An express easement of ingress and egress is hereby expressly granted on, over and across all such easements for the benefit of the provider of services for which easements are granted.

The proposed detention area easement(s) within the limits of this addition, will remain as detention area(s) to the line and grade shown on the plans at all times and will be maintained by the individual owner(s) of the lot or lots that are traversed by or adjacent to the detention area(s). The Town of Addison will not be responsible for the maintenance and operation of said detention area(s) or any damage or injury to private property or person that results from the flow of water along, into or out of said detention area(s), or for the control of erosion.

No obstruction to the natural flow of storm water run-off shall be permitted by filling or construction of any type of dam, building, bridge, fence, walkway or any other structure within the designated detention area(s) unless approved by the Director of Public Works, provided; however, it is understood that in the event it becomes necessary for the Town of Addison to erect any type of drainage structure in order to improve the storm drainage that may be occasioned by the streets and alleys in or adjacent to the subdivisions, then, in such event, the Town of Addison shall have the right to enter upon the detention area(s) at any point, or points, to erect, construct and maintain any drainage facility deemed necessary for drainage purposes. Each property owner shall keep the detention area(s) traversing or adjacent to his property clean and free of debris, silt and any substance which would result in unsanitary conditions or blockage of the drainage. The Town of Addison shall have the right of ingress and egress for the purpose of inspection and supervision of maintenance work by the property owner(s), or to alleviate any undesirable conditions, which may occur.

The detention area(s) as in the case of all detention areas are subject to storm water overflow(s) to an extent which cannot be clearly defined. The Town of Addison shall not be held liable for any damages of any nature resulting from the occurrences of these natural phenomena, nor resulting from the failure of any structure or structures, within the detention area(s) or subdivision storm drainage system.

The detention area easement line identified on this plat shows the detention area(s) serving this addition.

Water main and sanitary sewer easements shall also include additional area of working space for construction and maintenance of the systems. Additional easement area is also conveyed for installation and maintenance of manholes, cleanouts, fire hydrants, water service and sewer services from the main to curb or pavement line, and the descriptions of such additional easements herein granted shall be determined by their locations as installed.

This plat is approved subject to all platting ordinances, rules, regulations and resolutions of the Town of Addison, Texas.

WITNESS, my hand, this 5th day of August, 2010.

By: **MHSS-ADDISON, LP**, a Texas limited partnership  
By: SRP/Medica-Addison GP, L.L.C. a Texas limited liability company, its General Partner  
By: *Marc M. Goldman*  
Name: Marc Goldman  
Title: EVP

STATE OF TEXAS         \$  
COUNTY OF DALLAS    \$

**BEFORE ME**, the undersigned authority, a Notary Public in and for said county and state, on this day personally appeared Marc Goldman, known to me to be the person whose name is subscribed to the foregoing instrument and acknowledged to me that he executed the same for the purpose and consideration thereof expressed.

GIVEN UNDER MY HAND AND SEAL OF OFFICE THIS 5 DAY OF AUGUST, 2010.

*Alison Wylie*  
NOTARY PUBLIC in and for the STATE OF TEXAS

APPROVED BY THE CITY COUNCIL OF THE TOWN OF ADDISON, TEXAS ON  
August 10, 2010.

*Lee J. Brown*  
Mayer  
City Secretary

**RECORD DRAWINGS (SEPTEMBER 2010)**

INFORMATION PROVIDED BY:  
Rogers-O'Brien Construction Company

201000204888

**FINAL PLAT**  
**MHS ADDITION**  
LOT 1 & LOT 2, BLOCK A  
ELI SHEPARD SURVEY, ABSTRACT NO. 1361  
TOWN OF ADDISON  
DALLAS COUNTY, TEXAS


**Kimley-Horn and Associates, Inc.**  
12700 Park Central Drive, Suite 1800  
Dallas, Texas 75251  
Tel. No. (972) 770-1300  
Fax No. (972) 239-3820

Scale	Drawn by	Checked by	Date	Project No.	Sheet No.
1" = 30'	SRD	DAB	APRIL 2009	069302500	1 OF 2

OWNER  
MHSS-ADDISON, LP  
8343 DOUGLAS AVENUE, SUITE 350  
DALLAS, TX, 75251  
TEL: (972) 499-6302





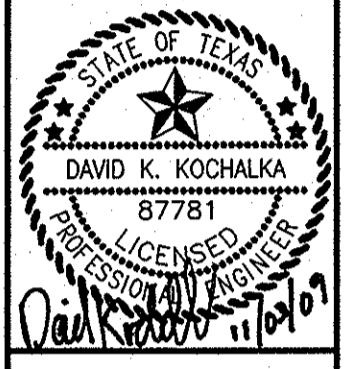


**METHODIST HOSPITAL FOR SURGERY**  
 ADDISON, TEXAS  
 FILE NUMBER: 311T-7863

**DEMOLITION PLAN**

Scale:	AS SHOWN
Designed by:	RCO
Drawn by:	RCO
Checked by:	DNK
Date:	11/9/09
Project No.:	6902500

SHEET  
**C-03**

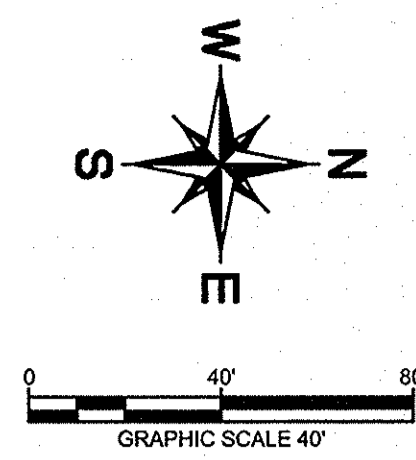

**DEMOLITION NOTES:**

1. THE CONTRACTOR SHALL FIELD VERIFY AND LOCATE ALL EXISTING UTILITIES ON SITE PRIOR TO DEMOLITION.
2. THE CONTRACTOR SHALL PERFORM DEMOLITION ACTIVITIES AS NOTED AND SHOWN ON THESE PLANS AND AS DIRECTED BY THE OWNER.
3. IT WILL BE THE RESPONSIBILITY OF THE CONTRACTOR TO OBTAIN ANY PERMITS AND PAY ANY FEES REQUIRED FOR DEMOLITION AND HAUL-OFF FROM THE APPROPRIATE AUTHORITIES.
4. THE CONTRACTOR SHALL PREPARE ALL DOCUMENTS AND ACQUIRE APPROPRIATE PERMITS AS REQUIRED PRIOR TO THE COMMENCEMENT OF DEMOLITION.
5. THE DEMOLITION PLAN IS INTENDED TO DEPICT GENERAL DEMOLITION AND UTILITY WORK. IT IS NOT INTENDED TO IDENTIFY EACH ELEMENT OF DEMOLITION OR RELOCATION. THE CONTRACTOR SHALL COORDINATE WITH THE OWNER AND APPROPRIATE UTILITY COMPANY PRIOR TO WORK.
6. CONTRACTOR TO COMPLETELY DEMOLISH AND DISPOSE OFF-SITE IN A LAWFUL MANNER EXISTING BUILDINGS, INCLUDING FOUNDATIONS AND ALL APPURTENANCES LOCATED ON AND AROUND THE PROPERTY INCLUDING BUT NOT LIMITED TO BOLLARDS, GAS METERS, AIR CONDITIONING UNITS, SIGNS, CURBS, SIDEWALKS, ELECTRIC METERS, FENCING, ETC.
7. REMOVE AND DISPOSE OF ANY SIDEWALK, FENCES, STAIRS, WALLS, FOUNDATIONS, CONDUITS, LIGHT POLE BASES, DEBRIS AND RUBBISH REQUIRING REMOVAL FROM THE WORK AREA IN AN APPROVED LANDFILL.
8. REMOVE AND/OR PLUG EXISTING UTILITIES SUCH AS SANITARY SEWER, WATER, GAS, ELECTRIC, AND TELEPHONE AS SHOWN OR AS NEEDED. THE CONTRACTOR IS RESPONSIBLE FOR CONTACTING EACH UTILITY COMPANY TO COORDINATE REMOVAL OF ALL UTILITIES AND FOR DETERMINING HORIZONTAL AND VERTICAL LOCATIONS OF UTILITIES PRIOR TO COMMENCING WORK.
9. THE CONTRACTOR SHALL CUT AND PLUG, OR ARRANGE FOR THE APPROPRIATE UTILITY COMPANY TO CUT AND PLUG ALL SERVICE PIPING AT THE STREET LINE OR MAIN, AS REQUIRED, OR AS OTHERWISE NOTED. ALL SERVICES MAY NOT BE SHOWN ON THIS PLAN. THE CONTRACTOR SHALL INVESTIGATE THE SITE PRIOR TO BIDDING TO DETERMINE THE EXTENT OF SERVICE PIPING TO BE REMOVED, CUT OR PLUGGED.
10. THE CONTRACTOR SHALL ARRANGE FOR THE RESETTING OF CURB BOXES, VALVE BOXES AND REMOVAL AND/OR RELOCATION OF OVERHEAD UTILITIES AND POLES WITH THE APPROPRIATE UTILITY COMPANY.
11. INSTALL ALL EROSION AND SEDIMENT CONTROL DEVICES AND TREE PROTECTION PRIOR TO BEGINNING DEMOLITION WORK.
12. THE CONTRACTOR IS RESPONSIBLE FOR THE PROTECTION OF ALL UTILITIES TO REMAIN IN PLACE.
13. THE CONTRACTOR SHALL TAKE ALL PRECAUTIONS TO AVOID UNNECESSARY DAMAGE TO EXISTING ROAD SURFACE.
14. FINISH SURFACE TO BE REMOVED OR DEMOLISHED SHALL BE CUT ALONG LINES OF JOINTS WHICH WILL PERMIT A NEAT SURFACE WHEN RESTORED.
15. ALL EXISTING ITEMS TO REMAIN WHICH ARE DAMAGED DURING CONSTRUCTION SHALL BE RESTORED TO ITS ORIGINAL CONDITION AT THE SOLE EXPENSE OF THE CONTRACTOR.
16. DO NOT INTERRUPT EXISTING UTILITIES SERVING FACILITIES OCCUPIED AND USED BY THE OWNER OR OTHERS DURING OCCUPIED HOURS EXCEPT WHEN SUCH INTERRUPTIONS HAVE BEEN AUTHORIZED IN WRITING BY THE OWNER AND THE LOCAL MUNICIPALITIES. INTERRUPTIONS SHALL ONLY OCCUR AFTER ACCEPTABLE TEMPORARY SERVICE HAS BEEN PROVIDED.
17. SHOULD ANY UNCHARTED OR INCORRECTLY CHARTED EXISTING PIPING OR OTHER UTILITY BE UNCOVERED DURING EXCAVATION, CONTACT THE ENGINEER IMMEDIATELY FOR DIRECTIONS BEFORE PROCEEDING FURTHER WITH WORK IN THE AREA.
18. ASBESTOS OR HAZARDOUS MATERIAL, IF FOUND ON SITE, SHALL BE REMOVED BY A LICENSED HAZARDOUS MATERIAL CONTRACTOR.

**NOTE**

KIMLEY-HORN AND ASSOCIATES, INC. IS NOT RESPONSIBLE FOR THE MEANS AND METHODS EMPLOYED BY THE CONTRACTOR TO IMPLEMENT THIS DEMOLITION PLAN. THIS DEMOLITION PLAN SIMPLY INDICATES THE KNOWN OBJECTS ON THE SUBJECT TRACTS THAT ARE TO BE DEMOLISHED AND REMOVED FROM THE SITE. KIMLEY-HORN AND ASSOCIATES, INC. DOES NOT WARRANT OR REPRESENT THAT THE PLAN, WHICH WAS PREPARED BASED ON SURVEY AND UTILITY INFORMATION PROVIDED BY OTHERS, SHOWS ALL IMPROVEMENTS AND UTILITIES, AND THAT THE IMPROVEMENTS AND UTILITIES ARE SHOWN ACCURATELY. THE CONTRACTOR IS RESPONSIBLE FOR PERFORMING HIS OWN SITE RECONNAISSANCE TO SCOPE HIS WORK AND TO CONFIRM WITH THE OWNERS OF EXISTING IMPROVEMENTS AND UTILITIES THE ABILITY AND PROCESS FOR THE REMOVAL OF PROPOSED DEMOLITION. THE GOAL OF THE DEMOLITION IS TO LEAVE THE SITE IN A STATE SUITABLE FOR THE CONSTRUCTION OF THE PROPOSED IMPROVEMENTS. REMOVAL, RELOCATION, OR PRESERVATION OF EXISTING IMPROVEMENTS, UTILITIES, ETC. TO ACCOMPLISH THIS GOAL ARE THE RESPONSIBILITY OF THE CONTRACTOR.


CONTRACTOR SHALL COMPLY WITH ALL LOCAL, STATE, AND FEDERAL REGULATIONS REGARDING THE DEMOLITION OF OBJECTS ON THE SITE AND THE DISPOSAL OF THE DEMOLISHED MATERIALS OFF-SITE. IT IS THE CONTRACTOR'S SOLE RESPONSIBILITY TO REVIEW THE SITE, DETERMINE THE APPLICABLE REGULATIONS, RECEIVE THE REQUIRED PERMITS AND AUTHORIZATIONS, AND COMPLY.

**RECORD DRAWINGS (SEPTEMBER 2010)**  
 INFORMATION PROVIDED BY:  
 Rogers-O'Brien Construction Company

**FRANCHISE UTILITY CONTACTS**

ONCOR (ELECTRIC) CONTACT: KAREN EASTMAN	817-335-7050
ATMOS ENERGY (GAS) CONTACT: GEORGE LONG	972-881-4152
AT&T COMMUNICATION (PHONE) CONTACT: STEVEN J. ELLIOT	972-234-7039


**!!WARNING!!**  
 EXISTING UTILITIES IN THE AREA. CONTRACTOR SHALL FIELD VERIFY THE LOCATION OF ALL EXISTING UTILITIES WITH THE PROVIDER PRIOR TO START OF CONSTRUCTION AND SHALL IMMEDIATELY NOTIFY THE ENGINEER OF ANY CONFLICTS DISCOVERED. CONTRACTOR IS RESPONSIBLE FOR COORDINATING UTILITY RELOCATION WHERE NECESSARY AND PROTECTING EXISTING UTILITIES (SHOWN OR NOT SHOWN). IF ANY EXISTING UTILITIES ARE DAMAGED, THE CONTRACTOR SHALL REPLACE THEM AT THEIR OWN EXPENSE.

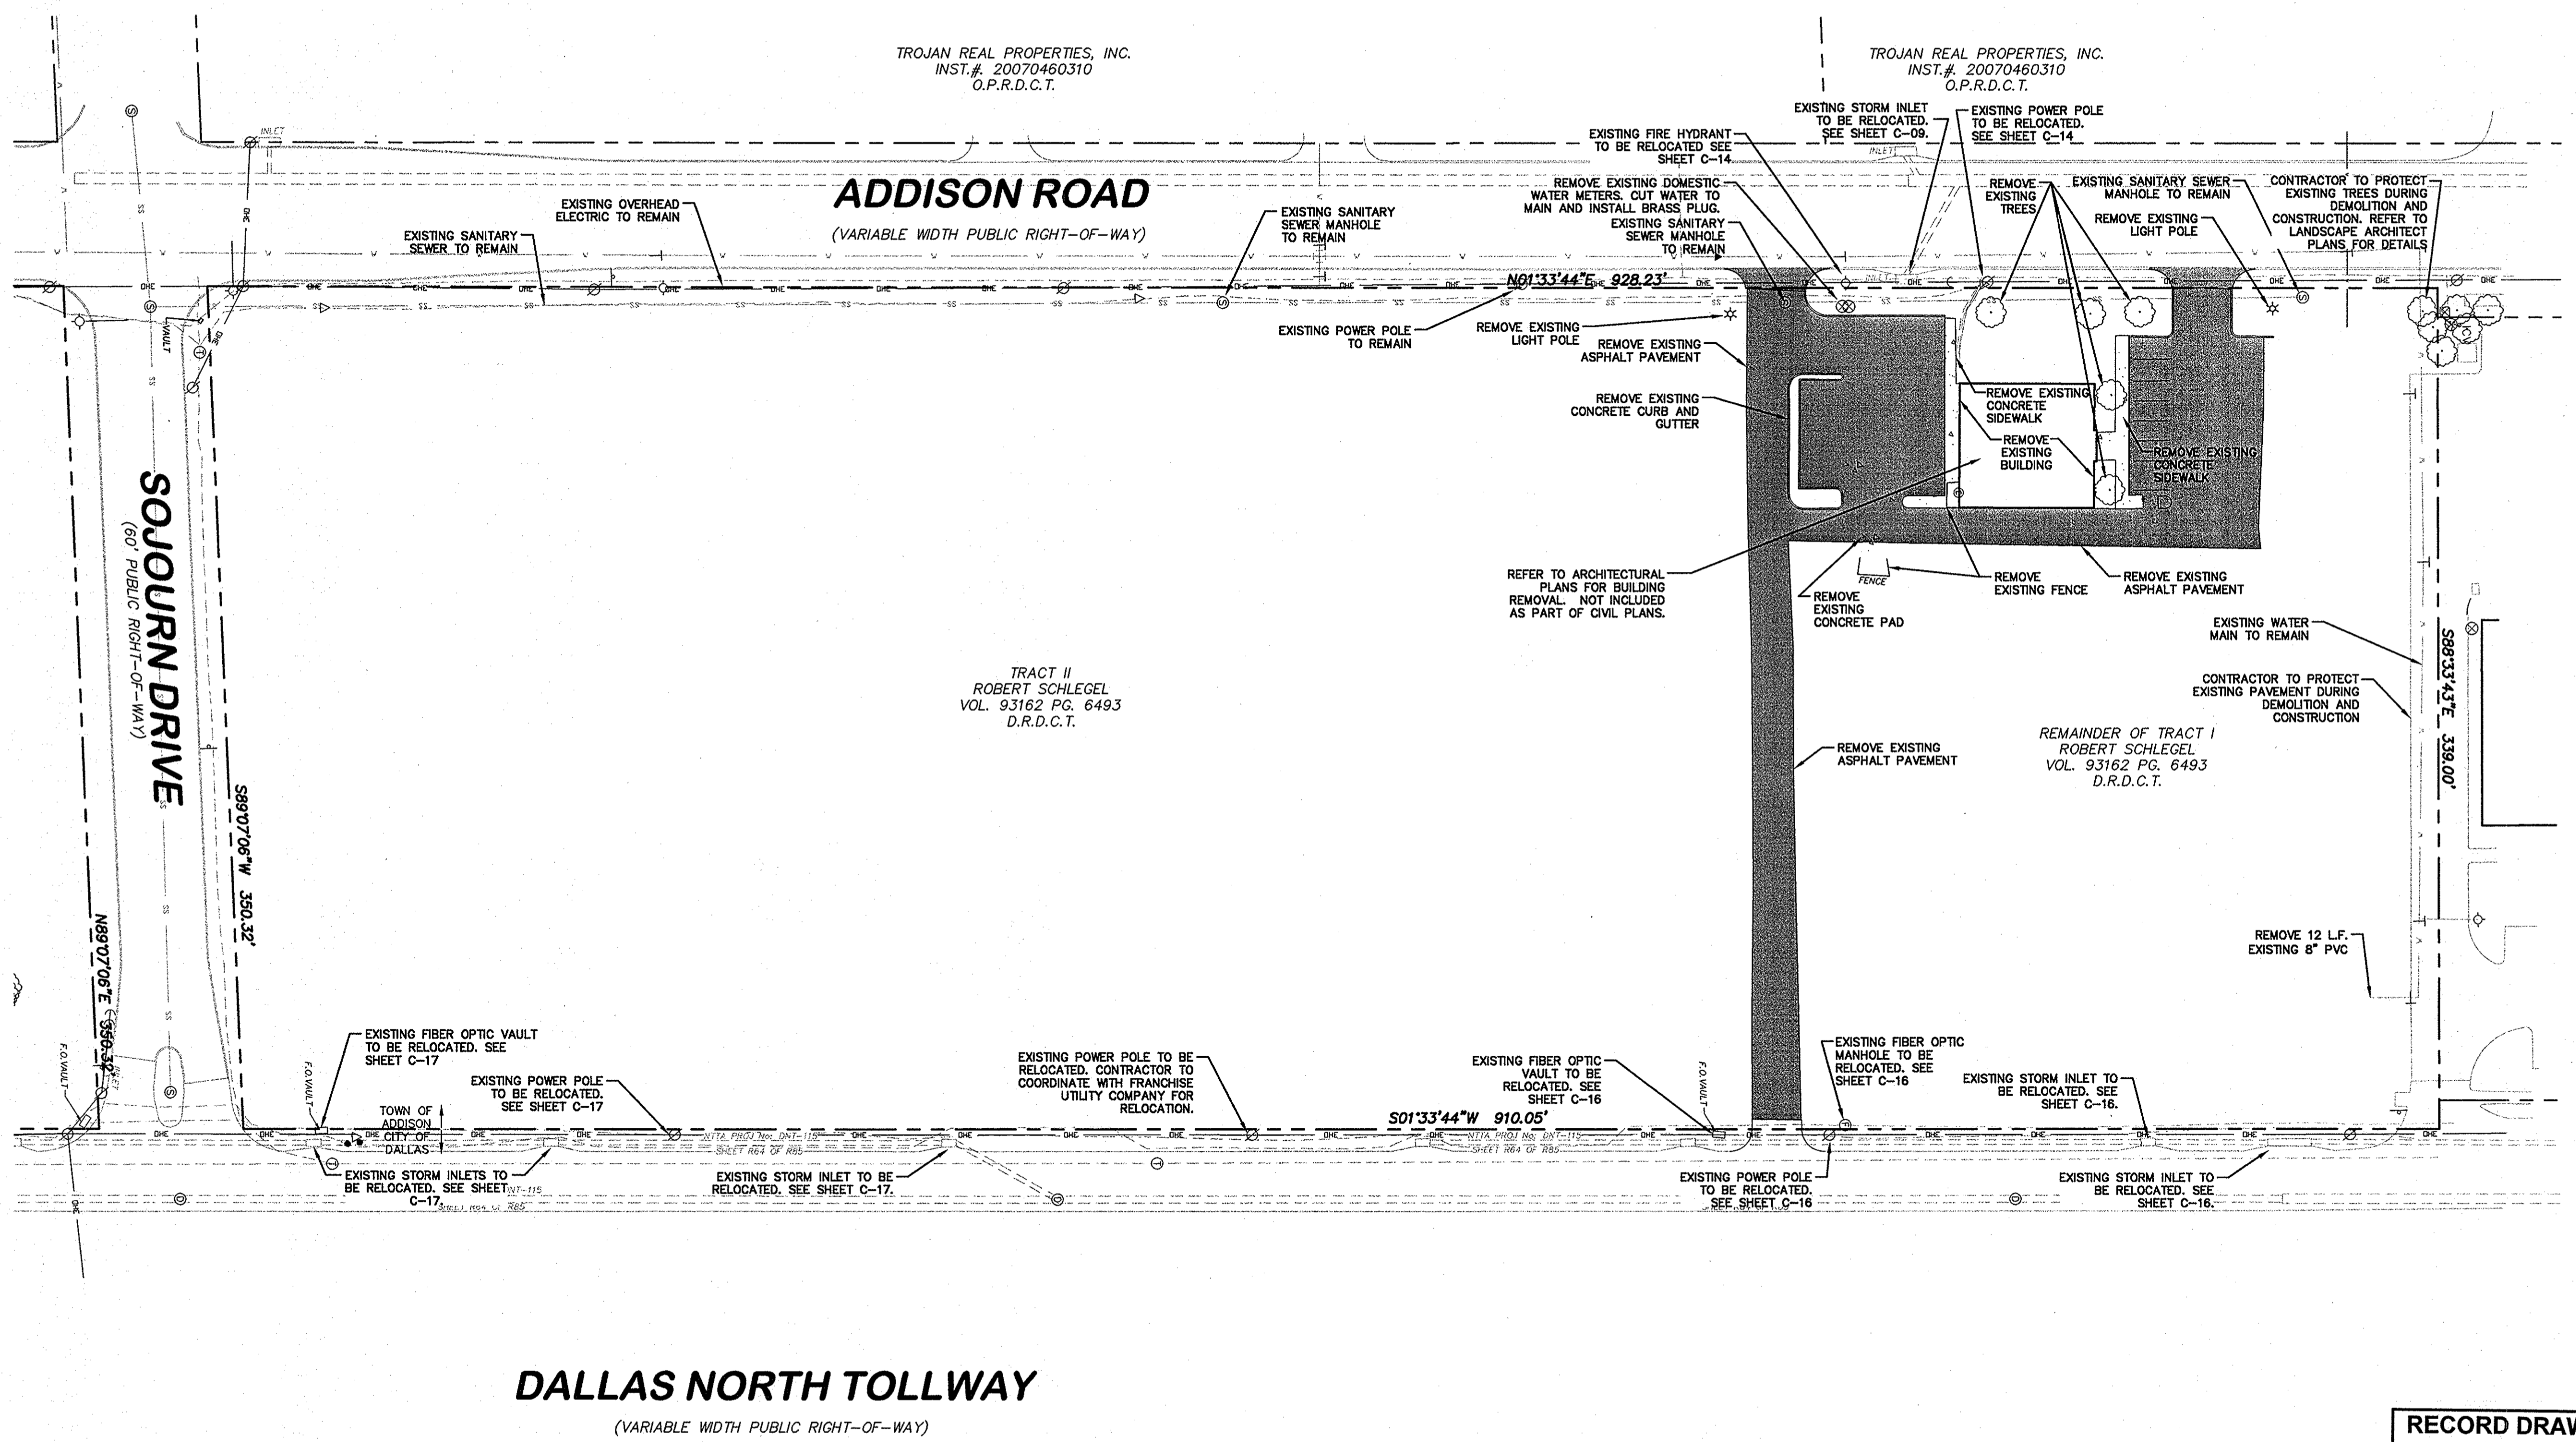

IMAGES: KIMLEY-HORN AND ASSOCIATES, INC. (KHA) AND OTHERS. KHA IS NOT RESPONSIBLE FOR THE MEANS AND METHODS EMPLOYED BY THE CONTRACTOR TO IMPLEMENT THIS DEMOLITION PLAN. THIS DEMOLITION PLAN SIMPLY INDICATES THE KNOWN OBJECTS ON THE SUBJECT TRACTS THAT ARE TO BE DEMOLISHED AND REMOVED FROM THE SITE. KIMLEY-HORN AND ASSOCIATES, INC. DOES NOT WARRANT OR REPRESENT THAT THE PLAN, WHICH WAS PREPARED BASED ON SURVEY AND UTILITY INFORMATION PROVIDED BY OTHERS, SHOWS ALL IMPROVEMENTS AND UTILITIES, AND THAT THE IMPROVEMENTS AND UTILITIES ARE SHOWN ACCURATELY. THE CONTRACTOR IS RESPONSIBLE FOR PERFORMING HIS OWN SITE RECONNAISSANCE TO SCOPE HIS WORK AND TO CONFIRM WITH THE OWNERS OF EXISTING IMPROVEMENTS AND UTILITIES THE ABILITY AND PROCESS FOR THE REMOVAL OF PROPOSED DEMOLITION. THE GOAL OF THE DEMOLITION IS TO LEAVE THE SITE IN A STATE SUITABLE FOR THE CONSTRUCTION OF THE PROPOSED IMPROVEMENTS. REMOVAL, RELOCATION, OR PRESERVATION OF EXISTING IMPROVEMENTS, UTILITIES, ETC. TO ACCOMPLISH THIS GOAL ARE THE RESPONSIBILITY OF THE CONTRACTOR.

SITE DATA SUMMARY TABLE

Table with 2 columns: ZONING, PROPOSED USE, TOTAL LOT AREA, TOTAL BUILDING AREA, BUILDING HEIGHT, TOTAL OFF-STREET PARKING PROVIDED, TOTAL HANDICAP PARKING REQUIRED, TOTAL HANDICAP PARKING PROVIDED. Values include PD/SUP, HOSPITAL/32 BEDS, 303,741 SF / 6.97 AC, 107,003 SF / 2.46 AC, 3 STORIES, 173, 6, 11.

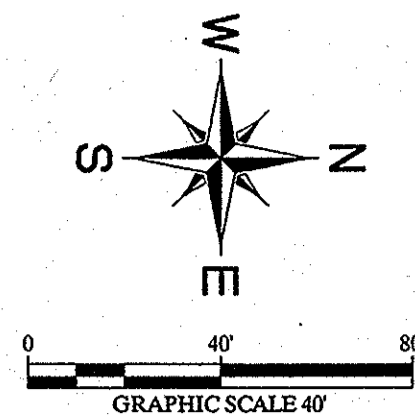

KEY NOTE LEGEND

- 1 ACCESSIBLE PARKING SPACE (TYP.)
2 CONCRETE WHEEL STOP (TYP.) SEE SHEET C-22 FOR DETAIL.
3 6" CURB AND GUTTER. SEE SHEET C-22 FOR DETAIL.
4 REFERENCE LANDSCAPE PLANS FOR DETAILED TRAFFIC STRIPING INFORMATION.
5 REFERENCE LANDSCAPE PLANS FOR DETAILED TRAFFIC STRIPING INFORMATION.
6 BARRIER FREE RAMP. REFERENCE LANDSCAPE FOR DETAIL.
7 HC SIGNS. SEE SHEET C-22 FOR DETAIL.
8 CONNECT TO EXISTING 6" CONCRETE CURB AND GUTTER.
9 FIRE LANE STRIPING. SEE SHEET C-22 FOR DETAIL.
10 STOP BAR. SEE SHEET C-22 FOR DETAIL ON CONC. PAVE. FOR STOP BAR ON PAVERS, REF. LANDSCAPE PLANS.
11 STOP SIGN. SEE SHEET C-22 FOR DETAIL.
12 END 6" CURB AND GUTTER. TRANSITION CURB FROM 6" DOWN TO 0" OVER 6'.
13 BARRIER FREE RAMP WITH 1' FLARES. SEE SHEET C-22 FOR DETAIL.
14 CONCRETE CURB CUT FLUME. SEE SHEET C-22 FOR DETAIL.
15 SCREEN WALL. REFER TO ARCHITECTS PLANS FOR DETAILS AND EXACT LOCATION.
16 PROPOSED CURB INLET.
17 DO NOT ENTER SIGN. SEE SHEET C-22 FOR DETAIL.
18 PROPOSED ENTRY GATES-REFERENCE ARCHITECTURAL PLANS FOR DETAIL.
19 PROPOSED STORM MANHOLE. SEE SHEET C-09 FOR DETAIL.
20 PROPOSED GRATE INLET.
21 PROPOSED PAVER DRAINS. REF. LANDSCAPE PLANS.

LEGEND

- PROPERTY LINE
BUILDING SETBACK LINE
LANDSCAPE SETBACK LINE
FL
PROPOSED FIRE LANE
PROPOSED LIGHT DUTY VEHICULAR PAVERS. SEE DETAIL THIS SHEET AND REFER TO LANDSCAPE ARCHITECT PLANS FOR ADDITIONAL DETAILS AND SPECIFICATIONS.
PROPOSED MEDIUM DUTY VEHICULAR PAVERS. SEE DETAIL THIS SHEET AND REFER TO LANDSCAPE ARCHITECT PLANS FOR ADDITIONAL DETAILS AND SPECIFICATIONS.
MEDIAL DUTY 6" REINFORCED 3500 PSI CONCRETE PAVEMENT WITH #3 BARS @ 18" O.C.E.W. ON 6" SCARIFIED SUBGRADE COMPACTED TO AT LEAST 98% STANDARD PROCTOR DENSITY AND WITHIN -1% TO +3% OPTIMUM MOISTURE CONTENT.
HEAVY DUTY 7" REINFORCED 3500 PSI CONCRETE PAVEMENT WITH #3 BARS @ 18" O.C.E.W. ON 6" LIME STABILIZED SUBGRADE (REFER TO GEOTECH REPORT)
8" REINFORCED 4000 PSI CONCRETE PAVEMENT WITH #4 BARS @ 18" O.C.E.W. ON 6" LIME STABILIZED SUBGRADE (REFER TO GEOTECH REPORT)
HEAVY DUTY 10" REINFORCED 4000 PSI CONCRETE PAVEMENT WITH #4 BARS @ 18" O.C.E.W. ON 8" LIME STABILIZED SUBGRADE COMPACTED TO 98% STANDARD PROCTOR DENSITY (REFER TO SHEET C-02, CITY OF DALLAS GENERAL CONSTRUCTION NOTE 5).
NUMBER OF PARKING SPACES PER ROW
KEY NOTE

NOTES

- 1. ALL DIMENSIONS ARE TO FACE OF CURB, FACE OF BUILDING, OR PROPERTY LINE UNLESS OTHERWISE NOTED.
2. ALL PARKING STALLS SHALL BE 9'x18', UNLESS OTHERWISE NOTED.
3. CONTRACTOR SHALL REFER TO ARCHITECTURAL PLANS FOR EXACT BUILDING FOOTPRINT DIMENSIONS.
4. ALL RADII ARE 2', UNLESS OTHERWISE NOTED.
5. FIRE LANE SHALL BE CONSTRUCTED PER TOWN OF ADDISON FIRE DEPARTMENT STANDARDS AND MARKED PER TOWN SPECIFICATIONS. REFER TO DETAILS FOR ADDITIONAL INFORMATION.
6. PAVEMENT DESIGN DATA SHOWN BY REFERENCE ONLY. PAVEMENT TO BE PER GEOTECH REPORT PROJECT NO. G090336 DATED APRIL 23, 2009 BY ALPHA TESTING. CONTRACTOR SHALL REFER TO ARCHITECTURAL PLANS AND FINAL GEOTECH REPORT FOR BUILDING SUB-GRADE PREPARATION REQUIREMENTS.
7. CONTRACTOR TO VERIFY T.A.S. COMPLIANCE, FOR ANY QUESTIONS CONTACT CIVIL ENGINEER IMMEDIATELY.
8. CONTRACTOR TO VERIFY ENGINEERING PLANS MATCH ARCHITECTURAL PLANS BEFORE CONSTRUCTION STARTING.
9. REFER TO LANDSCAPE PLANS FOR ADDITIONAL INFORMATION.
10. REFER TO SITE LIGHTING PLANS FOR ALL LIGHTING LOCATIONS, SPECIFICATIONS, AND PHOTOMETRIC DETAILS.
11. REFER TO BUILDING ELEVATION PLANS FOR ALL BUILDING SIGNAGE LOCATIONS AND DETAILS.
12. CONTRACTOR SHALL REFER TO M.E.P. AND LANDSCAPE PLANS FOR CONDUIT PLACEMENT PRIOR TO PAVING.
13. CONTRACTOR TO CONSTRUCT 1/2" EXPANSION JOINT WHERE DRIVEWAYS ABUT BUILDING.
14. ALL ACCESSIBLE PATHWAYS SHALL BE BUILT PER ADA STANDARDS, WITH A MAXIMUM CROSS SLOPE OF 2% AND A MAXIMUM LENGTH OF 15 FT.
15. JOINTS IN CONCRETE PAVING SHOULD NOT EXCEED 15 FT. REFER TO GEOTECH REPORT.
16. JOINTS IN CONCRETE PAVING SHOULD NOT EXCEED 15 FT.

RECORD DRAWINGS (SEPTEMBER 2010)


INFORMATION PROVIDED BY: Rogers-O'Brien Construction Company

STOP! CALL BEFORE YOU DIG DIG TESS 1-800-DIG-TESS (@ least 72 hours prior to digging)


BENCHMARK

- 1. "I" FOUND ON TOP OF THE CONCRETE BASE OF A LIGHT POLE IN THE CENTER MEDIAN OF EXCEL PARKWAY APPROXIMATELY 50 FEET WEST OF THE CENTERLINE OF ADDISON ROAD. (PER TOWN OF ADDISON PLAN # 96103, SHEET 2, DATED JANUARY 1998) ELEV=844.41
2. BM #60 SET ON TOP OF A CONCRETE CURB INLET LOCATED ON THE WEST SIDE OF DALLAS PARKWAY APPROXIMATELY 826 FEET NORTH OF THE CENTERLINE OF SOJOURN DRIVE. ELEV=832.78
3. BM #61 SET ON TOP OF A CONCRETE CURB INLET LOCATED ON THE WEST SIDE OF DALLAS PARKWAY APPROXIMATELY 160 FEET NORTH OF THE CENTERLINE OF SOJOURN DRIVE. ELEV=838.04


THE CONTRACTOR SHALL FIELD VERIFY THE HORIZONTAL AND VERTICAL LOCATIONS OF ALL EXISTING UTILITIES PRIOR TO START OF CONSTRUCTION AND SHALL NOTIFY THE CONSTRUCTION MANAGER AND ENGINEER OF ANY CONFLICTS DISCOVERED. CONTRACTOR IS RESPONSIBLE FOR PROTECTING EXISTING UTILITIES (SHOWN OR NOT SHOWN) WITHIN SCOPE OF CONSTRUCTION. IF ANY EXISTING UTILITIES ARE DAMAGED, THE CONTRACTOR SHALL REPLACE THEM AT HIS OWN EXPENSE. CALL 1-800-DIG-TESS AT LEAST 72 HOURS PRIOR TO COMMENCING CONSTRUCTION IN VICINITY.

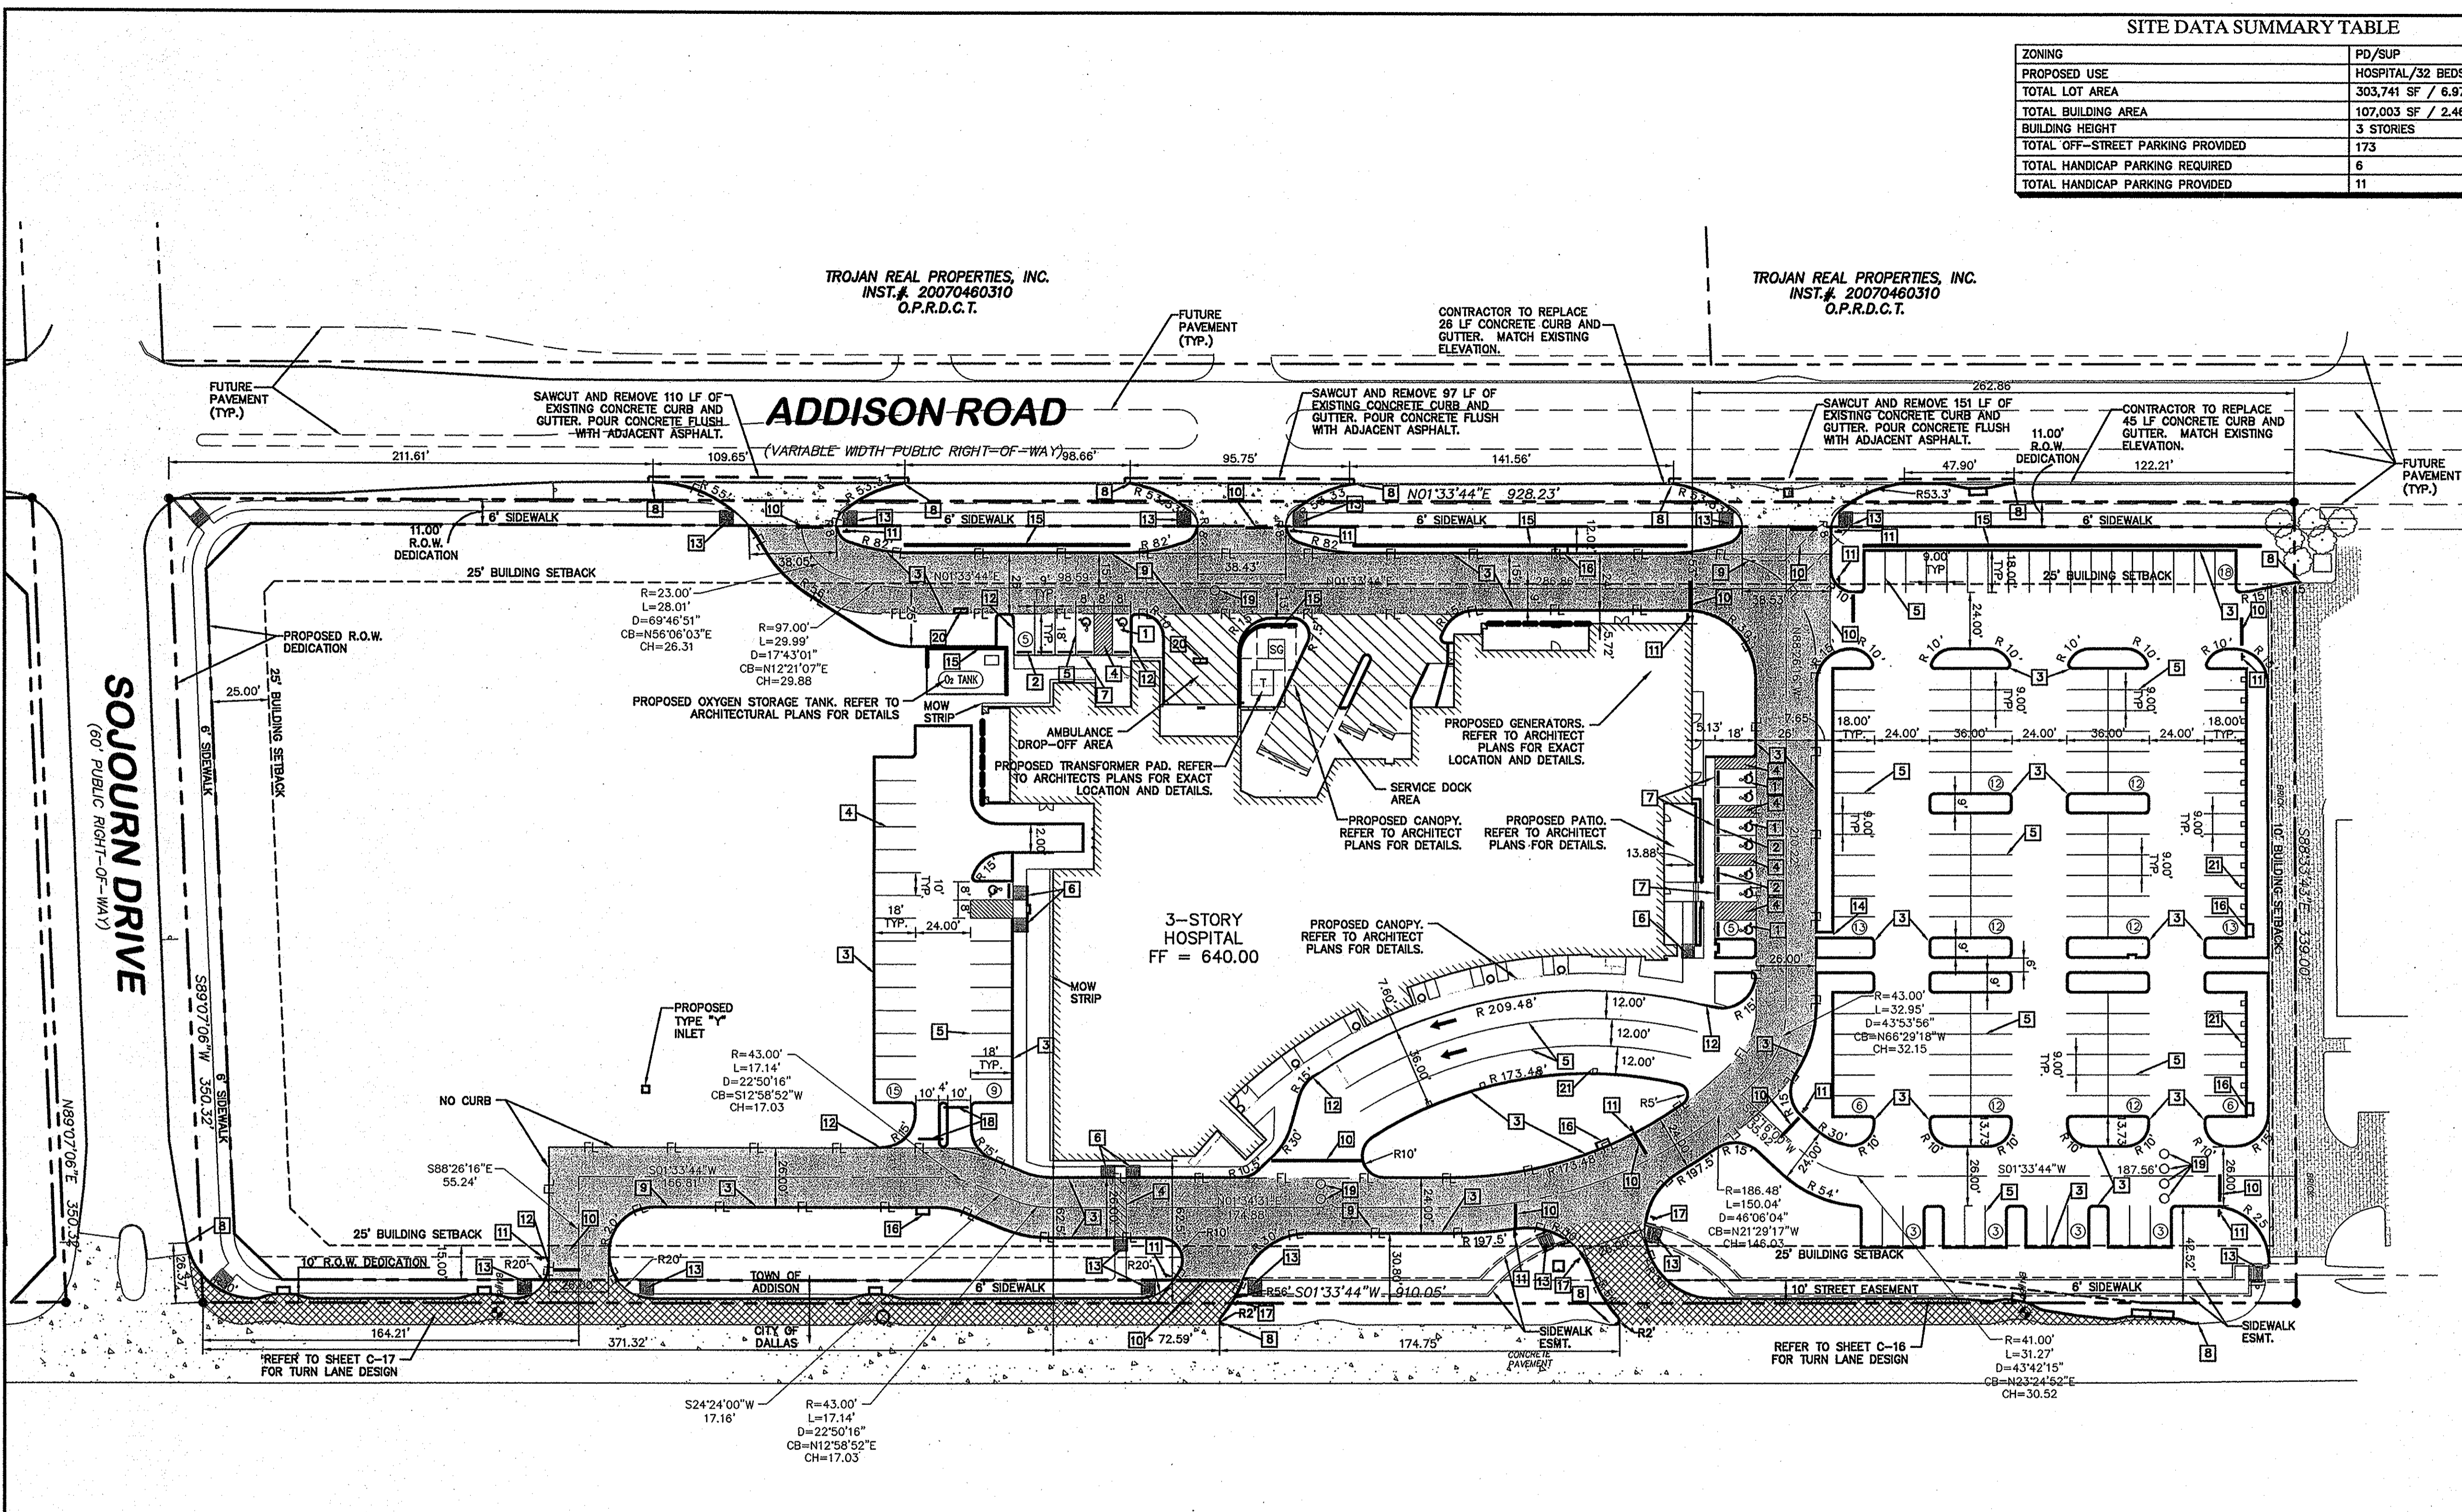

DALLAS NORTH TOLLWAY (VARIABLE WIDTH PUBLIC RIGHT-OF-WAY)

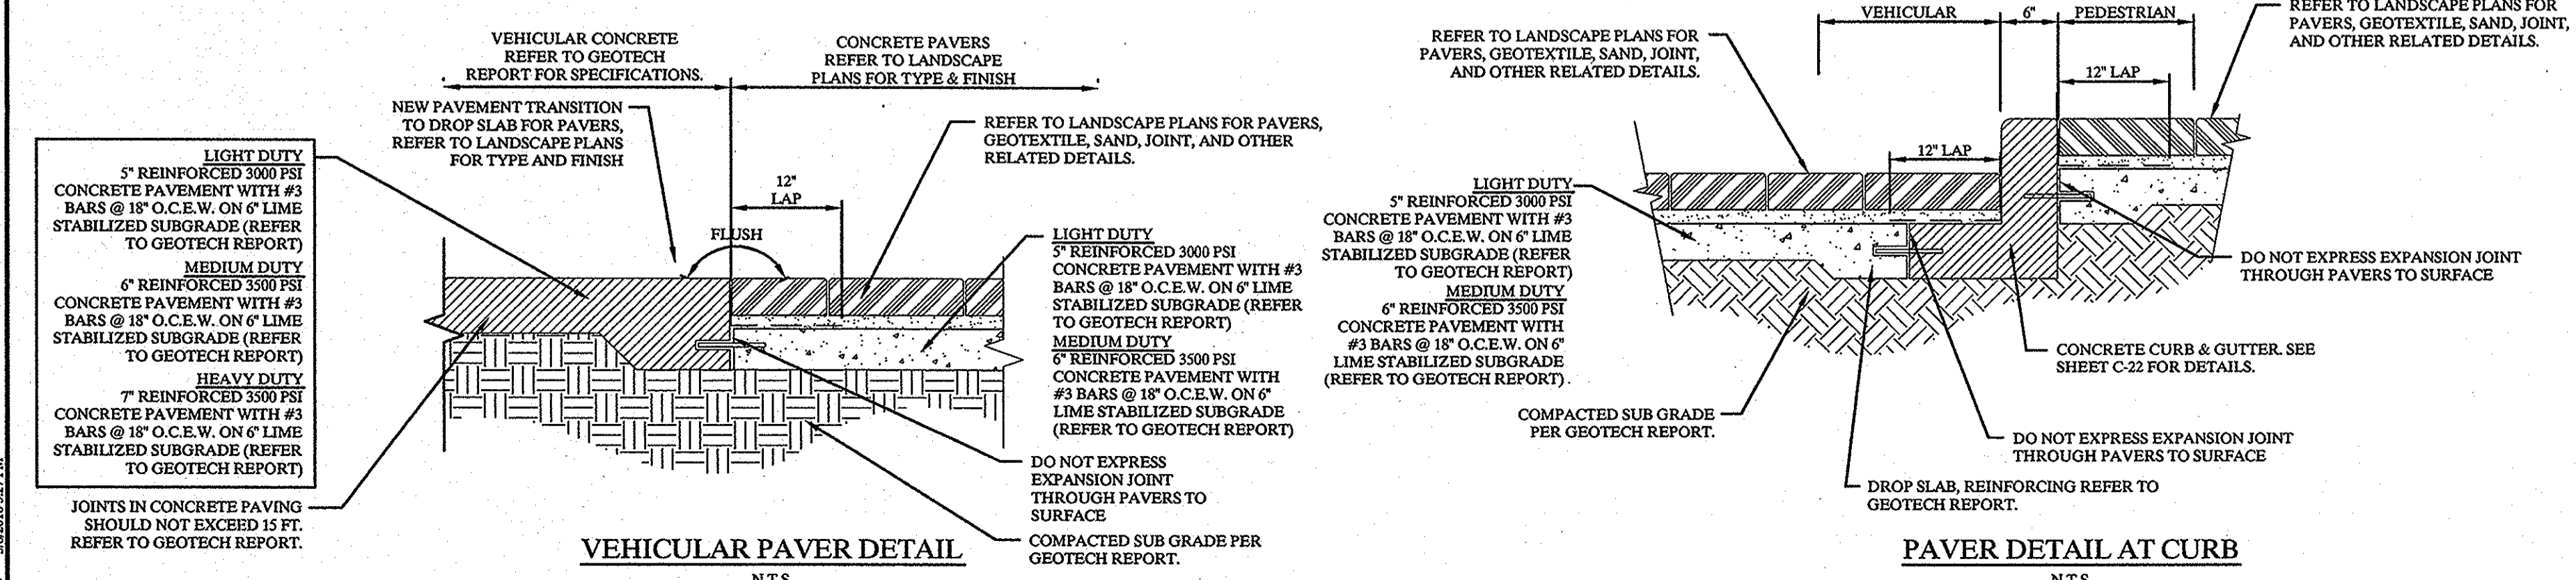

Kimley-Horn and Associates, Inc. Tel. No. (972) 335-3580 Fax No. (972) 335-3779

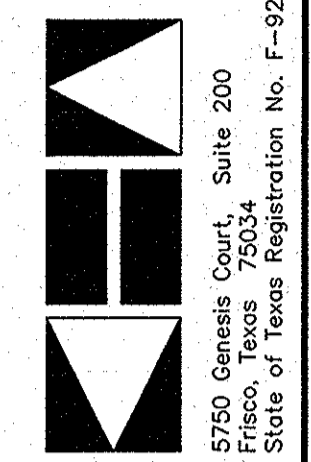

METHODIST HOSPITAL FOR SURGERY ADDISON, TEXAS FILE NUMBER: 311T-7863

DAVID K. ROCHALKA 87781 LICENSED PROFESSIONAL ENGINEER State of Texas Registration No. E-5228


DIMENSION CONTROL AND PAVING PLAN

Table with 2 columns: AS SHOWN, R/C/G, R/C/G, D/B/K, 01/02/10, 09/25/09. Rows for Design, Drawn, Checked, Date, Project No.


SHEET C-04

TROJAN REAL PROPERTIES, INC.  
INST. # 20070460310  
O.P.R.D.C.T.

TROJAN REAL PROPERTIES, INC.  
INST. # 20070460310  
O.P.R.D.C.T.

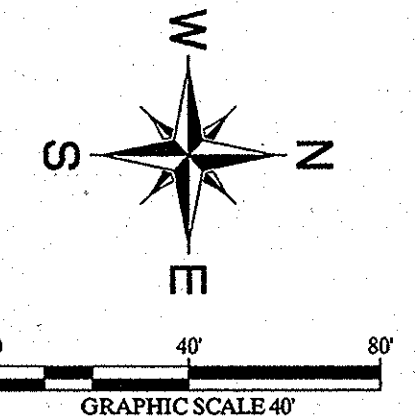

**ADDISON ROAD**  
(VARIABLE WIDTH PUBLIC RIGHT-OF-WAY)

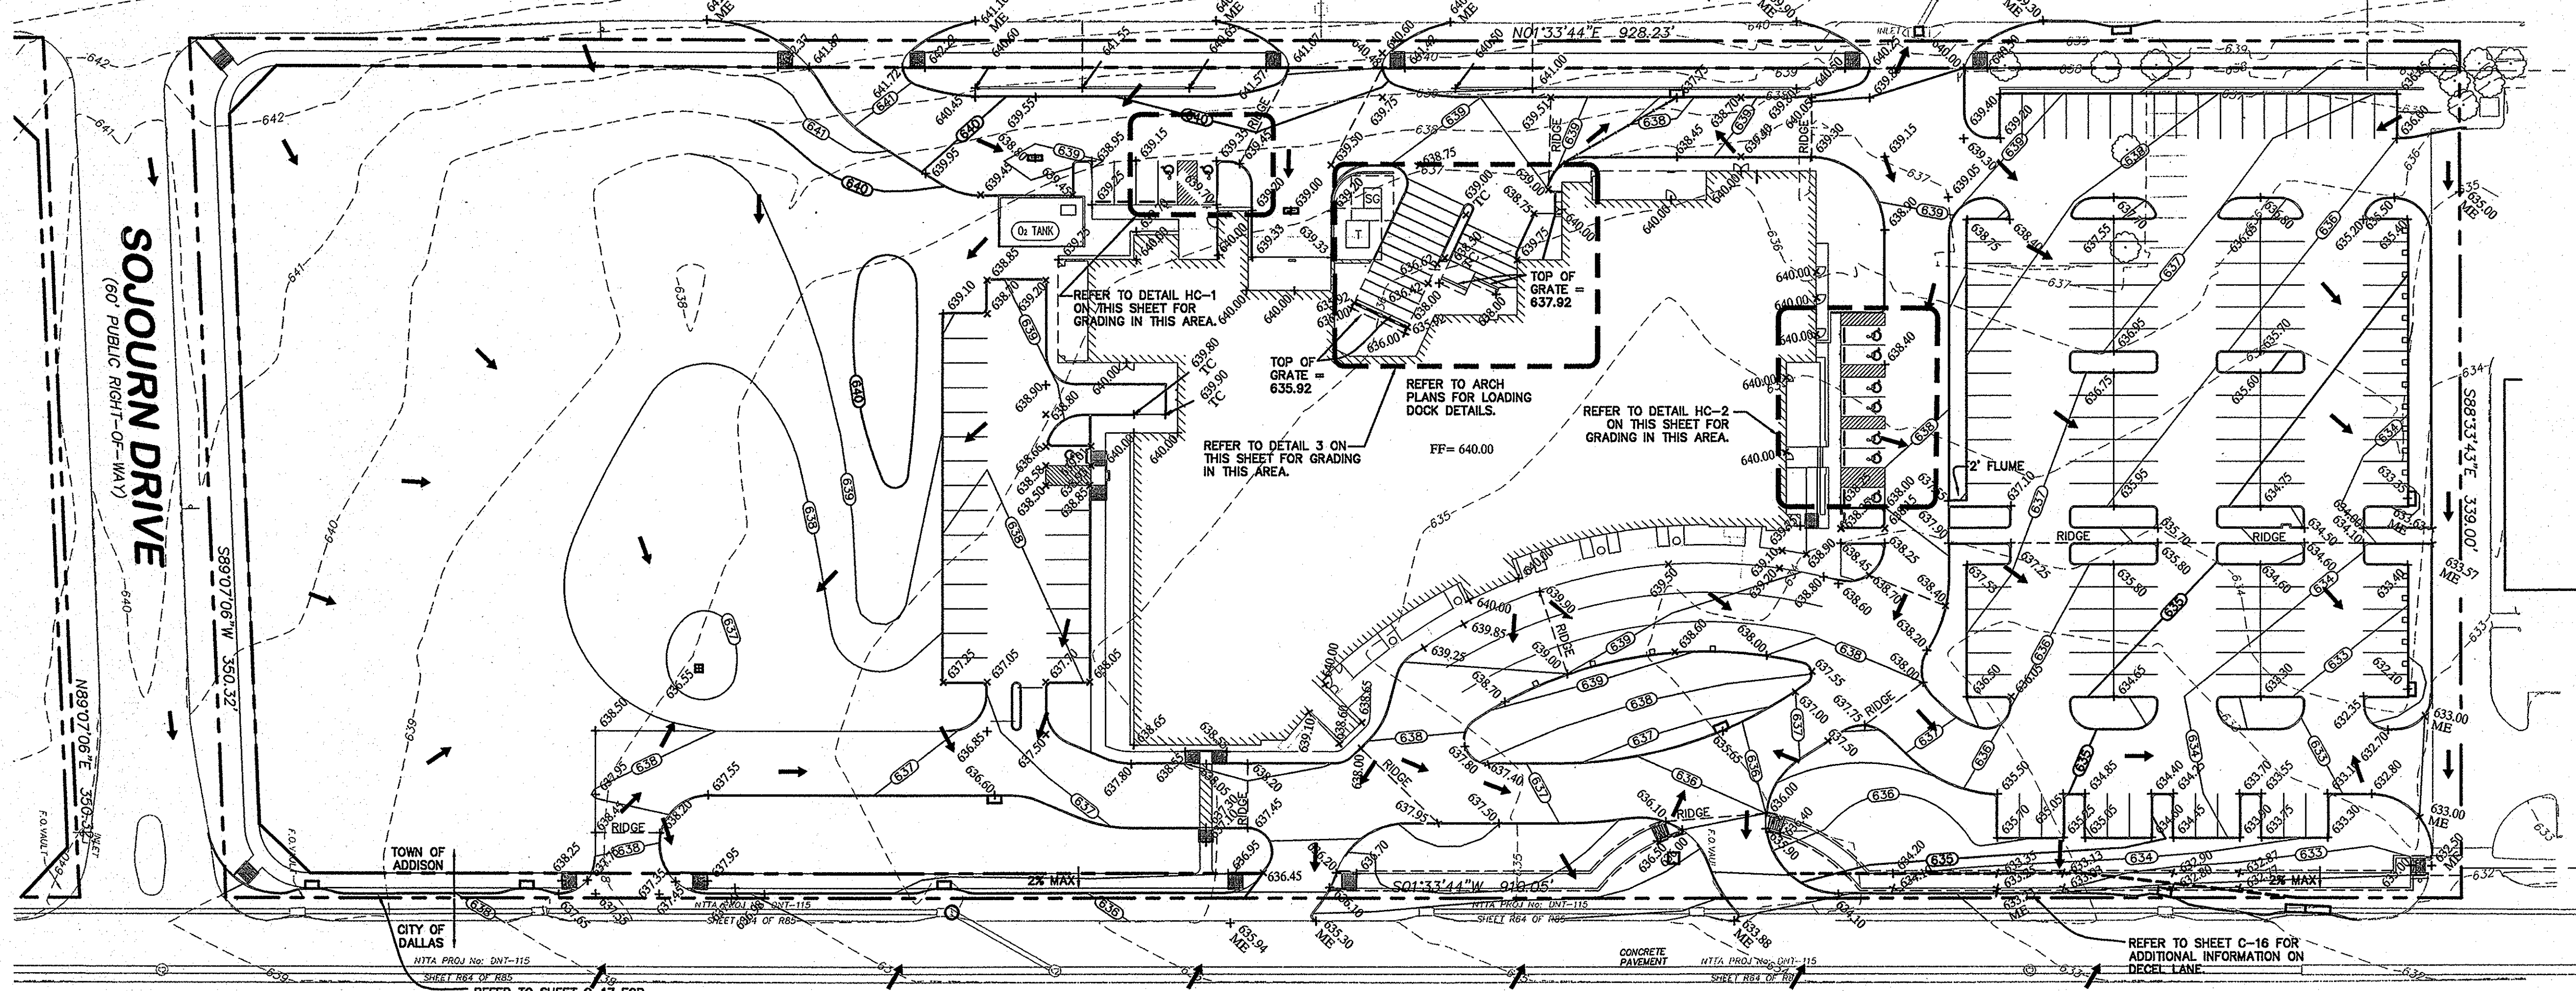

**LEGEND**

---	PROPERTY LINE
---(634)---	PROPOSED CONTOUR
---(696)---	EXISTING CONTOUR
---	SWALE
---	RIDGE
x 694.25	PROPOSED SPOT ELEVATION (TOP OF PAVEMENT)
ME	MATCH EXISTING ELEVATION
→	DIRECTION OF FLOW


- GRADING NOTES**
- SPOT ELEVATIONS ARE TOP OF PAVEMENT ELEVATIONS, UNLESS OTHERWISE NOTED (ADD 0.5" FOR ELEVATION AT TOP OF CURB).
  - CONTRACTOR SHALL REFER TO STRUCTURAL PLANS FOR SUBGRADE PREPARATION SPECIFICATIONS FOR ALL PROPOSED BUILDINGS.
  - ALL FILL MATERIAL SHALL BE COMPACTED TO A MINIMUM OF 95% STANDARD PROCTOR DENSITY. REFER TO PAVING SECTION DETAILS FOR SUBGRADE PREPARATION REQUIREMENTS UNDER ALL PAVED AREAS. (REFER TO GEOTECH REPORT)
  - ALL SIDEWALKS SHALL HAVE A MAXIMUM LONGITUDINAL SLOPE OF 5% AND A MAXIMUM GROSS SLOPE OF 2% IF THE CONTRACTOR IDENTIFIES SLOPES GREATER, CONTRACTOR SHALL NOTIFY ENGINEER PRIOR TO CONSTRUCTION.
  - CONTRACTOR SHALL VERIFY COMPLIANCE WITH TEXAS ACCESSIBILITY STANDARDS (TAS) AND SHALL NOTIFY CIVIL ENGINEER IMMEDIATELY OF ANY CONFLICTS.
  - CONTRACTOR SHALL COORDINATE GRADING AT FACE OF BUILDING WITH PLANS BY ARCHITECT AND SHALL NOTIFY CIVIL ENGINEER IMMEDIATELY OF ANY CONFLICTS.
  - MAXIMUM SLOPES FOR CUT AND FILL ARE BOTH 4:1.
  - ALL VAULTS, METERS, MANHOLE RIMS, CLEANOUTS, FIRE HYDRANT SLABS, ETC. SHALL BE LAID FLUSH WITH THE PROPOSED FLATWORK GRADING.
  - REFERENCE MEP PLANS FOR DETAILED INFORMATION REGARDING EQUIPMENT PADS IN THE MECHANICAL YARDS.

**STOP!**  
**CALL BEFORE YOU DIG**  
DIG TESS  
1-800-DIG-TESS  
(@ least 72 hours prior to digging)


- BENCHMARK**
- "T" FOUND ON TOP OF THE CONCRETE BASE OF A LIGHT POLE IN THE CENTER MEDIAN OF EXCEL PARKWAY APPROXIMATELY 50 FEET WEST OF THE CENTERLINE OF ADDISON ROAD. (PER TOWN OF ADDISON PLAN # 96103, SHEET 2, DATED JANUARY 1998) ELEV=644.41
  - BM #60 SET ON TOP OF A CONCRETE CURB INLET LOCATED ON THE WEST SIDE OF DALLAS PARKWAY APPROXIMATELY 828 FEET NORTH OF THE CENTERLINE OF SOJOURN DRIVE. ELEV=632.78
  - BM #61 SET ON TOP OF A CONCRETE CURB INLET LOCATED ON THE WEST SIDE OF DALLAS PARKWAY APPROXIMATELY 160 FEET NORTH OF THE CENTERLINE OF SOJOURN DRIVE. ELEV=638.04

THE CONTRACTOR SHALL FIELD VERIFY THE HORIZONTAL AND VERTICAL LOCATIONS OF ALL EXISTING UTILITIES PRIOR TO START OF CONSTRUCTION AND SHALL NOTIFY THE CONSTRUCTION MANAGER AND ENGINEER OF ANY CONFLICTS DISCOVERED. CONTRACTOR IS RESPONSIBLE FOR PROTECTING EXISTING UTILITIES (SHOWN OR NOT SHOWN) WITHIN SCOPE OF CONSTRUCTION. IF ANY EXISTING UTILITIES ARE DAMAGED, THE CONTRACTOR SHALL REPLACE THEM AT HIS OWN EXPENSE. CALL 1-800-DIG-TESS AT LEAST 72 HOURS PRIOR TO COMMENCING CONSTRUCTION IN VICINITY.


**DALLAS NORTH TOLLWAY**  
(VARIABLE WIDTH PUBLIC RIGHT-OF-WAY)

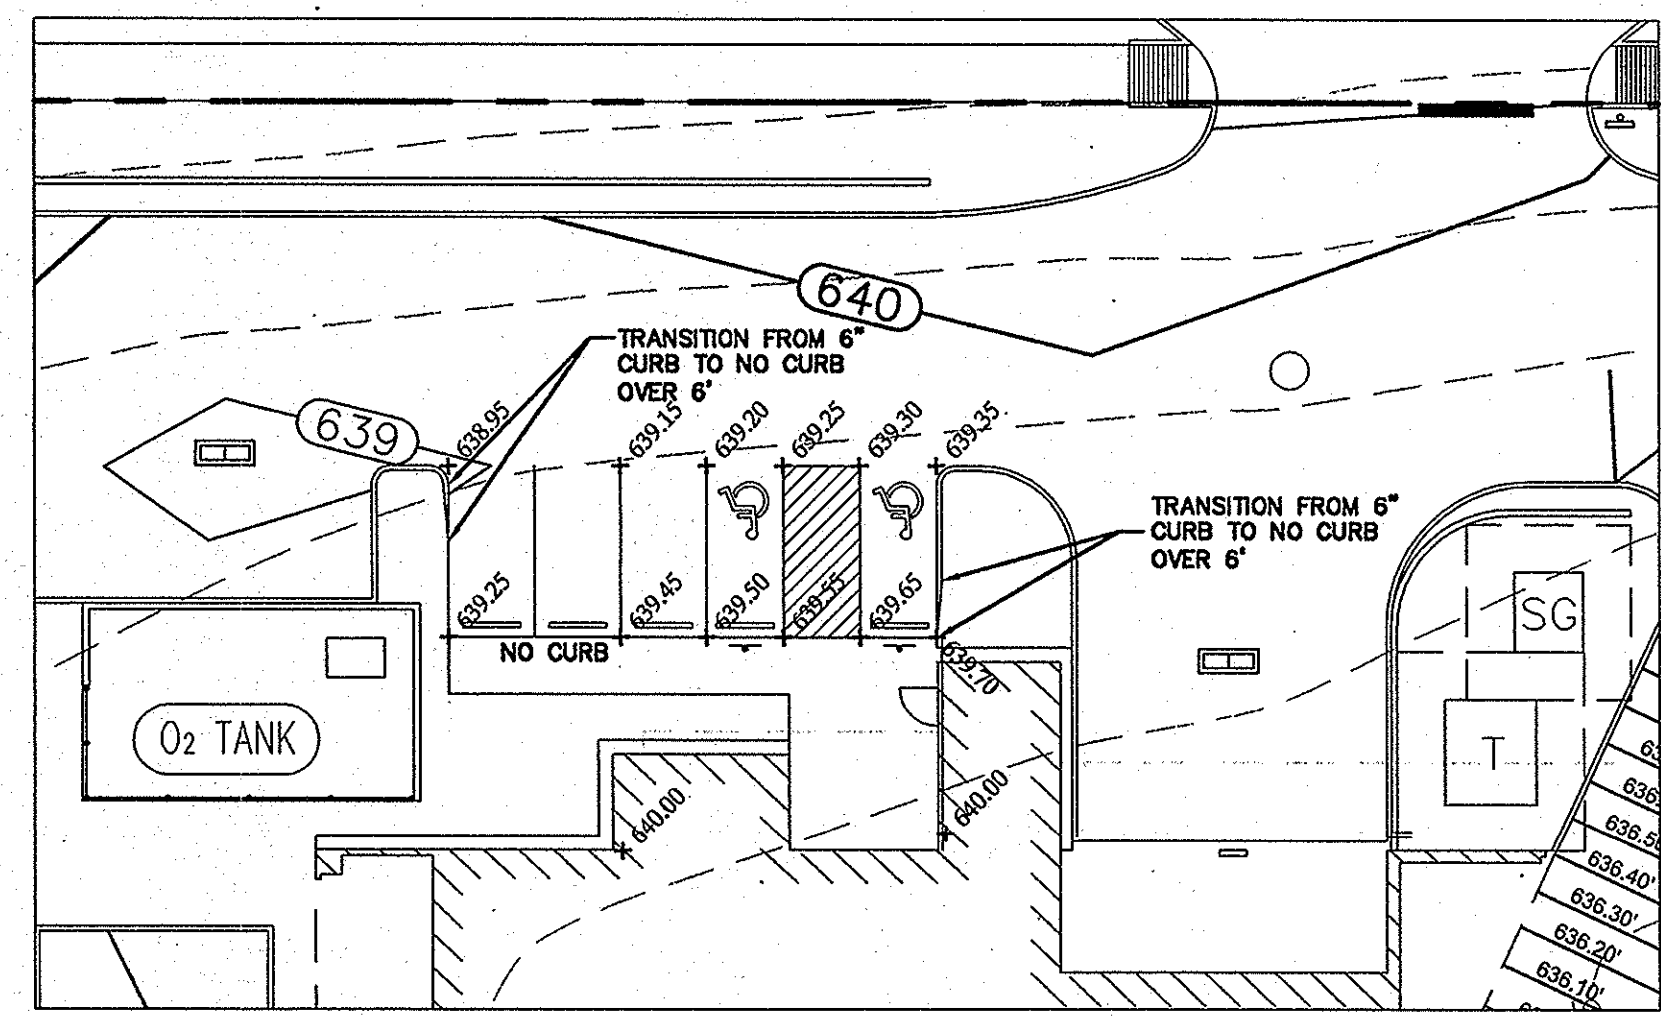

DETAIL HC-1  
SCALE: 1"=20'

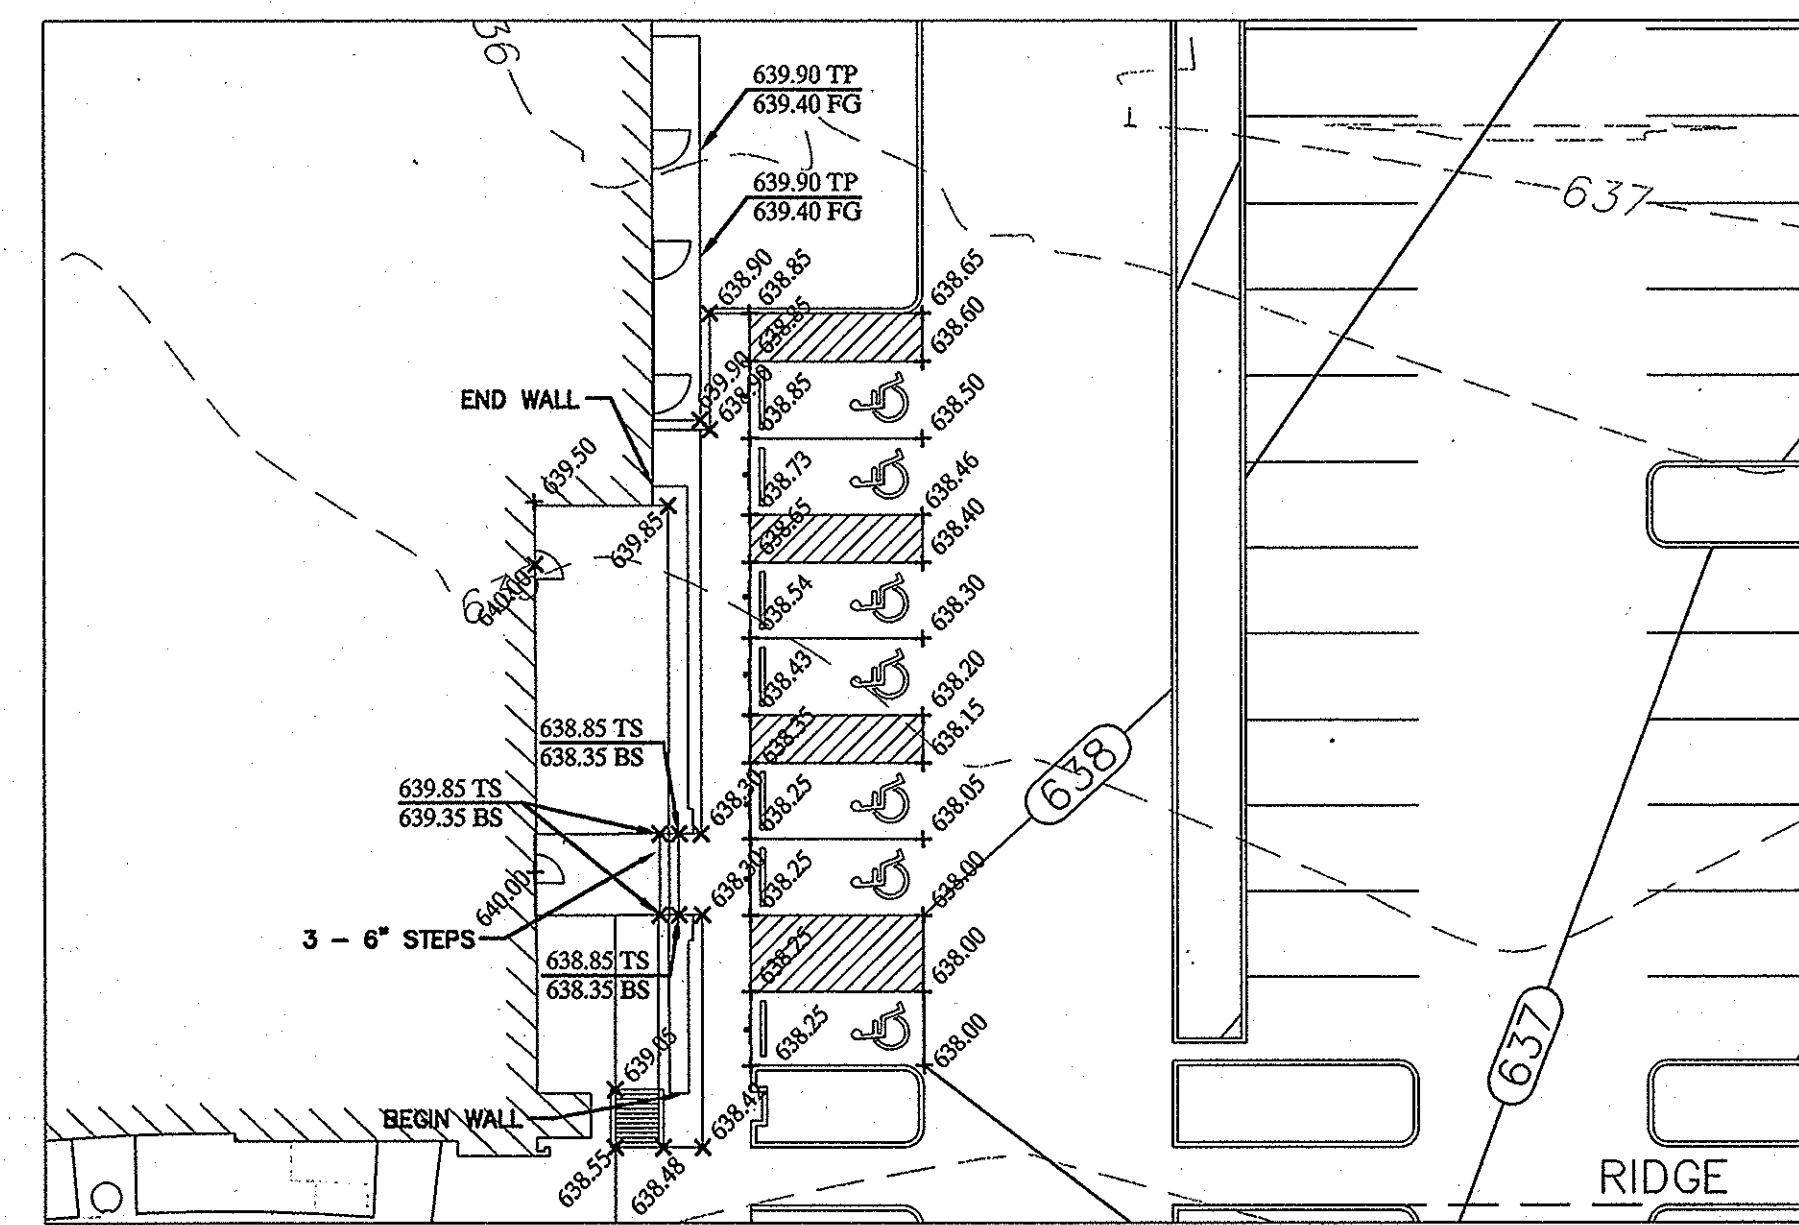

DETAIL HC-2  
SCALE: 1"=20'

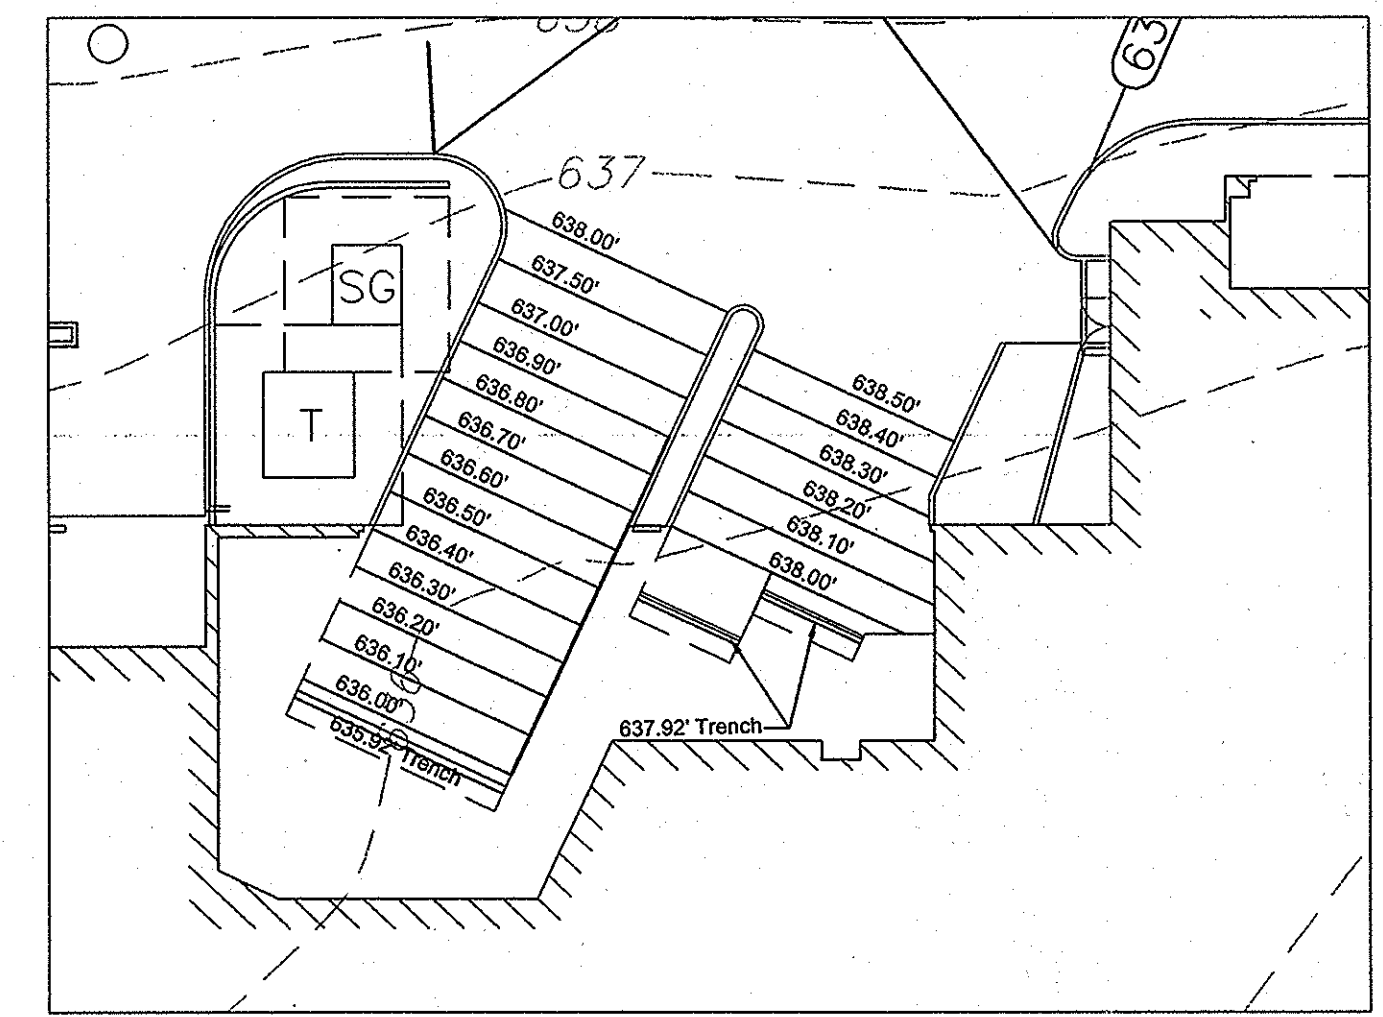

DETAIL 3  
SCALE: 1"=20'

**RECORD DRAWINGS**  
(SEPTEMBER 2010)  
INFORMATION PROVIDED BY:  
Rogers-O'Brien Construction Company

App. Revisions

No.	Date	Revisions
1	12/21/09	ISSUANCE TO ROGERS O'BRIEN CONSTRUCTION COMPANY FOR LAYOUT AND FRONT ENTRANCE

**Kimley-Horn and Associates, Inc.**  
Tel. No. (972) 335-3580  
Fax No. (972) 335-3779  
5750 Geneva Court, Suite 200  
Frisco, Texas 75034  
State of Texas Registration No. F-528

**METHODIST HOSPITAL FOR SURGERY**  
ADDISON, TEXAS  
FILE NUMBER: 311T-7863

**GRADING PLAN**

AS SHOWN  
Designed by: TNB  
Drawn by: TNB  
Checked by: DKK  
Date: 01/02/10  
Project No.: 69302500

SHEET  
**C-05**

THESE PLANS, SPECIFICATIONS, AND CONTRACT DOCUMENTS ARE THE PROPERTY OF KIMLEY-HORN AND ASSOCIATES, INC. AND ARE NOT TO BE REPRODUCED, COPIED, OR TRANSMITTED IN ANY FORM OR BY ANY MEANS, ELECTRONIC OR MECHANICAL, INCLUDING PHOTOCOPYING, RECORDING, OR BY ANY INFORMATION STORAGE AND RETRIEVAL SYSTEM, WITHOUT THE WRITTEN PERMISSION OF KIMLEY-HORN AND ASSOCIATES, INC.







Graphical Hydrograph Method for Stormwater Detention Pond 1  
Methodist Hospital for Special Surgery, Town of Addison

Design Frequency: 100 year storm  
Purpose: Use the graphical hydrograph method to determine the volume of stormwater storage needed to compensate for increased runoff due to development.  
Method: Use the Rational Method to determine maximum rate of runoff...  
Assumptions: Rainfall Intensity determined from attached graph given Time of Concentration (Tc) or Duration and the Return Period of the storm.  
For Existing Conditions: c=1.00, c=0.30, Tc=10 min, I=8.74 in./hr.  
For Proposed Conditions: Use cr=1.00, c=0.50 for Non-Residential Uses, Tc=10 min, I=8.74

I. Determination of Allowable Release Rate - Existing Site  
Total site area: 3.02 acres  
Detention Time of Concentration (Tc): 10 minutes  
Rainfall intensity for one-hundred year storm (I=10 min): 8.74 inches/hr  
Frequency Factor coefficient: 1.00  
Detained runoff coefficient: 0.30  
Allowable total site detained release rate: 7.9 cfs  
Area of site draining through detention pond: 2.60 acres  
Area of site draining undetained: 0.42 acres  
Undetained Time of Concentration (Tu): 10 minutes  
Rainfall intensity for one-hundred year storm (I=10 min): 8.74 inches/hr  
Frequency Factor coefficient: 1.00  
Runoff coefficient for developed conditions: 0.90  
Runoff from undetained area: 3.3 cfs  
Total off-site area passed through: 0.00 acres  
Time of Concentration (Tt): 10 minutes  
Rainfall intensity for one-hundred year storm (I=15 min): 8.74 inches/hr  
Frequency Factor coefficient: 1.00  
Runoff coefficient: 0.90  
Off-site pass-through rate: 0.0 cfs  
Total release rate from detention pond (allowed): 4.61 cfs  
Actual metered release rate from detention pond: 4.61 cfs

II. Required Storage Calculations, Return Period = 100 years  
Intensity: 0 0 0  
Duration (hours) (min) Rainfall Intensity (in/hr) Inflow Rate (cfs) Inflow Volume (cf) Outflow Rate (cfs) Outflow Volume (cf) Inflow-Outflow Volume (cf) Required Storage (ac-ft)  
0.17 10 8.74 20.5 12.271 4.61 2,769 9,502 0.218  
0.25 15 7.52 17.6 15.837 4.61 3,461 12,376 0.284  
0.33 20 6.80 15.9 19,094 4.61 4,153 14,941 0.343  
0.41 30 6.24 14.4 21,177 4.61 4,923 17,253 0.418  
0.49 40 5.81 13.2 22,743 4.61 5,738 19,321 0.492  
0.57 50 5.47 12.2 23,854 4.61 6,599 21,163 0.532  
0.65 60 5.18 11.3 24,519 4.61 7,506 22,771 0.574  
0.73 70 4.93 10.5 24,747 4.61 8,460 24,197 0.619  
0.81 80 4.71 9.8 24,519 4.61 9,462 25,439 0.667  
0.89 90 4.51 9.2 23,919 4.61 10,506 26,497 0.717  
0.97 100 4.34 8.6 22,925 4.61 11,590 27,471 0.770  
1.05 110 4.19 8.1 21,699 4.61 12,706 28,371 0.826  
1.13 120 4.05 7.7 20,297 4.61 13,851 29,207 0.885  
TOTAL 25,230

Pond 1 Outfall Calculations

Purpose: Provide metered flow that meets the 100-year storm event release rate restrictions.  
Method: Use weir flow and orifice flow calculations to determine total outflow as a product of pond depth.  
Goal: Water surface elevation based upon volume required 100-yr storm requires 0 cf of storage, which occurs at elev 635.42  
Where: Use weir equation to determine flow until opening is submerged.  
Q = C\*b\*H^(3/2)  
C = discharge coefficient = 3.33  
b = weir base width  
H = water level height above base of weir  
Use orifice equation to determine flow once opening is submerged.  
Q = A\*C\*(2g\*h)^(1/2)  
A = area of opening  
C = discharge coefficient = 0.6  
h = water level height above center of opening  
Opening 1: b = 0.80 ft, Height = 0.50 ft, A = 0.40 SF, base elev = 629.41 ft  
Weir table with columns: WSEL, H1, Q1, h1, Q1, Qtotal, Event, Q allow. Rows include WSEL values from 629.41 to 635.42.  
Orifice table with columns: WSEL, H1, Q1, h1, Q1, Qtotal, Event, Q allow. Rows include WSEL values from 629.41 to 635.42.

Graphical Hydrograph Method for Stormwater Detention Pond 2  
Methodist Hospital for Special Surgery, Town of Addison



Design Frequency: 100 year storm  
Purpose: Use the graphical hydrograph method to determine the volume of stormwater storage needed to compensate for increased runoff due to development.  
Method: Use the Rational Method to determine maximum rate of runoff...  
Assumptions: Rainfall Intensity determined from attached graph given Time of Concentration (Tc) or Duration and the Return Period of the storm.  
For Existing Conditions: cr=1.00, c=0.30, Tc=10 min, I=8.74 in./hr.  
For Proposed Conditions: Use cr=1.00, c=0.50 for Non-Residential Uses, Tc=10 min, I=8.74

I. Determination of Allowable Release Rate - Existing Site  
Total site area: 1.95 acres  
Detention Time of Concentration (Tc): 10 minutes  
Rainfall intensity for one-hundred year storm (I=10 min): 8.74 inches/hr  
Frequency Factor coefficient: 1.00  
Detained runoff coefficient: 0.30  
Allowable total site detained release rate: 5.1 cfs  
Area of site draining through detention pond: 1.74 acres  
Area of site draining undetained: 0.21 acres  
Undetained Time of Concentration (Tu): 10 minutes  
Rainfall intensity for one-hundred year storm (I=10 min): 8.74 inches/hr  
Frequency Factor coefficient: 1.00  
Runoff coefficient for developed conditions: 0.90  
Runoff from undetained area: 1.7 cfs  
Total off-site area passed through: 0.00 acres  
Time of Concentration (Tt): 10 minutes  
Rainfall intensity for one-hundred year storm (I=15 min): 8.74 inches/hr  
Frequency Factor coefficient: 1.00  
Runoff coefficient: 0.90  
Off-site pass-through rate: 0.0 cfs  
Total release rate from detention pond (allowed): 3.46 cfs  
Actual metered release rate from detention pond: 3.46 cfs

II. Required Storage Calculations, Return Period = 100 years  
Intensity: 0 0 0  
Duration (hours) (min) Rainfall Intensity (in/hr) Inflow Rate (cfs) Inflow Volume (cf) Outflow Rate (cfs) Outflow Volume (cf) Inflow-Outflow Volume (cf) Required Storage (ac-ft)  
0.17 10 8.74 17.7 8,212 3.46 2,077 6,135 0.141  
0.25 15 7.52 14.6 10,599 3.46 2,596 7,003 0.184  
0.33 20 6.80 10.6 12,779 3.46 3,115 9,664 0.222  
0.41 30 6.24 9.0 16,180 3.46 4,153 12,027 0.276  
0.49 40 5.81 7.7 18,566 3.46 5,192 13,375 0.307  
0.57 50 5.47 6.8 20,530 3.46 6,230 14,300 0.328  
0.65 60 5.18 6.1 21,987 3.46 7,268 14,718 0.338  
0.73 70 4.93 5.7 23,007 3.46 8,306 15,700 0.360  
0.81 80 4.71 5.2 23,181 3.46 9,345 15,836 0.364  
0.89 90 4.51 4.8 23,046 3.46 10,383 15,663 0.360  
0.97 100 4.34 4.5 22,967 3.46 11,421 15,545 0.357  
1.05 110 4.19 4.2 22,906 3.46 12,460 15,446 0.355  
1.13 120 4.05 4.0 22,526 3.46 13,498 15,028 0.345  
TOTAL 15,984

Pond 2 Outfall Calculations

Purpose: Provide metered flow that meets the 100-year storm event release rate restrictions.  
Method: Use weir flow and orifice flow calculations to determine total outflow as a product of pond depth.  
Goal: Water surface elevation based upon volume required 100-yr storm requires 0 cf of storage, which occurs at elev 631.11  
Where: Use weir equation to determine flow until opening is submerged.  
Q = C\*b\*H^(3/2)  
C = discharge coefficient = 3.33  
b = weir base width  
H = water level height above base of weir  
Use orifice equation to determine flow once opening is submerged.  
Q = A\*C\*(2g\*h)^(1/2)  
A = area of opening  
C = discharge coefficient = 0.6  
h = water level height above center of opening  
Opening 1: b = 0.63 ft, Height = 0.65 ft, A = 0.40 SF, base elev = 627.62 ft  
Weir table with columns: WSEL, H1, Q1, h1, Q1, Qtotal, Event, Q allow. Rows include WSEL values from 627.62 to 631.11.  
Orifice table with columns: WSEL, H1, Q1, h1, Q1, Qtotal, Event, Q allow. Rows include WSEL values from 627.62 to 631.11.

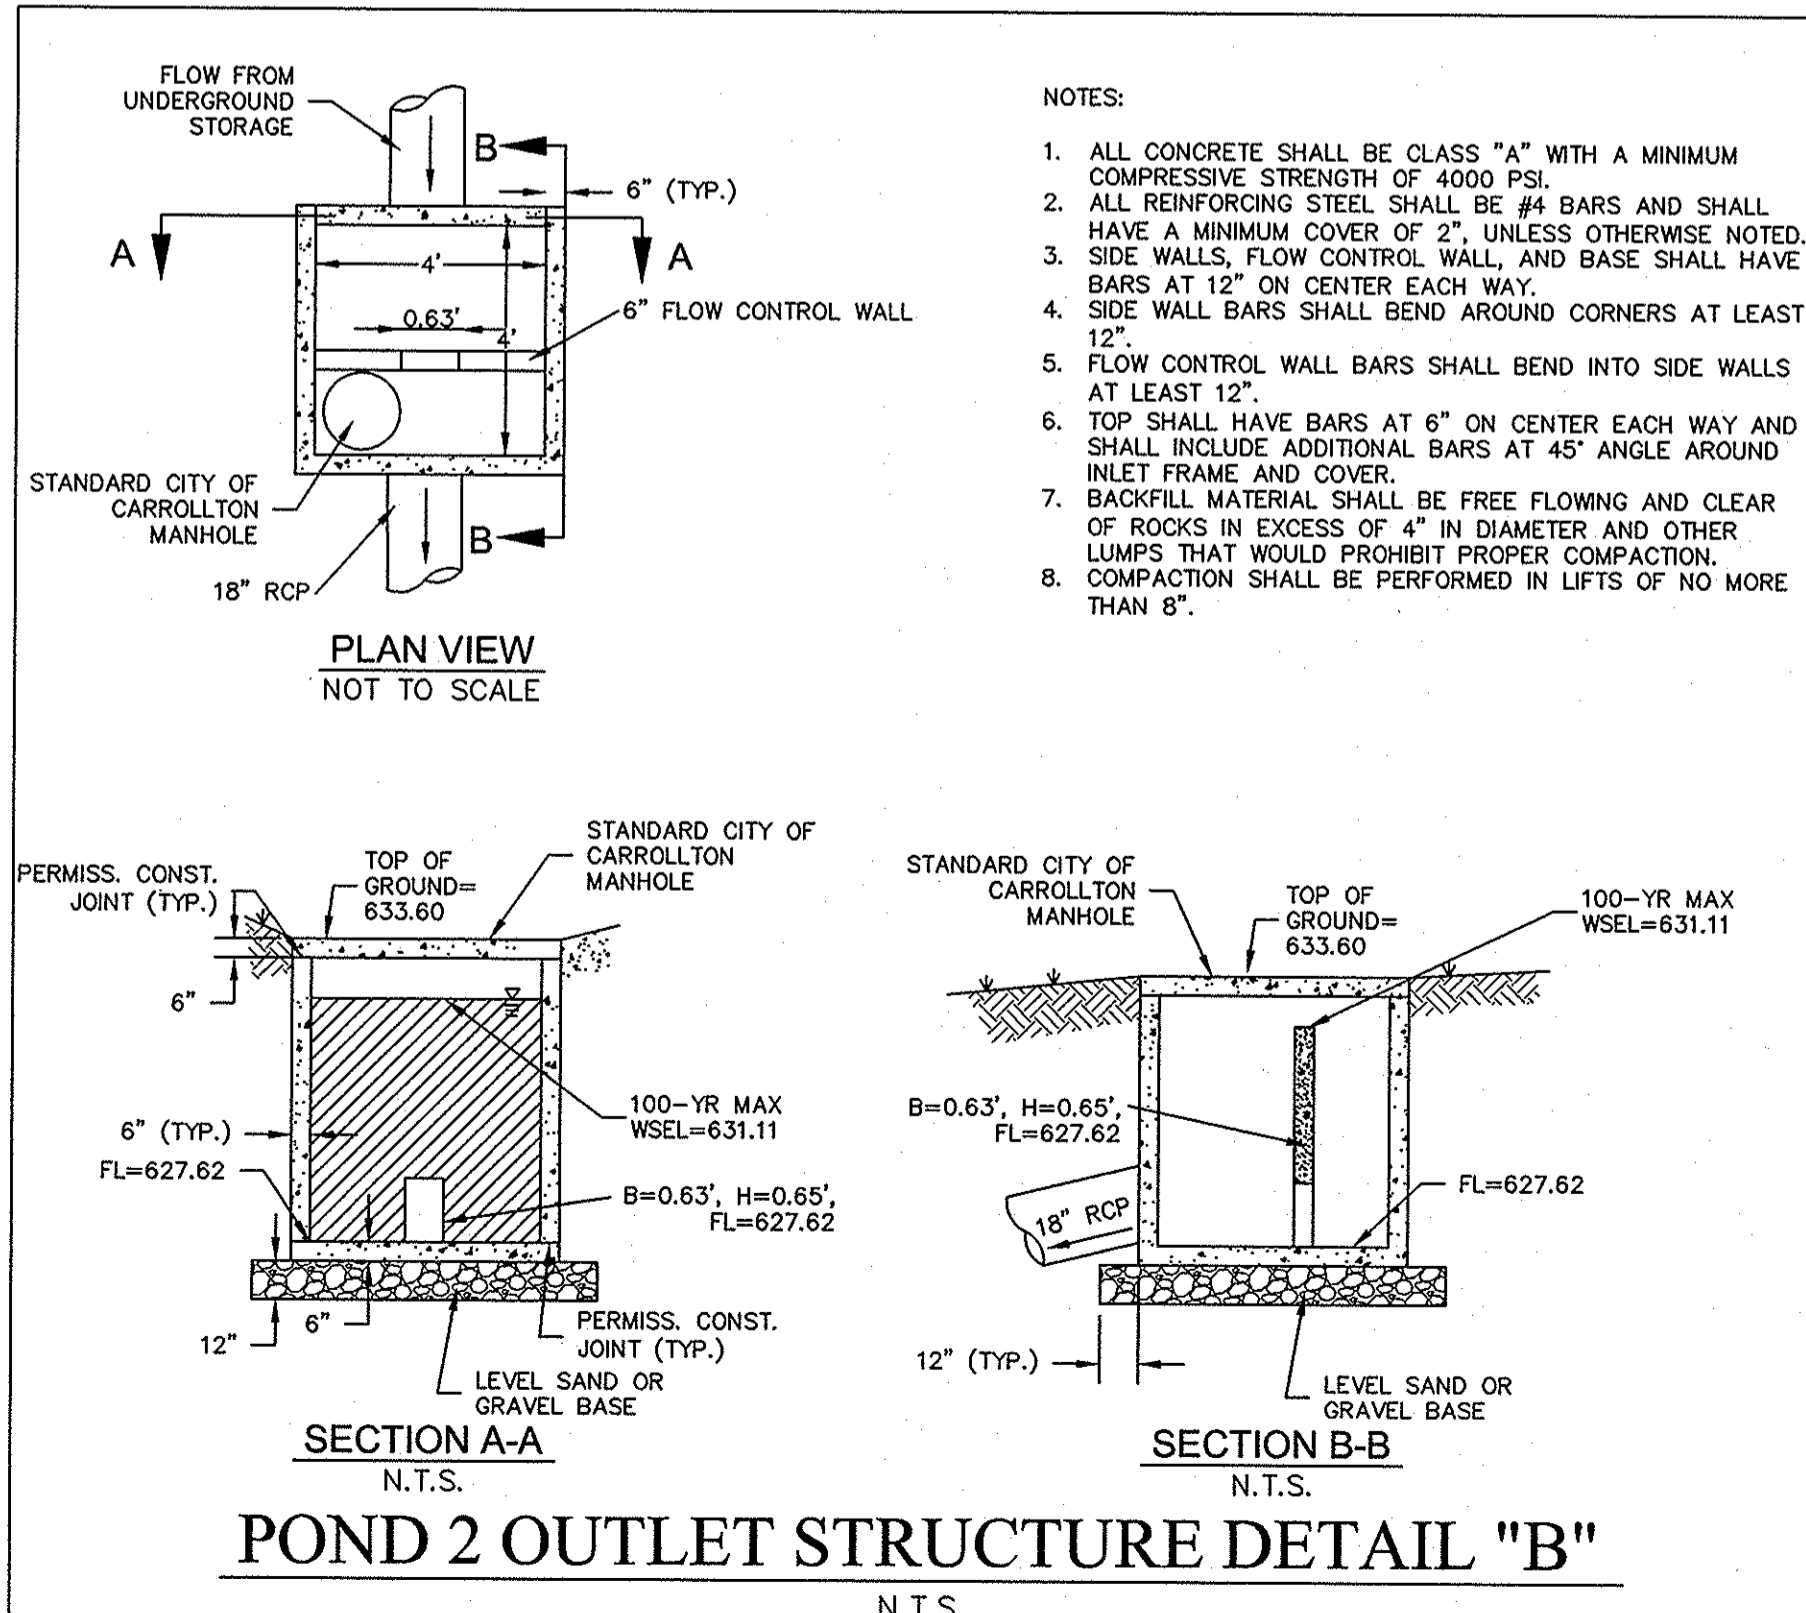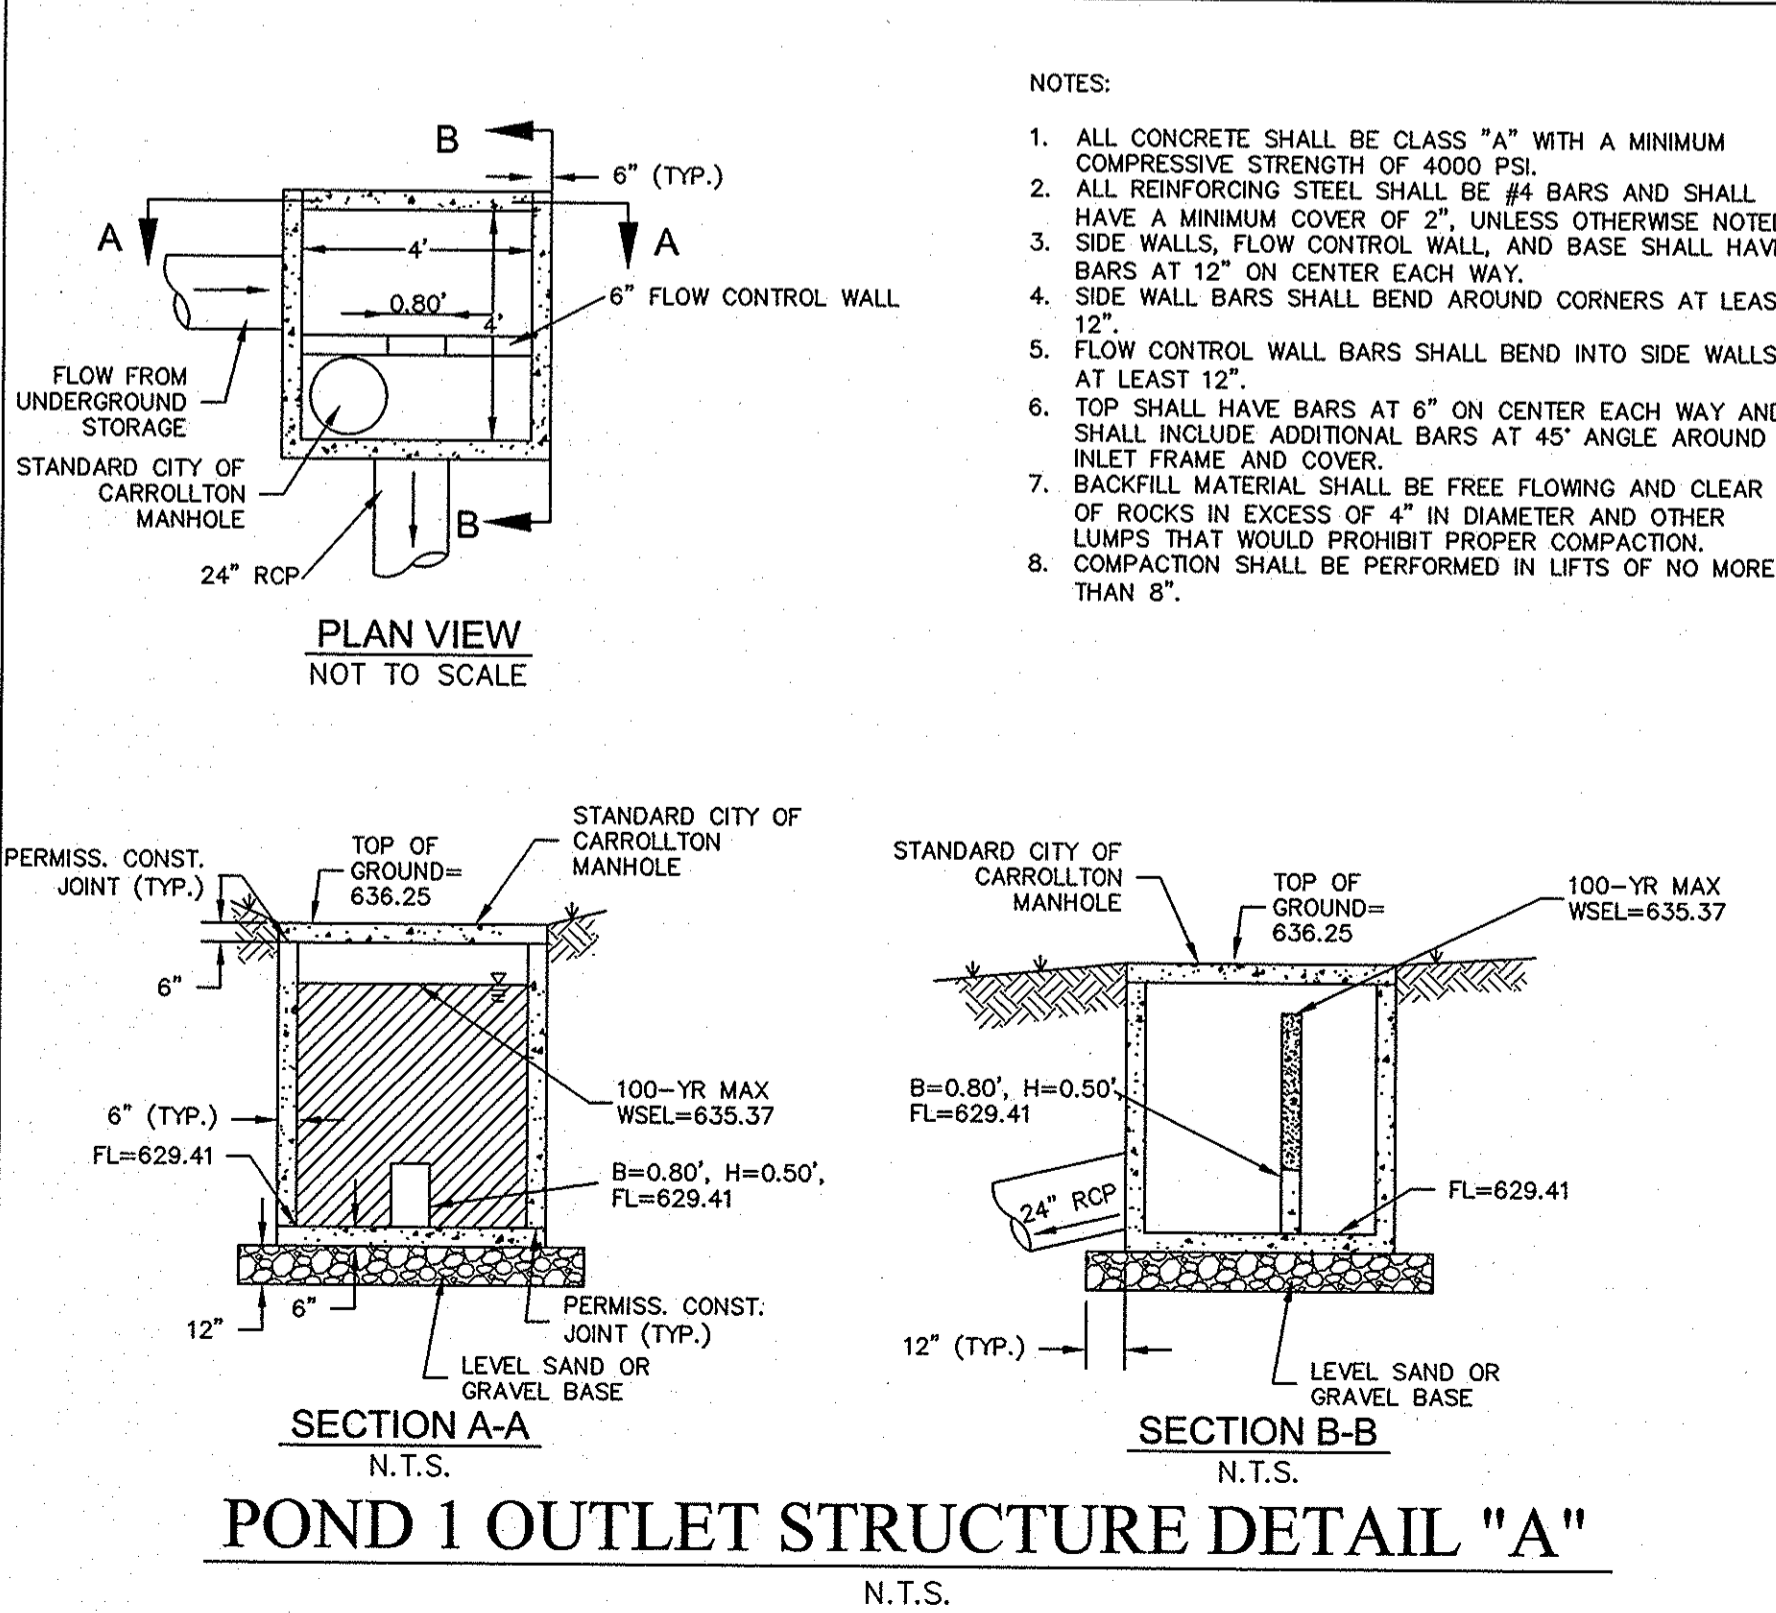

RECORD DRAWINGS (SEPTEMBER 2010)  
INFORMATION PROVIDED BY: Rogers-O'Brien Construction Company


Kimley-Horn and Associates, Inc.  
Tel: No. (972) 355-3500  
Fax: No. (972) 355-0779  
5710 Operetta Court, Suite 200  
Frisco, Texas 75034  
State of Texas Registration No. F-628

METHODIST HOSPITAL FOR SURGERY  
ADDISON, TEXAS  
FILE NUMBER: 311T-7863

DETENTION CALCULATIONS  
SHEET C-08  
Scale: AS SHOWN  
Designed by: TNB  
Drawn by: TNB  
Checked by: DKK  
Date: 11/02/09  
Project No.: 69052500


TROJAN REAL PROPERTIES, INC.  
INST. # 20070460310  
O.P.R.D.C.T.

TROJAN REAL PROPERTIES, INC.  
INST. # 20070460310  
O.P.R.D.C.T.

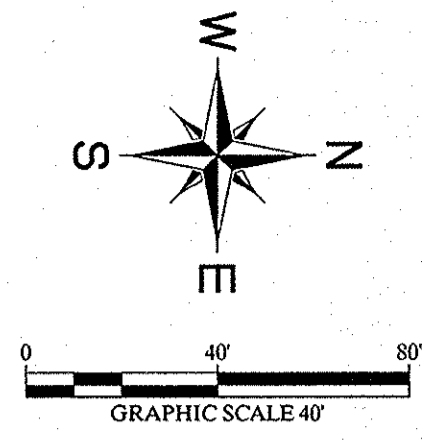

# ADDISON ROAD

(VARIABLE WIDTH PUBLIC RIGHT-OF-WAY)

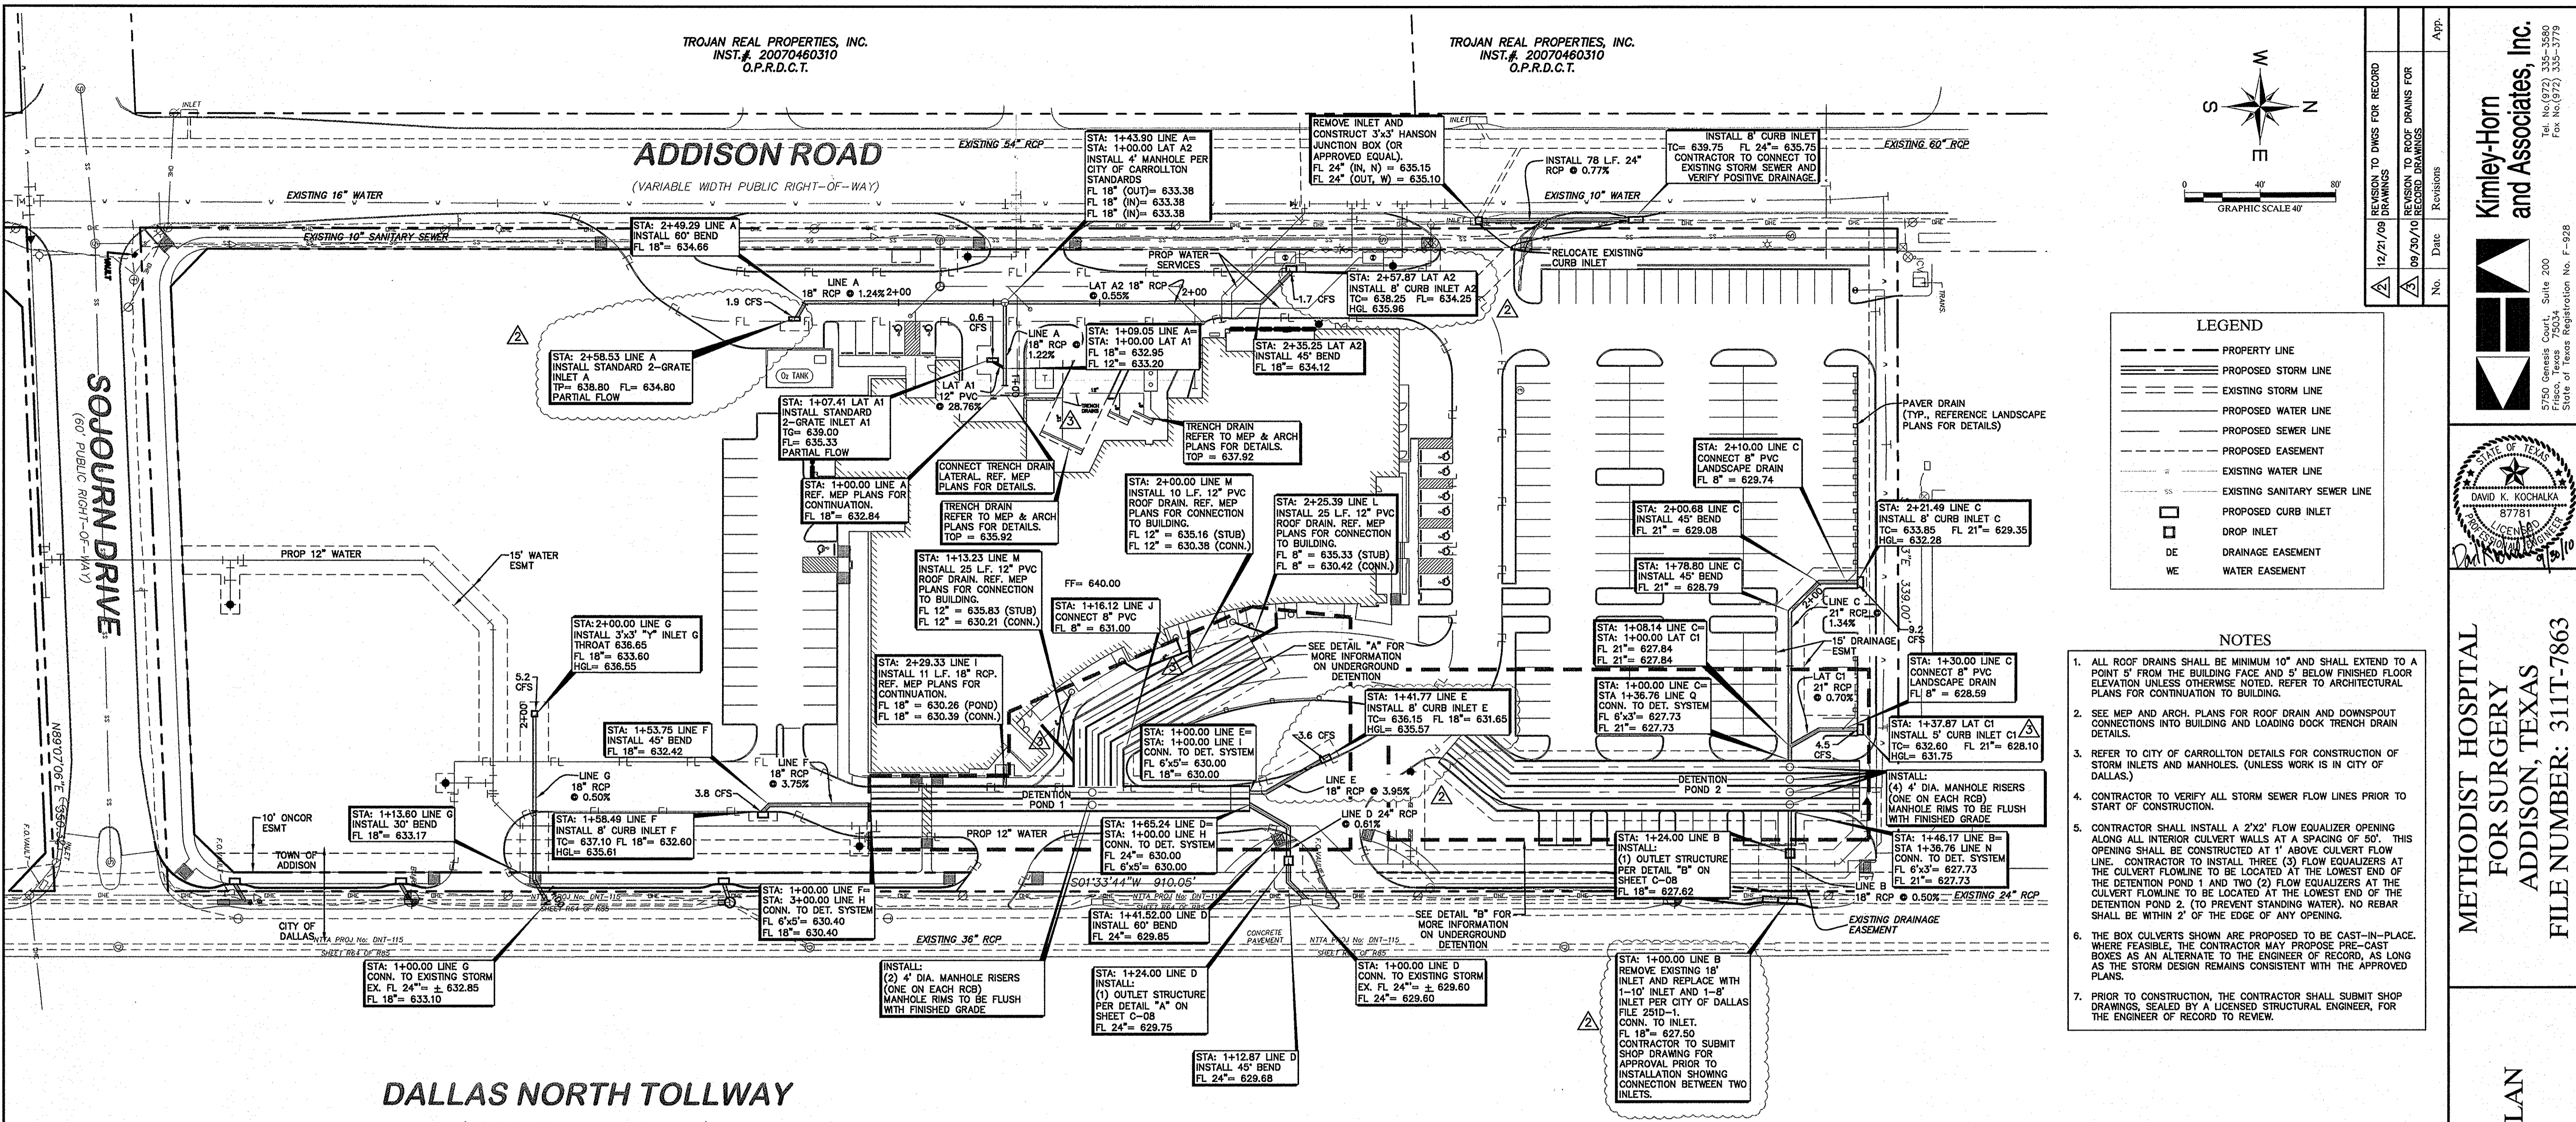

### LEGEND

- PROPERTY LINE
- PROPOSED STORM LINE
- EXISTING STORM LINE
- PROPOSED WATER LINE
- PROPOSED SEWER LINE
- PROPOSED EASEMENT
- EXISTING WATER LINE
- EXISTING SANITARY SEWER LINE
- PROPOSED CURB INLET
- DROP INLET
- DE DRAINAGE EASEMENT
- WE WATER EASEMENT

### NOTES

- ALL ROOF DRAINS SHALL BE MINIMUM 10" AND SHALL EXTEND TO A POINT 5' FROM THE BUILDING FACE AND 5' BELOW FINISHED FLOOR ELEVATION UNLESS OTHERWISE NOTED. REFER TO ARCHITECTURAL PLANS FOR CONTINUATION TO BUILDING.
- SEE MEP AND ARCH. PLANS FOR ROOF DRAIN AND DRENCH DRAIN CONNECTIONS INTO BUILDING AND LOADING DOCK TRENCH DRAIN DETAILS.
- REFER TO CITY OF CARROLLTON DETAILS FOR CONSTRUCTION OF STORM INLETS AND MANHOLES. (UNLESS WORK IS IN CITY OF DALLAS.)
- CONTRACTOR TO VERIFY ALL STORM SEWER FLOW LINES PRIOR TO START OF CONSTRUCTION.
- CONTRACTOR SHALL INSTALL A 2"x2" FLOW EQUALIZER OPENING ALONG ALL INTERIOR CURTAIN WALLS AT A SPACING OF 50'. THIS OPENING SHALL BE CONSTRUCTED AT 1' ABOVE CURTAIN FLOW LINE. CONTRACTOR TO INSTALL THREE (3) FLOW EQUALIZERS AT THE CURTAIN FLOWLINE TO BE LOCATED AT THE LOWEST END OF THE DETENTION POND 1 AND TWO (2) FLOW EQUALIZERS AT THE CURTAIN FLOWLINE TO BE LOCATED AT THE LOWEST END OF THE DETENTION POND 2. (TO PREVENT STANDING WATER). NO REBAR SHALL BE WITHIN 2' OF THE EDGE OF ANY OPENING.
- THE BOX CULVERTS SHOWN ARE PROPOSED TO BE CAST-IN-PLACE. WHERE FEASIBLE, THE CONTRACTOR MAY PROPOSE PRE-CAST BOXES AS AN ALTERNATE TO THE ENGINEER OF RECORD, AS LONG AS THE STORM DESIGN REMAINS CONSISTENT WITH THE APPROVED PLANS.
- PRIOR TO CONSTRUCTION, THE CONTRACTOR SHALL SUBMIT SHOP DRAWINGS, SEALED BY A LICENSED STRUCTURAL ENGINEER, FOR THE ENGINEER OF RECORD TO REVIEW.

### BENCHMARK

- "C" FOUND ON TOP OF THE CONCRETE BASE OF A LIGHT POLE IN THE CENTER MEDIAN OF EXCEL PARKWAY APPROXIMATELY 50 FEET WEST OF THE CENTERLINE OF ADDISON ROAD. (PER TOWN OF ADDISON PLAN # 96103, SHEET 2, DATED JANUARY 1998) ELEV=644.41
- BM #60" SET ON TOP OF A CONCRETE CURB INLET LOCATED ON THE WEST SIDE OF DALLAS PARKWAY APPROXIMATELY 826 FEET NORTH OF THE CENTERLINE OF SOJOURN DRIVE. ELEV=632.78
- BM #61" SET ON TOP OF A CONCRETE CURB INLET LOCATED ON THE WEST SIDE OF DALLAS PARKWAY APPROXIMATELY 160 FEET NORTH OF THE CENTERLINE OF SOJOURN DRIVE. ELEV=638.04

**RECORD DRAWINGS**  
**(SEPTEMBER 2010)**

INFORMATION PROVIDED BY:  
Rogers-O'Brien Construction Company


**STOP!**  
**CALL BEFORE YOU DIG**

DIG TESS  
1-800-DIG-TESS  
(at least 72 hours prior to digging)


THE CONTRACTOR SHALL FIELD VERIFY THE HORIZONTAL AND VERTICAL LOCATIONS OF ALL EXISTING UTILITIES PRIOR TO START OF CONSTRUCTION AND SHALL NOTIFY THE CONSTRUCTION MANAGER AND ENGINEER OF ANY CONFLICTS DISCOVERED. CONTRACTOR IS RESPONSIBLE FOR PROTECTING EXISTING UTILITIES (SHOWN OR NOT SHOWN) WITHIN SCOPE OF CONSTRUCTION. IF ANY EXISTING UTILITIES ARE DAMAGED, THE CONTRACTOR SHALL REPLACE THEM AT HIS OWN EXPENSE. CALL 1-800-DIG-TESS AT LEAST 72 HOURS PRIOR TO COMMENCING CONSTRUCTION IN VICINITY.

# DALLAS NORTH TOLLWAY

(VARIABLE WIDTH PUBLIC RIGHT-OF-WAY)

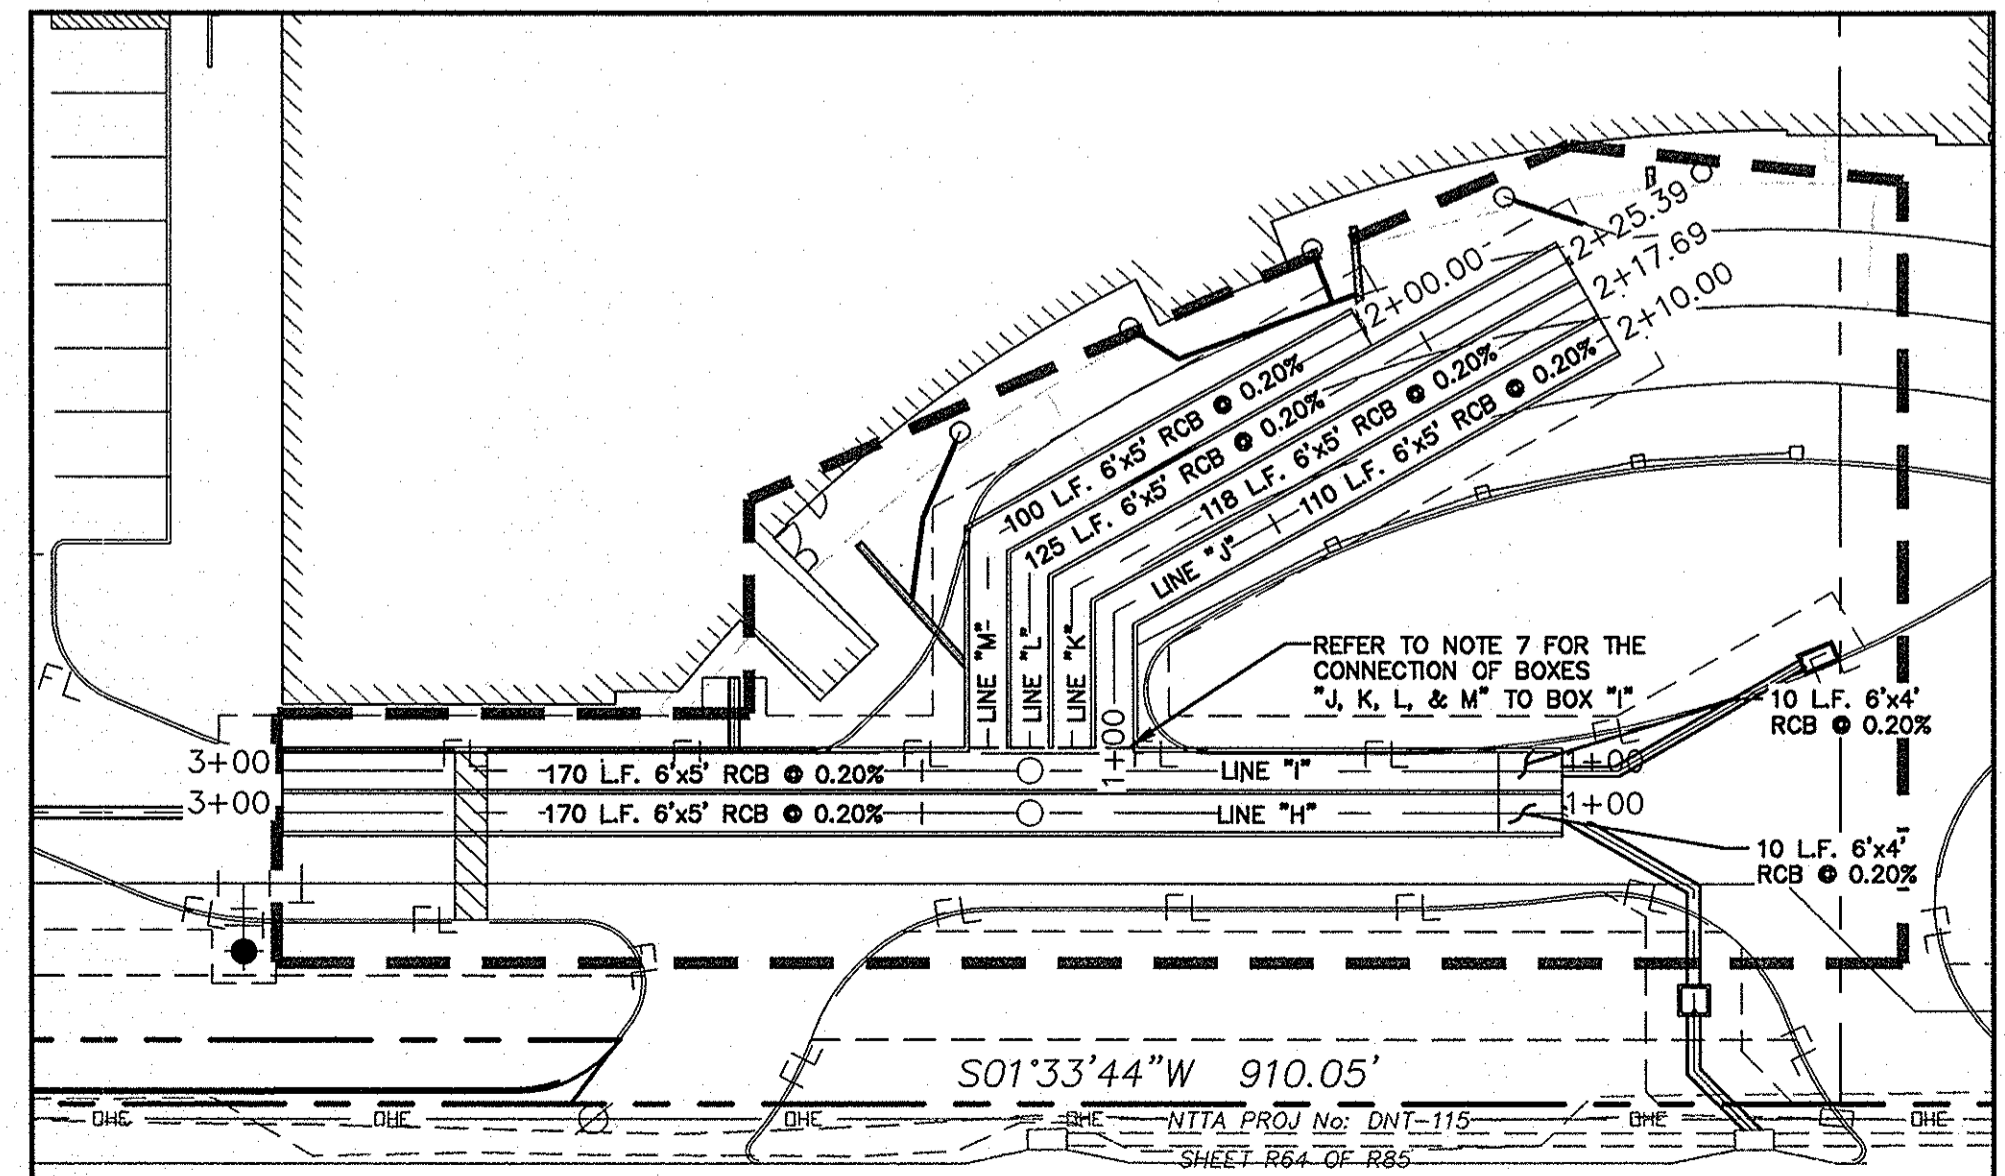

DETAIL A  
SCALE: 1"=30'

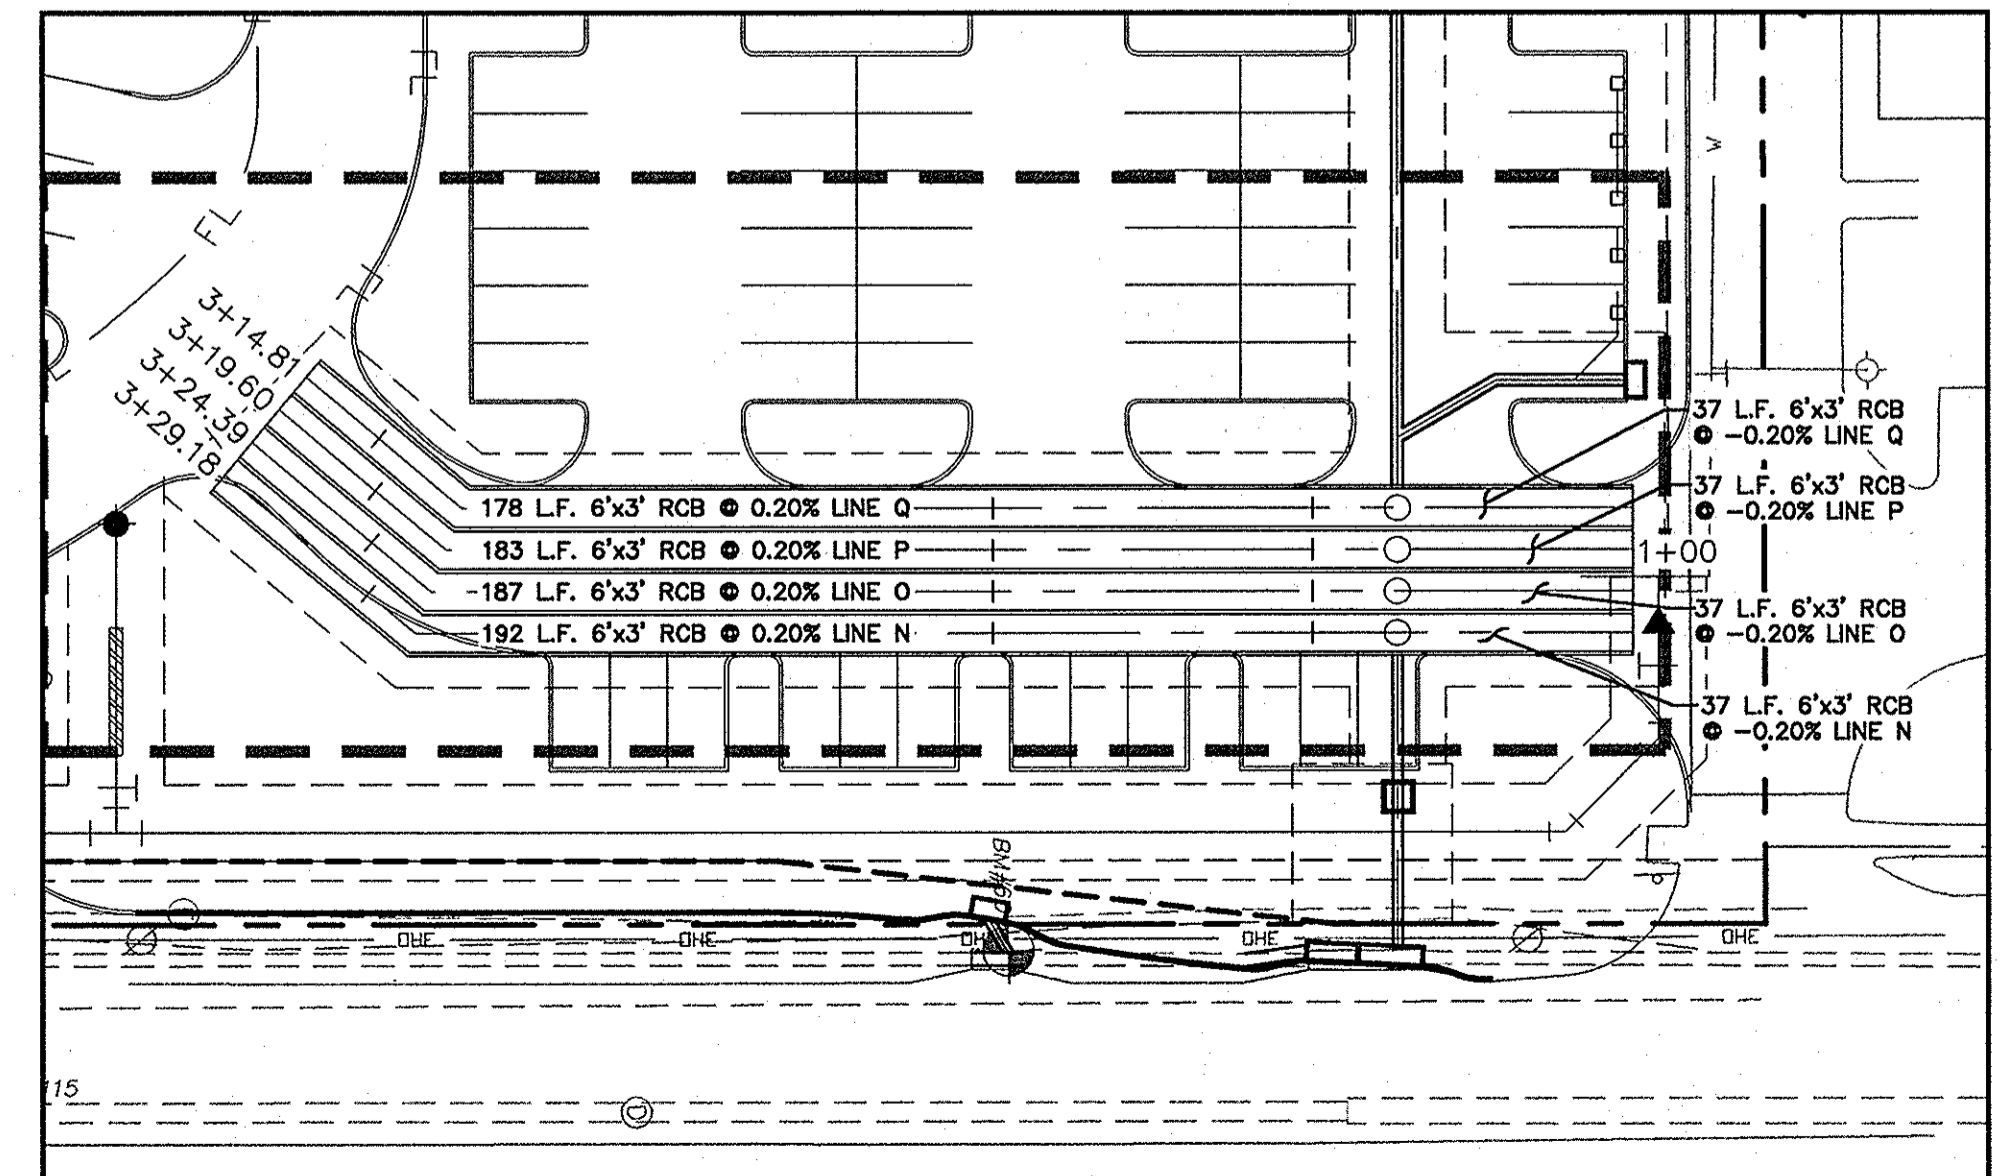

DETAIL B  
SCALE: 1"=30'

**Kimley-Horn and Associates, Inc.**

7530 Genesis Court, Suite 200  
Frisco, Texas 75034  
Tel. No. (972) 335-3580  
Fax No. (972) 335-3779

STATE OF TEXAS  
DAVID K. KOCHALKA  
87781  
REGISTERED PROFESSIONAL ENGINEER  
1991




METHODIST HOSPITAL  
FOR SURGERY  
ADDISON, TEXAS  
FILE NUMBER: 311T-7863

**STORM SEWER PLAN**

AS SHOWN  
Designed by: TB  
Drawn by: TB  
Checked by: DKK  
Date: 01/05/10  
Project No. 6902600

SHEET  
**C-09**

NITIA PROJ No. DNT-115  
 SHEET 08 OF 08  
 DATE: 09/20/10  
 DRAWN BY: TB  
 CHECKED BY: DKK  
 DATE: 01/05/10  
 PROJECT NO: 6902600

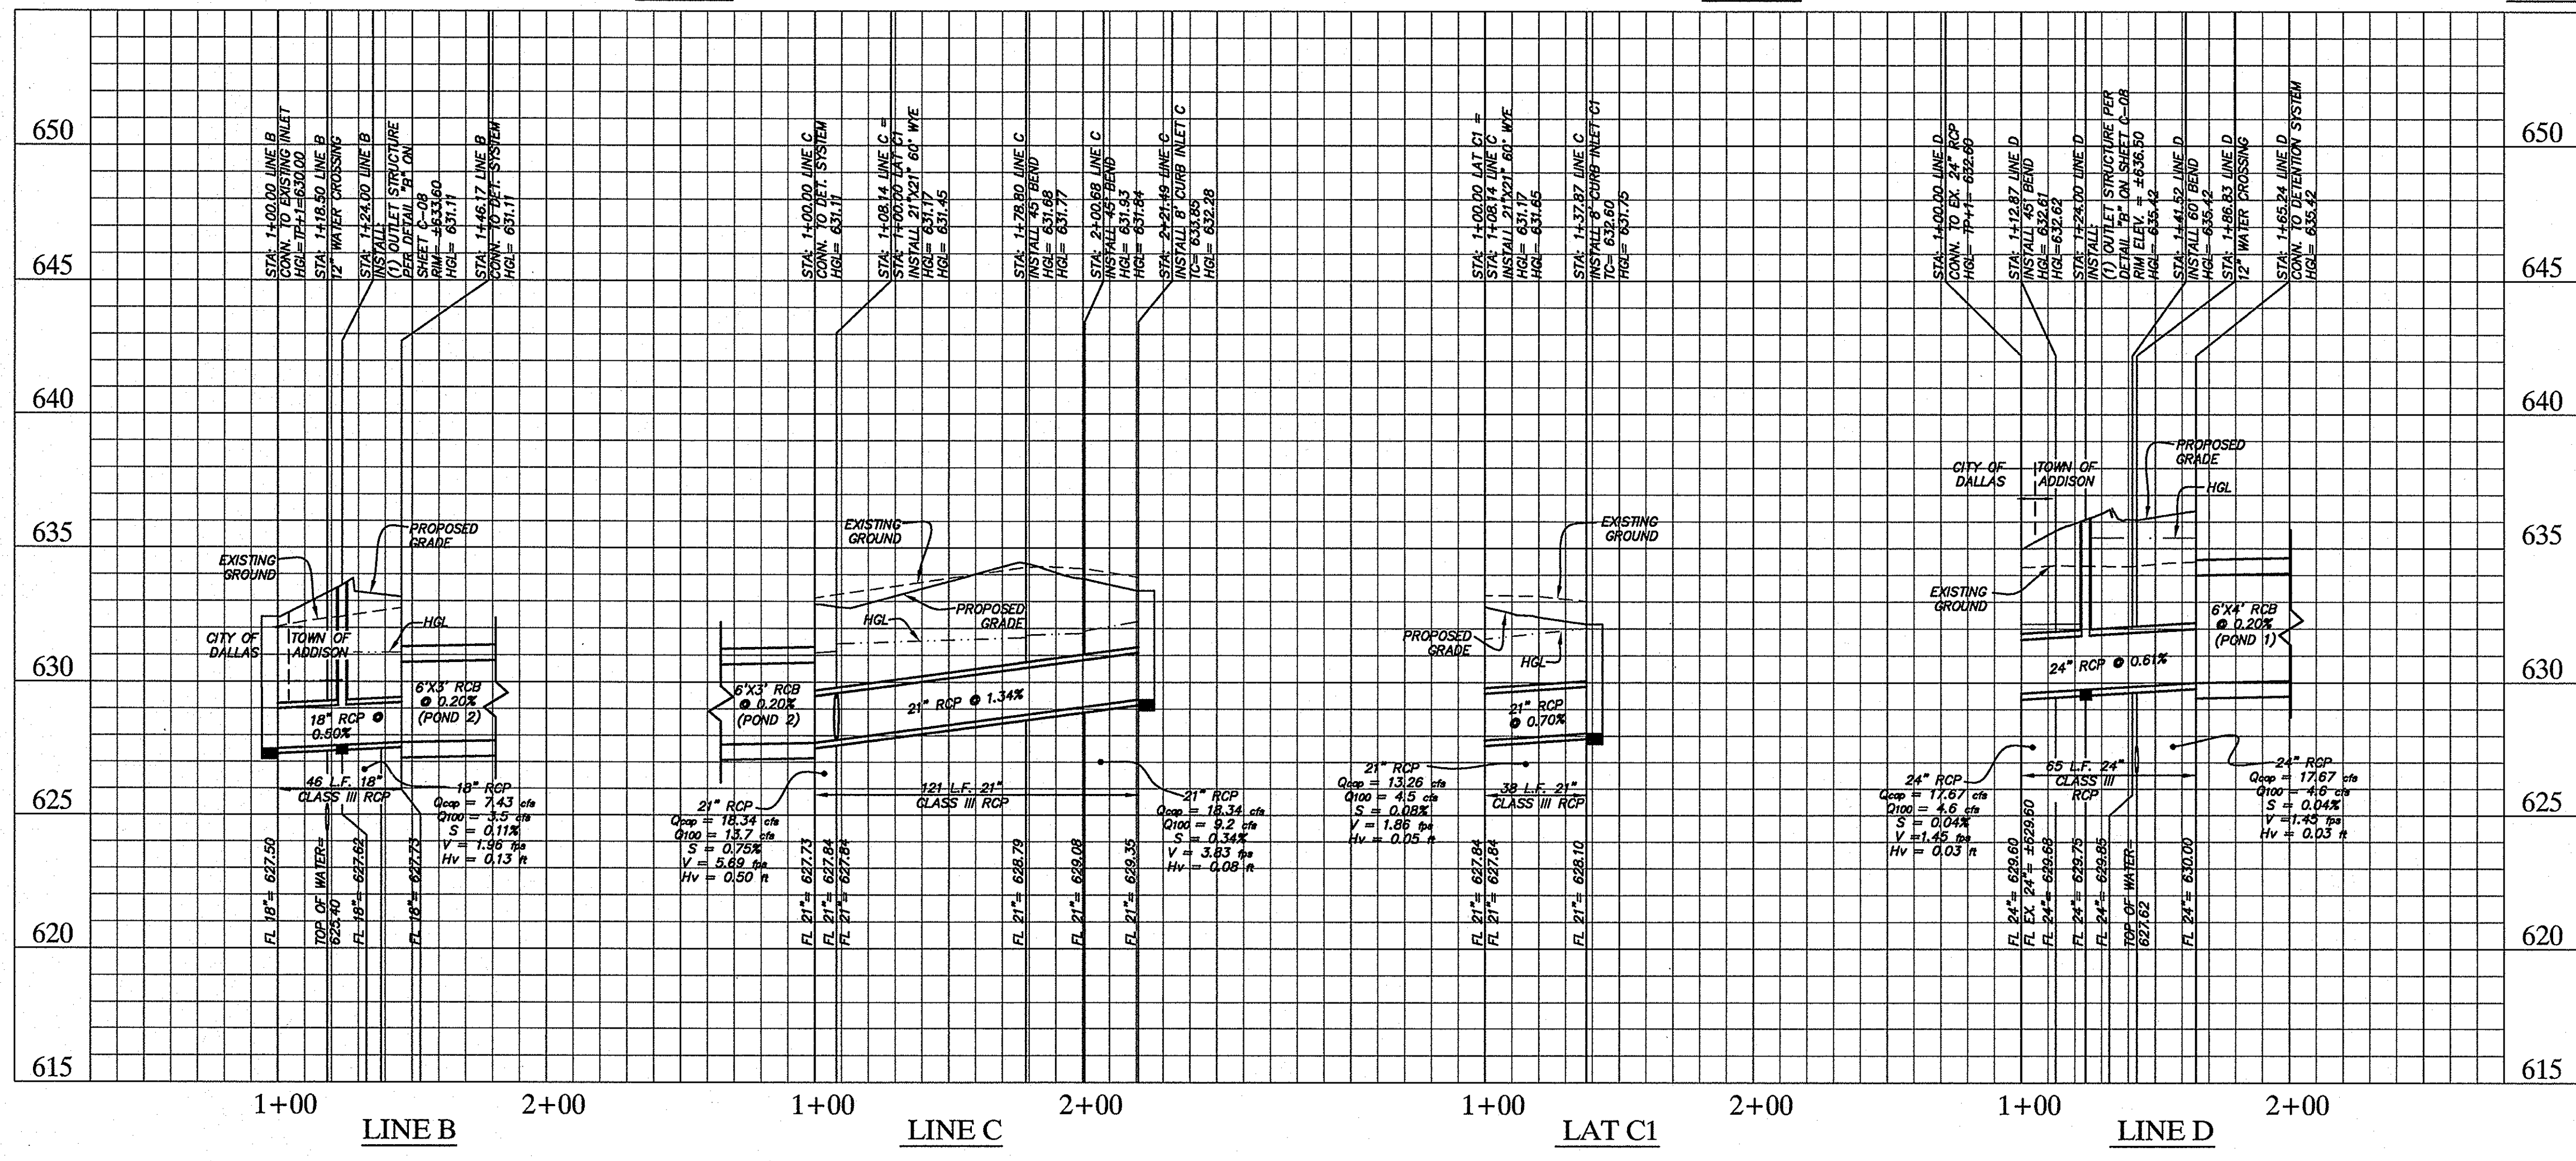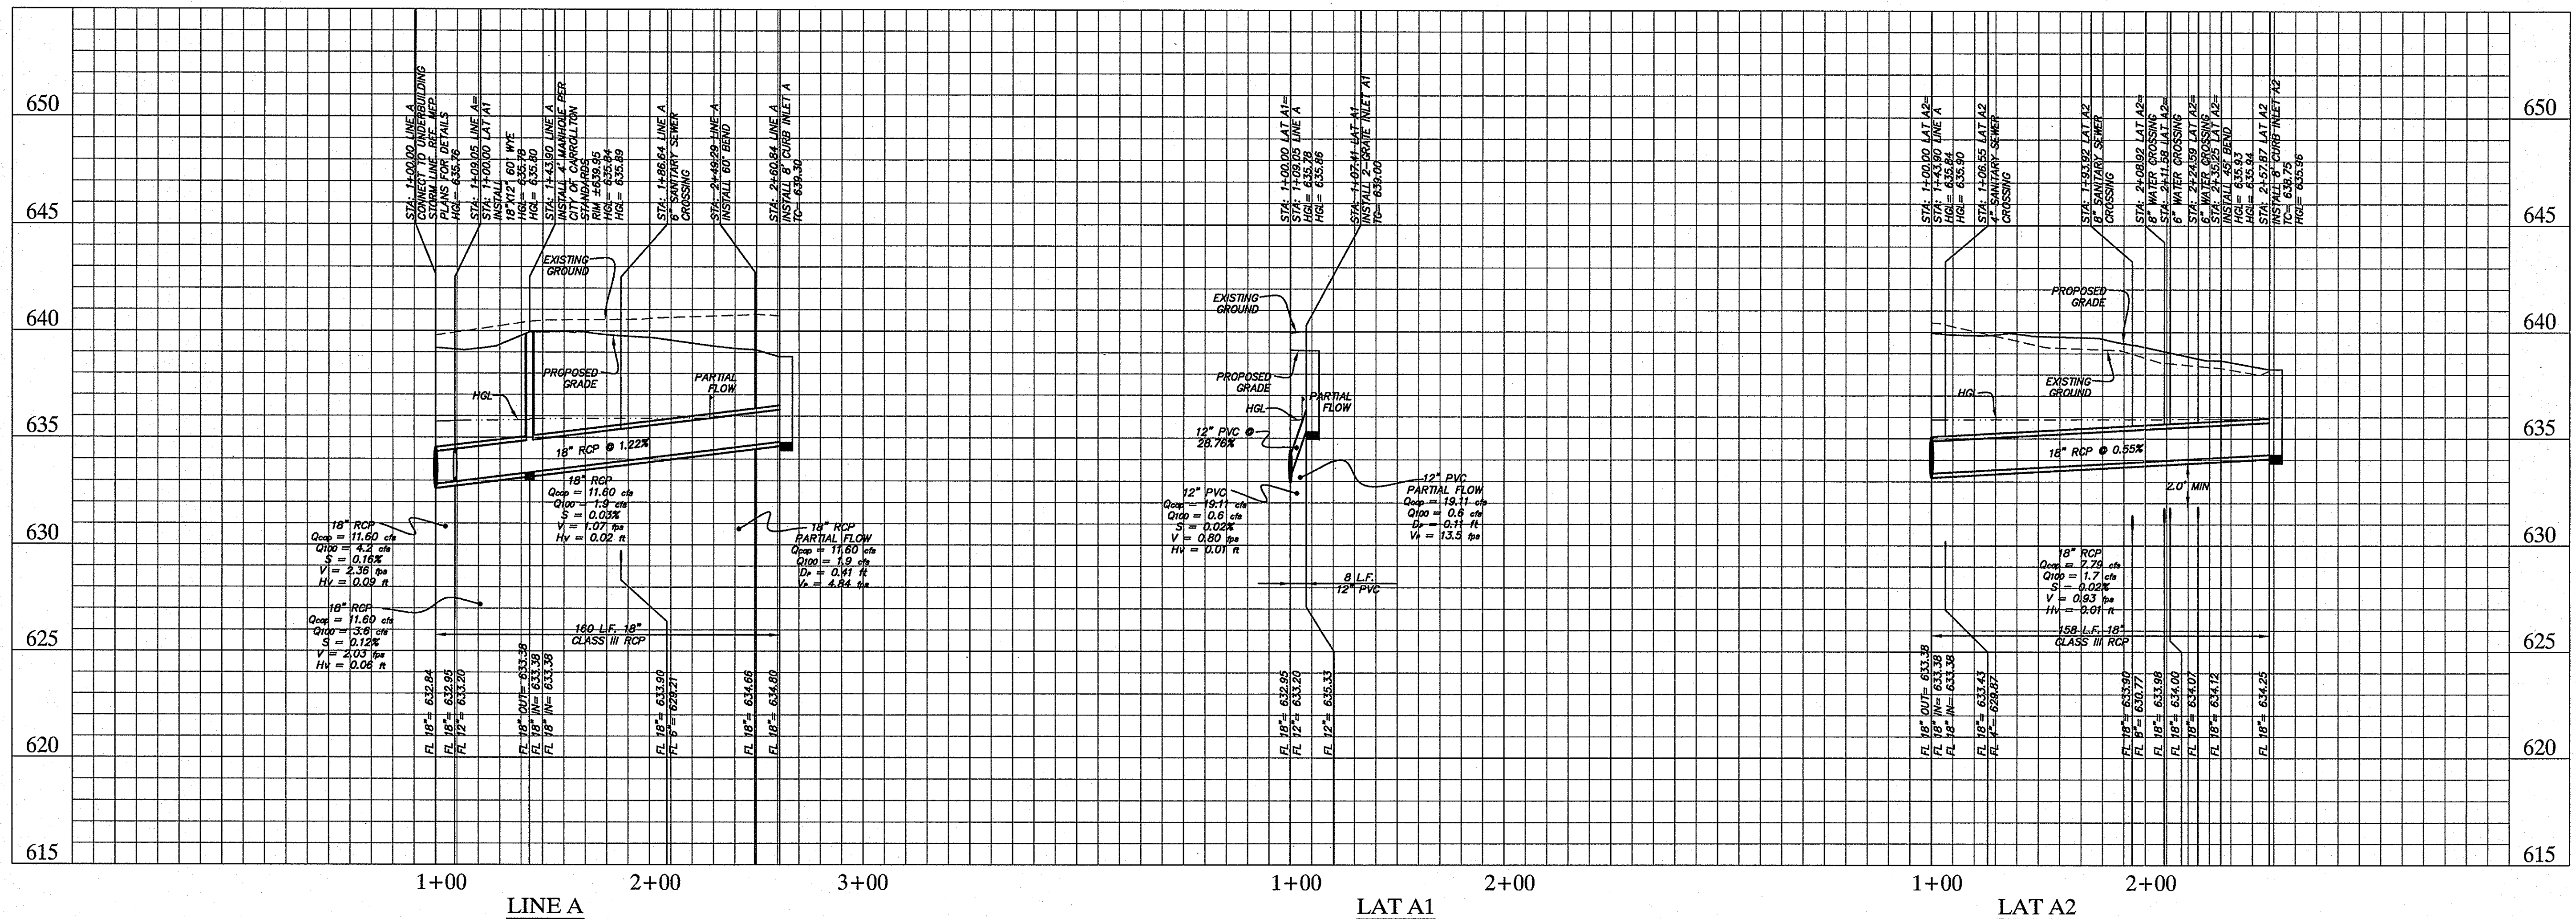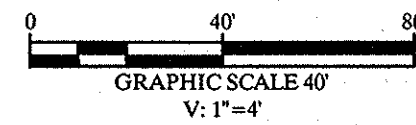

**RECORD DRAWINGS  
(SEPTEMBER 2010)**  
INFORMATION PROVIDED BY:  
Rogers-O'Brien Construction Company

- BENCHMARK**
- "1" FOUND ON TOP OF THE CONCRETE BASE OF A LIGHT POLE IN THE CENTER MEDIAN OF EXCEL PARKWAY APPROXIMATELY 50 FEET WEST OF THE CENTERLINE OF ADDISON ROAD. (PER TOWN OF ADDISON PLAN # 96103, SHEET 2, DATED JANUARY 1998) ELEV=644.41
  - BM #60" SET ON TOP OF A CONCRETE CURB INLET LOCATED ON THE WEST SIDE OF DALLAS PARKWAY APPROXIMATELY 826 FEET NORTH OF THE CENTERLINE OF SOJOURN DRIVE. ELEV=632.78
  - BM #61" SET ON TOP OF A CONCRETE CURB INLET LOCATED ON THE WEST SIDE OF DALLAS PARKWAY APPROXIMATELY 160 FEET NORTH OF THE CENTERLINE OF SOJOURN DRIVE. ELEV=638.04

App.	
No.	Revisions
Date	

**Kimley-Horn and Associates, Inc.**  
Tel. No. (972) 335-3580  
Ft. Worth, Texas 76104  
Fax No. (972) 335-3779

5750 Genesis Court, Suite 200  
Ft. Worth, Texas 76104  
State of Texas Registration No. E-628





**METHODIST HOSPITAL FOR SURGERY  
ADDISON, TEXAS  
FILE NUMBER: 311T-7863**

**STORM SEWER PROFILES**

Scale	AS SHOWN
Designed by	TNB
Drawn by	RCC
Checked by	DMK
Date	11/0/09
Project No.	6902500

SHEET  
**C-10**

DATE PLOTTED: 11/02/09 10:54 AM  
PLOT NAME: C:\PROJECTS\6902500\METHODIST\_ADDISON\WORK\PLANSET\STRM\PROF.DWG  
DWG NO.: 6902500-STRM-PROF.DWG

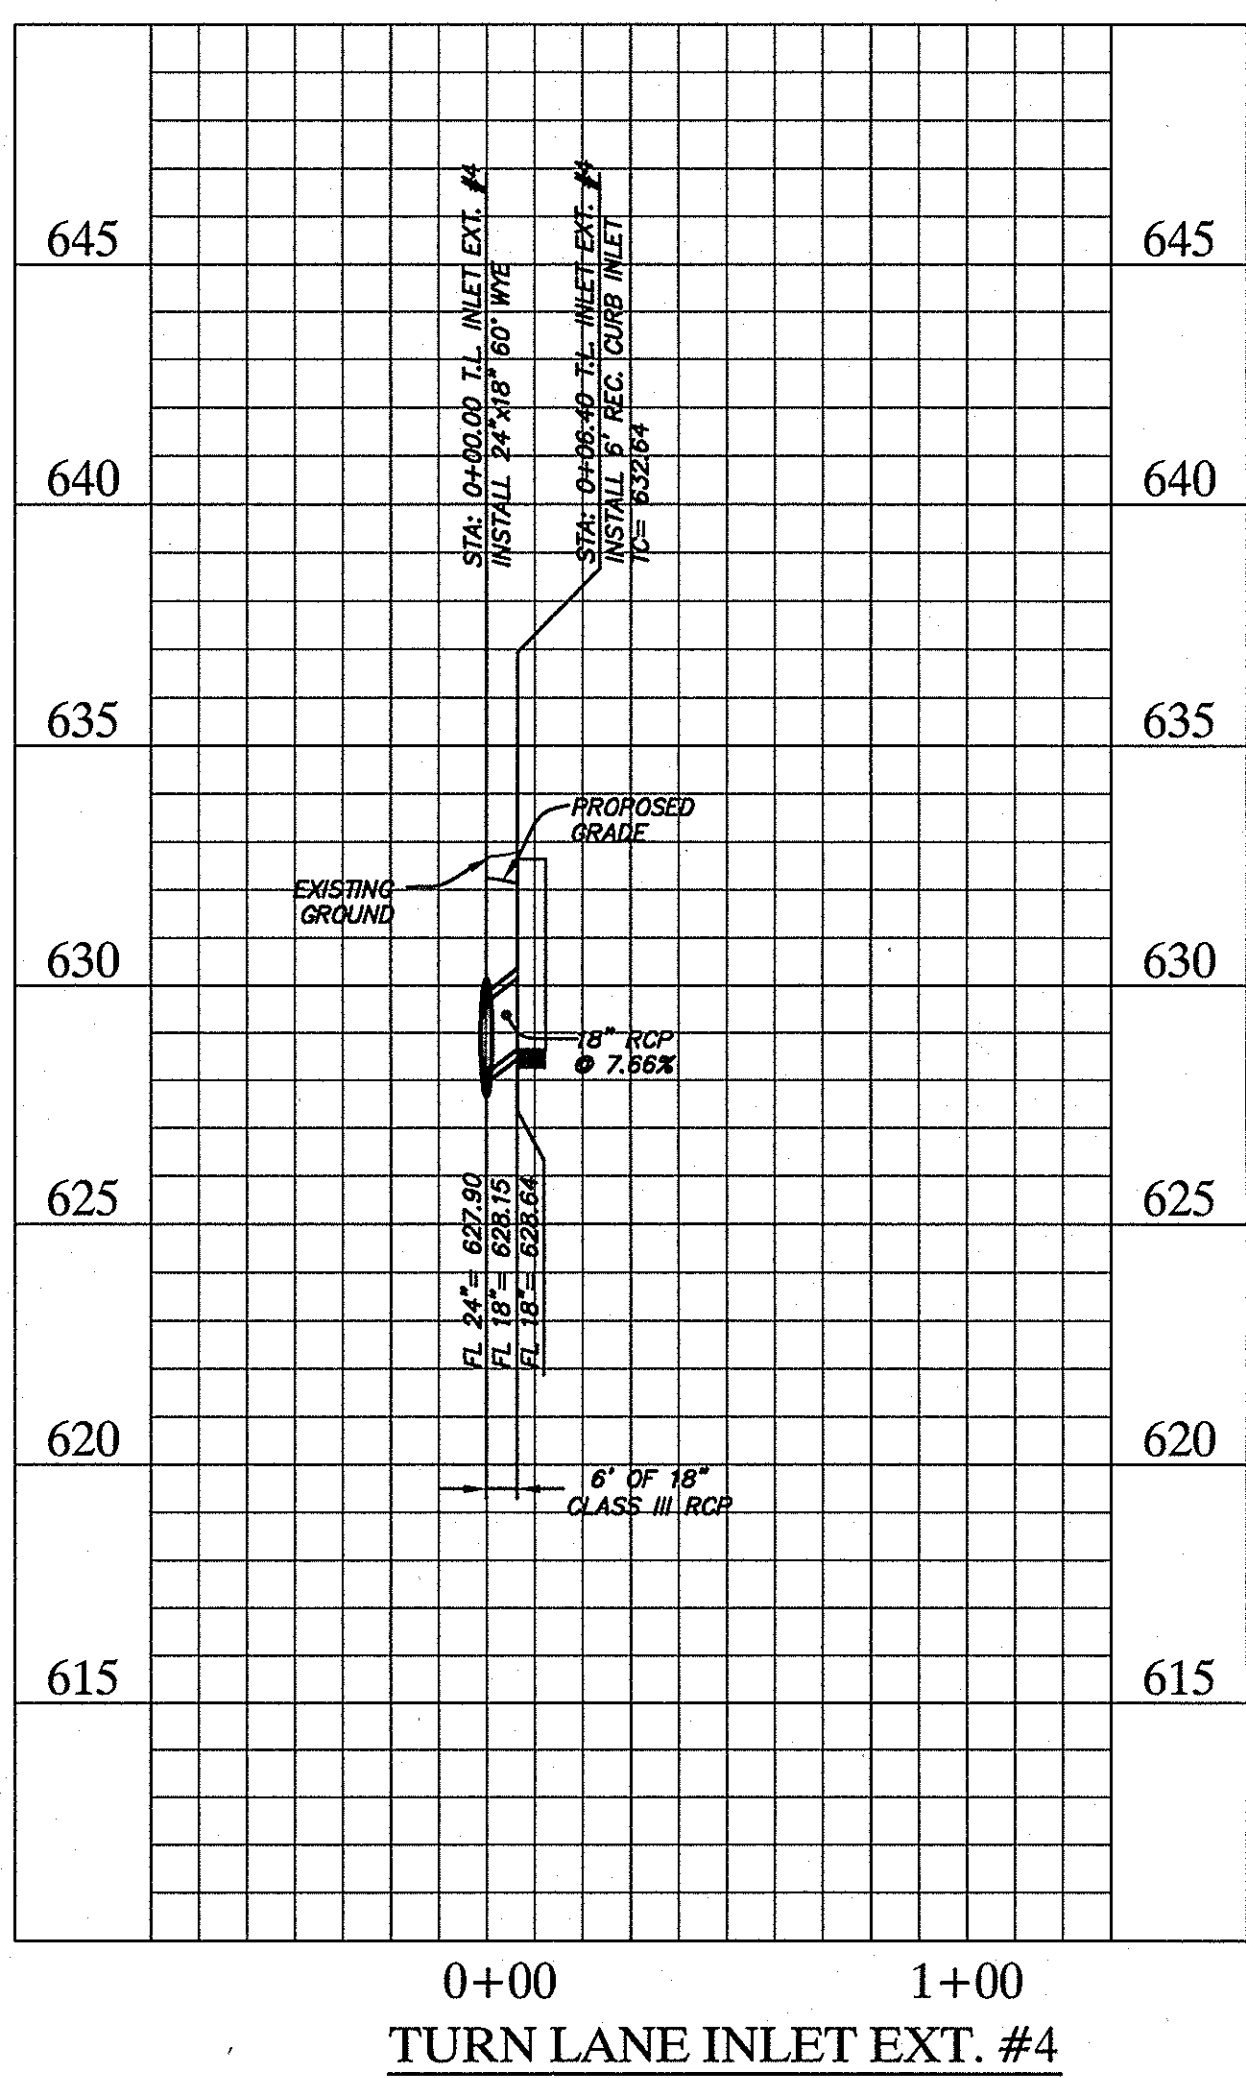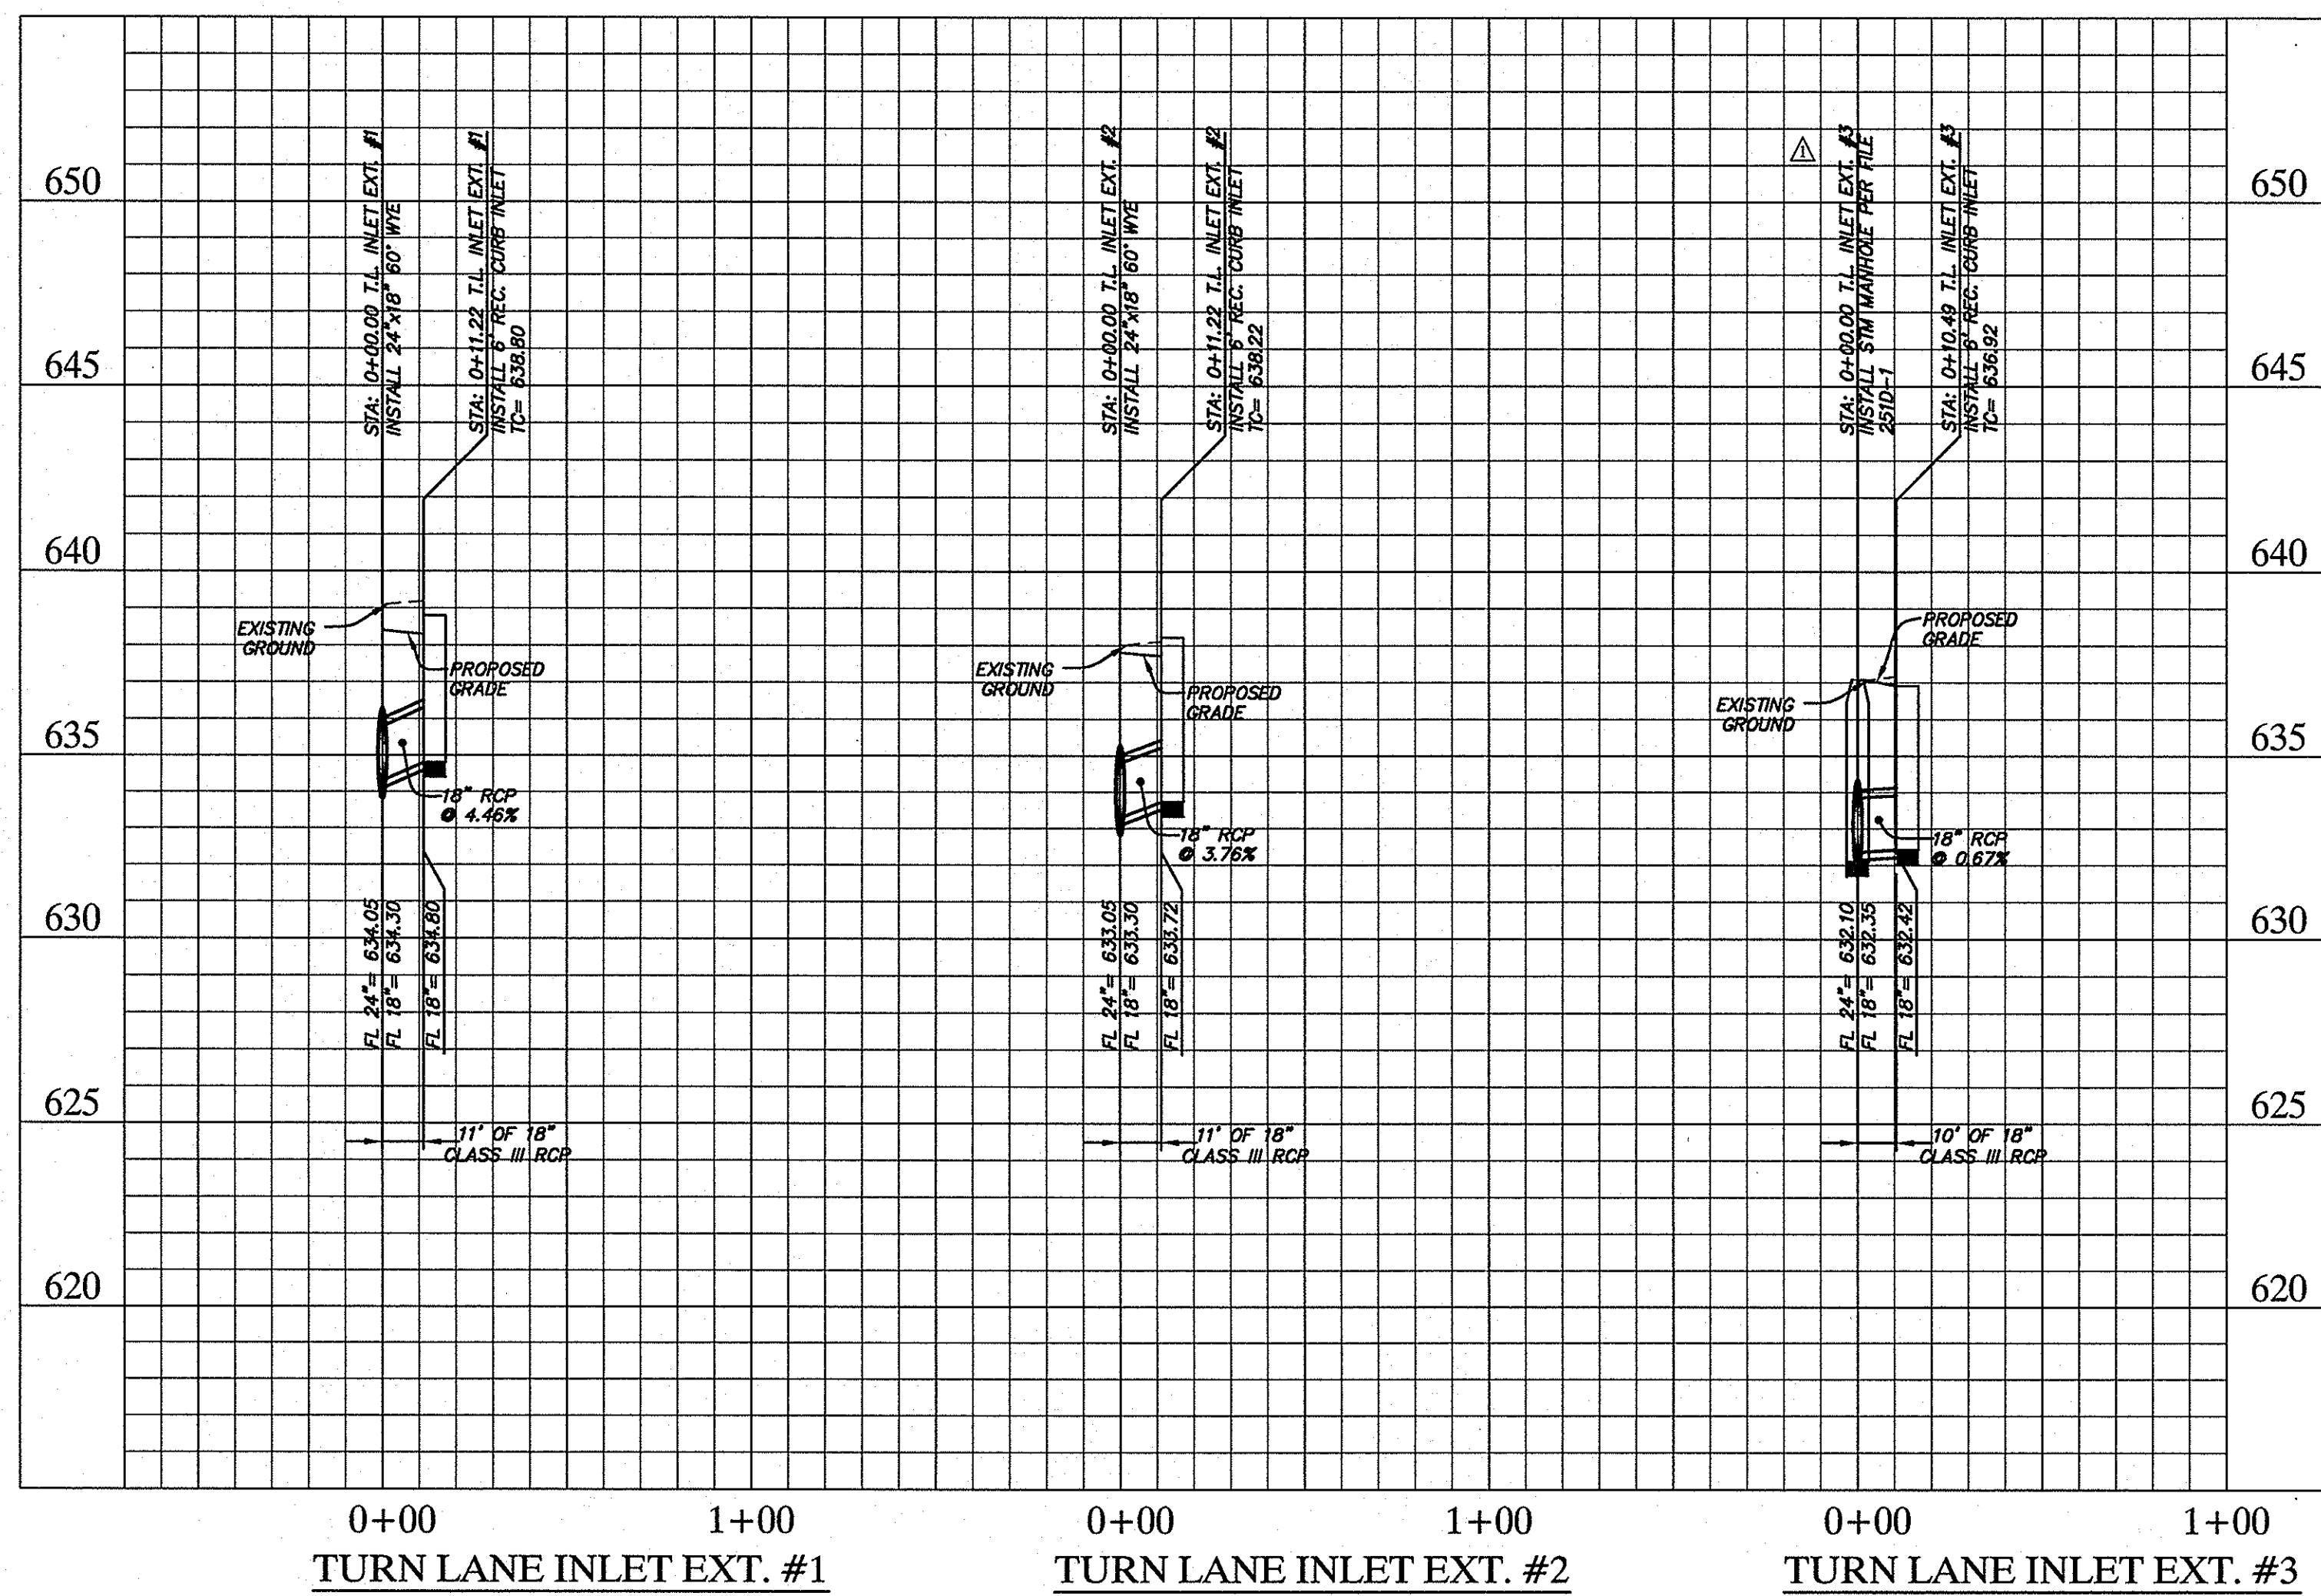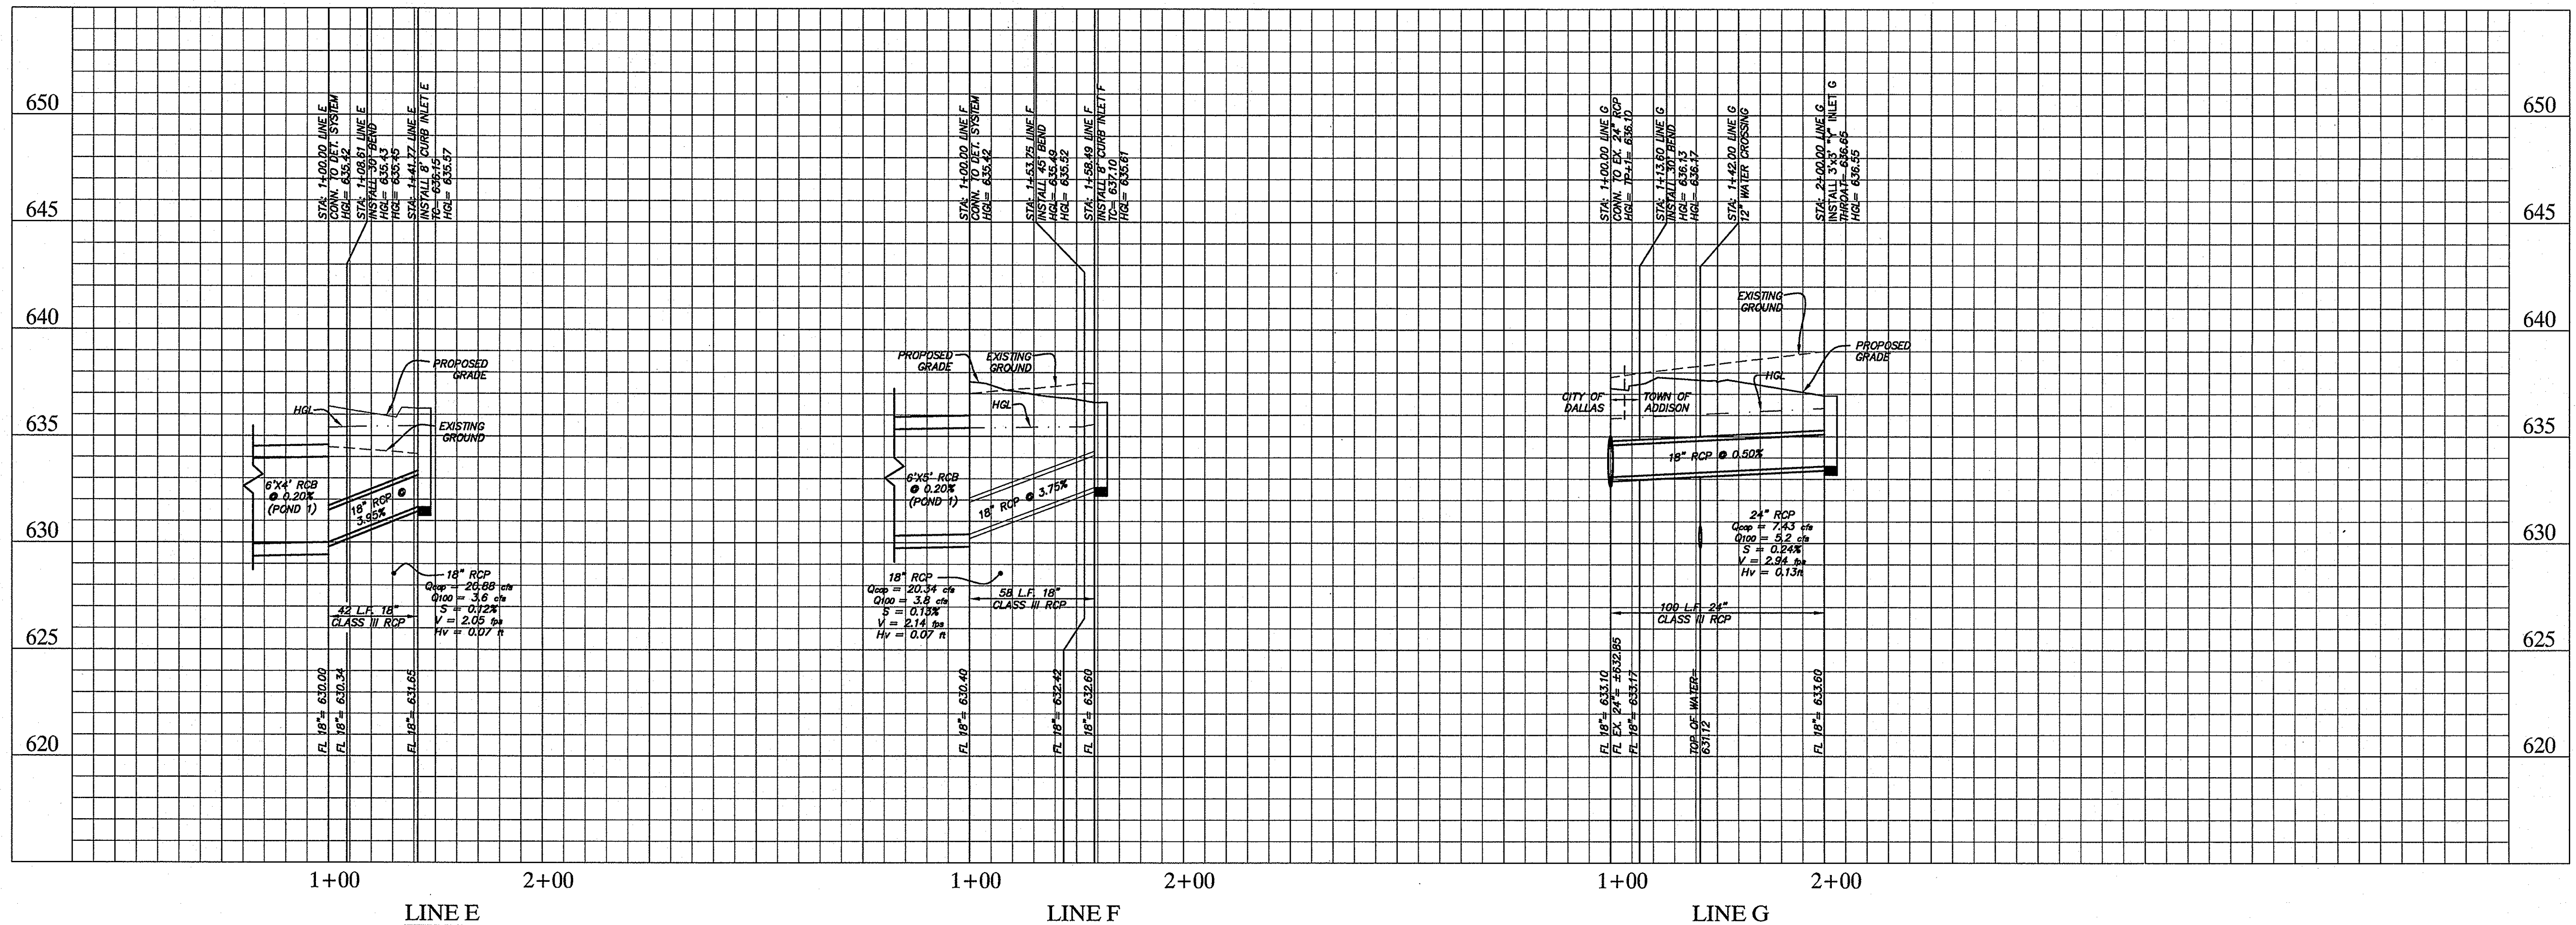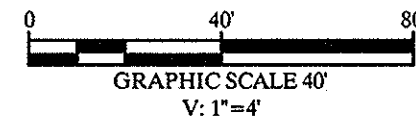

**RECORD DRAWINGS  
(SEPTEMBER 2010)**

INFORMATION PROVIDED BY:  
Rogers-O'Brien Construction Company


**BENCHMARK**

- "□" FOUND ON TOP OF THE CONCRETE BASE OF A LIGHT POLE IN THE CENTER MEDIAN OF EXCEL PARKWAY APPROXIMATELY 50 FEET WEST OF THE CENTERLINE OF ADDISON ROAD. (PER TOWN OF ADDISON PLAN # 96103, SHEET 2, DATED JANUARY 1998) ELEV=644.41
- BM #60" SET ON TOP OF A CONCRETE CURB INLET LOCATED ON THE WEST SIDE OF DALLAS PARKWAY APPROXIMATELY 825 FEET NORTH OF THE CENTERLINE OF SOJOURN DRIVE. ELEV=632.78
- BM #61" SET ON TOP OF A CONCRETE CURB INLET LOCATED ON THE WEST SIDE OF DALLAS PARKWAY APPROXIMATELY 160 FEET NORTH OF THE CENTERLINE OF SOJOURN DRIVE. ELEV=638.04

App. \_\_\_\_\_

No. \_\_\_\_\_ Date \_\_\_\_\_ Revisions \_\_\_\_\_

**Kimley-Horn and Associates, Inc.**  
Tel. No. (972) 335-3580  
Fax No. (972) 335-3779

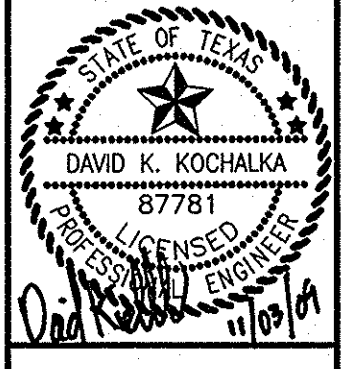




**METHODIST HOSPITAL  
FOR SURGERY  
ADDISON, TEXAS**

FILE NUMBER: 311T-7863

**STORM SEWER PROFILES**

Scale:	AS SHOWN
Designed by:	TNB
Drawn by:	RCC
Checked by:	DKK
Date:	11/09
Project No.:	6902500
SHEET	
C-11	

IMAGES: WBS, WBS, WBS, WBS  
 PLOTTED BY: BRUSWELL, TERRY, 11/09/09 2:41 PM  
 DWG NAME: K:\BTL\CIVIL\6902500 - METHODIST - ADDISON\DWG\PLANSET\STRM\PROF.DWG  
 PLOT DATE: 11/20/09 2:27:50

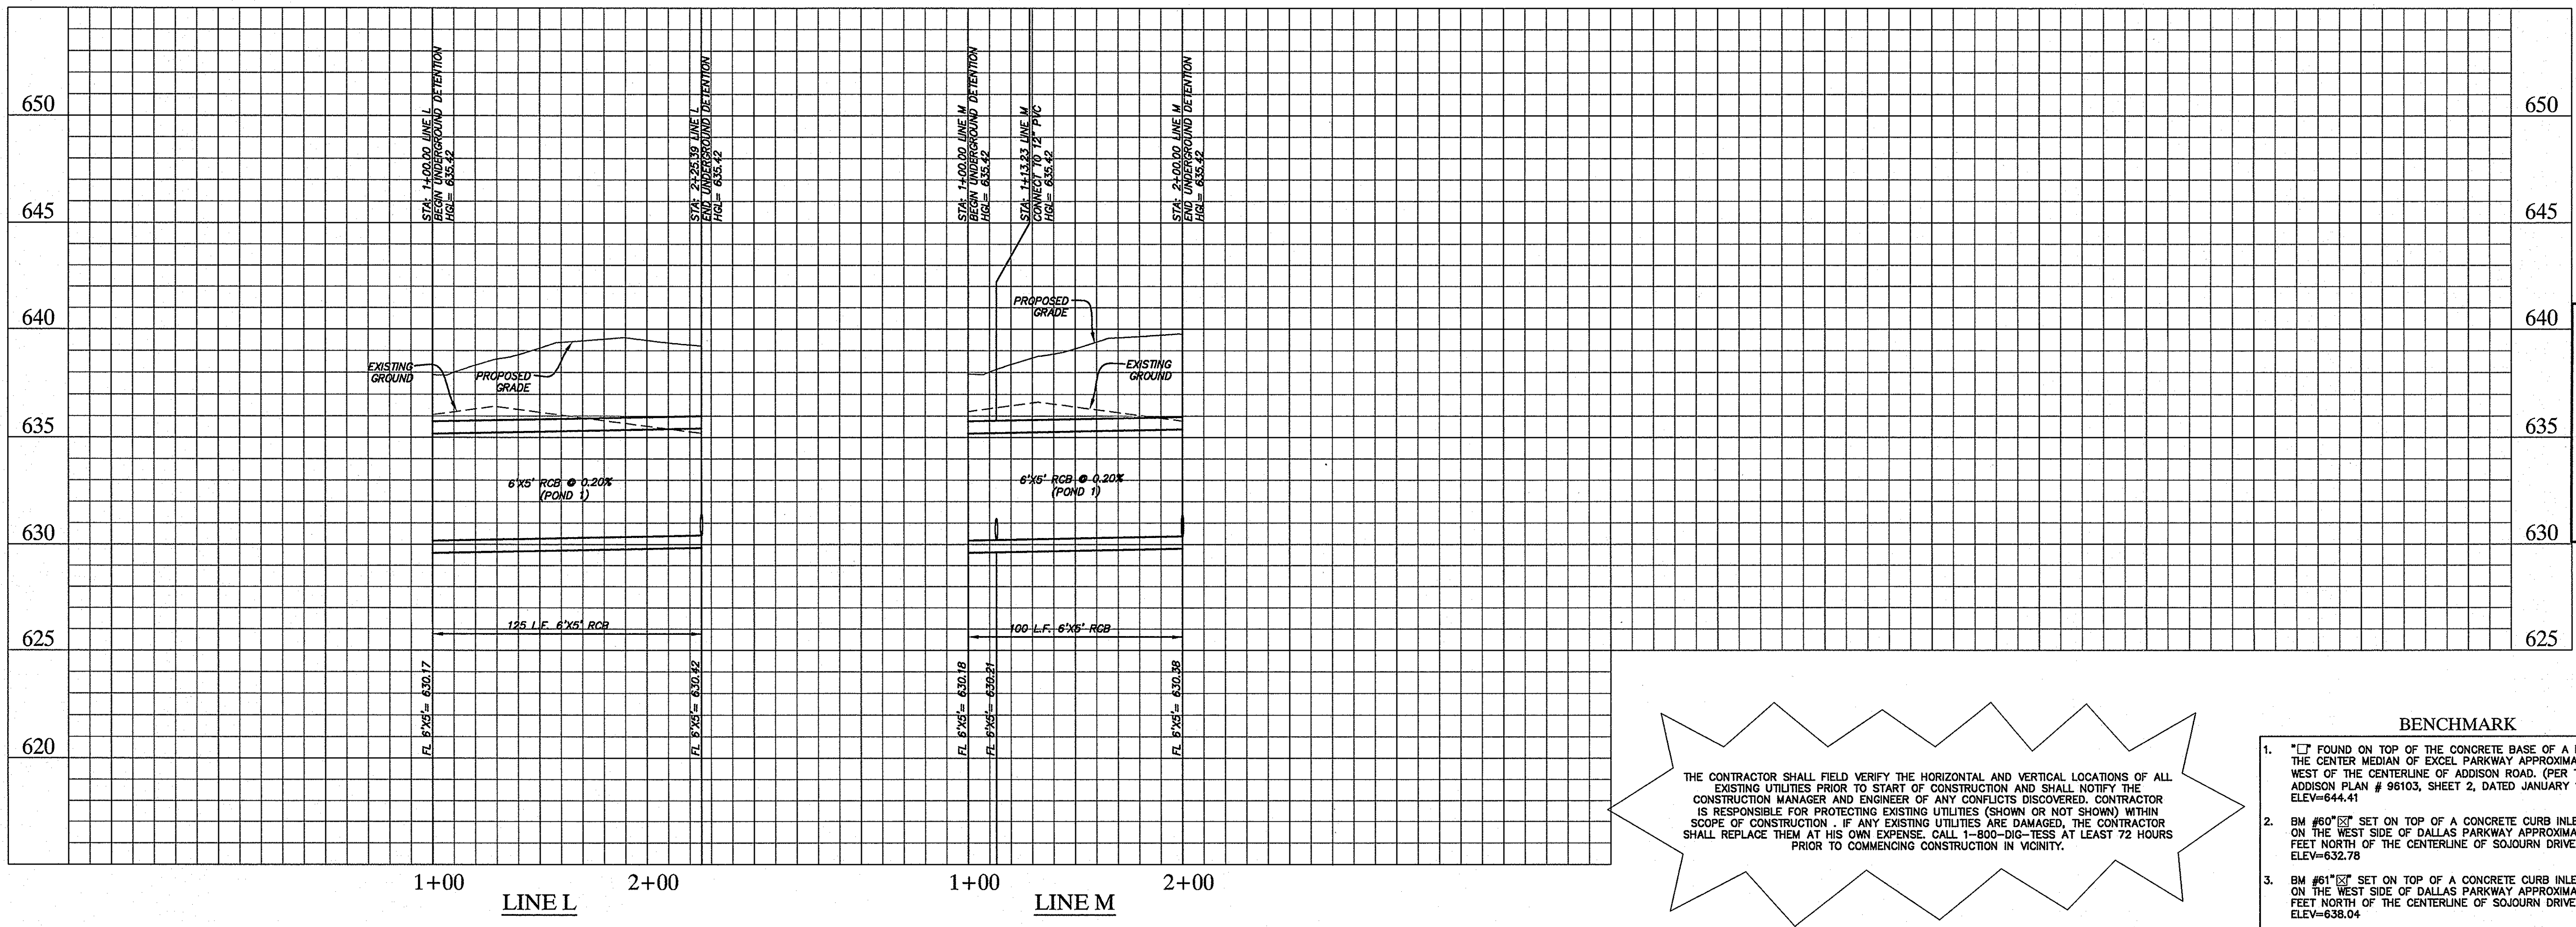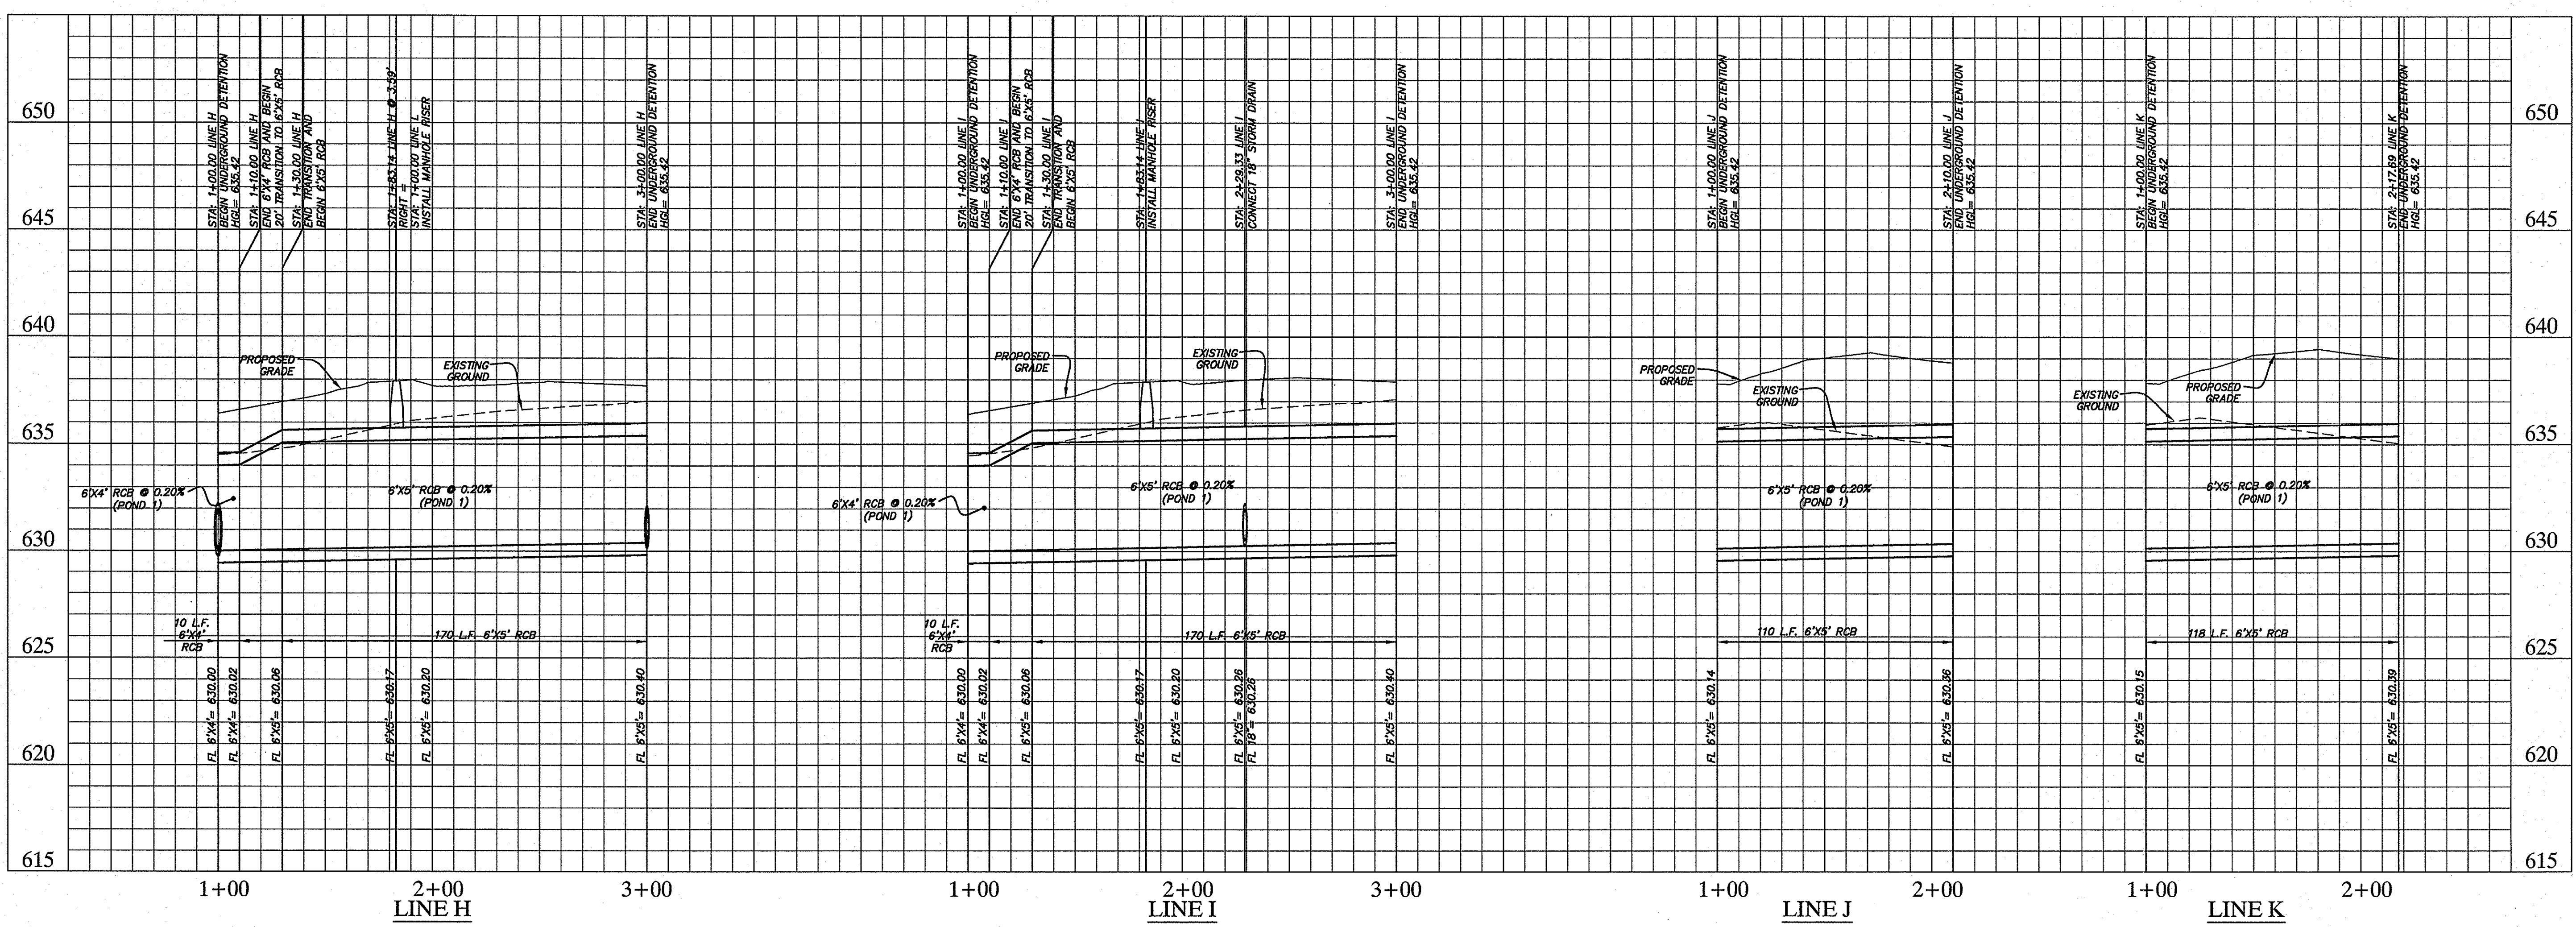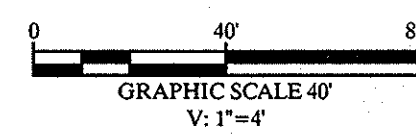


THE CONTRACTOR SHALL FIELD VERIFY THE HORIZONTAL AND VERTICAL LOCATIONS OF ALL EXISTING UTILITIES PRIOR TO START OF CONSTRUCTION AND SHALL NOTIFY THE CONSTRUCTION MANAGER AND ENGINEER OF ANY CONFLICTS DISCOVERED. CONTRACTOR IS RESPONSIBLE FOR PROTECTING EXISTING UTILITIES (SHOWN OR NOT SHOWN) WITHIN SCOPE OF CONSTRUCTION. IF ANY EXISTING UTILITIES ARE DAMAGED, THE CONTRACTOR SHALL REPLACE THEM AT HIS OWN EXPENSE. CALL 1-800-DIG-TESS AT LEAST 72 HOURS PRIOR TO COMMENCING CONSTRUCTION IN VICINITY.

- BENCHMARK**
- "□" FOUND ON TOP OF THE CONCRETE BASE OF A LIGHT POLE IN THE CENTER MEDIAN OF EXCEL PARKWAY APPROXIMATELY 50 FEET WEST OF THE CENTERLINE OF ADDISON ROAD. (PER TOWN OF ADDISON PLAN # 98103, SHEET 2, DATED JANUARY 1998) ELEV=644.41
  - BM #60" SET ON TOP OF A CONCRETE CURB INLET LOCATED ON THE WEST SIDE OF DALLAS PARKWAY APPROXIMATELY 626 FEET NORTH OF THE CENTERLINE OF SOJOURN DRIVE. ELEV=632.78
  - BM #61" SET ON TOP OF A CONCRETE CURB INLET LOCATED ON THE WEST SIDE OF DALLAS PARKWAY APPROXIMATELY 160 FEET NORTH OF THE CENTERLINE OF SOJOURN DRIVE. ELEV=638.04

No.	Date	Revisions

**Kimley-Horn and Associates, Inc.**  
 5750 Genesis Court, Suite 200  
 Frisco, Texas 75034  
 Tel. No. (972) 335-3880  
 Fax No. (972) 335-3779

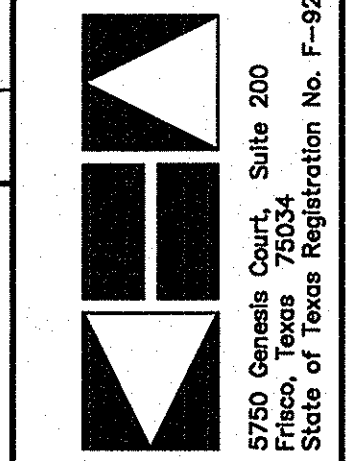

**METHODIST HOSPITAL FOR SURGERY**  
 ADDISON, TEXAS  
 FILE NUMBER: 311T-7863

**RECORD DRAWINGS (SEPTEMBER 2010)**  
 INFORMATION PROVIDED BY:  
 Rogers-O'Brien Construction Company




**DETENTION PROFILES**

Scale:	AS SHOWN
Designed by:	TNB
Drawn by:	RCO
Checked by:	DNK
Date:	11/08/09
Project No.:	6902500

**SHEET C-12**


IMAGES XREFED BY K:\E\1\C\1\03\0506 - METHODIST - ADDISON\DWG\PLAN\SET\STRM-PROP-DET.DWG LAST SAVED: 11/20/09 10:30 AM

IMAGES  
 DATE: 08/11/2010 11:00:00 AM  
 PLOTTED BY: KIRIL CIVIL/08/11/2010 11:00:00 AM  
 DWG NAME: 112507-02.DWG  
 PLOT DATE: 11/20/09 09:20:04

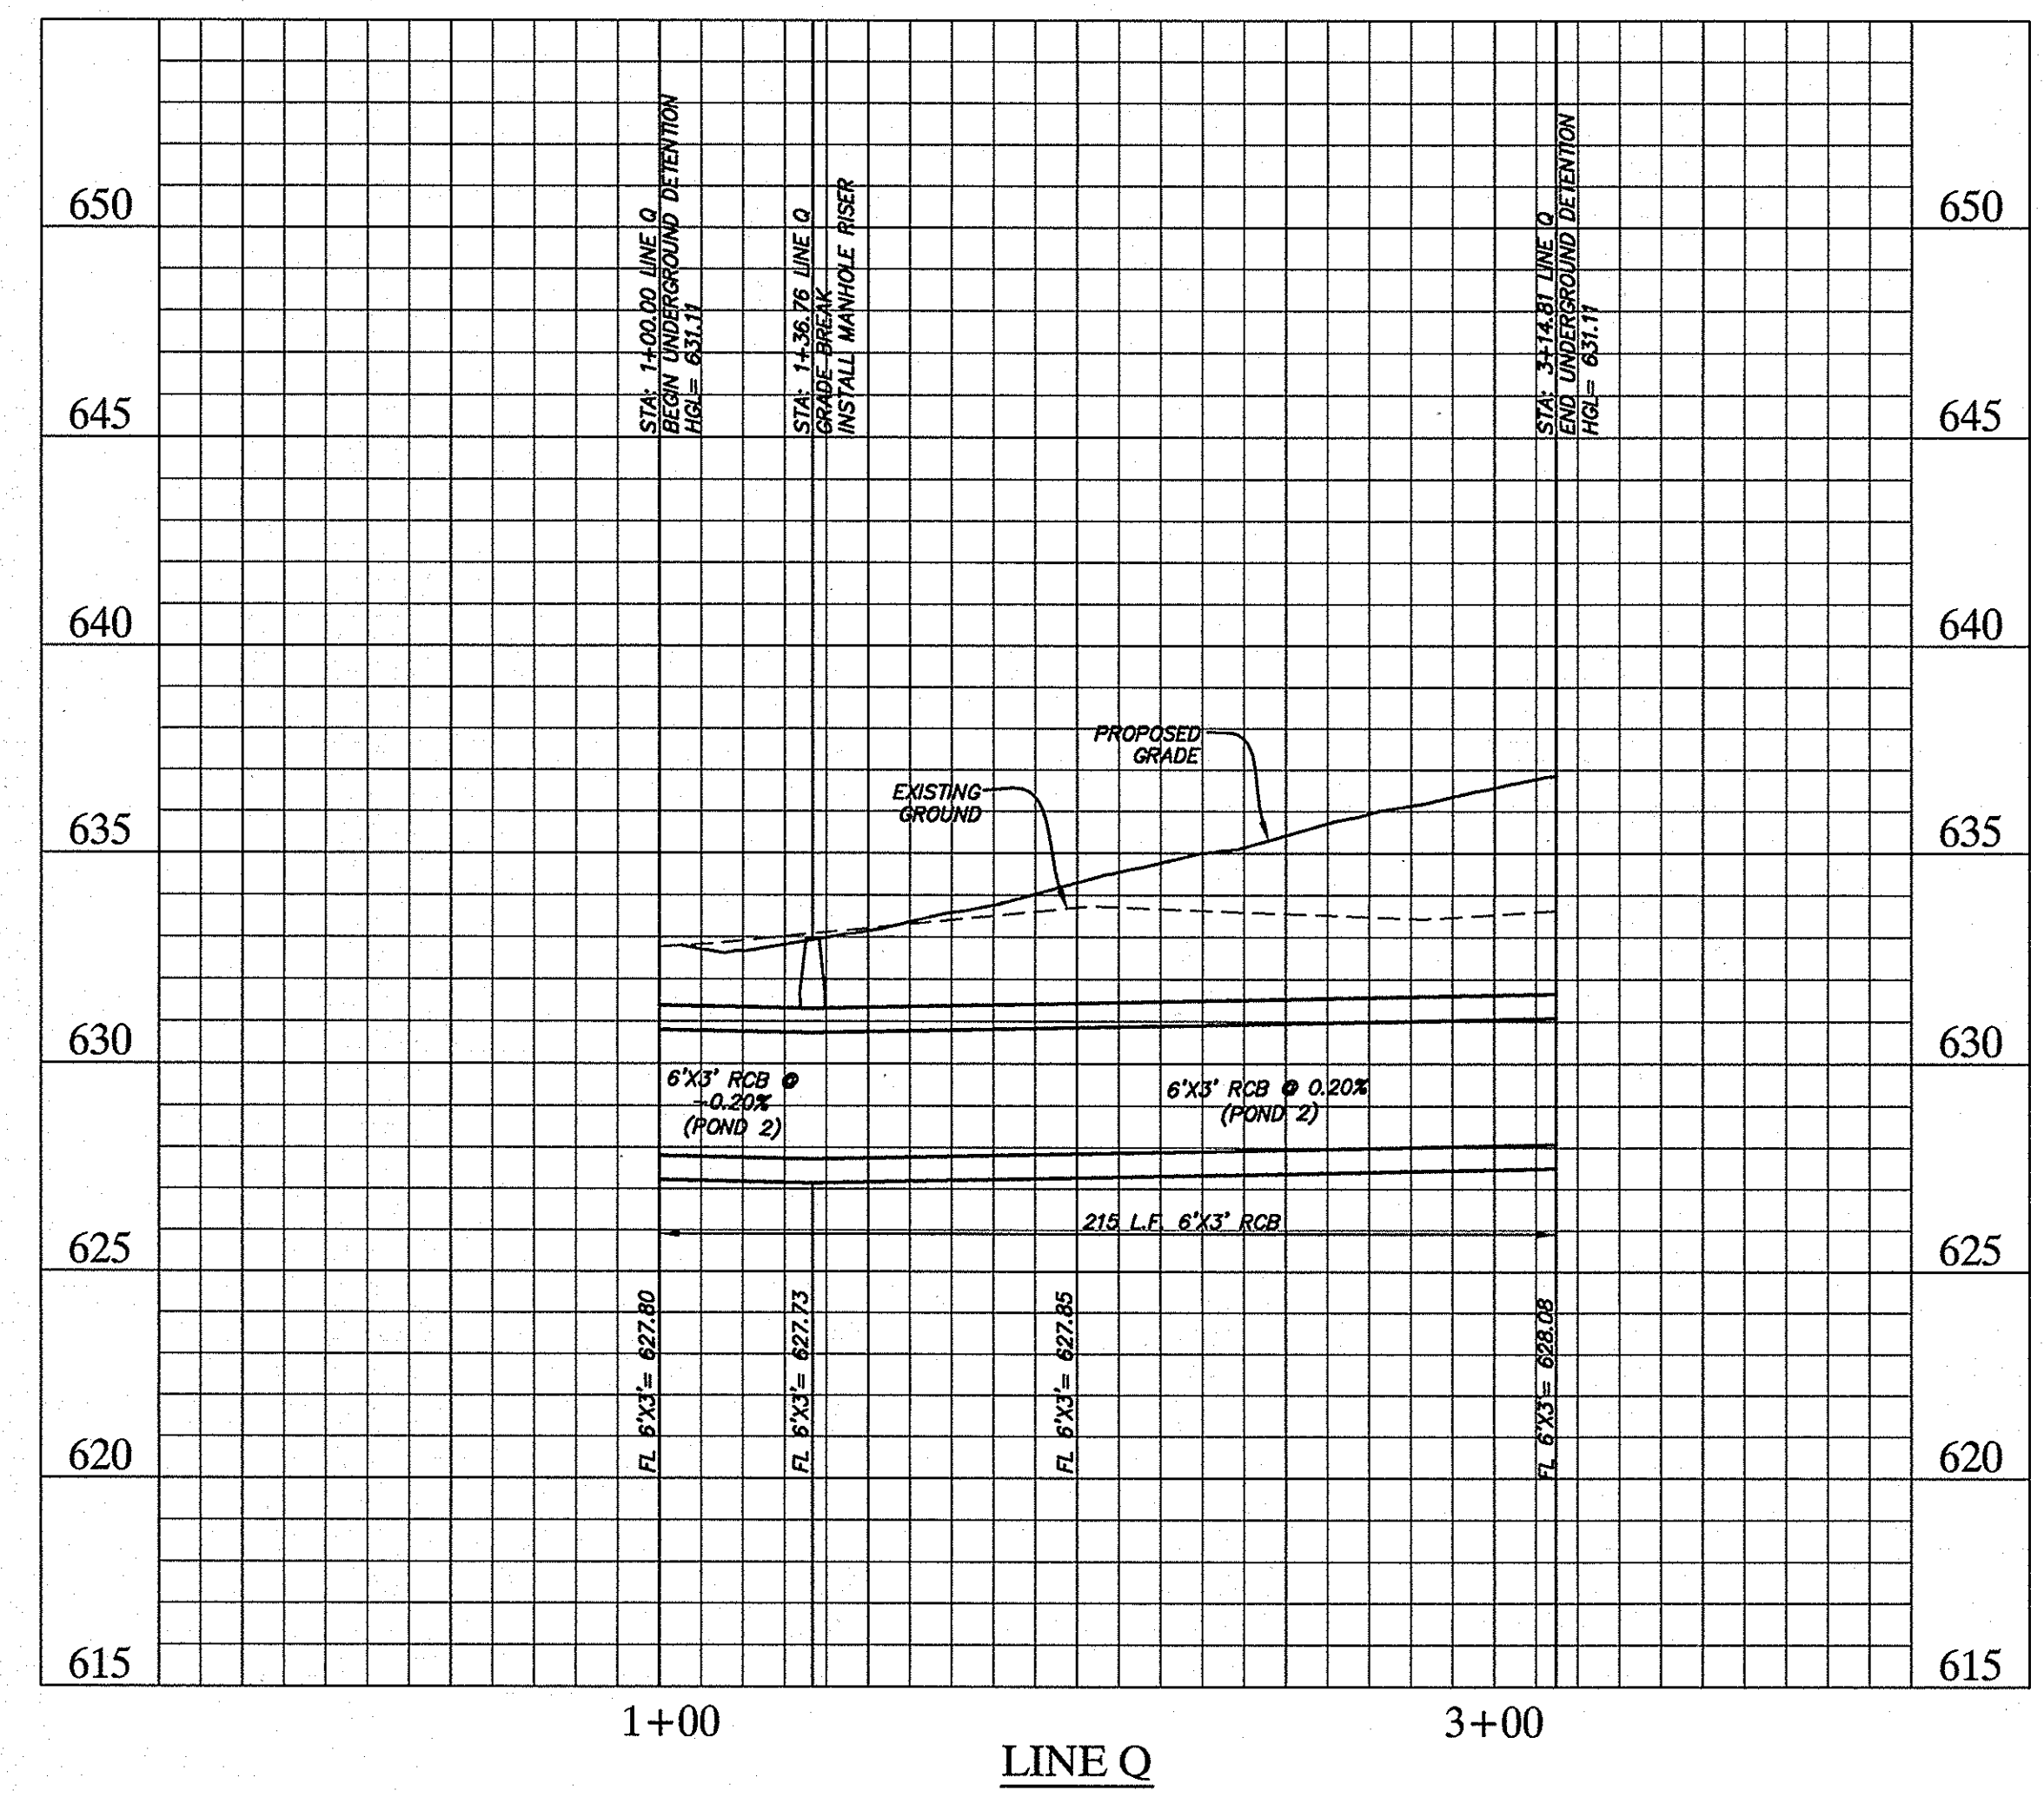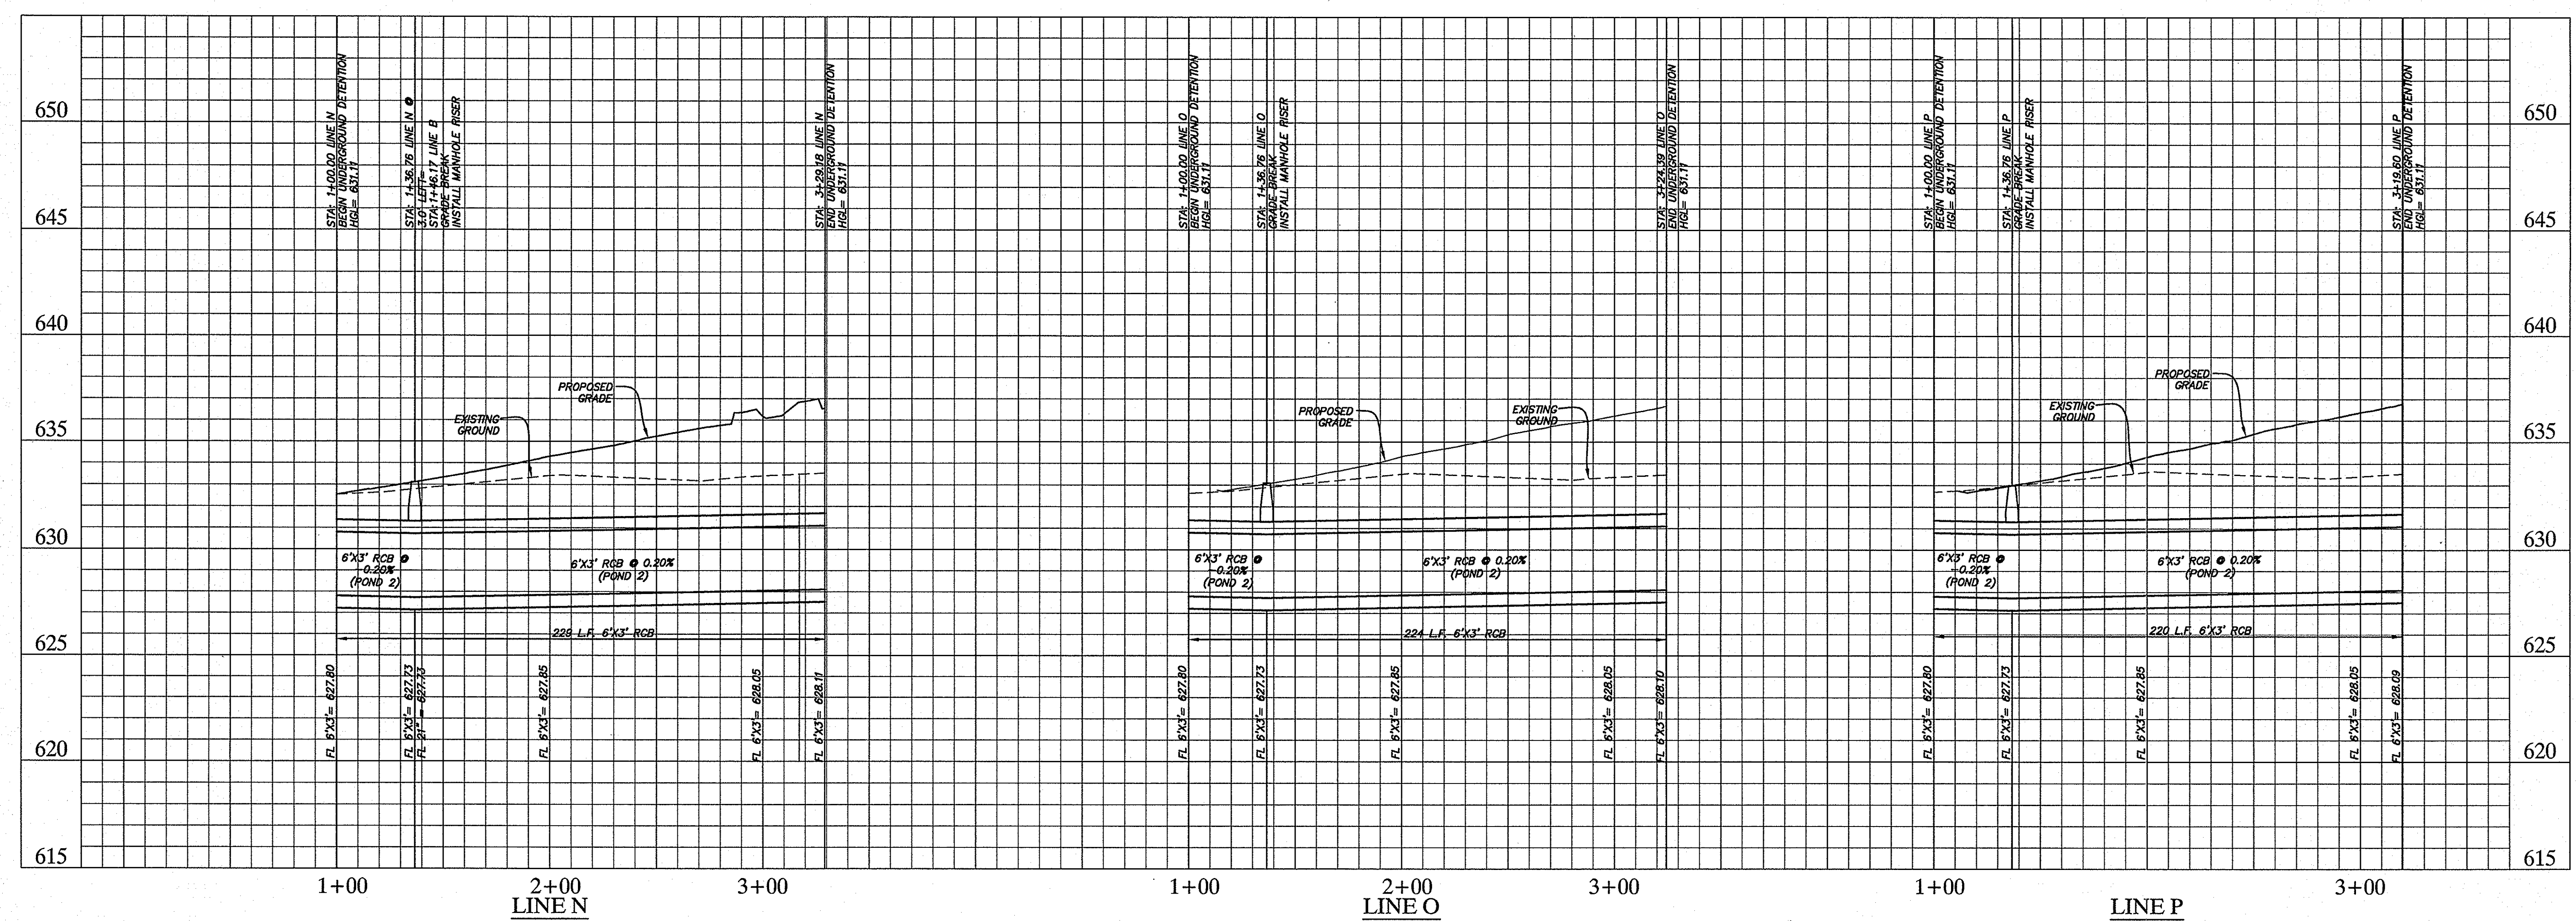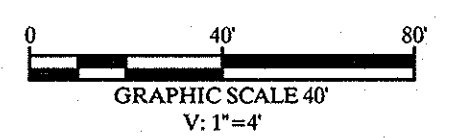

No.	Date	Revisions	App.

**Kimley-Horn and Associates, Inc.**  
 5750 Geneva Court, Suite 200  
 Frisco, Texas 75034  
 Tel. No. (972) 335-3580  
 Fax No. (972) 335-3779  
 State of Texas Registration No. E-928

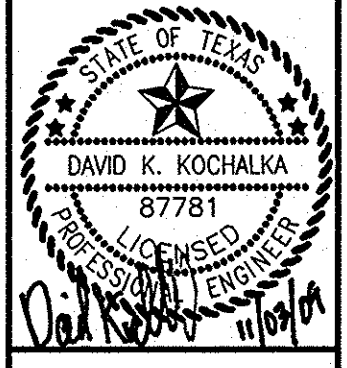

**METHODIST HOSPITAL FOR SURGERY**  
**ADDISON, TEXAS**  
 FILE NUMBER: 311T-7863

**DETENTION PROFILES**


**RECORD DRAWINGS (SEPTEMBER 2010)**  
 INFORMATION PROVIDED BY:  
 Rogers-O'Brien Construction Company

THE CONTRACTOR SHALL FIELD VERIFY THE HORIZONTAL AND VERTICAL LOCATIONS OF ALL EXISTING UTILITIES PRIOR TO START OF CONSTRUCTION AND SHALL NOTIFY THE CONSTRUCTION MANAGER AND ENGINEER OF ANY CONFLICTS DISCOVERED. CONTRACTOR IS RESPONSIBLE FOR PROTECTING EXISTING UTILITIES (SHOWN OR NOT SHOWN) WITHIN SCOPE OF CONSTRUCTION. IF ANY EXISTING UTILITIES ARE DAMAGED, THE CONTRACTOR SHALL REPLACE THEM AT HIS OWN EXPENSE. CALL 1-800-DIG-TESS AT LEAST 72 HOURS PRIOR TO COMMENCING CONSTRUCTION IN VICINITY.

**BENCHMARK**

- "1" FOUND ON TOP OF THE CONCRETE BASE OF A LIGHT POLE IN THE CENTER MEDIAN OF EXCEL PARKWAY APPROXIMATELY 50 FEET WEST OF THE CENTERLINE OF ADDISON ROAD, (PER TOWN OF ADDISON PLAN # 98103, SHEET 2, DATED JANUARY 1998) ELEV=644.41
- BM #60" SET ON TOP OF A CONCRETE CURB INLET LOCATED ON THE WEST SIDE OF DALLAS PARKWAY APPROXIMATELY 828 FEET NORTH OF THE CENTERLINE OF SOJOURN DRIVE. ELEV=632.78
- BM #61" SET ON TOP OF A CONCRETE CURB INLET LOCATED ON THE WEST SIDE OF DALLAS PARKWAY APPROXIMATELY 180 FEET NORTH OF THE CENTERLINE OF SOJOURN DRIVE. ELEV=638.04


Scale:	AS SHOWN
Designed by:	TNB
Drawn by:	ROC
Checked by:	DNK
Date:	11/09/09
Project No.:	6902500

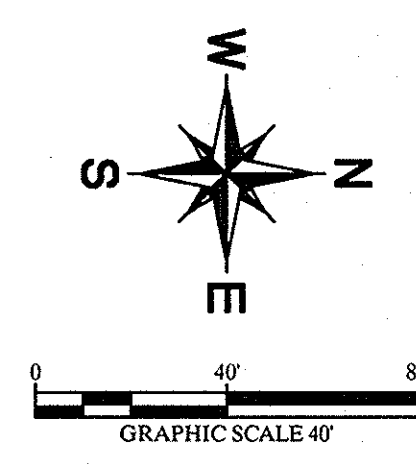


**LEGEND**

---	PROPERTY LINE
---	PROPOSED EASEMENT
---	PROPOSED SANITARY SEWER LINE
---	PROPOSED WATER LINE
---	PROPOSED STORM SEWER LINE
---	PROPOSED FIRE LINE
---	EXISTING OVERHEAD POWER LINE
---	EXISTING CABLE LINE
---	EXISTING GAS LINE
---	EXISTING WATER LINE
---	EXISTING SANITARY SEWER LINE
○	PROPOSED CLEANOUT
●	PROPOSED FIRE HYDRANT (FH)
▲	PROPOSED FIRE DEPARTMENT CONNECTION (FDC)
⊙	PROPOSED METER
⊙	EXISTING POWER POLE
⊙	EXISTING LIGHT POLE
⊙	EXISTING FIRE HYDRANT
⊙	EXISTING STORM MANHOLE
⊙	EXISTING SAN. SWR. MANHOLE
⊙	EXISTING SIGN

- UTILITY NOTES**
- SEE MEP PLANS FOR ALL UTILITY CONNECTIONS INTO BUILDING.
  - WATER AND SEWER LINES SHALL STUB 5 FEET FROM BUILDING FOR SERVICE CONNECTIONS UNLESS OTHERWISE NOTED.
  - A FIVE FOOT CLEARANCE SHALL BE MAINTAINED AROUND ALL FIRE HYDRANTS.
  - REFER TO TOWN OF ADDISON DETAILS FOR WATER METER, METER BOX, FIRE HYDRANTS, VALVES, VALVE BOXES AND SERVICE INSTALLATION.
  - REFER TO DETAILS FOR SANITARY SEWER MANHOLE REQUIREMENTS.
  - REFER TO DETAILS FOR TRENCHING, BEDDING, BACKFILL, AND TRENCH COMPACTION REQUIREMENTS.
  - WATER AND SANITARY SEWER PIPE SHALL BE CONSTRUCTED OF SLIP-ON OR MECHANICAL JOINT CAST OR DUCTILE IRON PIPE, OR PVC PIPE.
  - REFER TO ARCHITECTURE PLANS FOR LOCATION AND SIZING OF PVC SLEEVES FOR FRANCHISE UTILITIES, IRRIGATION, ETC.
  - ALL PIPE DEFLECTIONS SHALL BE PER MANUFACTURER'S SPECIFICATIONS. ANY VARIATIONS SHALL BE APPROVED IN WRITING BY THE ENGINEER BEFORE INSTALLATION.
  - IT IS THE CONTRACTOR'S RESPONSIBILITY TO DEFLECT ELECTRIC, GAS, CABLE, AND TELEPHONE CONDUIT AND PIPING AS REQUIRED TO AVOID UTILITY CONFLICTS.
  - IT WILL BE THE RESPONSIBILITY OF THE CONTRACTOR TO SUPPLY A TRAFFIC CONTROL PLAN TO THE TOWN FOR APPROVAL FOR UTILITY WORK WITHIN THE PUBLIC R.O.W.

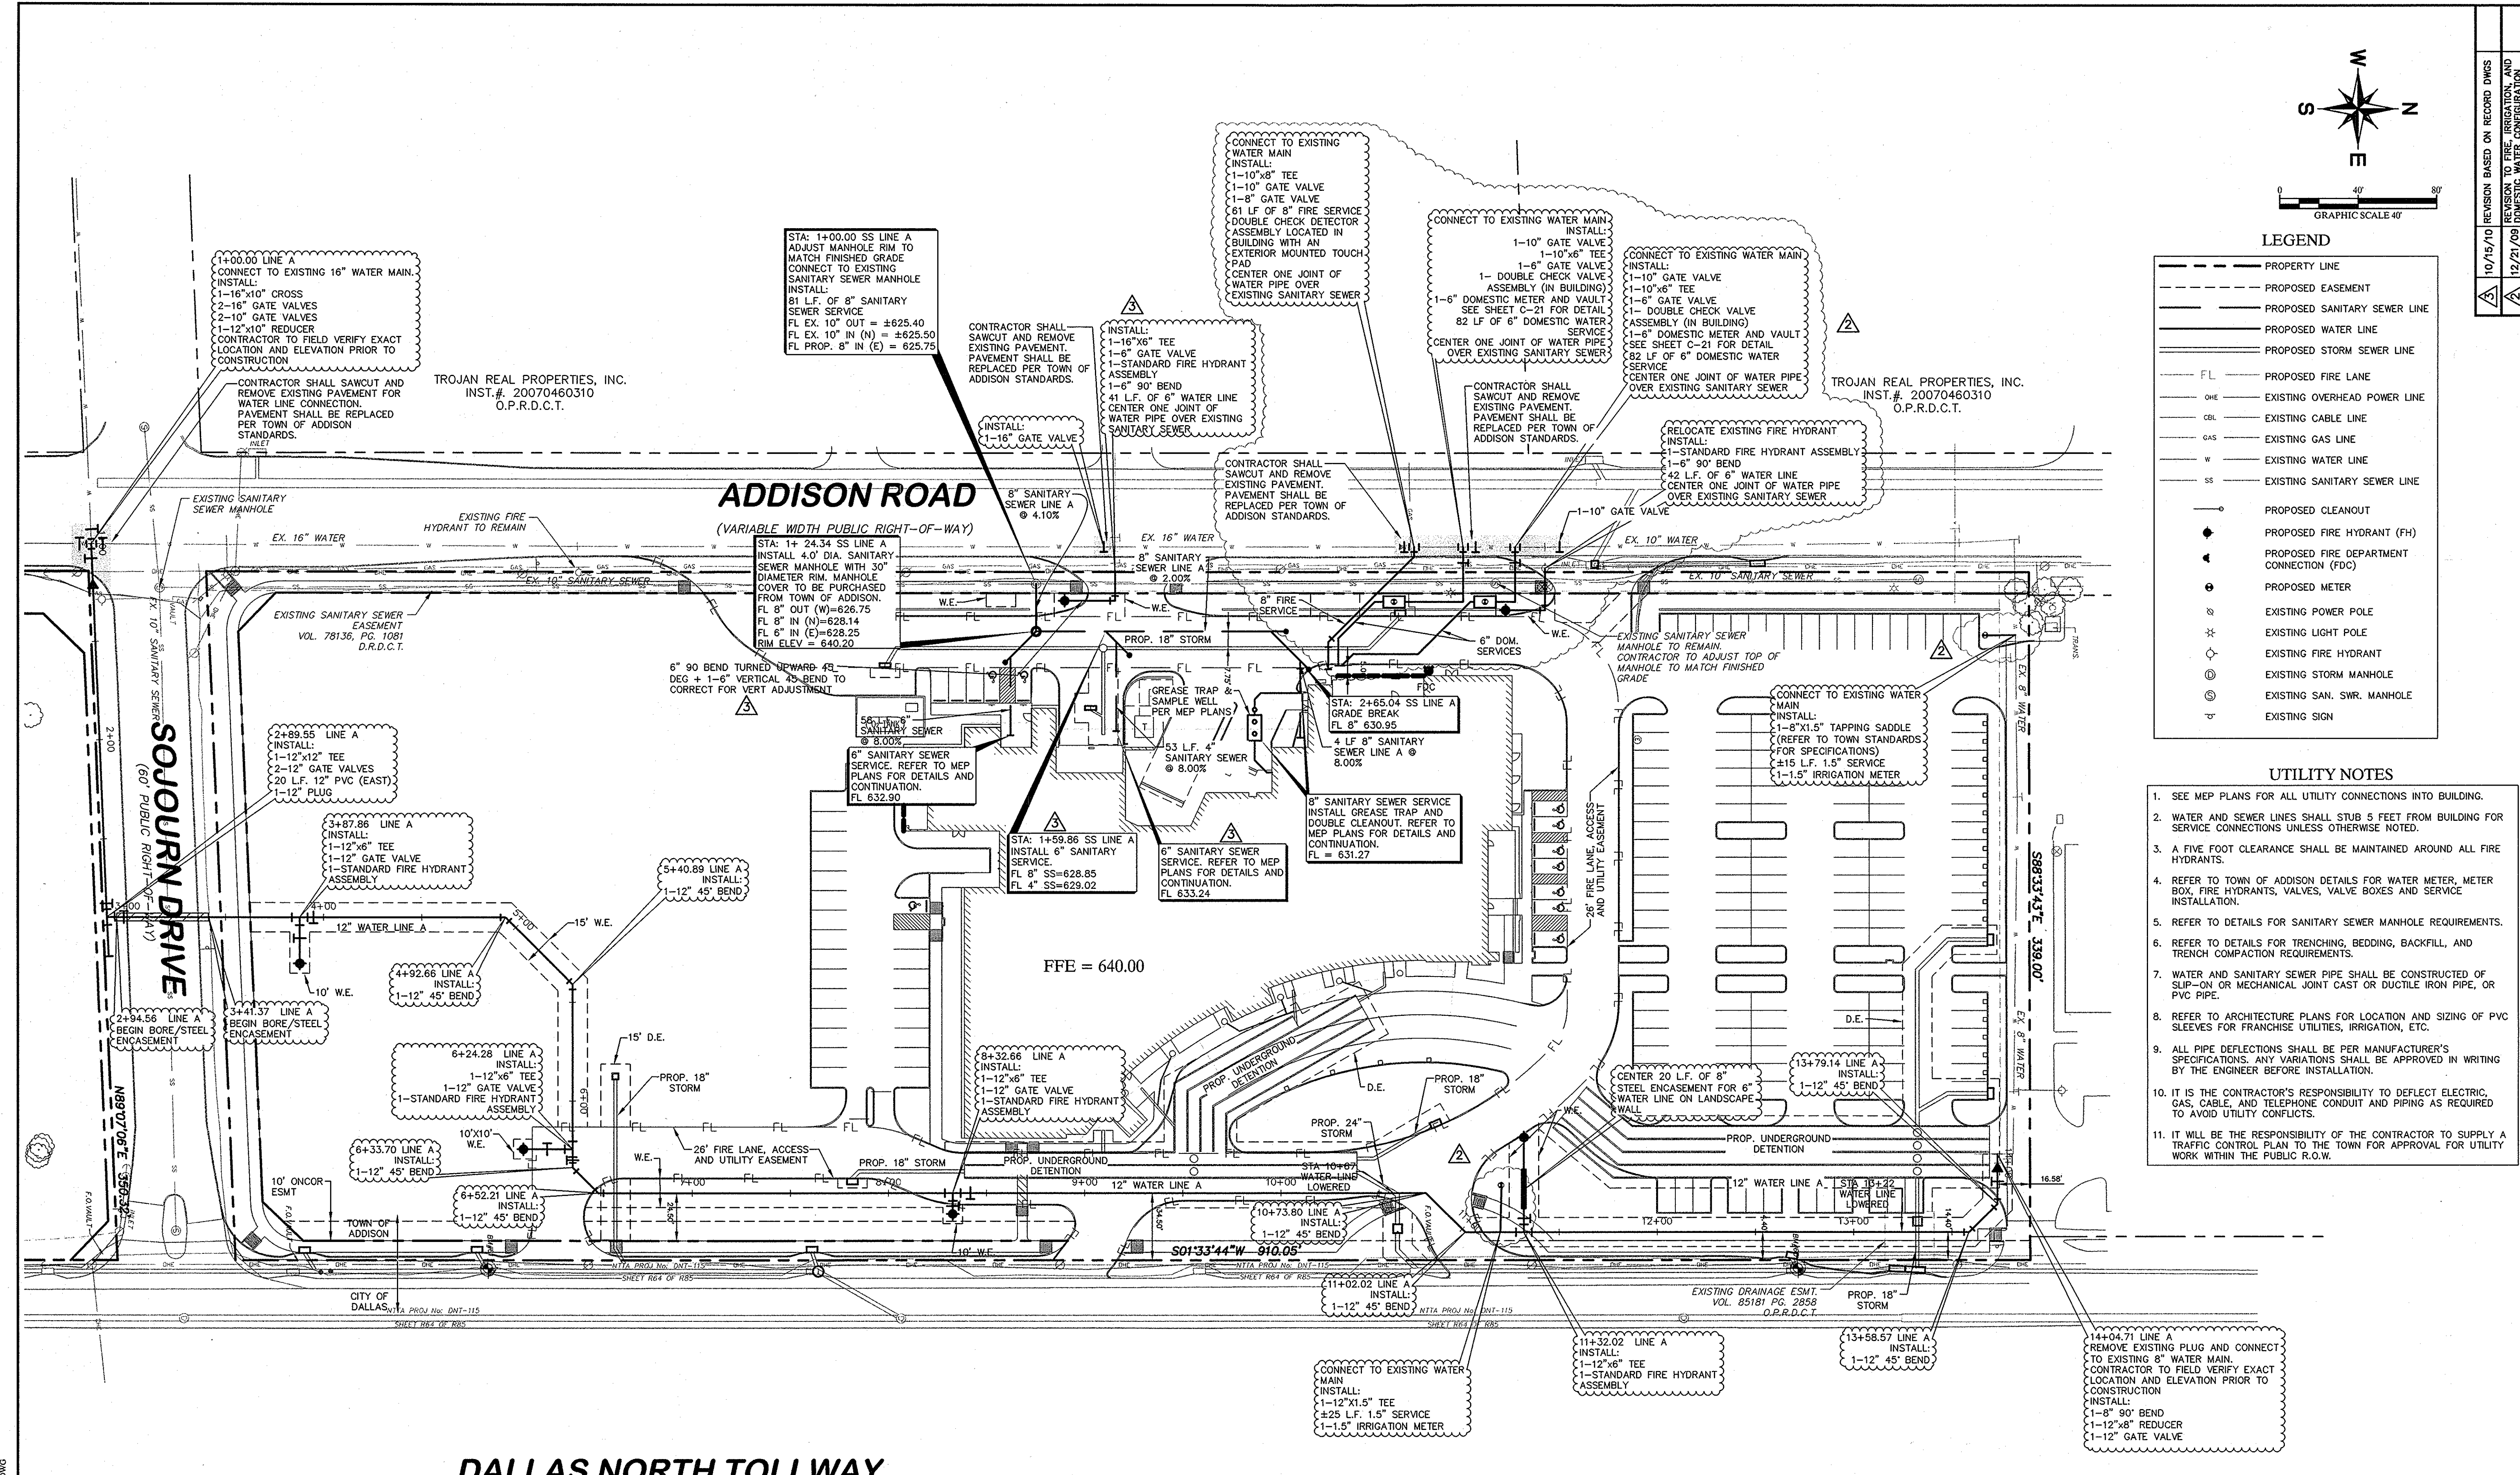

THE CONTRACTOR SHALL FIELD VERIFY THE HORIZONTAL AND VERTICAL LOCATIONS OF ALL EXISTING UTILITIES PRIOR TO START OF CONSTRUCTION AND SHALL NOTIFY THE CONSTRUCTION MANAGER AND ENGINEER OF ANY CONFLICTS DISCOVERED. CONTRACTOR IS RESPONSIBLE FOR PROTECTING EXISTING UTILITIES (SHOWN OR NOT SHOWN) WITHIN SCOPE OF CONSTRUCTION. IF ANY EXISTING UTILITIES ARE DAMAGED, THE CONTRACTOR SHALL REPLACE THEM AT HIS OWN EXPENSE. CALL 1-800-DIG-TESS AT LEAST 72 HOURS PRIOR TO COMMENCING CONSTRUCTION IN VICINITY.

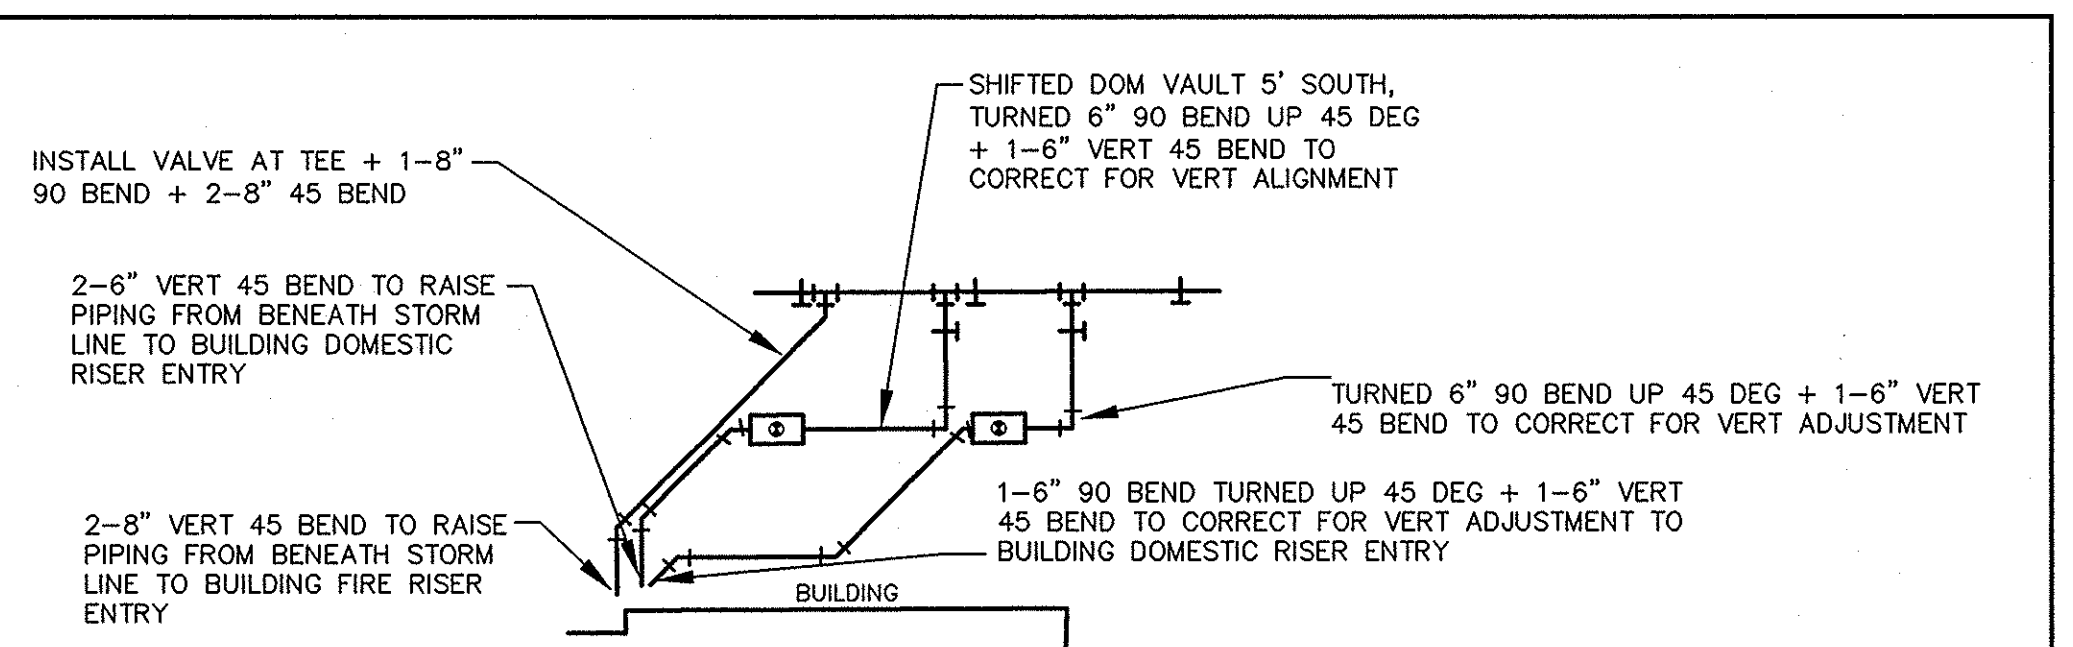

**STOP!**  
**CALL BEFORE YOU DIG**  
 DIG TESS  
 1-800-DIG-TESS  
 (@ least 72 hours prior to digging)

- BENCHMARK**
- "□" FOUND ON TOP OF THE CONCRETE BASE OF A LIGHT POLE IN THE CENTER MEDIAN OF EXCEL PARKWAY APPROXIMATELY 50 FEET WEST OF THE CENTERLINE OF ADDISON ROAD. (PER TOWN OF ADDISON PLAN # 96103, SHEET 2, DATED JANUARY 1998) ELEV=644.41
  - BM #60" SET ON TOP OF A CONCRETE CURB INLET LOCATED ON THE WEST SIDE OF DALLAS PARKWAY APPROXIMATELY 826 FEET NORTH OF THE CENTERLINE OF SOJOURN DRIVE. ELEV=632.78
  - BM #61" SET ON TOP OF A CONCRETE CURB INLET LOCATED ON THE WEST SIDE OF DALLAS PARKWAY APPROXIMATELY 160 FEET NORTH OF THE CENTERLINE OF SOJOURN DRIVE. ELEV=638.04


AS-BUILT DETAIL FOR FIRE AND DOMESTIC WATER SERVICE  
 (PROVIDED BY CALHAR CONSTRUCTION, INC. 9/30/10)

XREF: SANITARY SEWER, WATER, FIRE, GAS, AND TELEPHONE UTILITIES. ALL UTILITIES SHOWN ARE BASED ON RECORD DRAWINGS AND FIELD SURVEY. CONTRACTOR SHALL VERIFY ALL UTILITIES PRIOR TO CONSTRUCTION. ANY CHANGES TO UTILITIES SHALL BE NOTED ON THIS PLAN.







DATE PLOTTED: 11/09/09 10:00 AM  
 PLOTTED BY: K. RAY  
 DWG NAME: C-15  
 C-15.dwg  
 11/09/09 10:00 AM

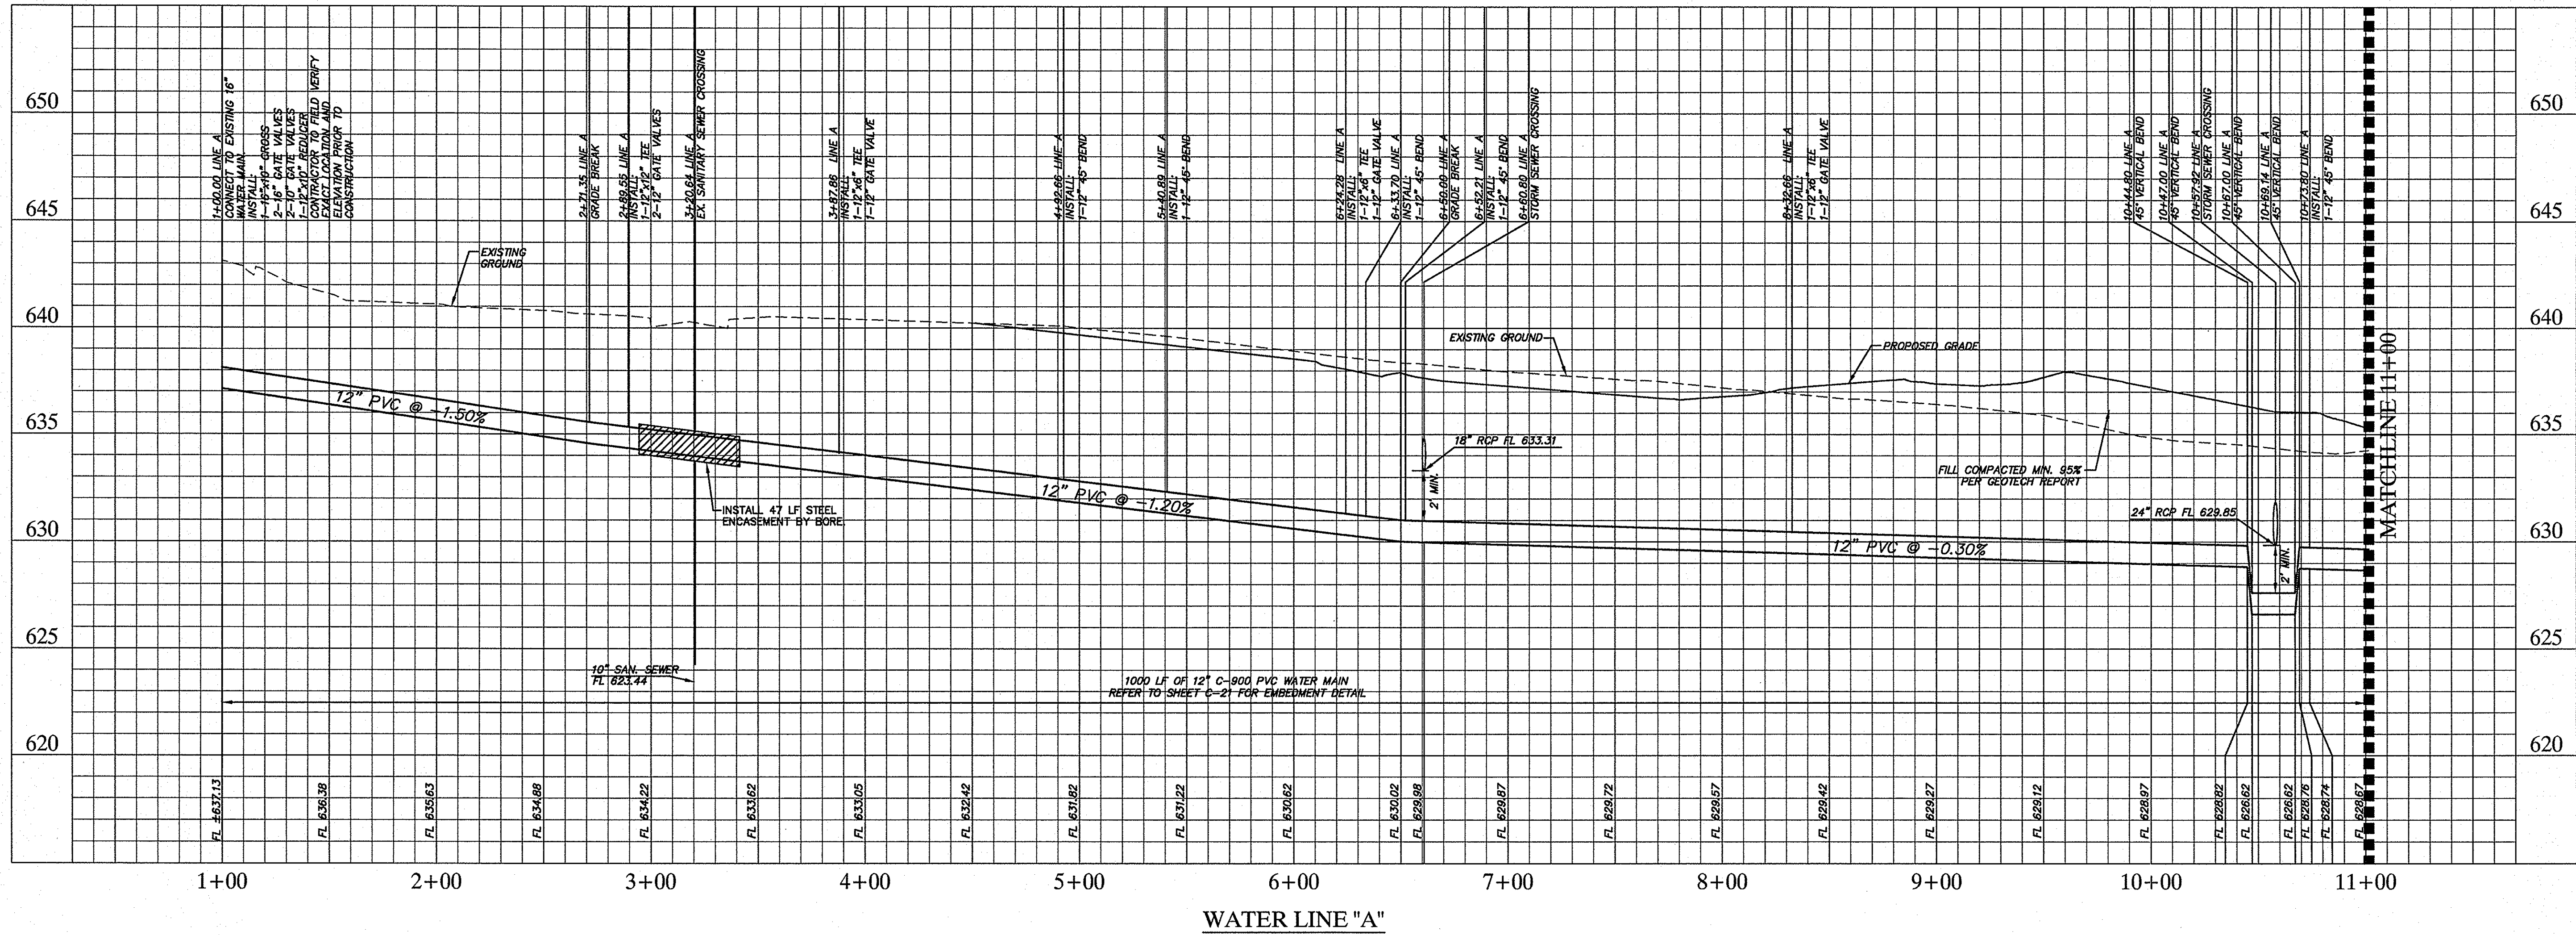

WATER LINE "A"

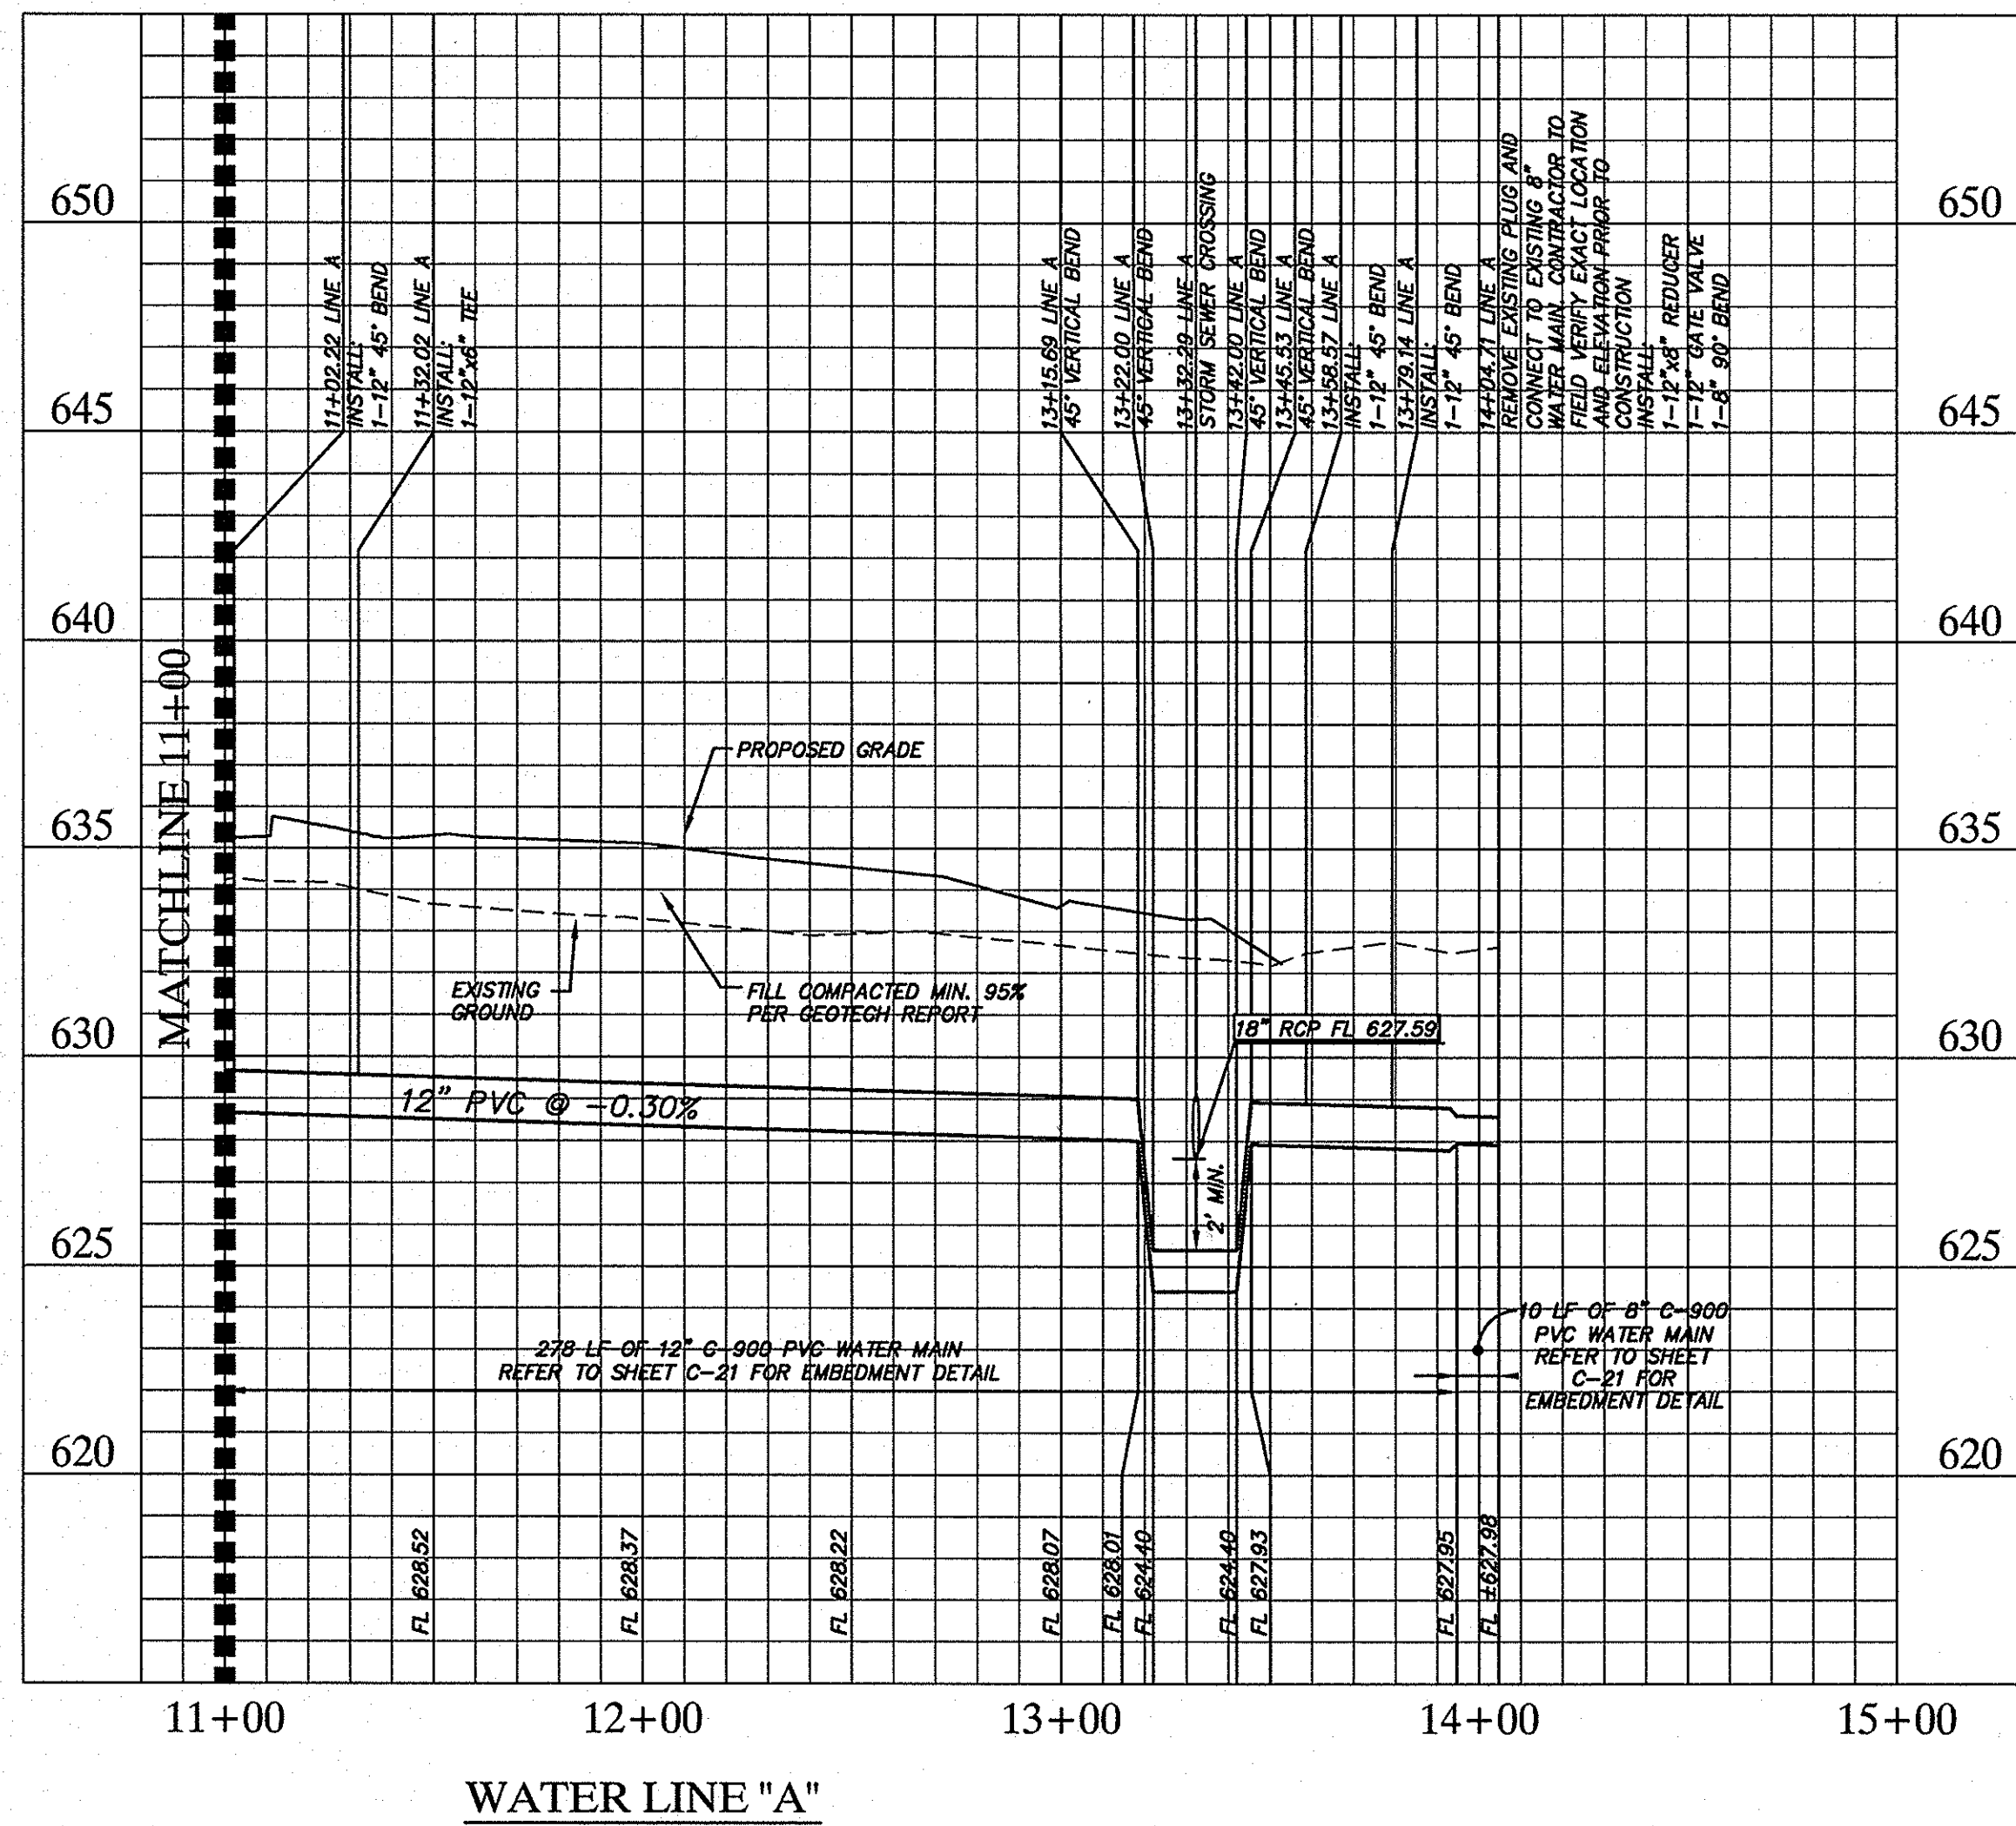


WATER LINE "A"

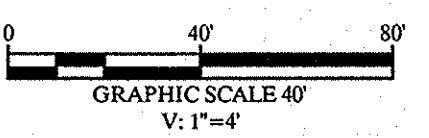

No.	Date	Revisions	App.

**Kimley-Horn and Associates, Inc.**  
 5700 Genesis Court, Suite 200  
 Frisco, Texas 75034  
 State of Texas Registration No. F-928  
 Tel. No. (972) 335-3580  
 Fax No. (972) 335-3779

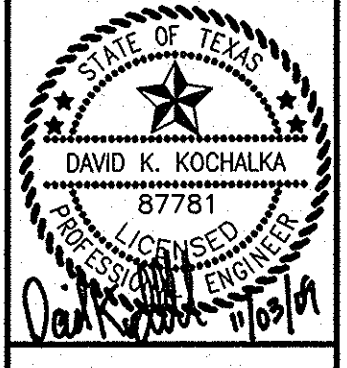

**METHODIST HOSPITAL FOR SURGERY**  
 ADDISON, TEXAS  
 FILE NUMBER: 311T-7863

**WATER LINE PROFILES**

**RECORD DRAWINGS (SEPTEMBER 2010)**  
 INFORMATION PROVIDED BY:  
 Rogers-O'Brien Construction Company

**BENCHMARK**





- "1" FOUND ON TOP OF THE CONCRETE BASE OF A LIGHT POLE IN THE CENTER MEDIAN OF EXCEL PARKWAY APPROXIMATELY 50 FEET WEST OF THE CENTERLINE OF ADDISON ROAD. (PER TOWN OF ADDISON PLAN # 96103, SHEET 2, DATED JANUARY 1998) ELEV=644.41
- BM #60" SET ON TOP OF A CONCRETE CURB INLET LOCATED ON THE WEST SIDE OF DALLAS PARKWAY APPROXIMATELY 828 FEET NORTH OF THE CENTERLINE OF SOJOURN DRIVE. ELEV=632.78
- BM #61" SET ON TOP OF A CONCRETE CURB INLET LOCATED ON THE WEST SIDE OF DALLAS PARKWAY APPROXIMATELY 160 FEET NORTH OF THE CENTERLINE OF SOJOURN DRIVE. ELEV=638.04

Scale:	AS SHOWN
Designed by:	RCC
Drawn by:	RCC
Checked by:	DMK
Date:	11/09/09
Project No.:	6962500

SHEET  
**C-15**




LEGEND

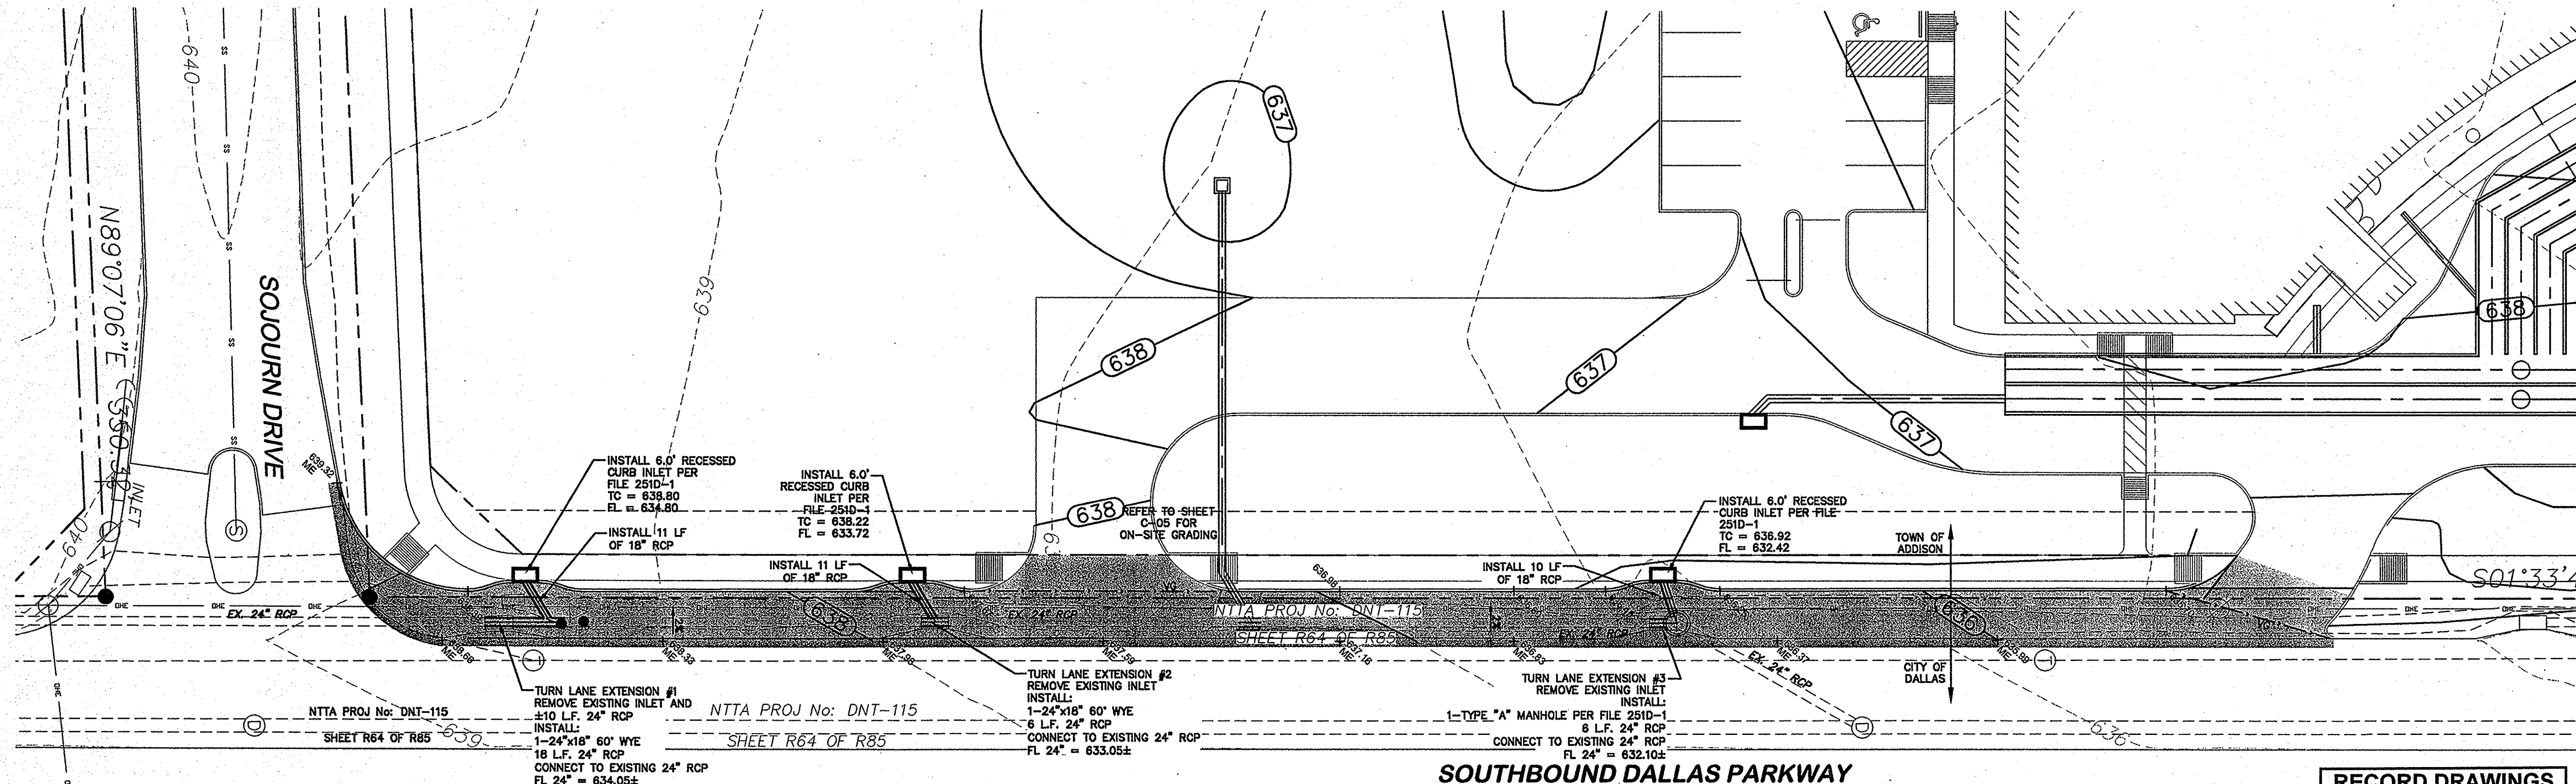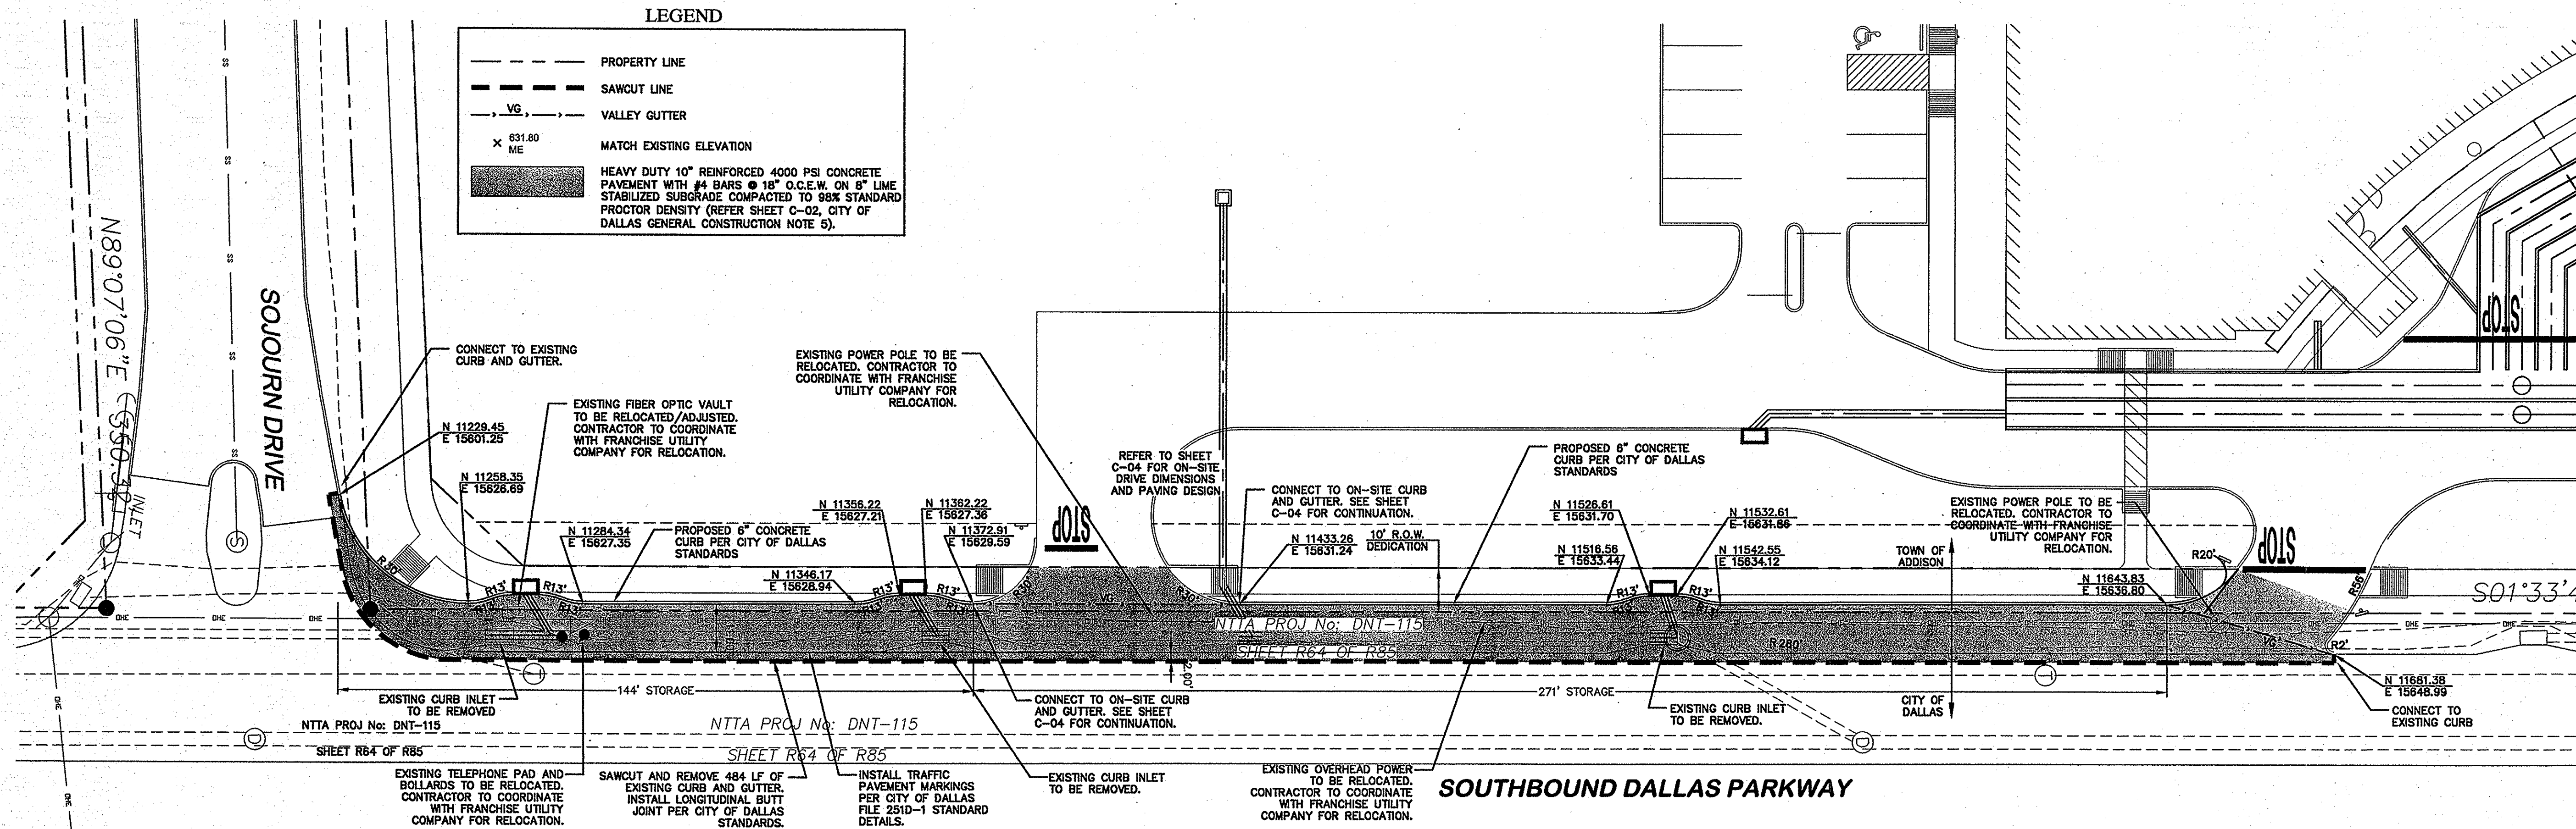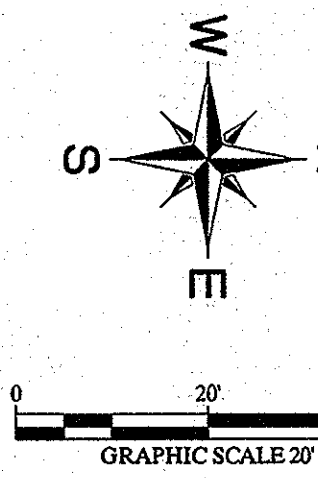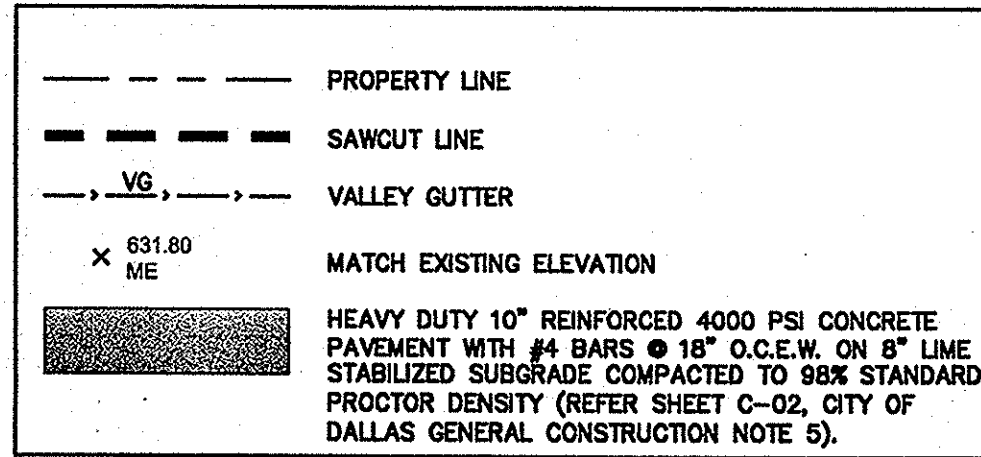

App. Revisions No. Date

**Kimley-Horn and Associates, Inc.**

1750 Geneva Court, Suite 200  
Addison, TX 75001  
Tel. No. (972) 335-3990  
Fax. No. (972) 335-3779

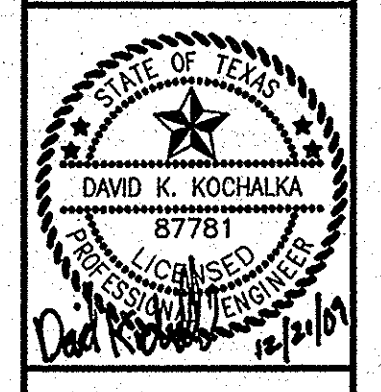

METHODIST HOSPITAL  
FOR SURGERY  
ADDISON, TEXAS  
FILE NUMBER: 311T-7863


DALLAS NORTH  
TOLLWAY FRONTAGE  
ROAD TURN LANE #2

AS SHOWN	RCG
Designed by:	RCG
Drawn by:	DXK
Checked by:	1/1/09
Date:	09/02/09
Project No.:	0902900

SHEET  
**C-17**

NOTES

- ALL DIMENSIONS ARE TO FACE OF CURB, FACE OF BUILDING, OR PROPERTY LINE UNLESS OTHERWISE NOTED.
- ALL PARKING STALLS SHALL BE 9'x18', UNLESS OTHERWISE NOTED.
- CONTRACTOR SHALL REFER TO ARCHITECTURAL PLANS FOR EXACT BUILDING FOOTPRINT DIMENSIONS.
- ALL RADII ARE 3', UNLESS OTHERWISE NOTED.
- FIRE LANE SHALL BE CONSTRUCTED PER TOWN OF ADDISON FIRE DEPARTMENT STANDARDS AND MARKED PER TOWN SPECIFICATIONS. REFER TO DETAILS FOR ADDITIONAL INFORMATION.
- PAVEMENT DESIGN DATA SHOWN BY REFERENCE ONLY. PAVEMENT TO BE PER GEOTECH REPORT PROJECT NO. G090336 DATED APRIL 23, 2009 BY ALPHA TESTING.
- CONTRACTOR SHALL REFER TO ARCHITECTURAL PLANS AND FINAL GEOTECH REPORT FOR BUILDING SUB GRADE PREPARATION REQUIREMENTS.
- CONTRACTOR TO VERIFY T.A.S COMPLIANCE, FOR ANY QUESTIONS CONTACT CIVIL ENGINEER IMMEDIATELY.
- CONTRACTOR TO VERIFY ENGINEERING PLANS MATCH ARCHITECTURAL PLANS BEFORE CONSTRUCTION STAKING.
- REFER TO LANDSCAPE PLANS FOR ALL SCREENING AND OPEN SPACE CALCULATIONS.
- REFER TO SITE LIGHTING PLANS FOR ALL LIGHTING LOCATIONS, SPECIFICATIONS, AND PHOTOMETRIC DETAILS.
- REFER TO BUILDING ELEVATION PLANS FOR ALL BUILDING SIGNAGE LOCATIONS AND DETAILS.
- CONTRACTOR SHALL REFER TO M.E.P. AND LANDSCAPE PLANS FOR CONDUIT PLACEMENT PRIOR TO PAVING.
- CITY OF DALLAS FORCES SHALL INSTALL ALL REQUIRED TRAFFIC SIGNS AND PAVEMENT MARKINGS WITHIN THE DALLAS PARKWAY RIGHT-OF-WAY. PLEASE CALL (214) 670-3773 TO RELEASE THE WORK ORDERS FOR THE SIGNS AND PAVEMENT MARKINGS INSTALLATIONS FOUR WEEKS PRIOR TO CONSTRUCTION COMPLETION. THE CITY OF DALLAS SHALL BE REIMBURSED FOR THE COSTS OF THE TRAFFIC SIGNS AND PAVEMENT MARKINGS.
- ALL CONSTRUCTION WITHIN CITY OF DALLAS SHALL REFER TO CITY OF DALLAS CONSTRUCTION STANDARDS SPECIFIED IN FILE 251D-1.

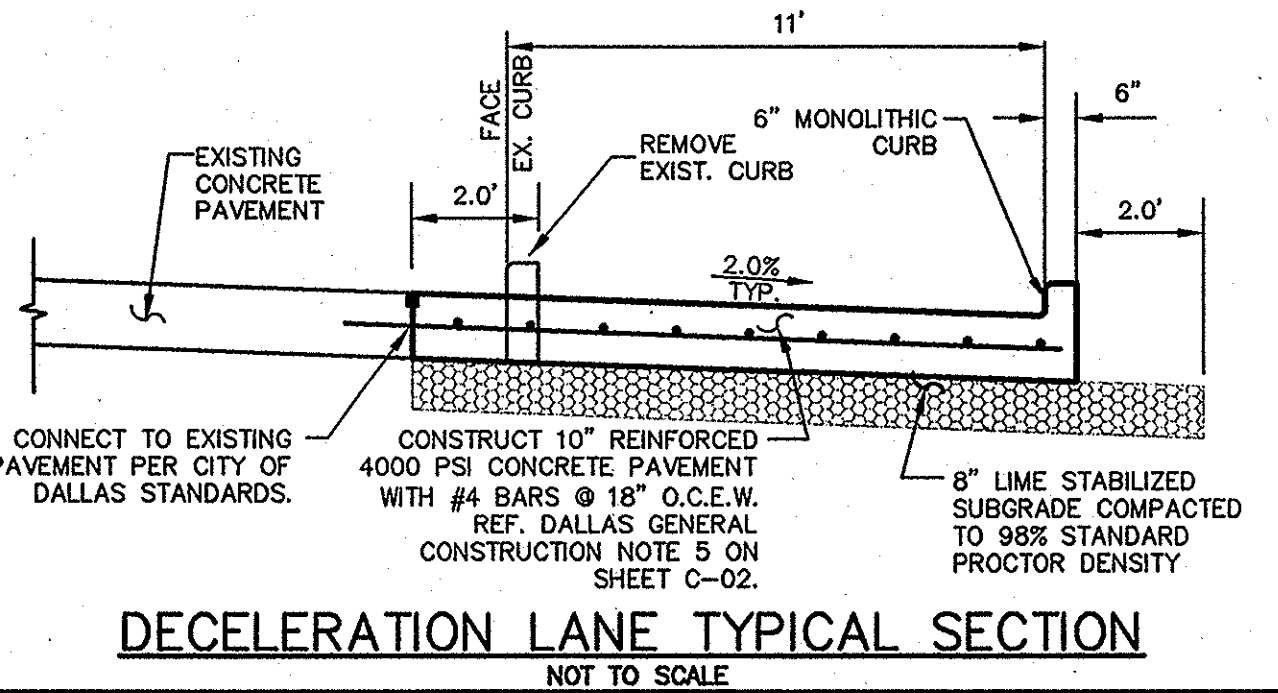

- BENCHMARK**
- "I" FOUND ON TOP OF THE CONCRETE BASE OF A LIGHT POLE IN THE CENTER MEDIAN OF EXCEL PARKWAY APPROXIMATELY 50 FEET WEST OF THE CENTERLINE OF ADDISON ROAD. (PER TOWN OF ADDISON PLAN # 88103, SHEET 2, DATED JANUARY 1998) ELEV=844.41
  - BM #60" SET ON TOP OF A CONCRETE CURB INLET LOCATED ON THE WEST SIDE OF DALLAS PARKWAY APPROXIMATELY 828 FEET NORTH OF THE CENTERLINE OF SOJOURN DRIVE. ELEV=632.78
  - BM #61" SET ON TOP OF A CONCRETE CURB INLET LOCATED ON THE WEST SIDE OF DALLAS PARKWAY APPROXIMATELY 180 FEET NORTH OF THE CENTERLINE OF SOJOURN DRIVE. ELEV=638.04


**RECORD DRAWINGS (SEPTEMBER 2010)**

INFORMATION PROVIDED BY:  
Rogers-O'Brien Construction Company

**STOP! CALL BEFORE YOU DIG**

**DIG TESS**  
1-800-DIG-TESS  
(@ least 72 hours prior to digging)

THE CONTRACTOR SHALL FIELD VERIFY THE HORIZONTAL AND VERTICAL LOCATIONS OF ALL EXISTING UTILITIES PRIOR TO START OF CONSTRUCTION AND SHALL NOTIFY THE CONSTRUCTION MANAGER AND ENGINEER OF ANY CONFLICTS DISCOVERED. CONTRACTOR IS RESPONSIBLE FOR PROTECTING EXISTING UTILITIES (KNOWN OR NOT SHOWN) WITHIN SCOPE OF CONSTRUCTION. IF ANY EXISTING UTILITIES ARE DAMAGED, THE CONTRACTOR SHALL REPLACE THEM AT HIS OWN EXPENSE. CALL 1-800-DIG-TESS AT LEAST 72 HOURS PRIOR TO COMMENCING CONSTRUCTION IN VICINITY.

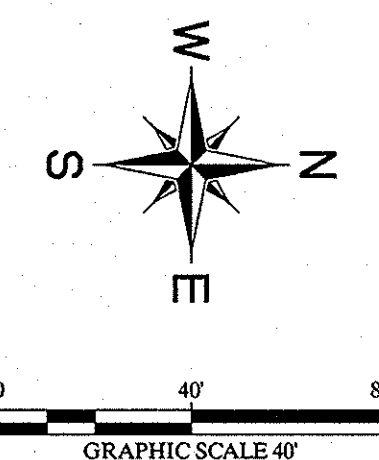

TROJAN REAL PROPERTIES, INC.  
INST.# 20070460310  
O.P.R.D.C.T.

TROJAN REAL PROPERTIES, INC.  
INST.# 20070460310  
O.P.R.D.C.T.

### ADDISON ROAD

(VARIABLE WIDTH PUBLIC RIGHT-OF-WAY)

### SOJOURN DRIVE

(60' PUBLIC RIGHT-OF-WAY)

TOWN OF ADDISON

CITY OF DALLAS

NITA PROJ No. 047-115

SHEET #64 OF 685

NITA PROJ No. 047-115

SHEET #64 OF 685

NITA PROJ No. 047-115

SHEET #64 OF 685

NITA PROJ No. 047-115

SHEET #64 OF 685

LEGEND	
- - - - -	PROPERTY LINE
— 682 —	PROPOSED CONTOUR
- - - - -	EXISTING CONTOUR
SF	SILT FENCE
— 640 —	LIMITS OF DISTURBANCE
IP	INLET PROTECTION
CE	CONSTRUCTION ENTRANCE

#### EROSION CONTROL SCHEDULE AND PHASING

- THE PROJECT SHALL GENERALLY CONFORM TO THE FOLLOWING:
- PHASE 1 – GRADING**  
A. CONSTRUCT TEMPORARY CONSTRUCTION ENTRANCE, SILT FENCE AND INLET PROTECTION ACCORDING TO THE APPROXIMATE LOCATION SHOWN ON THE GRADING AND EROSION CONTROL PLAN NOTES AND DETAIL SHEET.  
B. BEGIN CLEARING AND GRADING OF SITE.  
C. SEED AND REVEGETATE SLOPES WHERE NECESSARY.
  - PHASE 2 – UTILITIES**  
A. KEEP ALL STORM WATER POLLUTION PREVENTION MEASURES IN PLACE.  
B. INSTALL STORM DRAINS AND INLET PROTECTION AS SPECIFIED ON PLAN SHEETS.
  - PHASE 3 – PAVING**  
A. KEEP ALL STORM WATER POLLUTION PREVENTION MEASURES IN PLACE. REMOVE AS NEEDED TO PAVE.  
B. STABILIZE SUBGRADE.  
C. PAVE PARKING LOT AND SIDEWALKS AS SPECIFIED ON PLAN SHEETS.
  - PHASE 4 – LANDSCAPING AND DEVELOPMENT**  
A. REVEGETATE LOT AND PARKWAYS.  
B. LANDSCAPE CONTRACTOR SHALL REVEGETATE ALL AREAS RESERVED FOR LANDSCAPE VEGETATIVE COVERS.  
C. REMOVE EROSION CONTROL DEVICES WHEN GROUND COVER ESTABLISHED.

#### SITE MAP-GENERAL NOTES

- CONTRACTOR IS SOLELY RESPONSIBLE FOR SELECTION, IMPLEMENTATION, MAINTENANCE, AND EFFECTIVENESS OF ALL SWPPP CONTROLS – CONTROLS SHOWN ON THIS SITE MAP ARE SUGGESTED CONTROLS ONLY.
- CONTRACTOR SHALL RECORD INSTALLATION, MAINTENANCE OR MODIFICATION, AND REMOVAL DATES FOR EACH BMP EMPLOYED (WHETHER CALLED OUT ON ORIGINAL SWPPP OR NOT) DIRECTLY ON THE SITE MAP.
- DRAINAGE PATTERNS ARE SHOWN ON THIS PLAN BY PROPOSED AND EXISTING CONTOURS, FLOW ARROWS, AND SLOPES.
- TEMPORARY AND PERMANENT STABILIZATION PRACTICES AND BMP'S SHALL BE INSTALLED AT THE EARLIEST POSSIBLE TIME DURING THE CONSTRUCTION SEQUENCE. AS AN EXAMPLE, PERIMETER SILT FENCE SHALL BE INSTALLED BEFORE COMMENCEMENT OF ANY GRADING ACTIVITIES. OTHER BMP'S SHALL BE INSTALLED AS SOON AS PRACTICABLE AND SHALL BE MAINTAINED UNTIL FINAL SITE STABILIZATION IS ATTAINED. CONTRACTOR SHALL ALSO REFERENCE CIVIL AND LANDSCAPE PLANS SINCE PERMANENT STABILIZATION IS PROVIDED BY LANDSCAPING, THE BUILDING(S), AND SITE PAVING.
- BMP'S HAVE BEEN LOCATED AS INDICATED ON THIS PLAN IN ACCORDANCE WITH GENERALLY ACCEPTED ENGINEERING PRACTICES IN ORDER TO MINIMIZE SEDIMENT TRANSFER. FOR EXAMPLE: SILT FENCES LOCATED AT TOE OF SLOPE AND INLET PROTECTION FOR INLETS RECEIVING SEDIMENT FROM SITE RUN-OFF.
- SANITARY SEWER EFFLUENT IS DISPOSED OF VIA AN ONSITE SEWER SYSTEM CONNECTED TO A MUNICIPAL SEWER SYSTEM.
- NO STEEL POSTS IN TOWN R.O.W.

### DALLAS NORTH TOLLWAY

(VARIABLE WIDTH PUBLIC RIGHT-OF-WAY)

#### VEGETATIVE STABILIZATION REQUIREMENTS


TEMPORARY SEEDING		
ALL DISTURBED AREAS WHICH WILL BE LEFT DORMANT FOR GREATER THAN 14 DAYS SHALL BE SEEDED WITH FAST-GERMINATING TEMPORARY VEGETATION IMMEDIATELY FOLLOWING GRADING OPERATIONS. SELECTION OF THE SEED WILL DEPEND ON THE TIME OF YEAR IT IS APPLIED (SEE DESCRIPTIONS IN TABLE 2). REFERENCE LANDSCAPE PLAN FOR PERMANENT STABILIZATION REQUIREMENTS. ALL TEMPORARY SEEDING MATERIALS SHALL BE APPROVED BY THE OWNER'S REPRESENTATIVE PRIOR TO APPLICATION.		
TABLE 2 VEGETATION TABLE*		
TEMPORARY SEEDING SPECIES	PLANTING RATE 7#/ACRE	PLANTING-DATES 8/15 - 11/30
CRIMSON CLOVER	7#/ACRE	5/1 - 8/31
MILLET, FOXTAIL	30#/ACRE	8/15 - 9/30
RYEGRASS, ANNUAL	30#/ACRE	2/1 - 5/1
SPRANGLETOP, GREEN	2.5#/ACRE	9/1 - 10/15
TALL FESCUE	7#-10#/1000 SF	
*USE ONLY USDA CERTIFIED SEED.		

SURFACE PREPARATION FOR TEMPORARY SEEDING	
1. INSTALL EROSION STRUCTURES SUCH AS DIKES, DIVERSIONS, ETC. PRIOR TO SEEDING.	
2. FURROW SLOPES STEEPER THAN 3:1 ON THE CONTOUR LINE BEFORE SEEDING.	
3. ENSURE SEED BED IS PULVERIZED, LOOSE, AND UNIFORM.	
APPLICATION	
1. WHEN HYDROMULCHING IS USED, DO NOT MIX SEED AND FERTILIZER MORE THAN 30 MINUTES PRIOR TO APPLICATION.	
2. APPLY SEED EVENLY USING PROPER EQUIPMENT AND WATER TO AID VEGETATION GROWTH.	
3. EROSION CONTROL NETTING SHALL BE INSTALLED OVER FILL SLOPES WHICH HAVE BEEN BROUGHT TO FINAL GRADE AND HAVE BEEN SEED TO PROTECT AGAINST EROSION. MULCH (STRAW OR FIBER) SHALL BE USED ON RELATIVELY FLAT SLOPES.	

SITE DATA	
TOTAL SITE AREA	7.16 AC.
TOTAL SITE AREA DISTURBED	7.00 AC.
TOTAL OFF-SITE AREA DISTURBED	0.00 AC.
TOTAL AREA DISTURBED *	7.00 AC.
NEW PAVED AREA	2.73 AC.
NEW ROOFED AREA	1.27 AC.
NEW SEEDED/GROUND COVER AREA	3.16 AC.
PRE-DEVELOPMENT RUNOFF COEFFICIENT	0.30
POST-DEVELOPMENT RUNOFF COEFFICIENT	0.90

\* DOES NOT INCLUDE ANY OFF-SITE DISPOSAL OR BORROW AREAS – CONTRACTOR TO UPDATE AS NECESSARY DURING CONSTRUCTION.

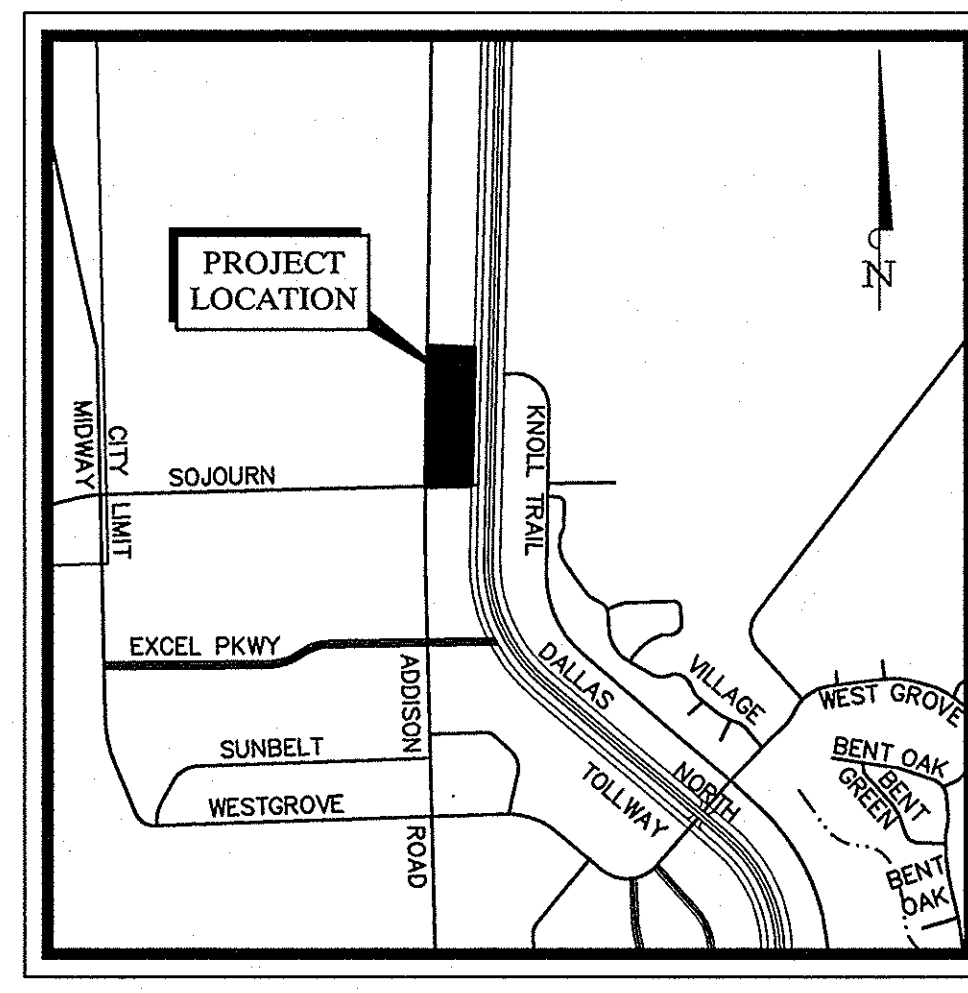

#### RECORD DRAWINGS (SEPTEMBER 2010)

INFORMATION PROVIDED BY:  
Rogers-O'Brien Construction Company

#### STANDARD EROSION CONTROL GENERAL NOTES

- EROSION CONTROL DEVICES AS SHOWN ON THE EROSION CONTROL PLAN FOR THE PROJECT SHALL BE INSTALLED PRIOR TO THE START OF LAND DISTURBING ACTIVITIES ON THE PROJECT.
- ALL EROSION CONTROL DEVICES ARE TO BE INSTALLED IN ACCORDANCE WITH THE APPROVED PLANS AND SPECIFICATIONS FOR THE PROJECT. CHANGES ARE TO BE APPROVED BEFORE CONSTRUCTION BY THE DESIGN ENGINEER AND THE TOWN OF ADDISON ENGINEERING DEPARTMENT.
- IF THE EROSION CONTROL PLAN AS APPROVED CANNOT CONTROL EROSION AND OFF-SITE SEDIMENTATION FROM THE PROJECT THE EROSION CONTROL PLAN WILL BE REQUIRED TO BE REVISED AND/OR ADDITIONAL EROSION CONTROL DEVICES WILL BE REQUIRED ON SITE.
- IF OFF-SITE BORROW OR SPOILS SITES ARE USED IN CONJUNCTION WITH THIS PROJECT, THIS INFORMATION SHALL BE DISCLOSED AND SHOWN ON THE EROSION CONTROL PLAN. OFF-SITE BORROW AND SPOILS AREAS ARE CONSIDERED PART OF THE PROJECT SITE AND THEREFORE SHALL COMPLY WITH THE TOWN OF ADDISON EROSION CONTROL REQUIREMENTS. THESE AREAS SHALL BE STABILIZED WITH GROUND COVER PRIOR TO FINAL APPROVAL OF THE PROJECT.

THE CONTRACTOR SHALL FIELD VERIFY THE HORIZONTAL AND VERTICAL LOCATIONS OF ALL EXISTING UTILITIES PRIOR TO START OF CONSTRUCTION AND SHALL NOTIFY THE CONSTRUCTION MANAGER AND ENGINEER OF ANY CONFLICTS DISCOVERED. CONTRACTOR IS RESPONSIBLE FOR PROTECTING EXISTING UTILITIES (SHOWN OR NOT SHOWN) WITHIN SCOPE OF CONSTRUCTION. IF ANY EXISTING UTILITIES ARE DAMAGED, THE CONTRACTOR SHALL REPLACE THEM AT HIS OWN EXPENSE. CALL 1-800-DIG-TESS AT LEAST 72 HOURS PRIOR TO COMMENCING CONSTRUCTION IN VICINITY.

#### STOP! CALL BEFORE YOU DIG

**DIG TESS**  
1-800-DIG-TESS  
(@ least 72 hours prior to digging)

#### BENCHMARK

- "I" FOUND ON TOP OF THE CONCRETE BASE OF A LIGHT POLE IN THE CENTER MEDIAN OF EXCEL PARKWAY APPROXIMATELY 50 FEET WEST OF THE CENTERLINE OF ADDISON ROAD. (PER TOWN OF ADDISON PLAN # 95103, SHEET 2, DATED JANUARY 1998) ELEV=644.41
- BM #60" SET ON TOP OF A CONCRETE CURB INLET LOCATED ON THE WEST SIDE OF DALLAS PARKWAY APPROXIMATELY 826 FEET NORTH OF THE CENTERLINE OF SOJOURN DRIVE. ELEV=632.78
- BM #61" SET ON TOP OF A CONCRETE CURB INLET LOCATED ON THE WEST SIDE OF DALLAS PARKWAY APPROXIMATELY 160 FEET NORTH OF THE CENTERLINE OF SOJOURN DRIVE. ELEV=638.04

IMAGES COURTESY OF... KIMLEY-HORN AND ASSOCIATES, INC. 5750 GENESIS COURT, SUITE 200 PRISCO, TEXAS 75034 STATE OF TEXAS REGISTRATION NO. F-928

Kimley-Horn and Associates, Inc.  
Tel. No. (972) 335-3580  
Fax No. (972) 335-3779

5750 Genesis Court, Suite 200  
Prisco, Texas 75034  
State of Texas Registration No. F-928

DAVID K. KOCHALKO  
87781  
LICENSED PROFESSIONAL ENGINEER

METHODIST HOSPITAL FOR SURGERY  
ADDISON, TEXAS  
FILE NUMBER: 311T-7863

EROSION CONTROL PLAN

SHEET  
C-18

Scale: AS SHOWN  
Designed by: RCO  
Drawn by: RCO  
Checked by: DKK  
Date: 11/09/09  
Project No.: 6902500

**CONSTRUCTION SPECIFICATIONS FOR SILT BARRIER FENCE MATERIALS:**

1. SYNTHETIC FILTER FABRIC SHALL BE A PERVIOUS SHEET OF PROPYLENE, NYLON, POLYESTER OR ETHYLENE YARN AND SHALL BE CERTIFIED BY THE MANUFACTURER OR SUPPLIER AS CONFORMING TO THE FOLLOWING REQUIREMENTS (PER ASTM METHODS):

PHYSICAL PROPERTY	REQUIREMENTS
FILTERING EFFICIENCY	75% (MIN.)
TENSILE STRENGTH AT 20% EXT. STRENGTH = 50 LBS./LIN. IN. (MIN.)	
MAXIMUM ELONGATION STD. STRENGTH = 30 LBS./LIN. IN. (MIN.)	
FLOW RATE 30 GAL./SQ. FT./MINUTE (MIN.)	





2. SYNTHETIC FILTER FABRIC SHALL CONTAIN ULTRAVIOLET RAY INHIBITORS AND STABILIZERS TO PROVIDE A MINIMUM OF 6 MONTHS OF EXPECTED USABLE CONSTRUCTION LIFE AT A TEMPERATURE RANGE OF 0 TO 120°.

**INSTALLATION:**


- THE HEIGHT OF THE SILT FENCE SHALL BE A MINIMUM OF 15" AND A MAXIMUM OF 18" ABOVE FINAL GRADE.
- STANDARD STRENGTH SYNTHETIC FILTER FABRIC SHALL BE PURCHASED IN A CONTINUOUS ROLL AND CUT TO THE LENGTH OF THE BARRIER TO AVOID THE USE OF JOINTS (AND THUS IMPROVE THE BARRIER'S STRENGTH AND EFFICIENCY).
- STAKES FOR THE SILT FENCE SHALL BE 2"x 2" WOOD WITH A MINIMUM LENGTH OF 3 FEET.
- THE STAKES SHALL BE SPACED A MAXIMUM OF 5 FEET APART AT THE BARRIER LOCATION AND DRIVEN SECURELY INTO THE GROUND (18" MIN.).
- A TRENCH SHALL BE EXCAVATED APPROX. 6" WIDE AND 6" DEEP ALONG THE LINE OF STAKES AND UPSLOPE FROM THE BARRIER.
- THE SILT FENCE SHALL BE STAPLED TO THE STAKES WITH 8" (MIN.) OF FABRIC EXTENDED INTO THE TRENCH. HEAVY DUTY WIRE STAPLES (1/2" INCH LONG MIN.) SHALL BE USED. THE FENCE SHALL NOT BE STAPLED TO EXISTING TREES.
- THE TRENCH SHALL BE BACKFILLED AND THE SOIL COMPACTED OVER THE FENCE MATERIAL.
- IF A SILT FENCE IS TO BE CONSTRUCTED ACROSS A DITCH LINE OR SWALE, THE BARRIER SHALL BE OF SUFFICIENT LENGTH TO ELIMINATE END FLOW. THE PLAN CONFIGURATION SHALL RESEMBLE AN ARC OR HORSESHOE WITH THE ENDS ORIENTED UPSLOPE.
- SILT FENCES SHALL BE REMOVED WHEN THEY HAVE SERVED THEIR USEFUL PURPOSE, BUT NOT BEFORE THE UPSLOPE AREA HAS BEEN PERMANENTLY STABILIZED.

**MAINTENANCE:**


- SILT FENCES SHALL BE INSPECTED IMMEDIATELY AFTER RAINFALL AND AT LEAST DAILY DURING PROLONGED RAINFALL. ANY REQUIRED REPAIRS SHALL BE MADE IMMEDIATELY.
- SHOULD THE FABRIC ON A SILT FENCE DECOMPOSE OR BECOME INEFFECTIVE PRIOR TO THE END OF THE EXPECTED USABLE LIFE AND THE SILT FENCE IS STILL NECESSARY, IT SHALL BE REPLACED IMMEDIATELY.
- SEDIMENT DEPOSITS SHALL BE REMOVED WHEN DEPOSITS REACH APPROXIMATELY 1/3 THE HEIGHT OF THE FENCE.
- ANY SEDIMENT DEPOSITS REMAINING IN PLACE AFTER THE SILT FENCE IS NO LONGER REQUIRED SHALL BE DRESSED TO CONFORM WITH THE EXISTING GRADE, PREPARED AND SEEDED.
- THERE SHOULD BE NO GAPS OR SAGS IN THE SILT FENCE.

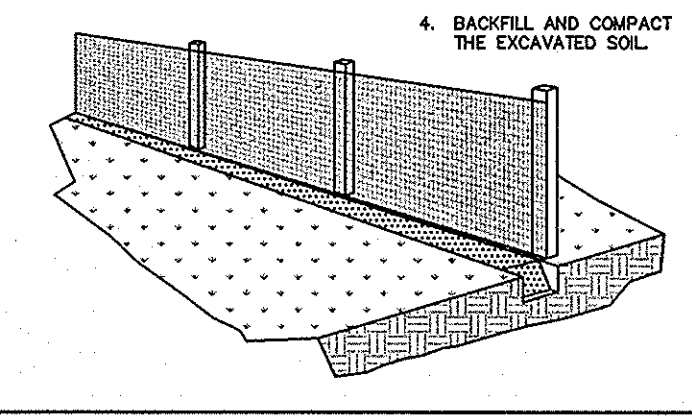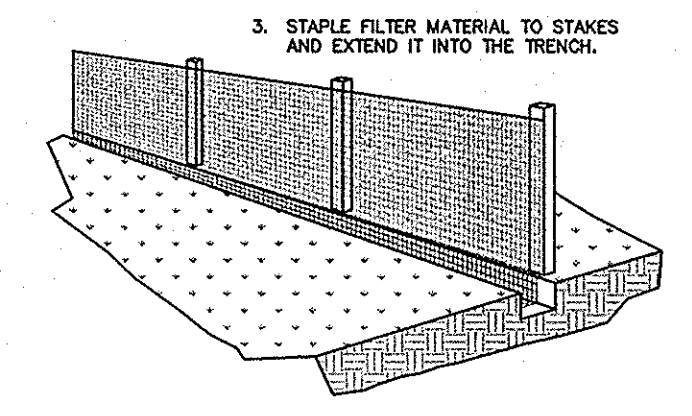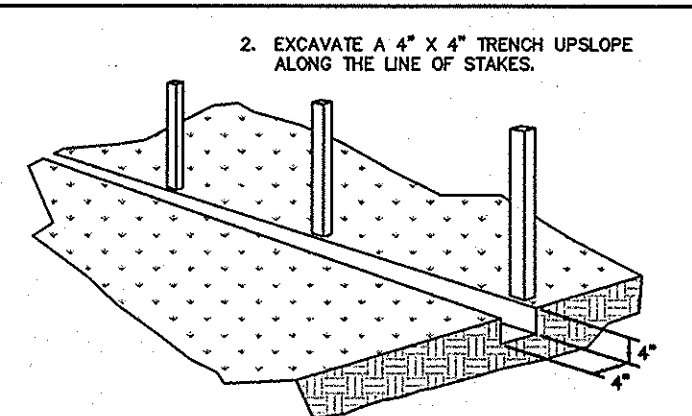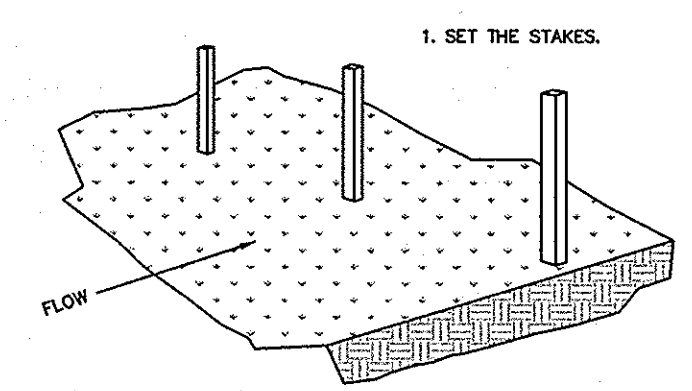


**CONSTRUCTION OF A FILTER BARRIER**  
N.T.S.

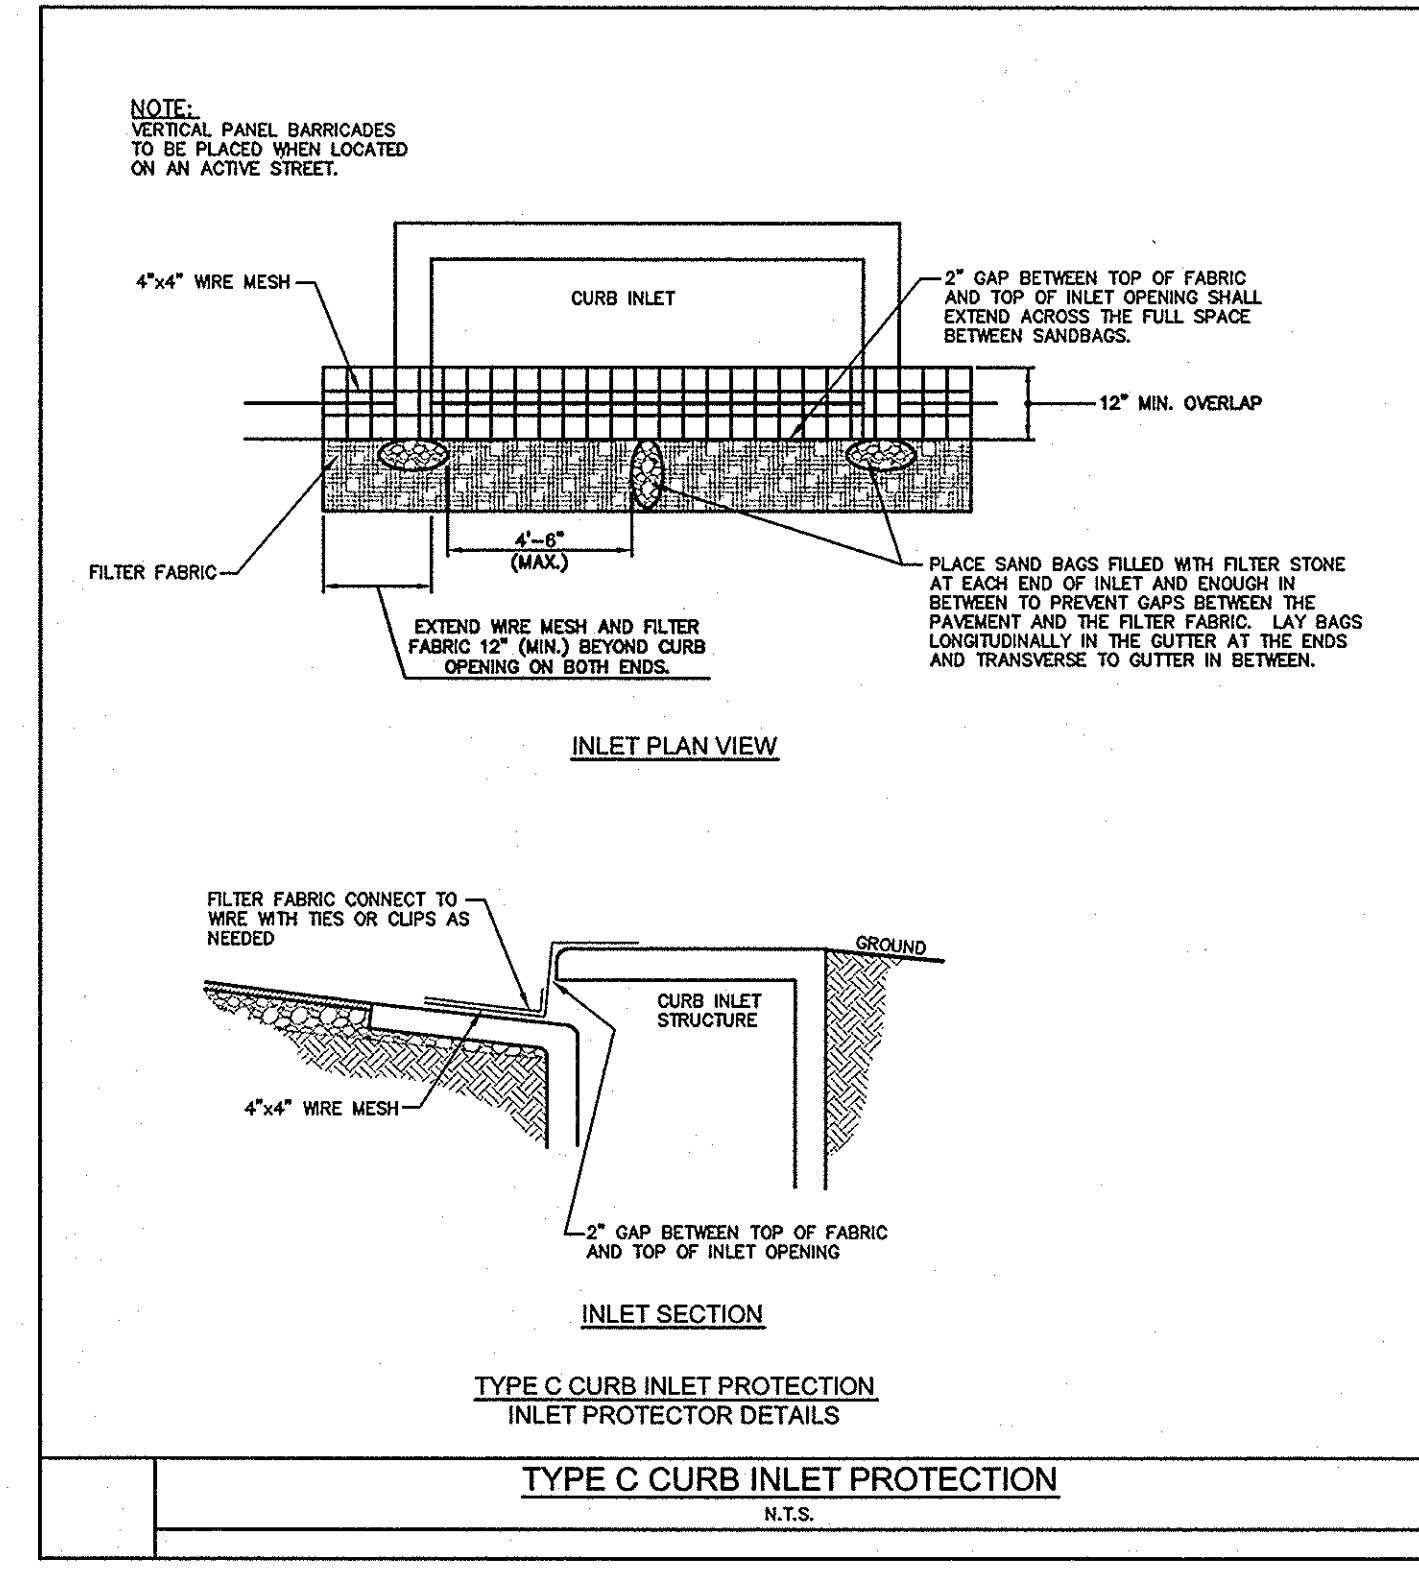

**TYPE C CURB INLET PROTECTION**  
N.T.S.

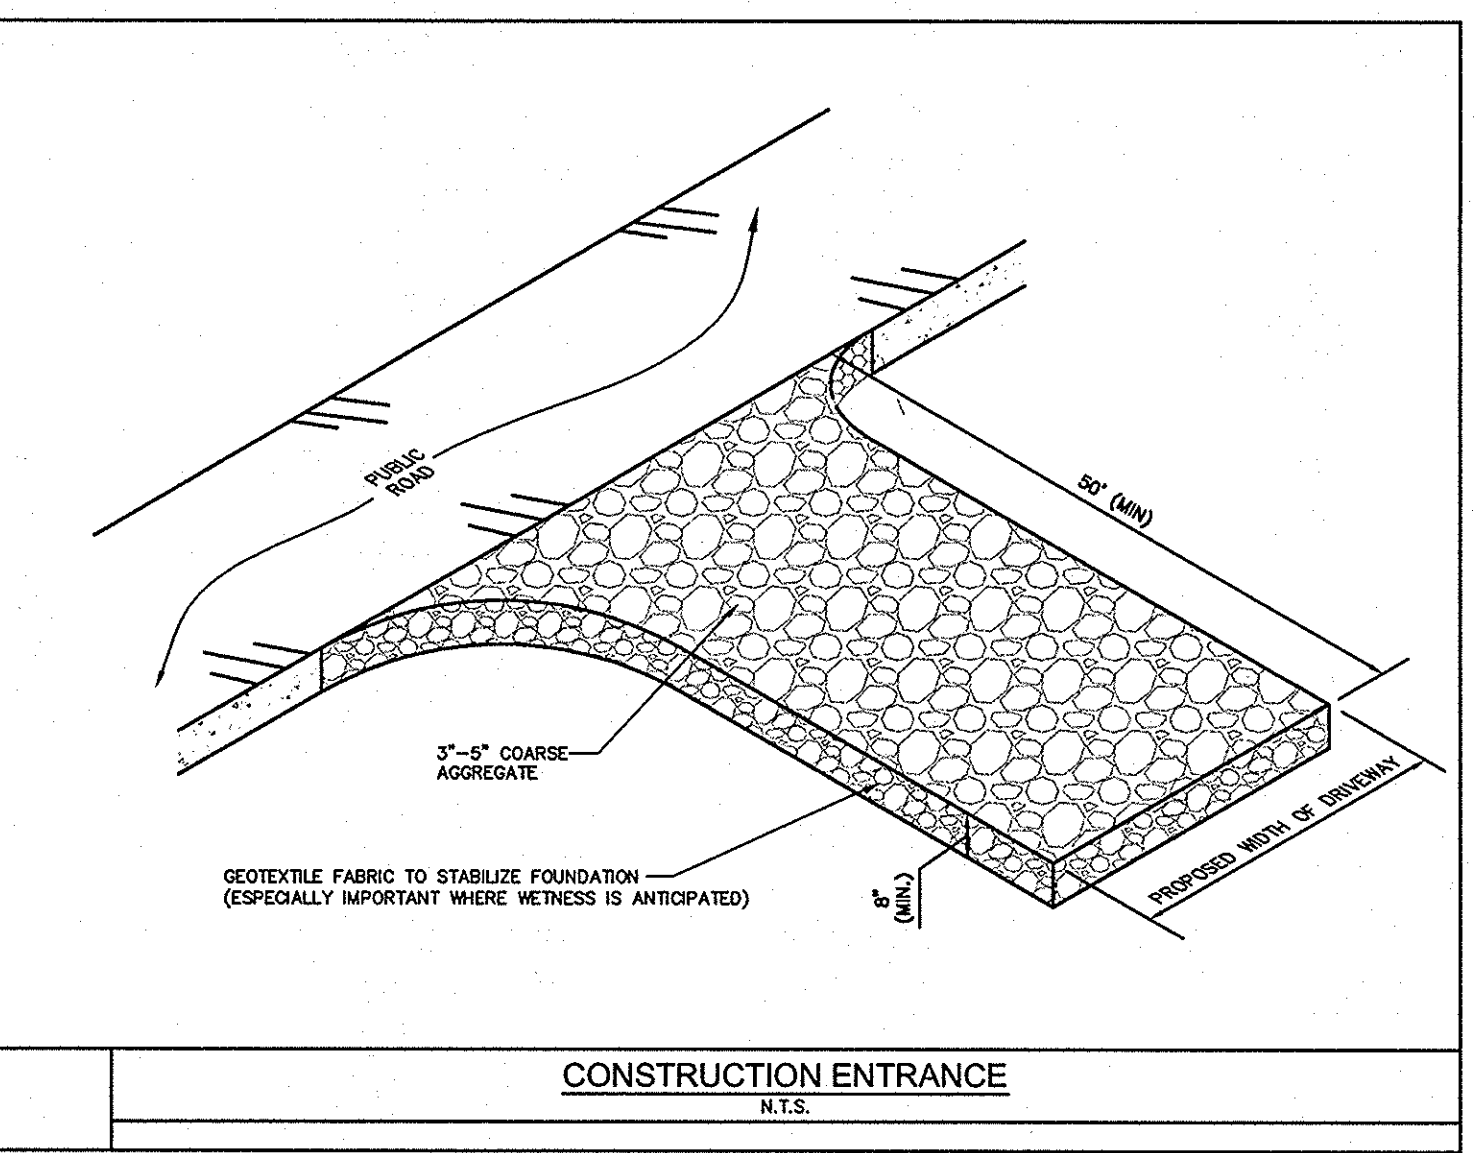


**CONSTRUCTION ENTRANCE**  
N.T.S.

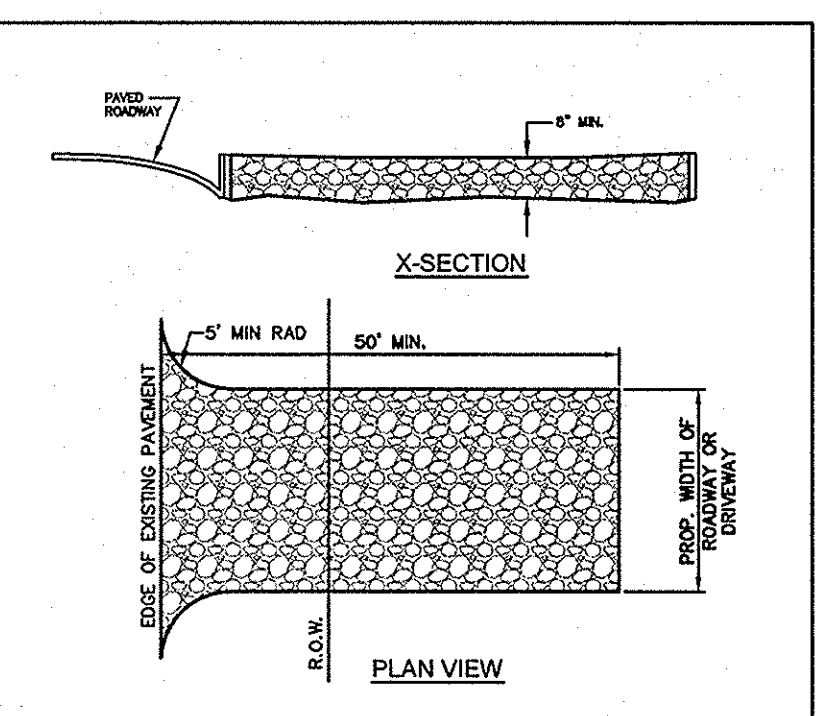


- NOTES:**
- Stone size - 3 to 5 inches crushed rock.
  - Length - as effective, but not less than 50 feet.
  - Thickness - not less than 8 inches.
  - Width - not less than full width of all points of ingress or egress.
  - Washing - when necessary, wheels shall be cleaned to remove sediment prior to entrance onto public roadway. When washing is required, it shall be done on an area stabilized with crushed stone which drains into an approved trap or sediment basin. All sediment shall be prevented from entering any storm drain, ditch or watercourse using approved methods.
  - Maintenance - the entrance shall be maintained in condition which will prevent tracking or flowing of sediment onto public roadways. This may require periodic top dressing with additional stone as conditions demand, and repair and/or cleanup of any measures used to trap sediment. All sediment spilled, dropped, washed or tracked onto public roadway, must be removed immediately.
  - Drainage - entrance must be properly graded or incorporate a drainage sedge to prevent runoff from leaving the construction site.
  - Contractor to coordinate exact location of this detail.

**CONSTRUCTION ENTRANCE**  
N.T.S.

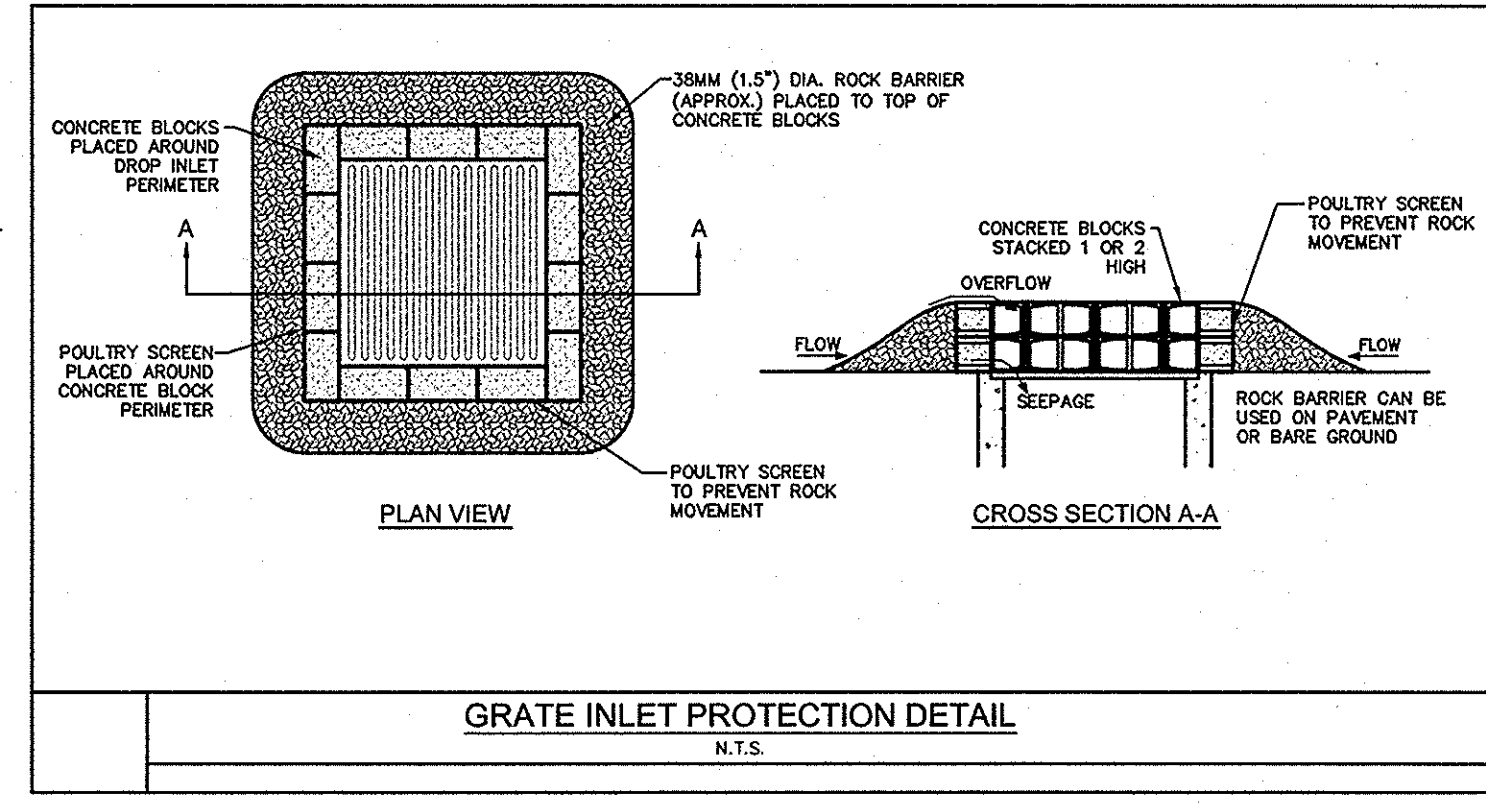

**GRATE INLET PROTECTION DETAIL**  
N.T.S.

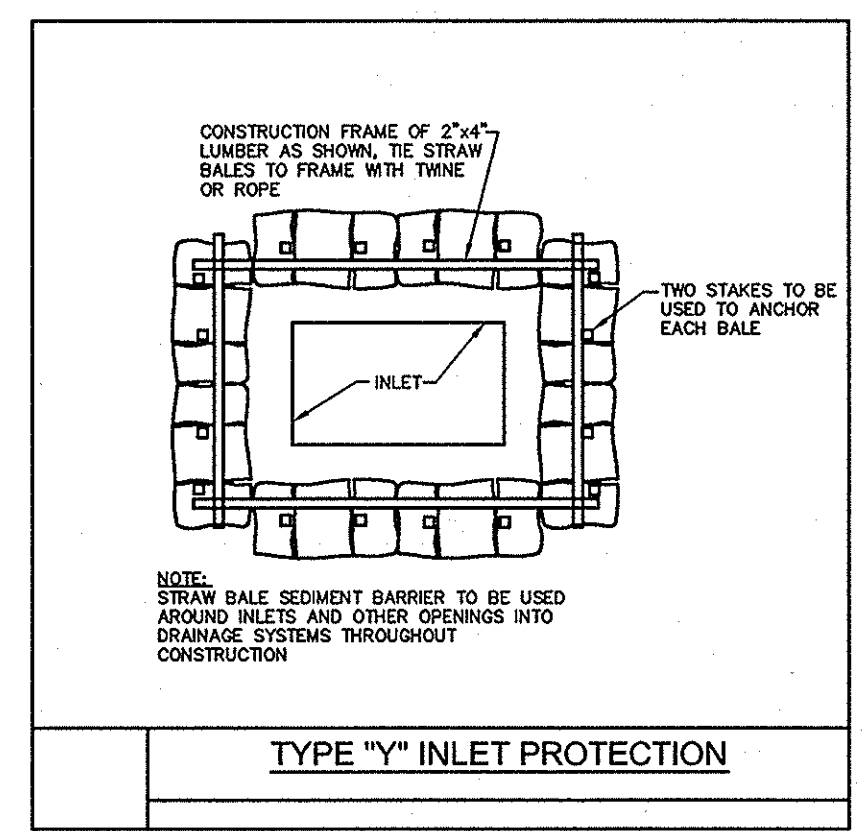

**TYPE "Y" INLET PROTECTION**

**GENERAL NOTES:**

- ALL EROSION CONTROL DEVICES SHALL BE INSTALLED PRIOR TO SITE DISTURBANCE AND SHALL REMAIN IN PLACE UNTIL FINAL GRADING AND PAVING IS COMPLETE AND A STAND OF GRASS IS ESTABLISHED WITH 70% COVERAGE ACHIEVED.
- CONSTRUCTION OPERATIONS SHALL BE MANAGED SO THAT AS MUCH OF THE SITE AS POSSIBLE IS LEFT COVERED WITH TOPSOIL AND VEGETATION.
- ALL AREAS DISTURBED BY CONSTRUCTION OPERATIONS MUST BE SEEDED AND IRRIGATED UNTIL A PERMANENT STAND OF GRASS IS ACHIEVED WITH A MINIMUM OF 70% COVERAGE.
- THE CONTRACTOR SHALL COMPLY WITH ALL FEDERAL, STATE, AND LOCAL EROSION, CONSERVATION, AND SILTATION ORDINANCES. THE CONTRACTOR SHALL REMOVE ALL TEMPORARY EROSION CONTROL DEVICES UPON COMPLETION OF PERMANENT DRAINAGE AND THE ESTABLISHMENT OF A STAND OF GRASS SUFFICIENT TO PREVENT EROSION.
- THE CONTRACTOR MUST USE SEDIMENT FILTERS OR OTHER MEASURES APPROVED BY THE ENGINEER AND CONSTRUCTION MANAGER TO PREVENT SILT AND CONSTRUCTION DEBRIS FROM CLOGGING STORM SEWER PIPES OR PROPOSED OR EXISTING INLETS, OR FROM BEING TRANSPORTED TO ADJACENT PROPERTIES.
- CONSTRUCTION ENTRANCE - MINIMUM SIZE STONE: 3"-5" CRUSHED ROCK THICKNESS: NOT LESS THAN 8" LENGTH: NOT LESS THAN 100' WIDTH: NOT LESS THAN FULL WIDTH OF ALL POINTS OF INGRESS AND EGRESS. MAINTENANCE REQUIREMENTS: AS NECESSARY TO PREVENT TRACKING OR FLOWING MUD INTO PUBLIC RIGHT-OF-WAY OR PARKING AREAS.
- PLACE INLET PROTECTION AROUND ALL PROPOSED INLETS DURING CONSTRUCTION.
- SITE ENTRY AND EXIT LOCATIONS SHALL BE MAINTAINED IN A CONDITION WHICH WILL PREVENT TRACKING OR FLOWING OF SEDIMENT ONTO PUBLIC ROADWAYS. ALL SEDIMENT SPILLED, DROPPED, WASHED OR TRACKED ON A PUBLIC ROADWAY MUST BE REMOVED IMMEDIATELY. WHEN WASHING IS REQUIRED TO REMOVE SEDIMENT PRIOR TO ENTRANCE TO A PUBLIC ROADWAY, IT SHALL BE DONE ON AN AREA STABILIZED WITH CRUSHED STONE WHICH DRAINS INTO AN APPROVED SEDIMENT BASIN. ALL FINES IMPOSED FOR TRACKING ONTO PUBLIC ROADS SHALL BE PAID BY THE CONTRACTOR.
- MAINTENANCE, EROSION CONTROLS SHALL BE REPAIRED OR REPLACED AS INSPECTION DEMANDS NECESSARY, OR AS DIRECTED BY THE OWNER'S REPRESENTATIVE. ACCUMULATED SILT IN ANY EROSION CONTROL DEVICE SHALL BE REMOVED AND SHALL BE DISTRIBUTED ON SITE IN A MANNER NOT CONTRIBUTING TO ADDITIONAL SILTATION.
- EROSION CONTROL MEASURES MAY ONLY BE PLACED IN FRONT OF INLETS, OR IN CHANNELS, DRAINAGE WAYS OR BORROW DITCHES AT RISK OF CONTRACTOR. CONTRACTOR SHALL REMAIN LIABLE FOR ANY DAMAGE CAUSED BY THE MEASURES, INCLUDING FLOODING DAMAGE, WHICH MAY OCCUR DUE TO BLOCKED DRAINAGE. AT THE CONCLUSION OF ANY PROJECT, ALL CHANNELS, DRAINAGE WAYS AND BORROW DITCHES IN THE WORK ZONE SHALL BE DREDGED OF ANY SEDIMENT GENERATED BY THE PROJECT OR DEPOSITED AS A RESULT OF EROSION CONTROL MEASURES.
- THE CONTRACTOR IS RESPONSIBLE FOR REESTABLISHING ANY EROSION CONTROL DEVICE WHICH THEY DISTURB. EACH CONTRACTOR SHALL NOTIFY THE OWNER'S REPRESENTATIVE OF ANY DEFICIENCIES IN THE ESTABLISHED EROSION CONTROL MEASURES WHICH MAY LEAD TO UNAUTHORIZED DISCHARGE OR STORM WATER POLLUTION, SEDIMENTATION OR OTHER POLLUTANTS. UNAUTHORIZED POLLUTANTS INCLUDE, BUT ARE NOT LIMITED TO, EXCESS CONCRETE DUMPING OR CONCRETE RESIDUE, PAINTS, SOLVENTS, GREASES, FUEL AND LUBE OIL, PESTICIDES, AND SOLID WASTE MATERIALS.
- THE CONTRACTOR SHALL MAINTAIN ADEQUATE SITE DRAINAGE DURING ALL PHASES OF CONSTRUCTION. THE CONTRACTOR SHALL USE FILTER BARRIER (OR OTHER METHOD APPROVED BY THE ENGINEER AND CITY) AS REQUIRED TO PREVENT SILT AND CONSTRUCTION DEBRIS FROM FLOWING ONTO ADJACENT PROPERTIES. CONTRACTOR SHALL COMPLY WITH ALL APPLICABLE FEDERAL, STATE, OR LOCAL EROSION, CONSERVATION, AND SILTATION ORDINANCES. CONTRACTOR SHALL REMOVE ALL TEMPORARY EROSION CONTROL DEVICES UPON COMPLETION OF PERMANENT DRAINAGE FACILITIES AND THE ESTABLISHMENT OF A STAND OF GRASS OR OTHER GROWTH TO PREVENT EROSION.
- THE CONTRACTOR SHALL CONSTRUCT FILTER BARRIER, STRAW BALES OR OTHER APPROVED DEVICES PRIOR TO CONSTRUCTION TO PREVENT ADVERSE OFF SITE IMPACT OR STORM WATER QUALITY AND AS REQUIRED BY THE CITY OF FORT WORTH. CONTRACTOR IS RESPONSIBLE FOR PROPER MAINTENANCE OF THE REQUIRED EROSION CONTROL DEVICES THROUGHOUT THE ENTIRE CONSTRUCTION PROCESS.
- CONTRACTOR IS RESPONSIBLE FOR REMOVING ALL SILT AND DEBRIS OFF SITE FROM THE EXISTING ROADWAYS AND PROJECT SITE THAT ARE A RESULT OF THE PROPOSED CONSTRUCTION AS REQUESTED BY THE CITY OF FORT WORTH.
- CONTRACTOR SHALL CONSTRUCT A STABILIZED CONSTRUCTION ENTRANCE AT ALL PRIMARY POINTS OF ACCESS. CONTRACTOR IS RESPONSIBLE FOR INSURING THAT ALL CONSTRUCTION TRAFFIC UTILIZES THE STABILIZED ENTRANCE AT ALL TIMES FOR INGRESS/EGRESS TO THE SITE.
- THE CONTRACTOR SHALL TAKE ALL AVAILABLE PRECAUTIONS TO CONTROL DUST. CONTRACTOR SHALL CONTROL DUST BY SPRINKLING WATER, OR BY OTHER MEANS APPROVED BY THE CITY AND ENGINEER, AT NO ADDITIONAL COST TO THE OWNER.
- BEFORE ANY EARTHWORK IS DONE, THE CONTRACTOR SHALL STAKE OUT AND MARK THE LIMITS OF CONSTRUCTION AND OTHER ITEMS ESTABLISHED BY THE PLANS. THE CONTRACTOR SHALL PROTECT AND PRESERVE CONTROL POINTS AT ALL TIMES DURING THE COURSE OF THE PROJECT. THE GRADING CONTRACTOR SHALL PROVIDE ALL NECESSARY ENGINEERING AND SURVEYING FOR LINE AND GRADE CONTROL POINTS RELATED TO EARTHWORK.
- THE CONTRACTOR SHALL SALVAGE AND PROTECT ALL EXISTING POWER POLES, SIGNS, MANHOLES, TELEPHONE RISERS, WATER VALVES, ETC. DURING ALL CONSTRUCTION PHASES UNLESS NOTED OTHERWISE.
- CONTRACTOR STAGING AREA TO BE AGREED UPON BY OWNER PRIOR TO CONSTRUCTION.

**NOTE:**

FOR WORK WITHIN THE CITY OF DALLAS REFER TO THE CITY OF DALLAS CONSTRUCTION STANDARDS AS SPECIFIED IN THE FILE 2510-1.

**RECORD DRAWINGS**  
**(SEPTEMBER 2010)**

INFORMATION PROVIDED BY:  
Rogers-O'Brien Construction Company

App. \_\_\_\_\_  
Revisions \_\_\_\_\_  
Date \_\_\_\_\_  
No. \_\_\_\_\_

**Kimley-Horn and Associates, Inc.**  
Tel. No. (972) 335-3580  
Fax No. (972) 335-3779  
5750 Genesis Court, Suite 200  
Frisco, Texas 75034  
State of Texas Registration No. E-928

**METHODIST HOSPITAL FOR SURGERY**  
ADDISON, TEXAS  
FILE NUMBER: 311T-7863





**EROSION CONTROL DETAILS**

Scale: AS SHOWN  
Designed by: RCO  
Drawn by: RCO  
Checked by: DMK  
Date: 11/3/09  
Project No. 6905200

SHEET  
**C-19**

DATE PLOTTED: 11/03/09 11:00 AM  
PLOTTER: HP DesignJet 2450  
SCALE: 1/8" = 1'-0"  
SHEET: C-19  
PROJECT: METHODIST ADISON HOSPITAL SURGERY




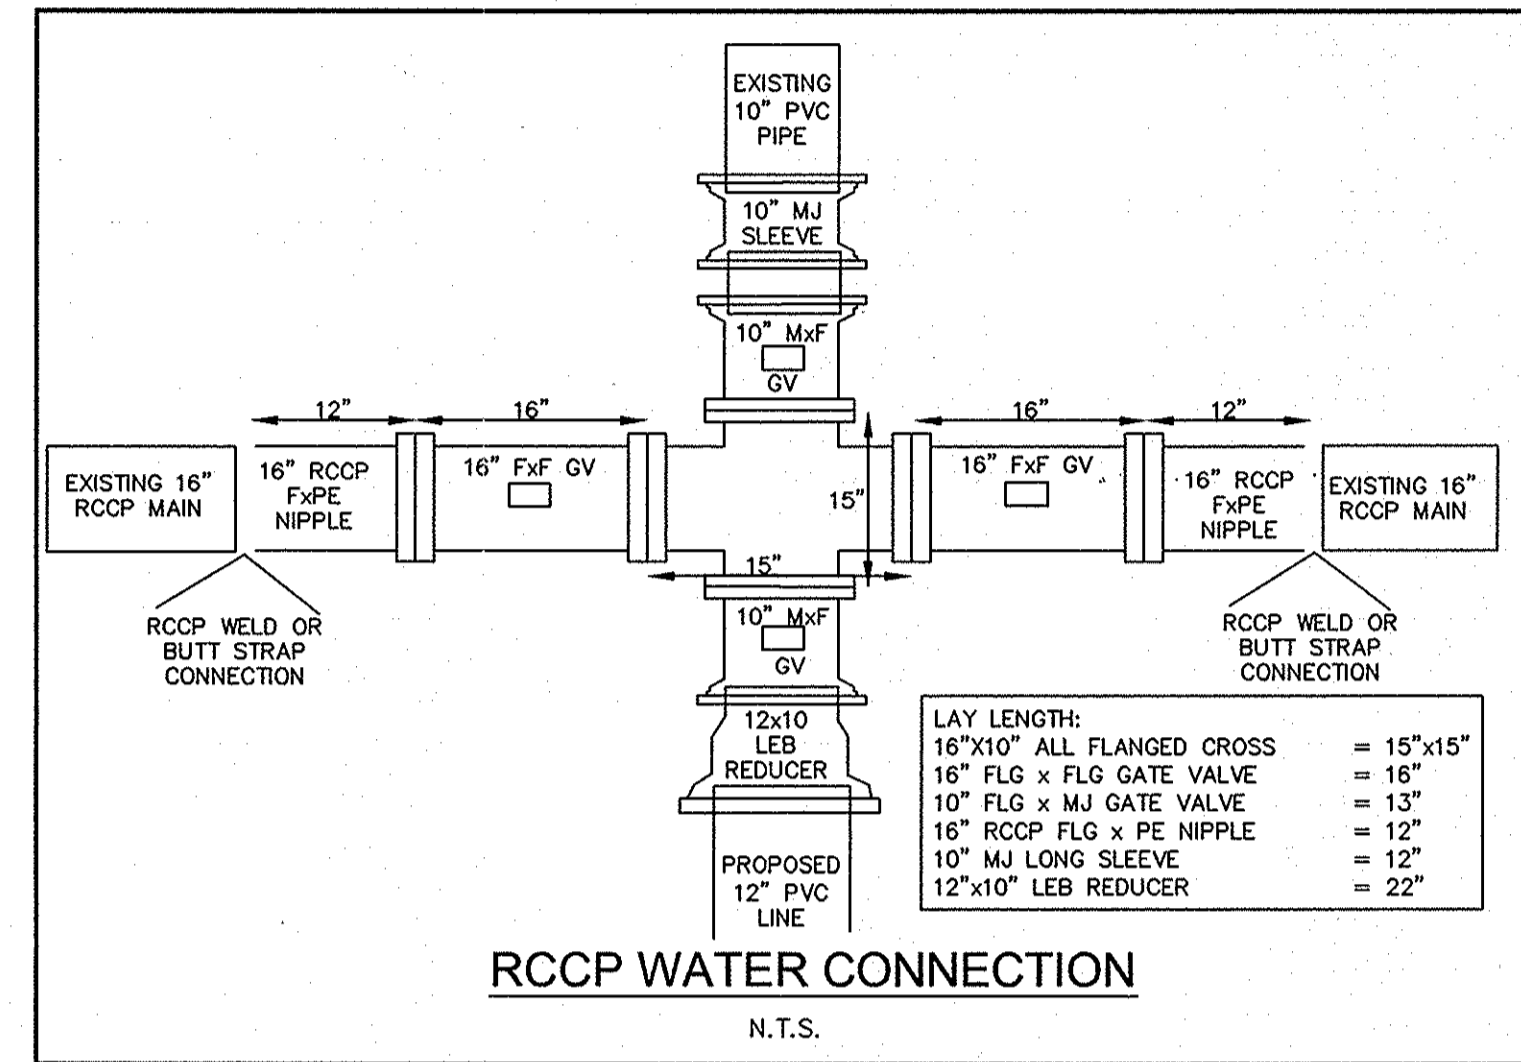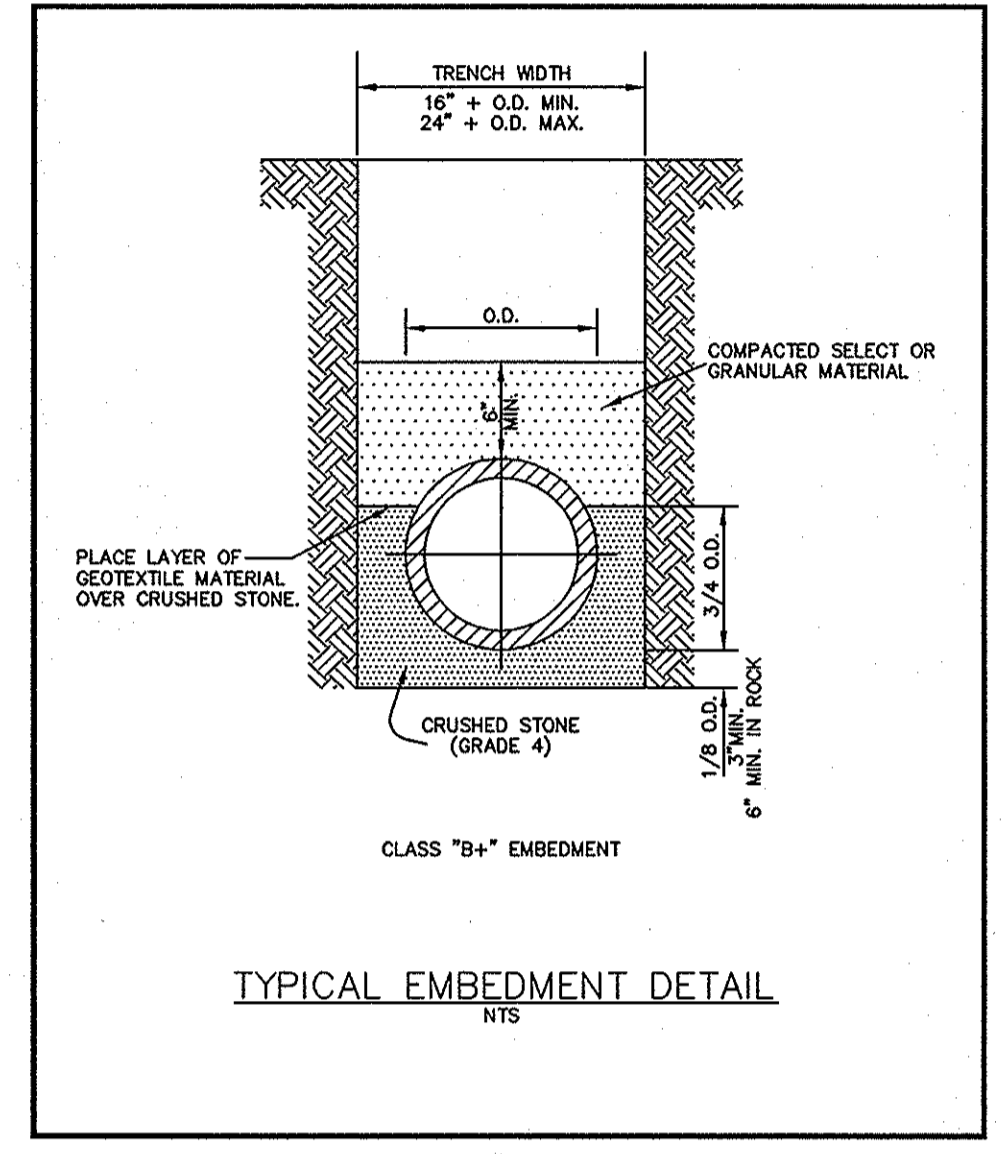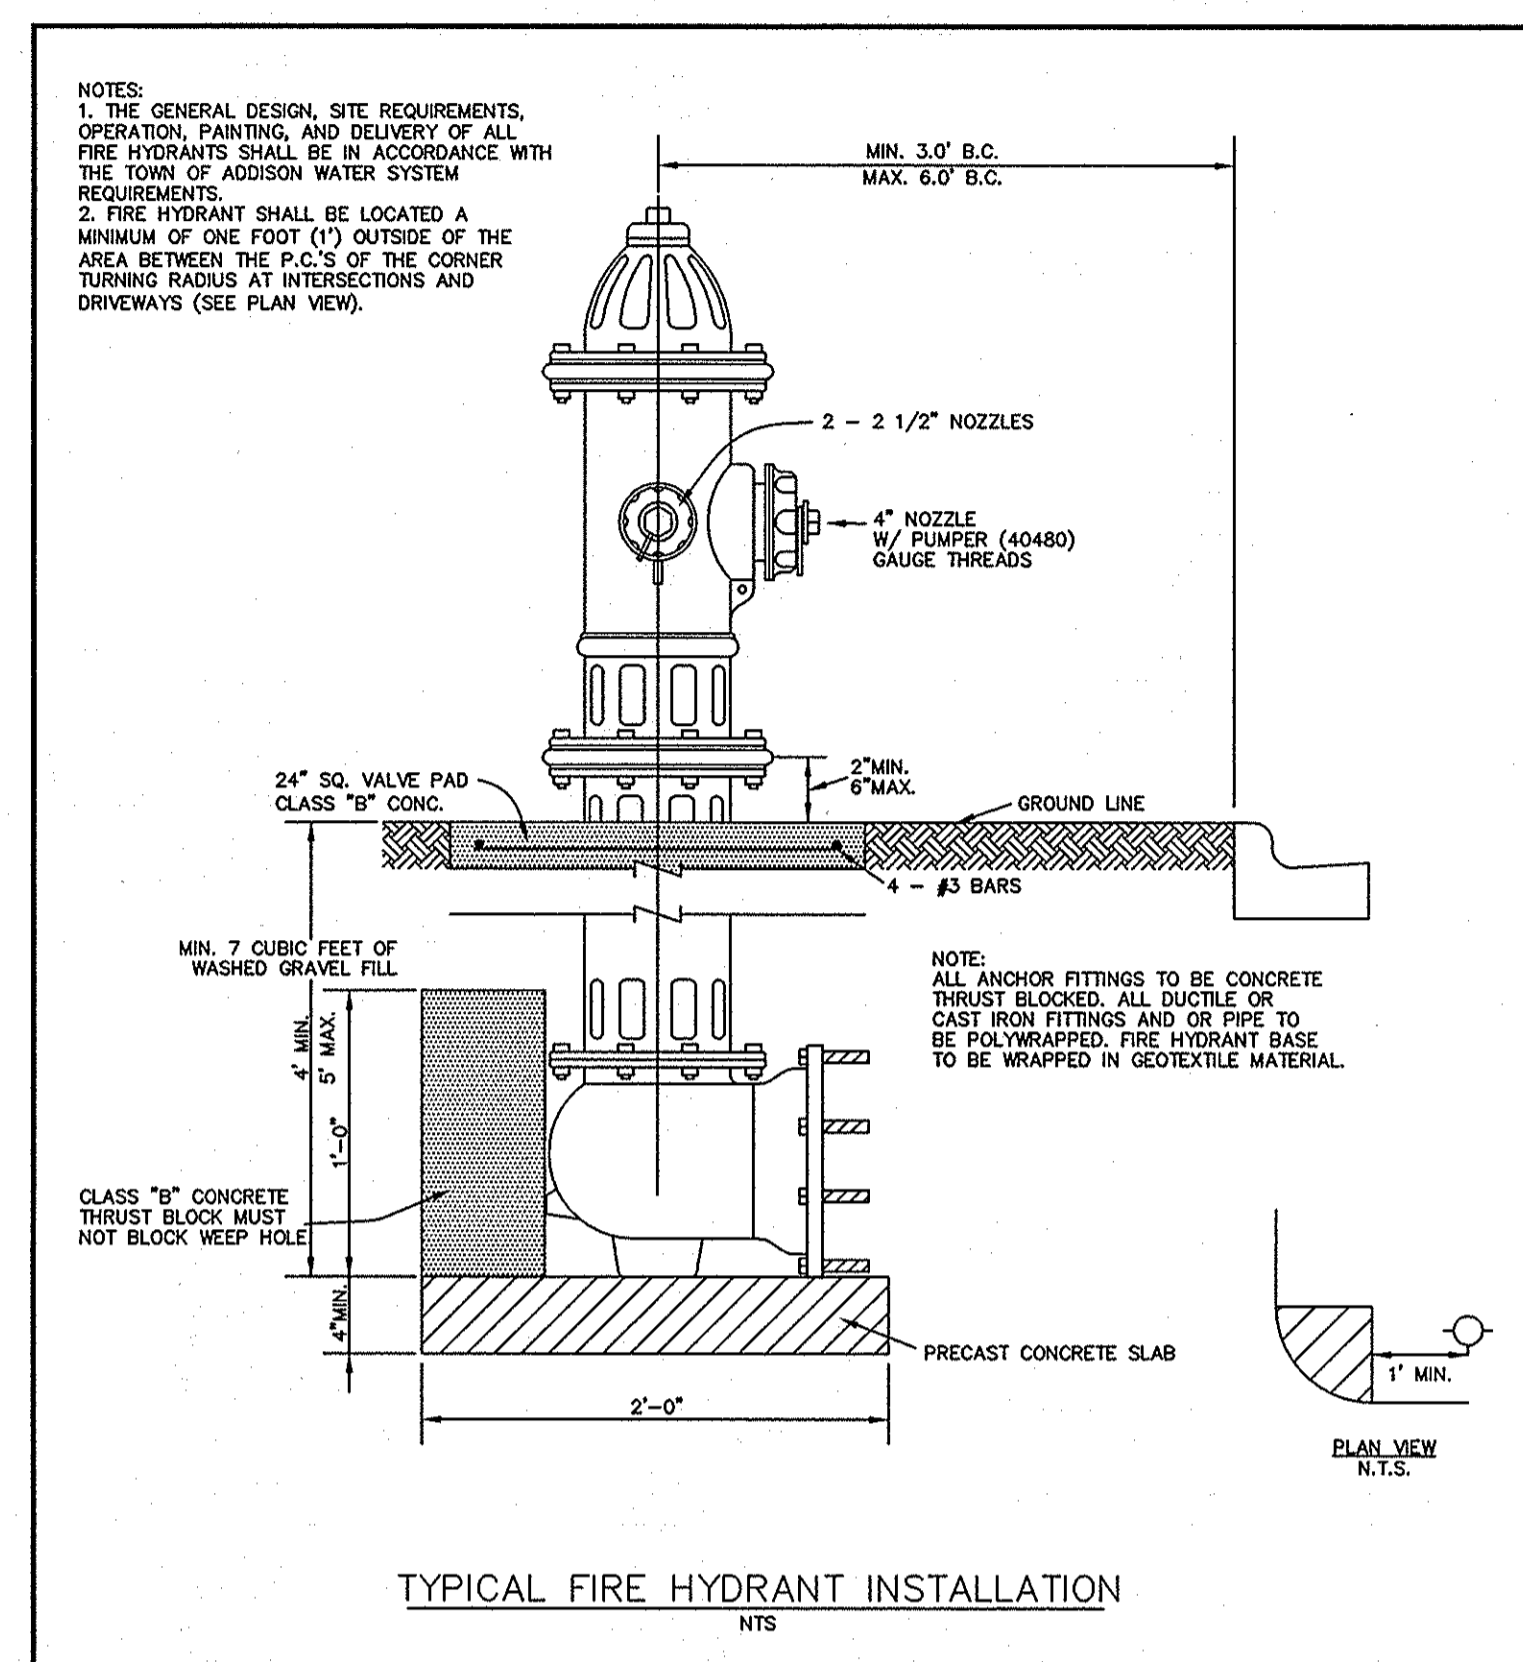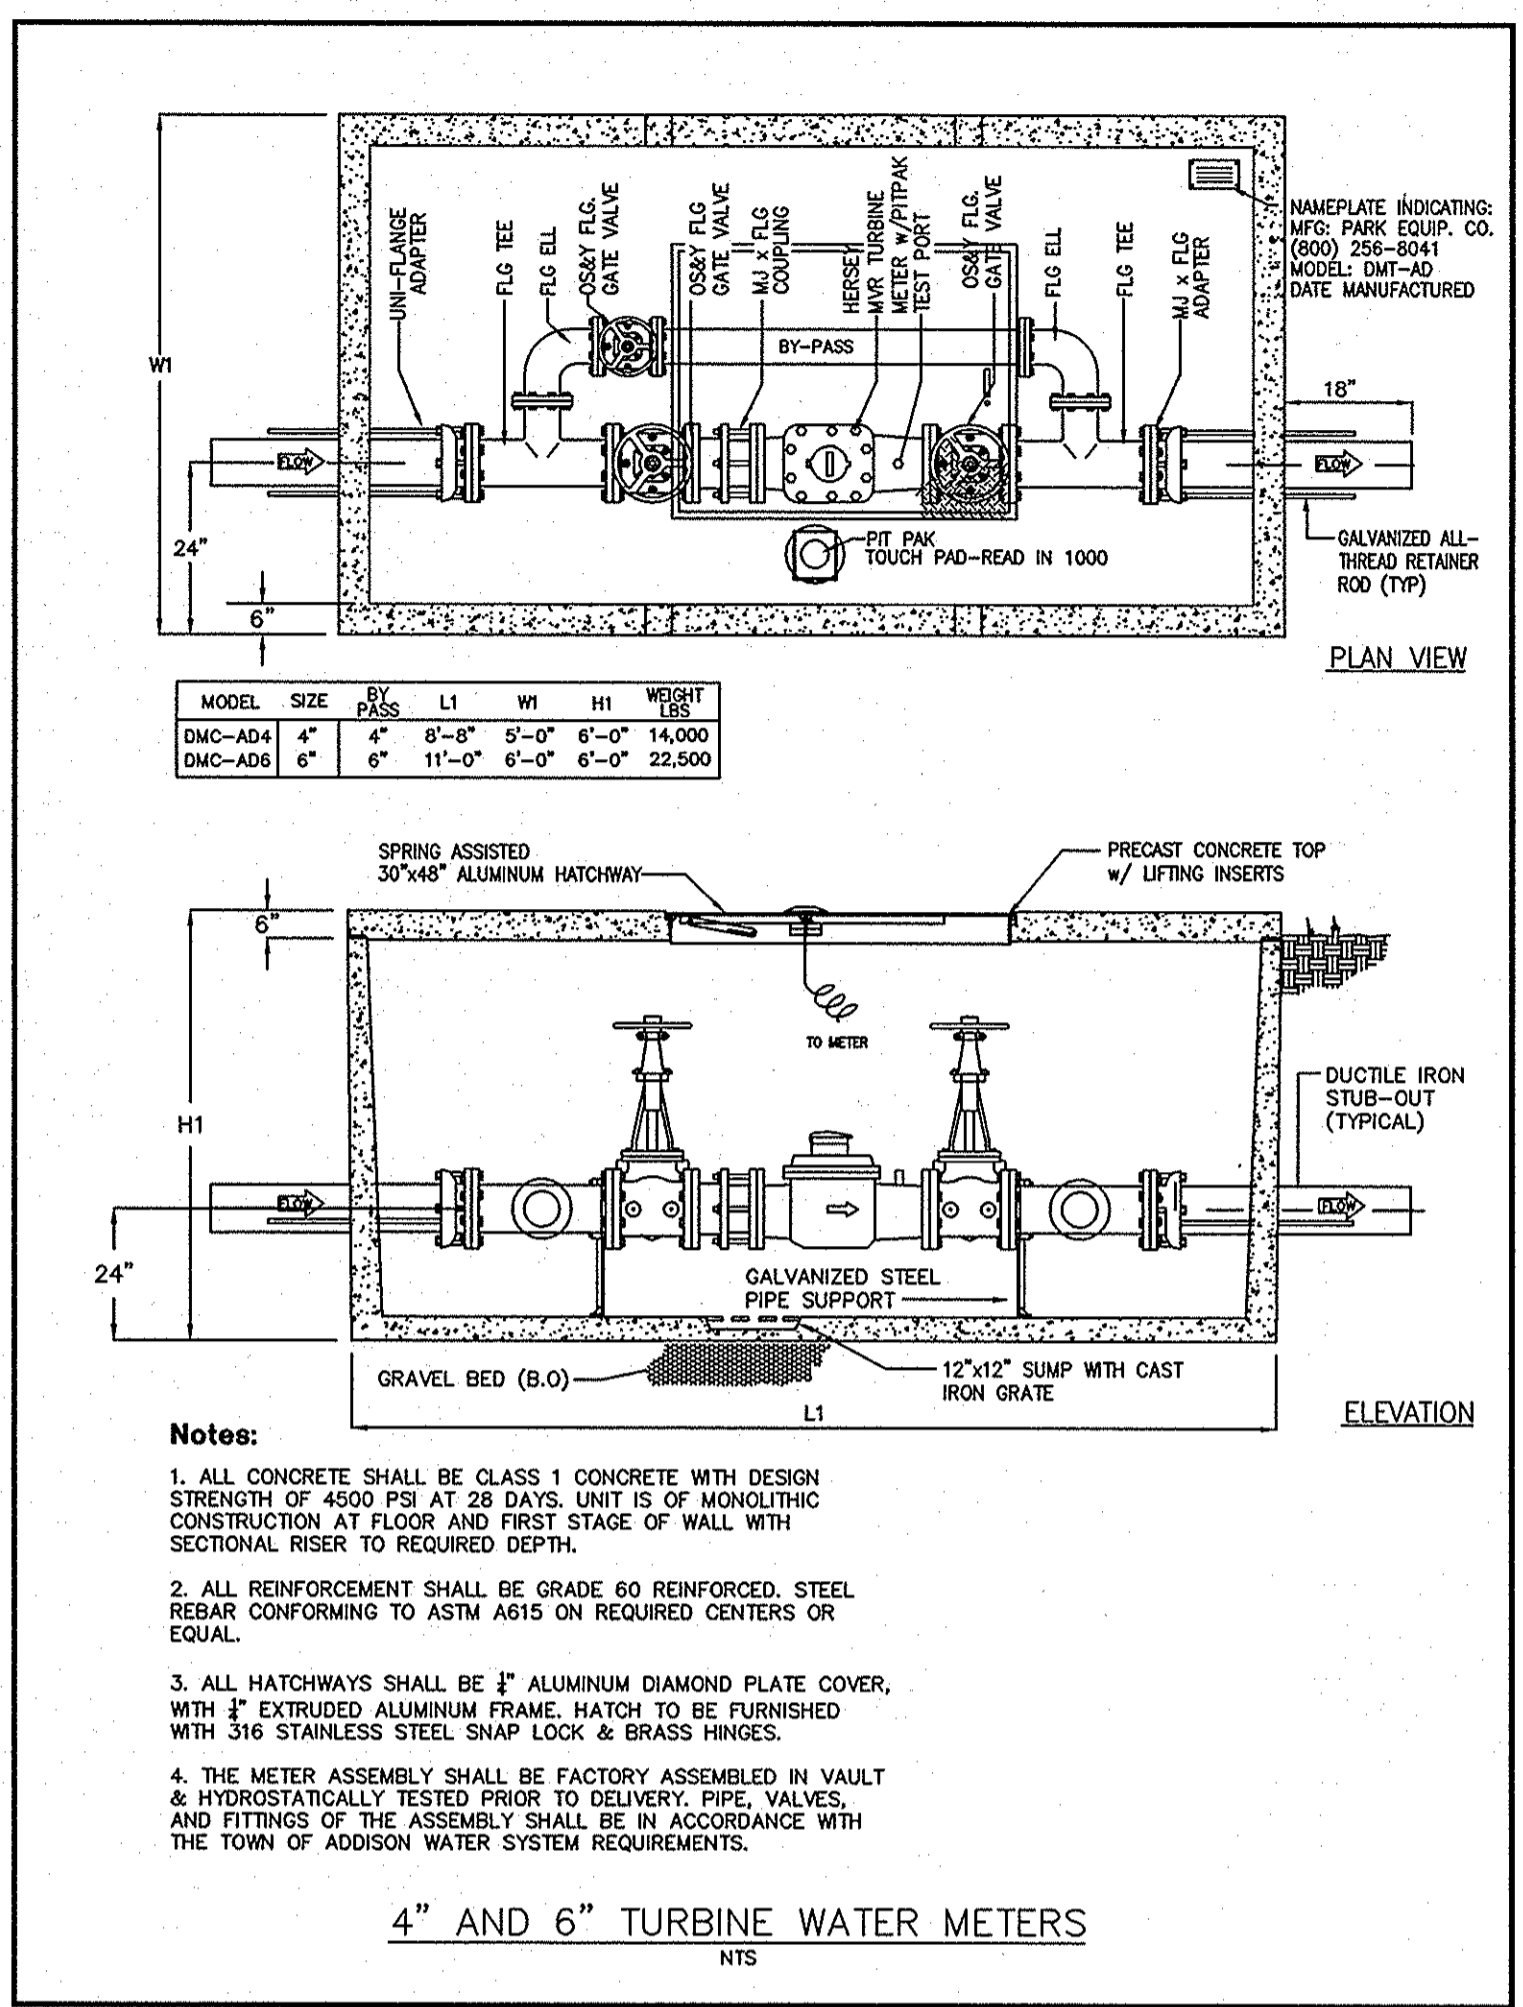


**RECORD DRAWINGS**  
**(SEPTEMBER 2010)**  
 INFORMATION PROVIDED BY:  
 Rogers-O'Brien Construction Company

THESE DETAILS APPLY ONLY TO IMPROVEMENTS WITHIN THE TOWN OF ADDISON LIMITS. USE FILE 251D-1 DETAILS FOR IMPROVEMENTS WITHIN THE CITY OF DALLAS LIMITS.




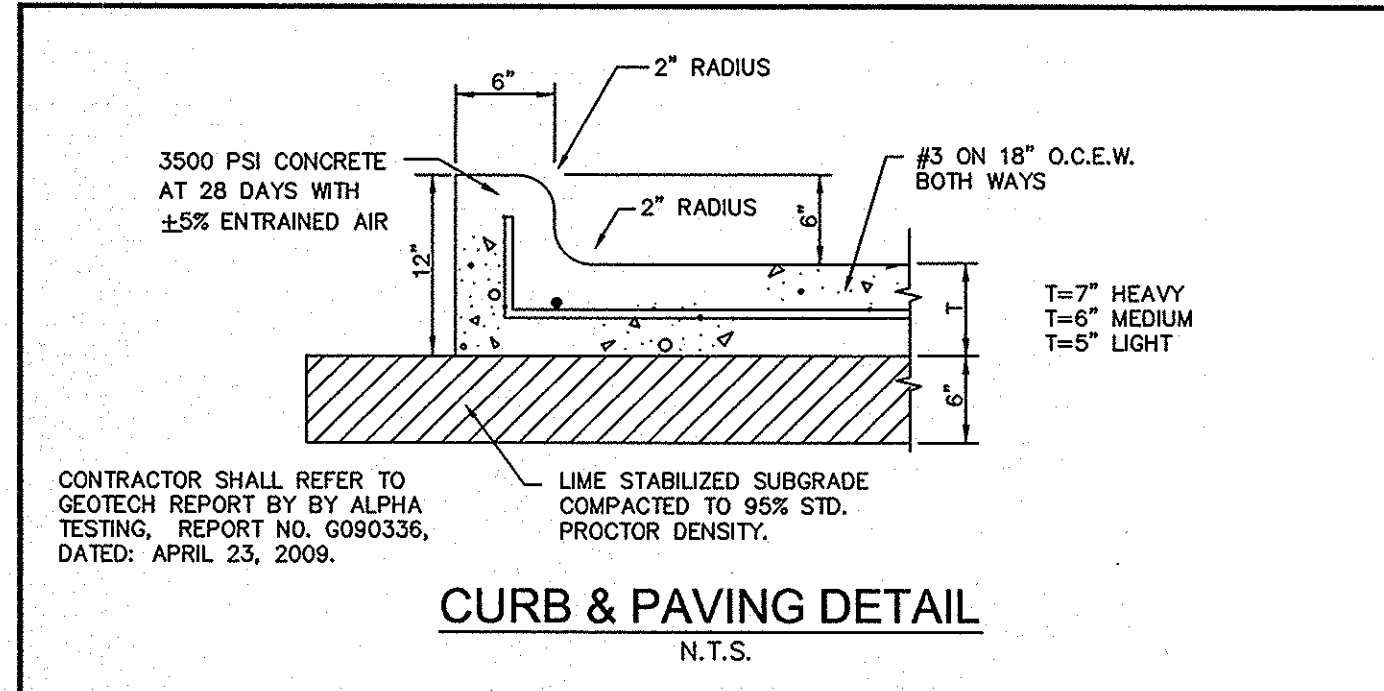


**CURB & PAVING DETAIL**  
N.T.S.

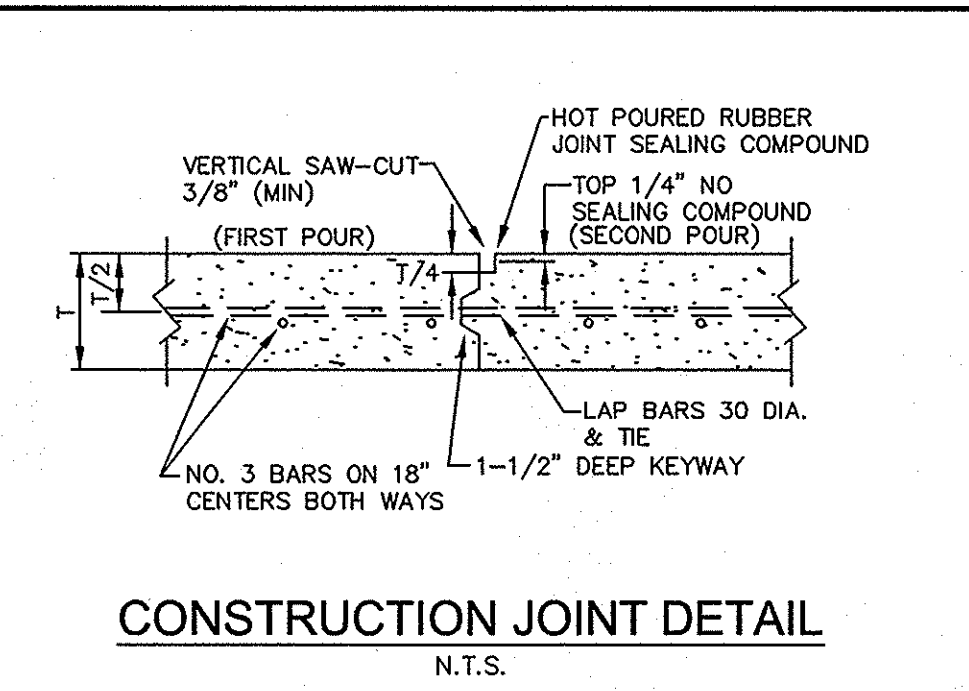


**CONSTRUCTION JOINT DETAIL**  
N.T.S.

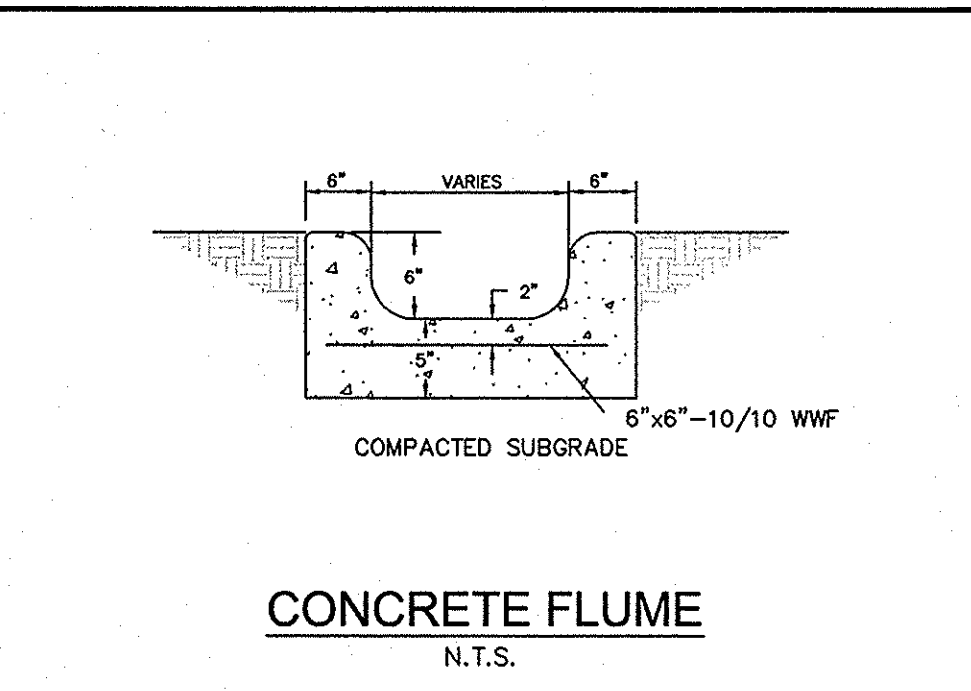


**CONCRETE FLUME**  
N.T.S.

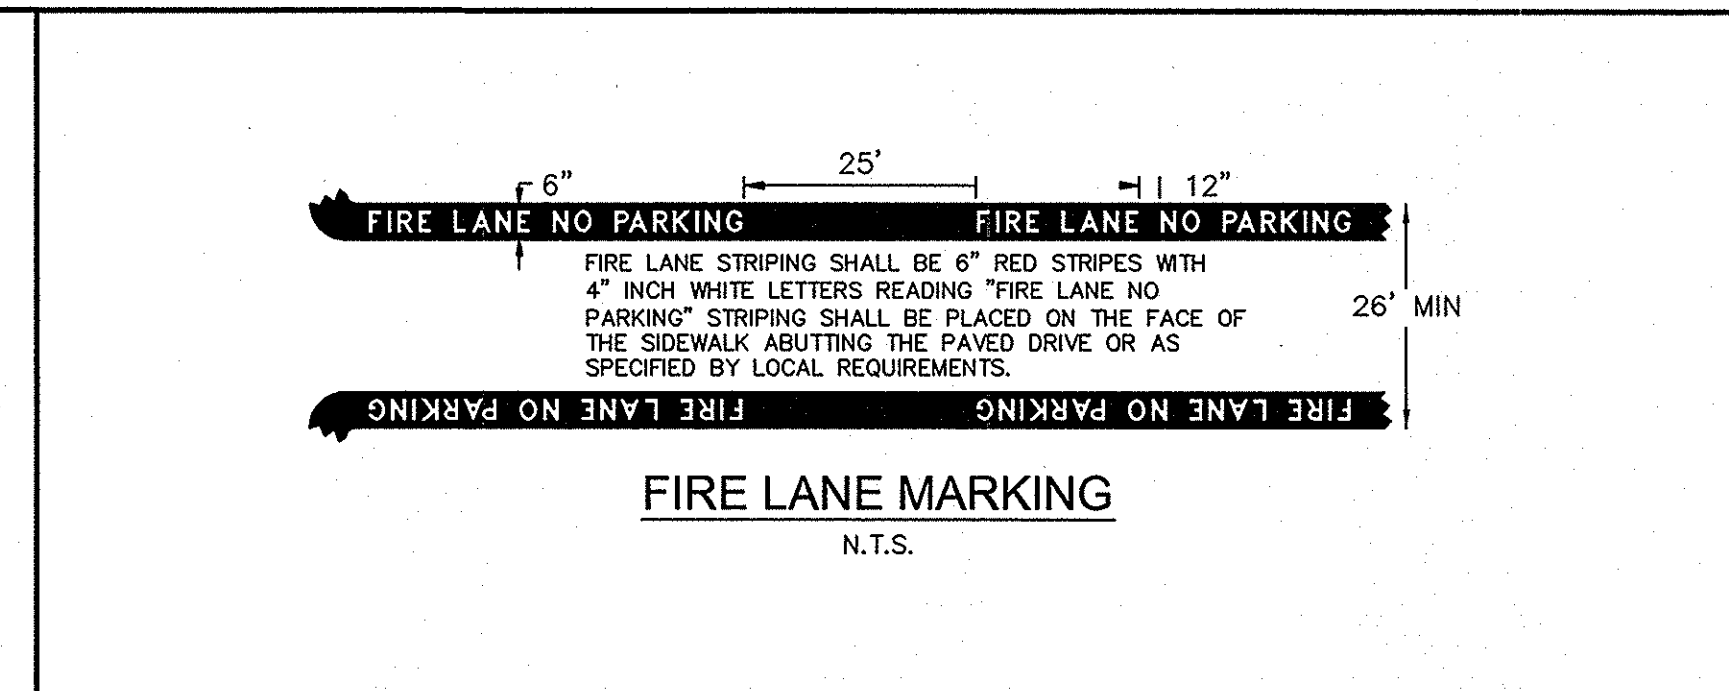


**FIRE LANE MARKING**  
N.T.S.

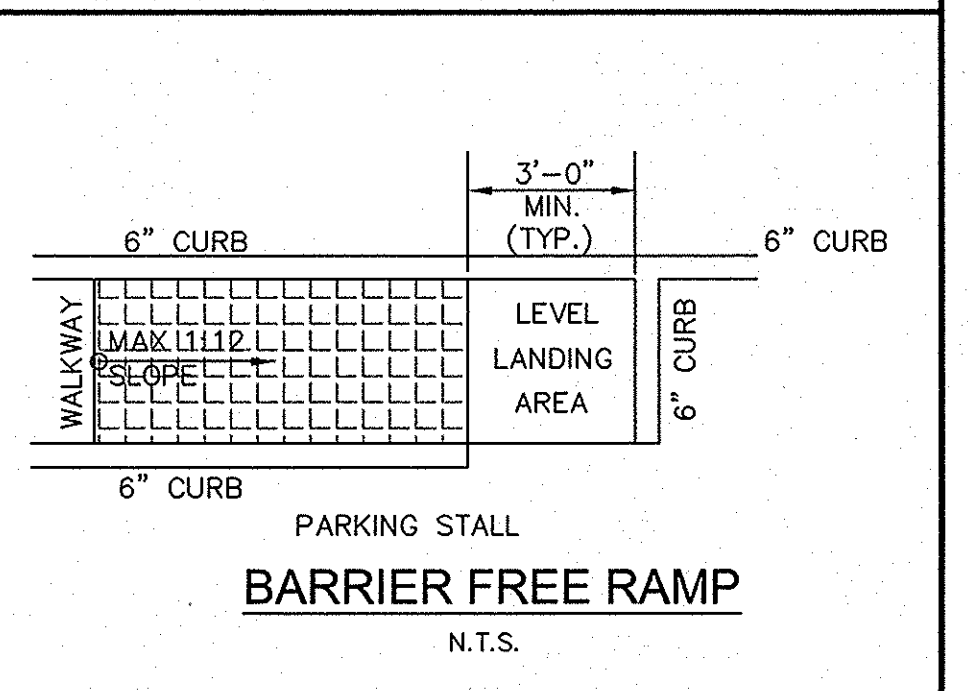


**BARRIER FREE RAMP**  
N.T.S.

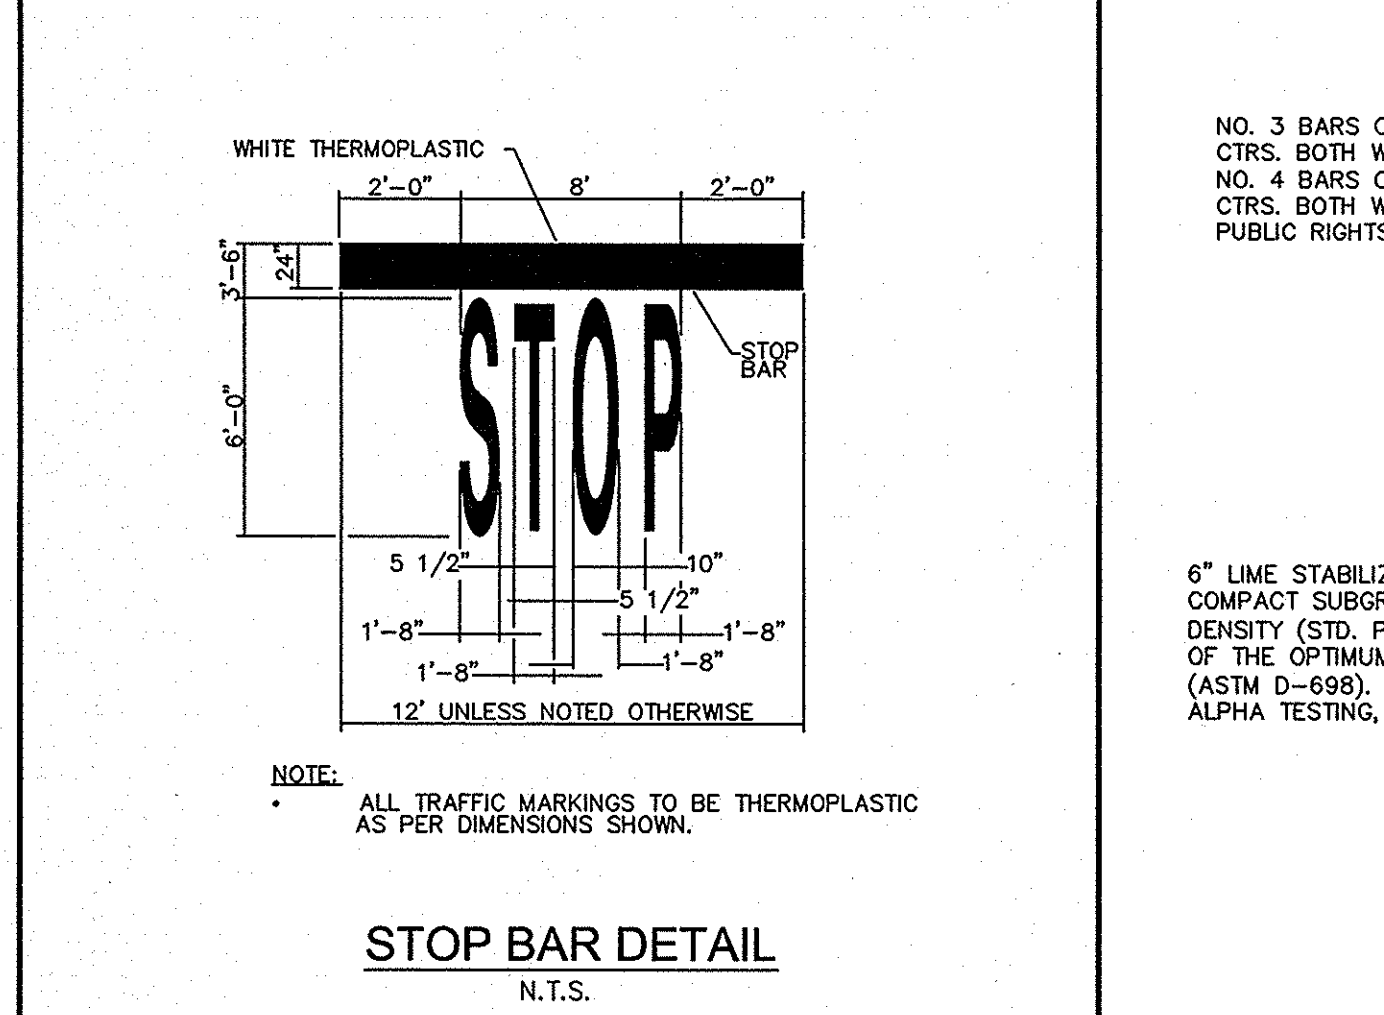


**STOP BAR DETAIL**  
N.T.S.

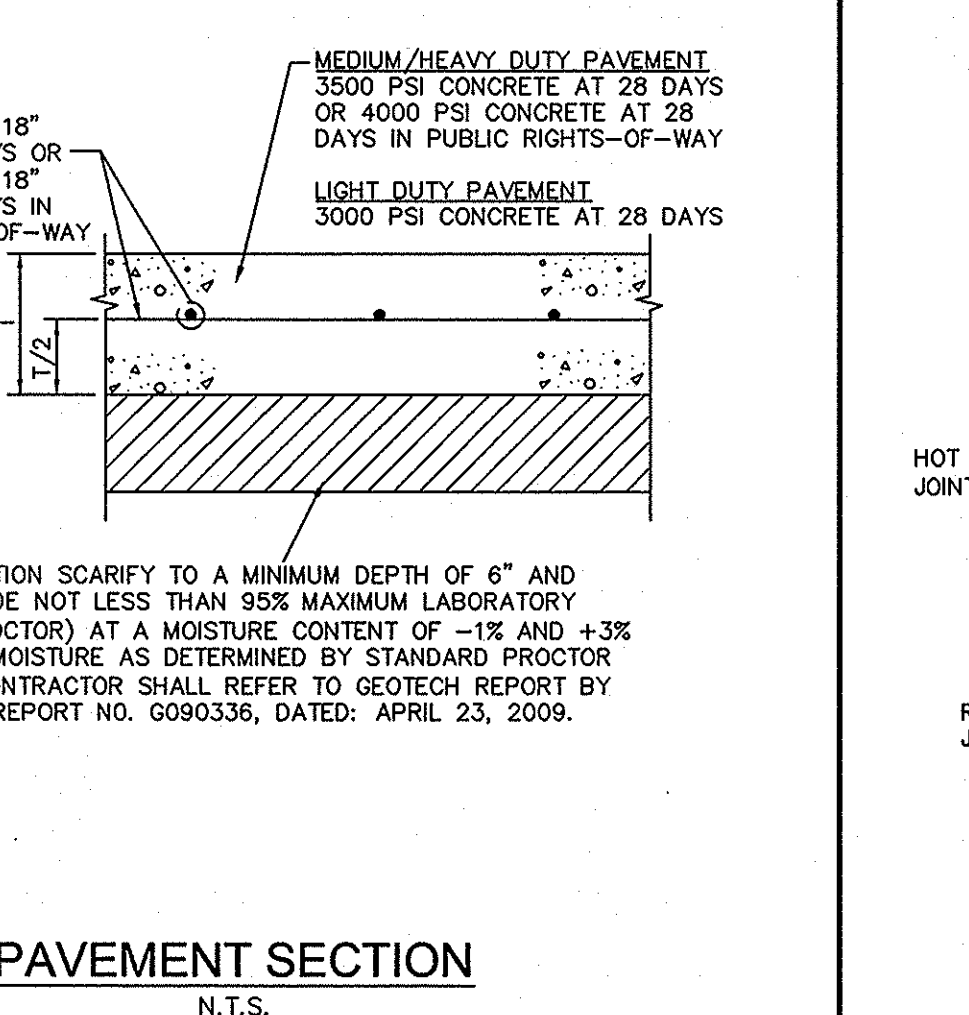


**PAVEMENT SECTION**  
N.T.S.

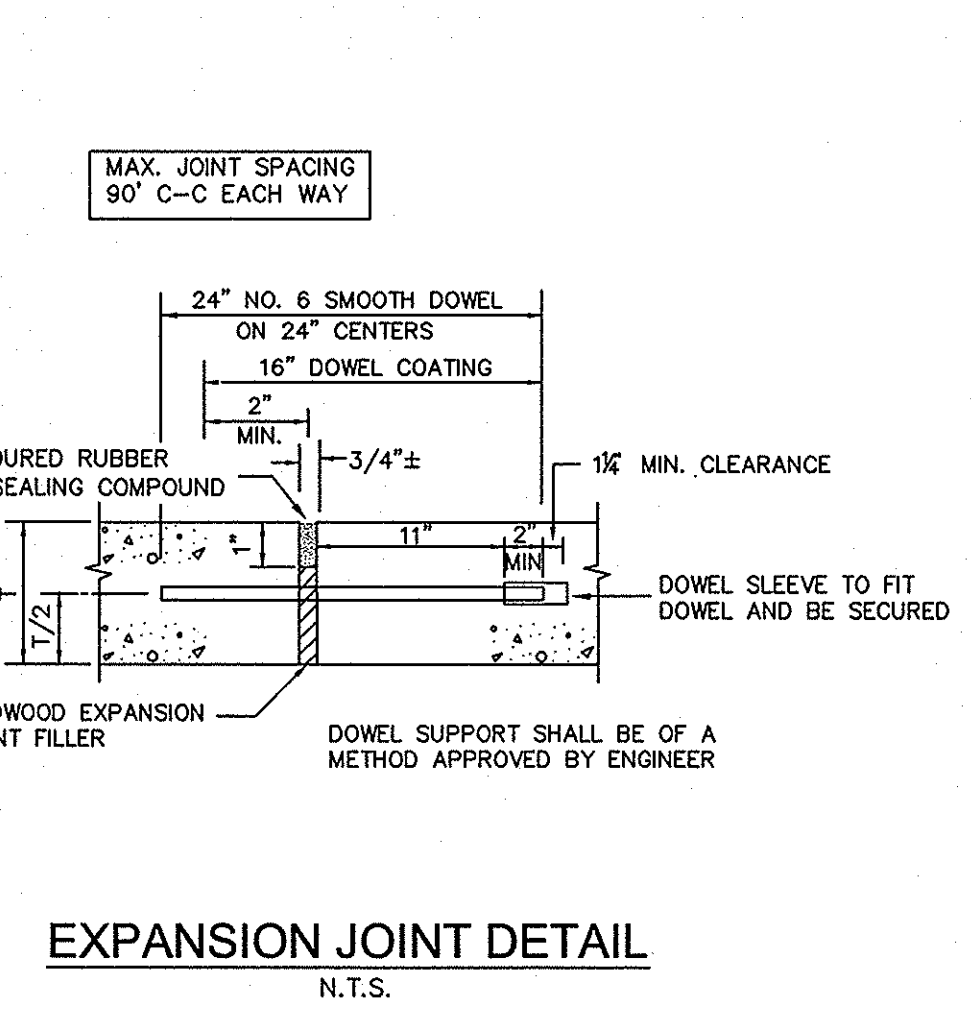


**EXPANSION JOINT DETAIL**  
N.T.S.

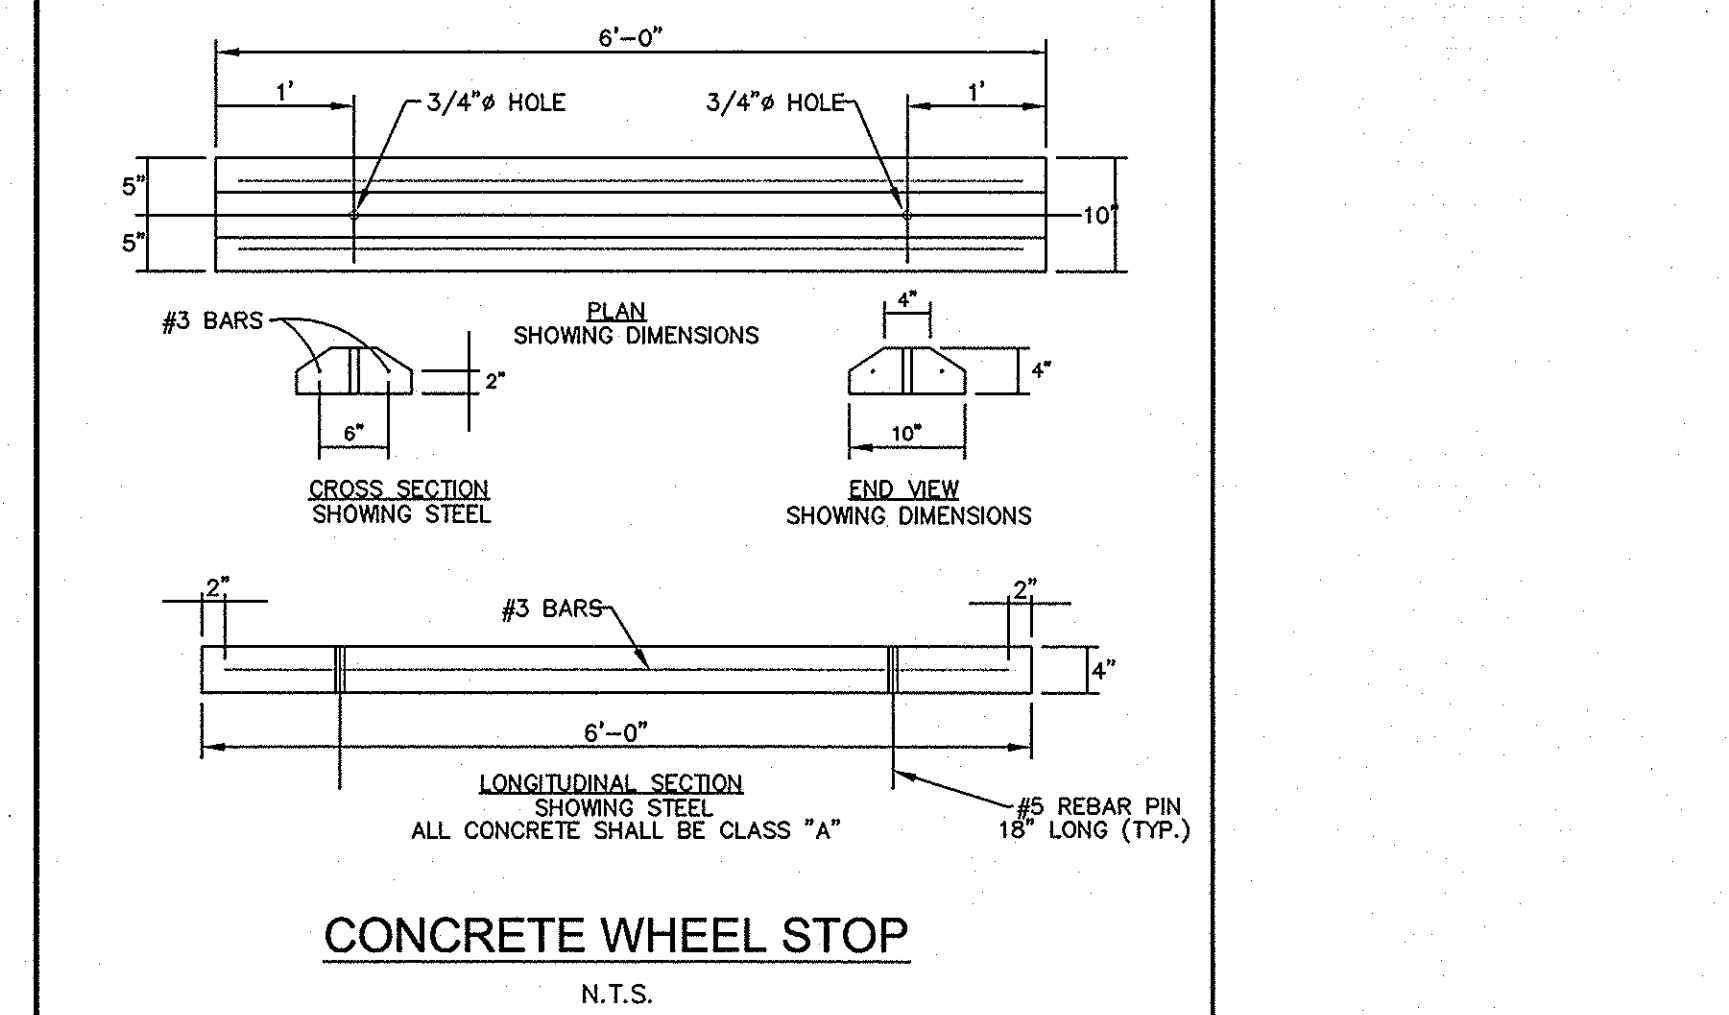


**CONCRETE WHEEL STOP**  
N.T.S.

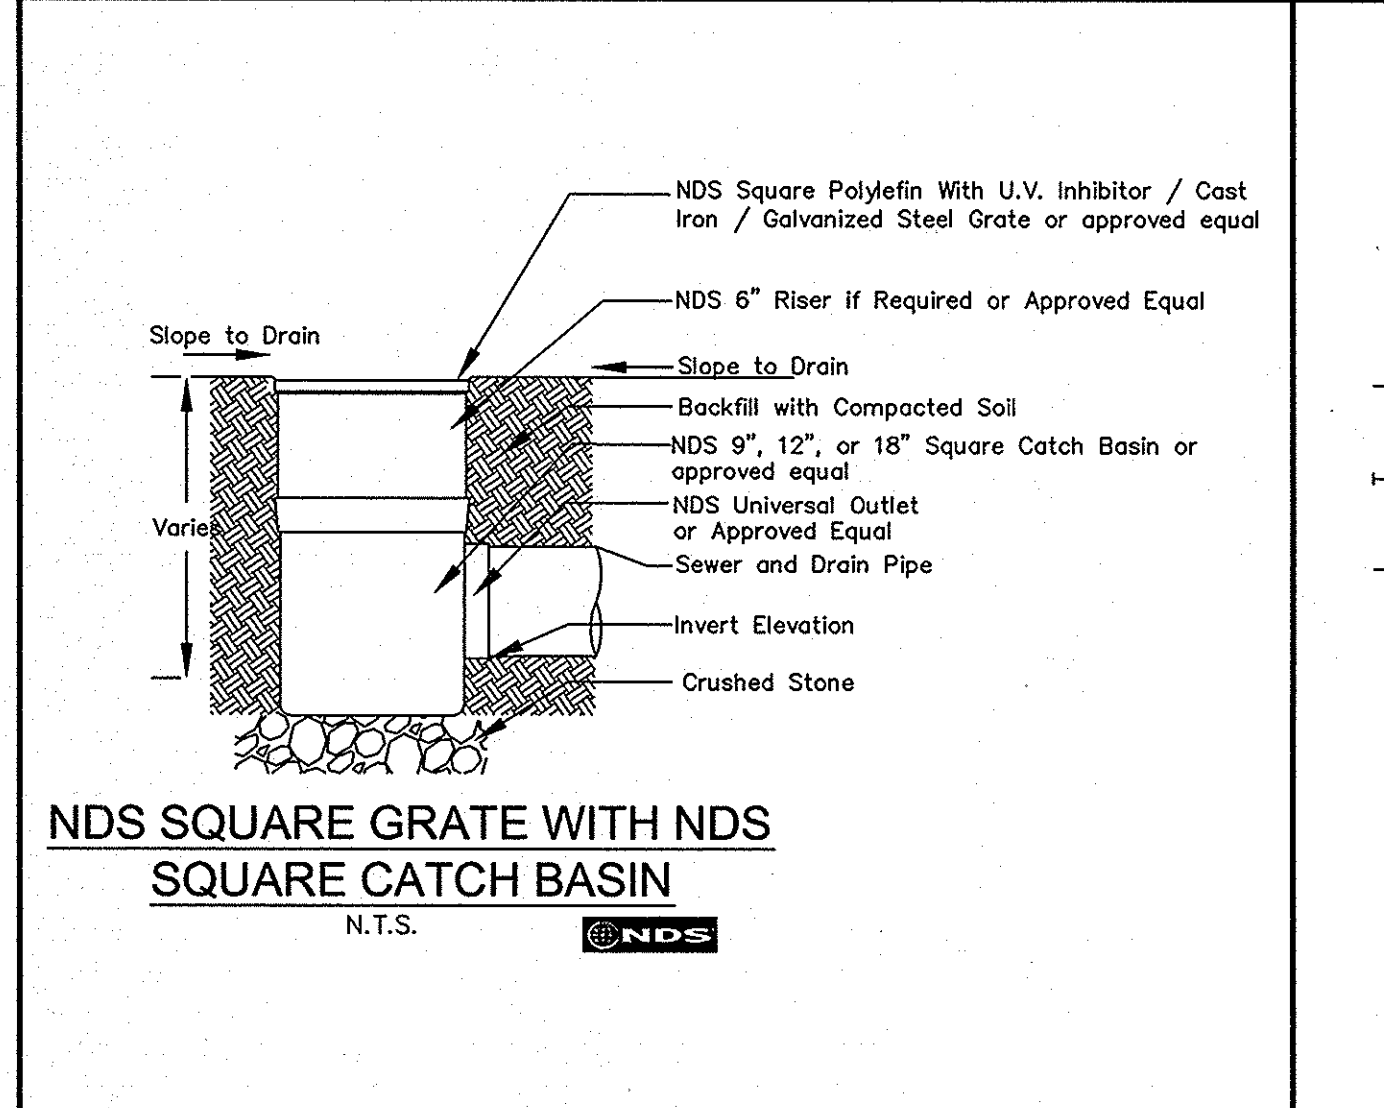


**NDS SQUARE GRATE WITH NDS SQUARE CATCH BASIN**  
N.T.S.

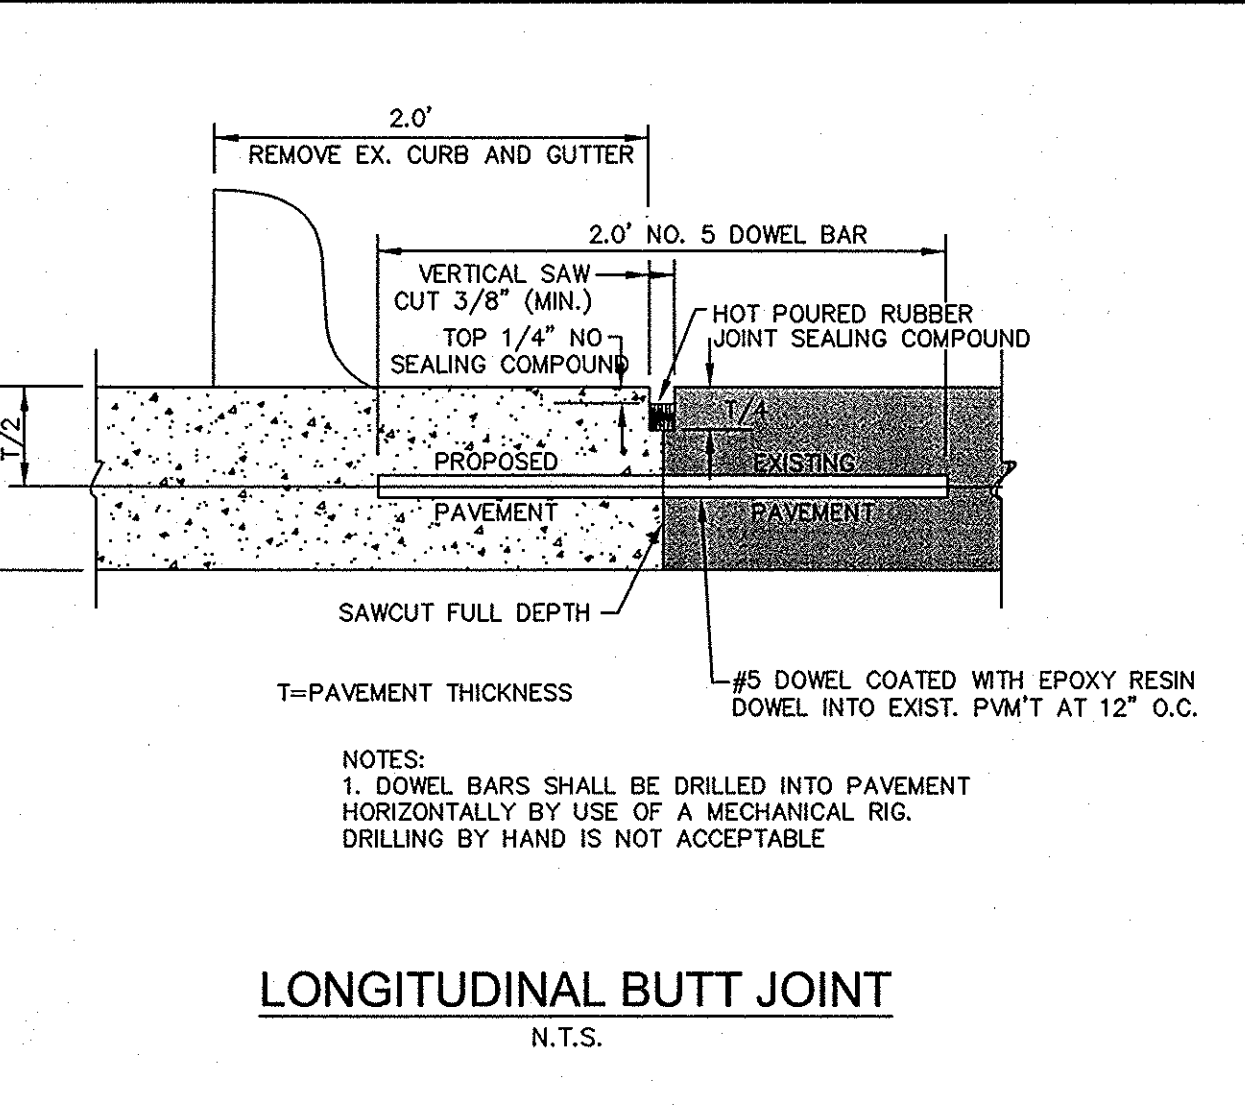

**LONGITUDINAL BUTT JOINT**  
N.T.S.

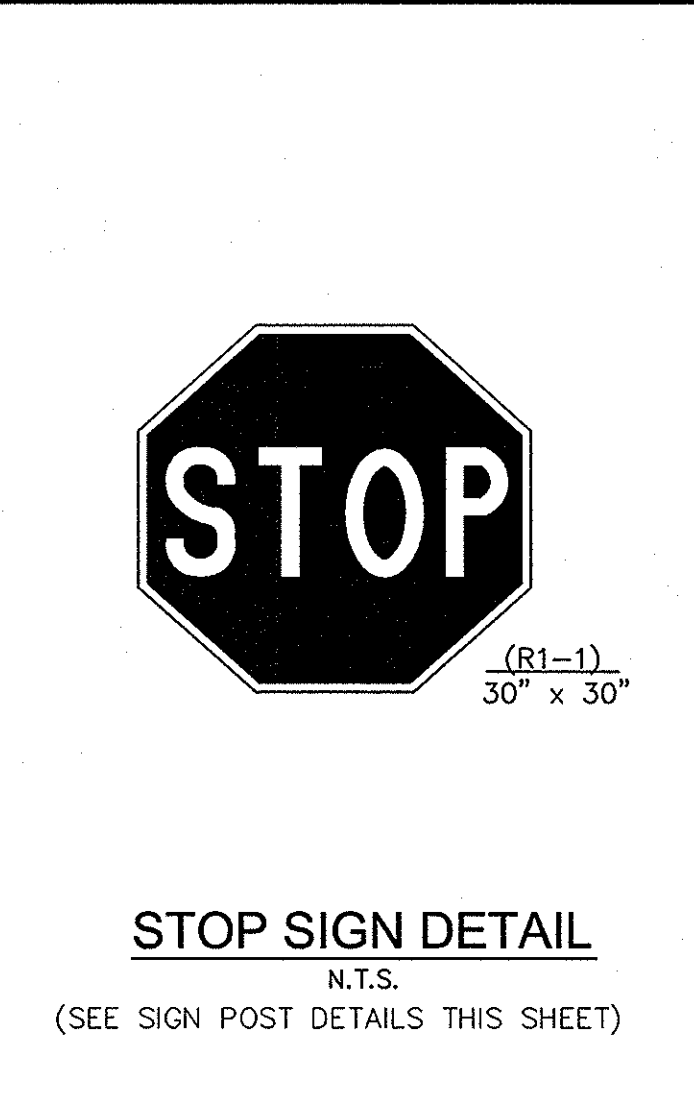


**STOP SIGN DETAIL**  
N.T.S.

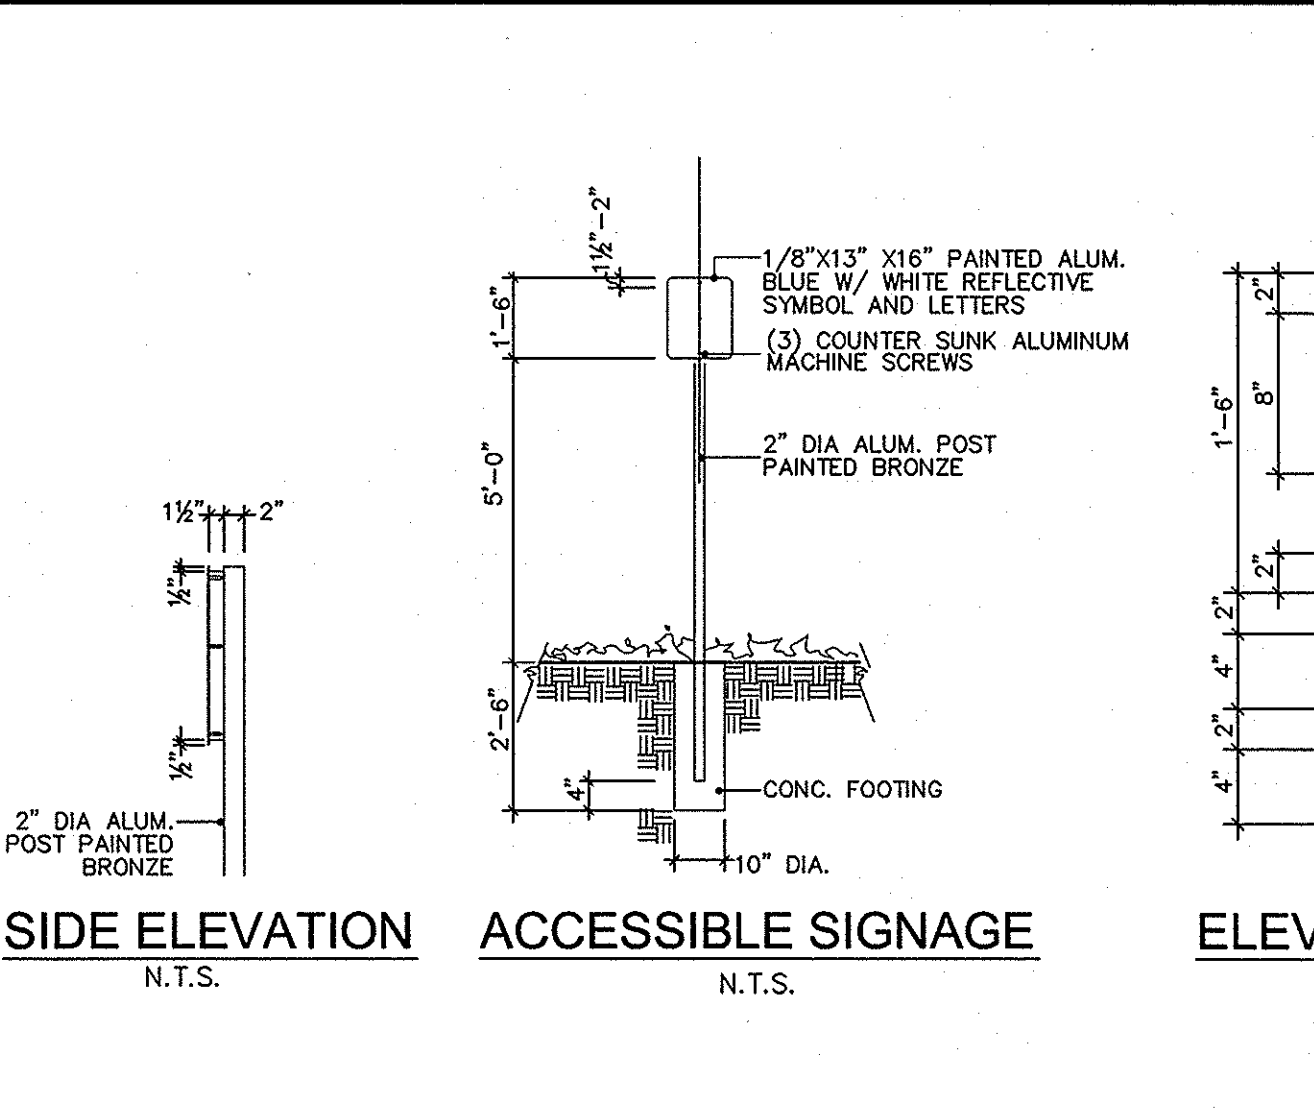


**SIDE ELEVATION**  
N.T.S.


**ACCESSIBLE SIGNAGE**  
N.T.S.

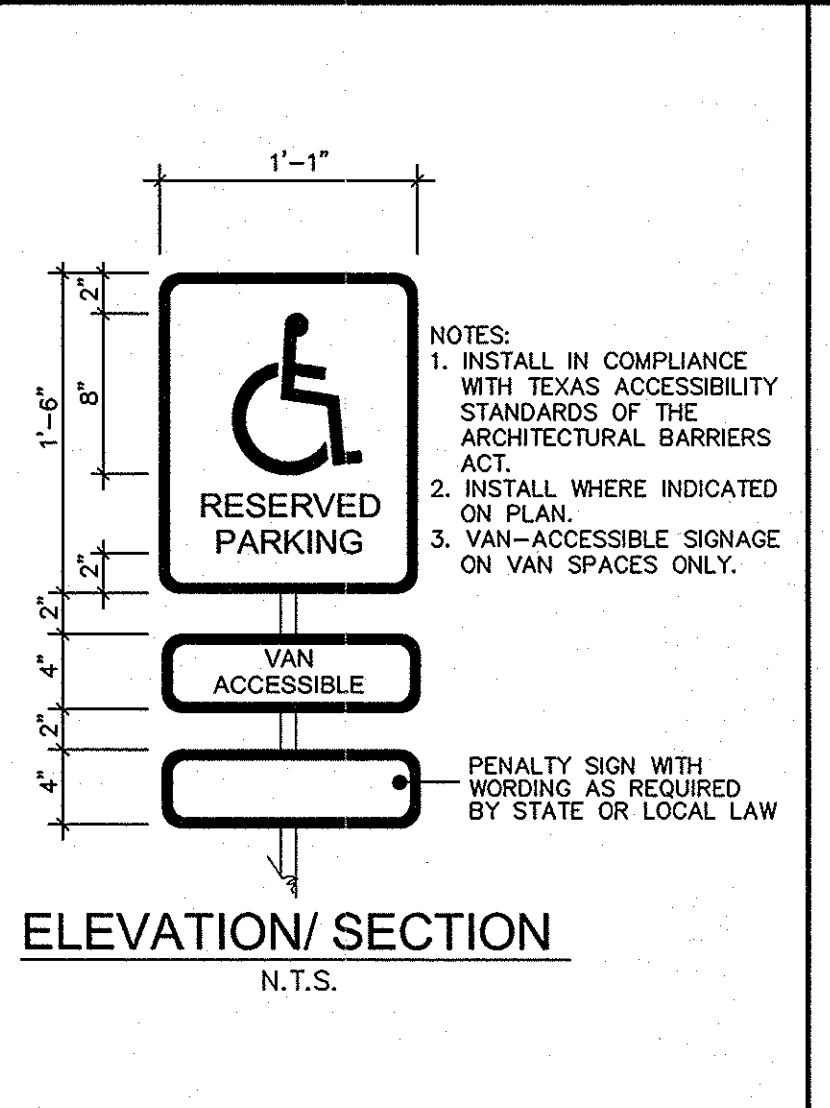


**ELEVATION/SECTION**  
N.T.S.

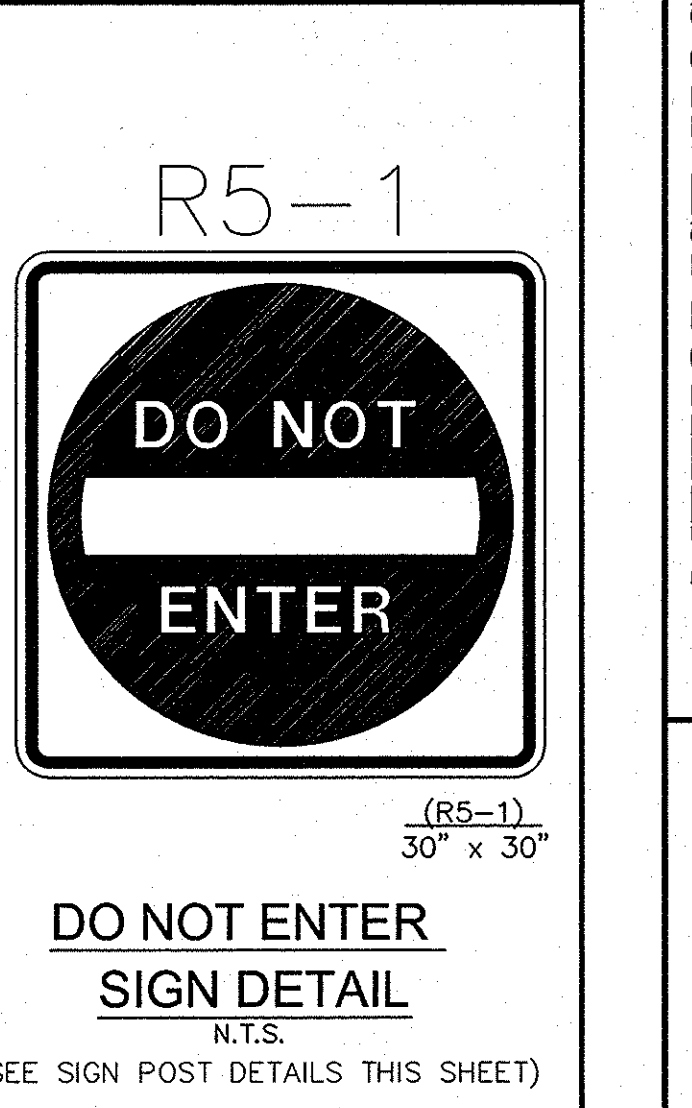


**DO NOT ENTER SIGN DETAIL**  
N.T.S.

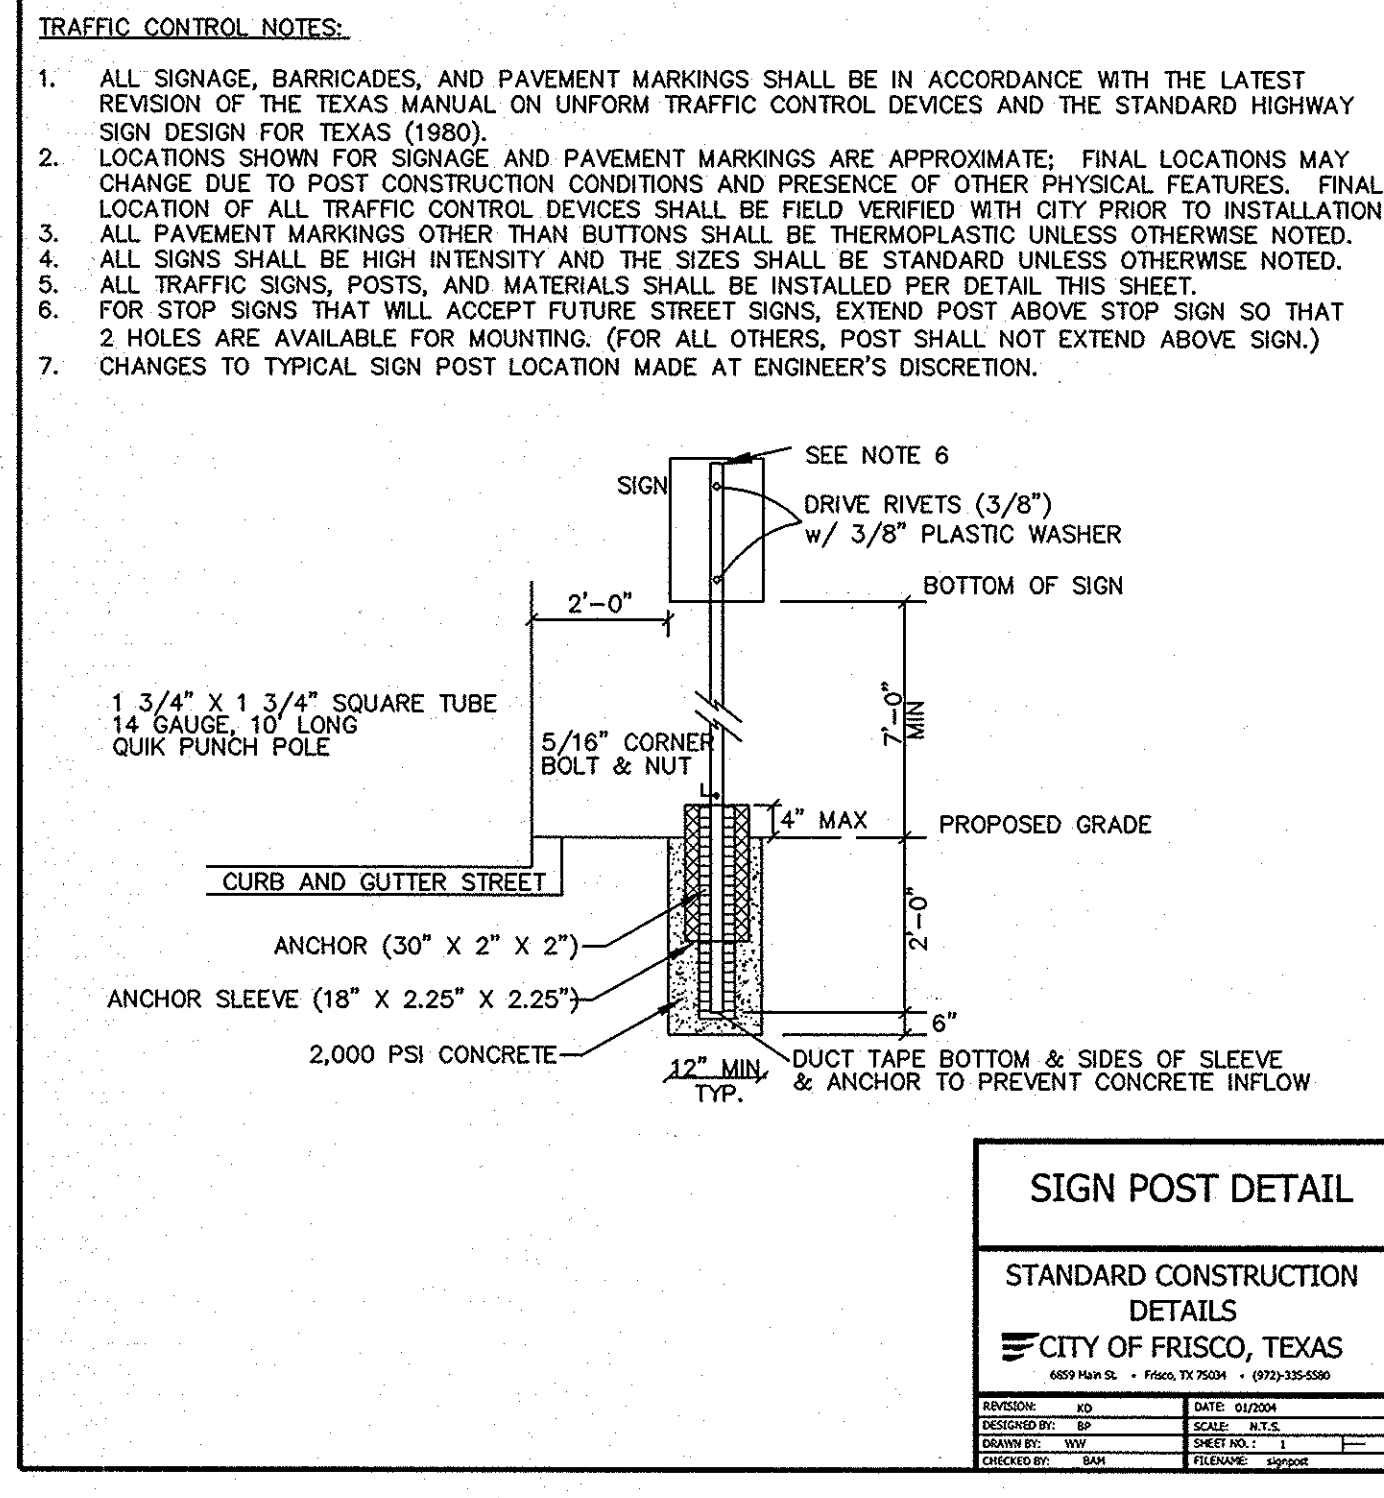


**SIGN POST DETAIL**  
N.T.S.

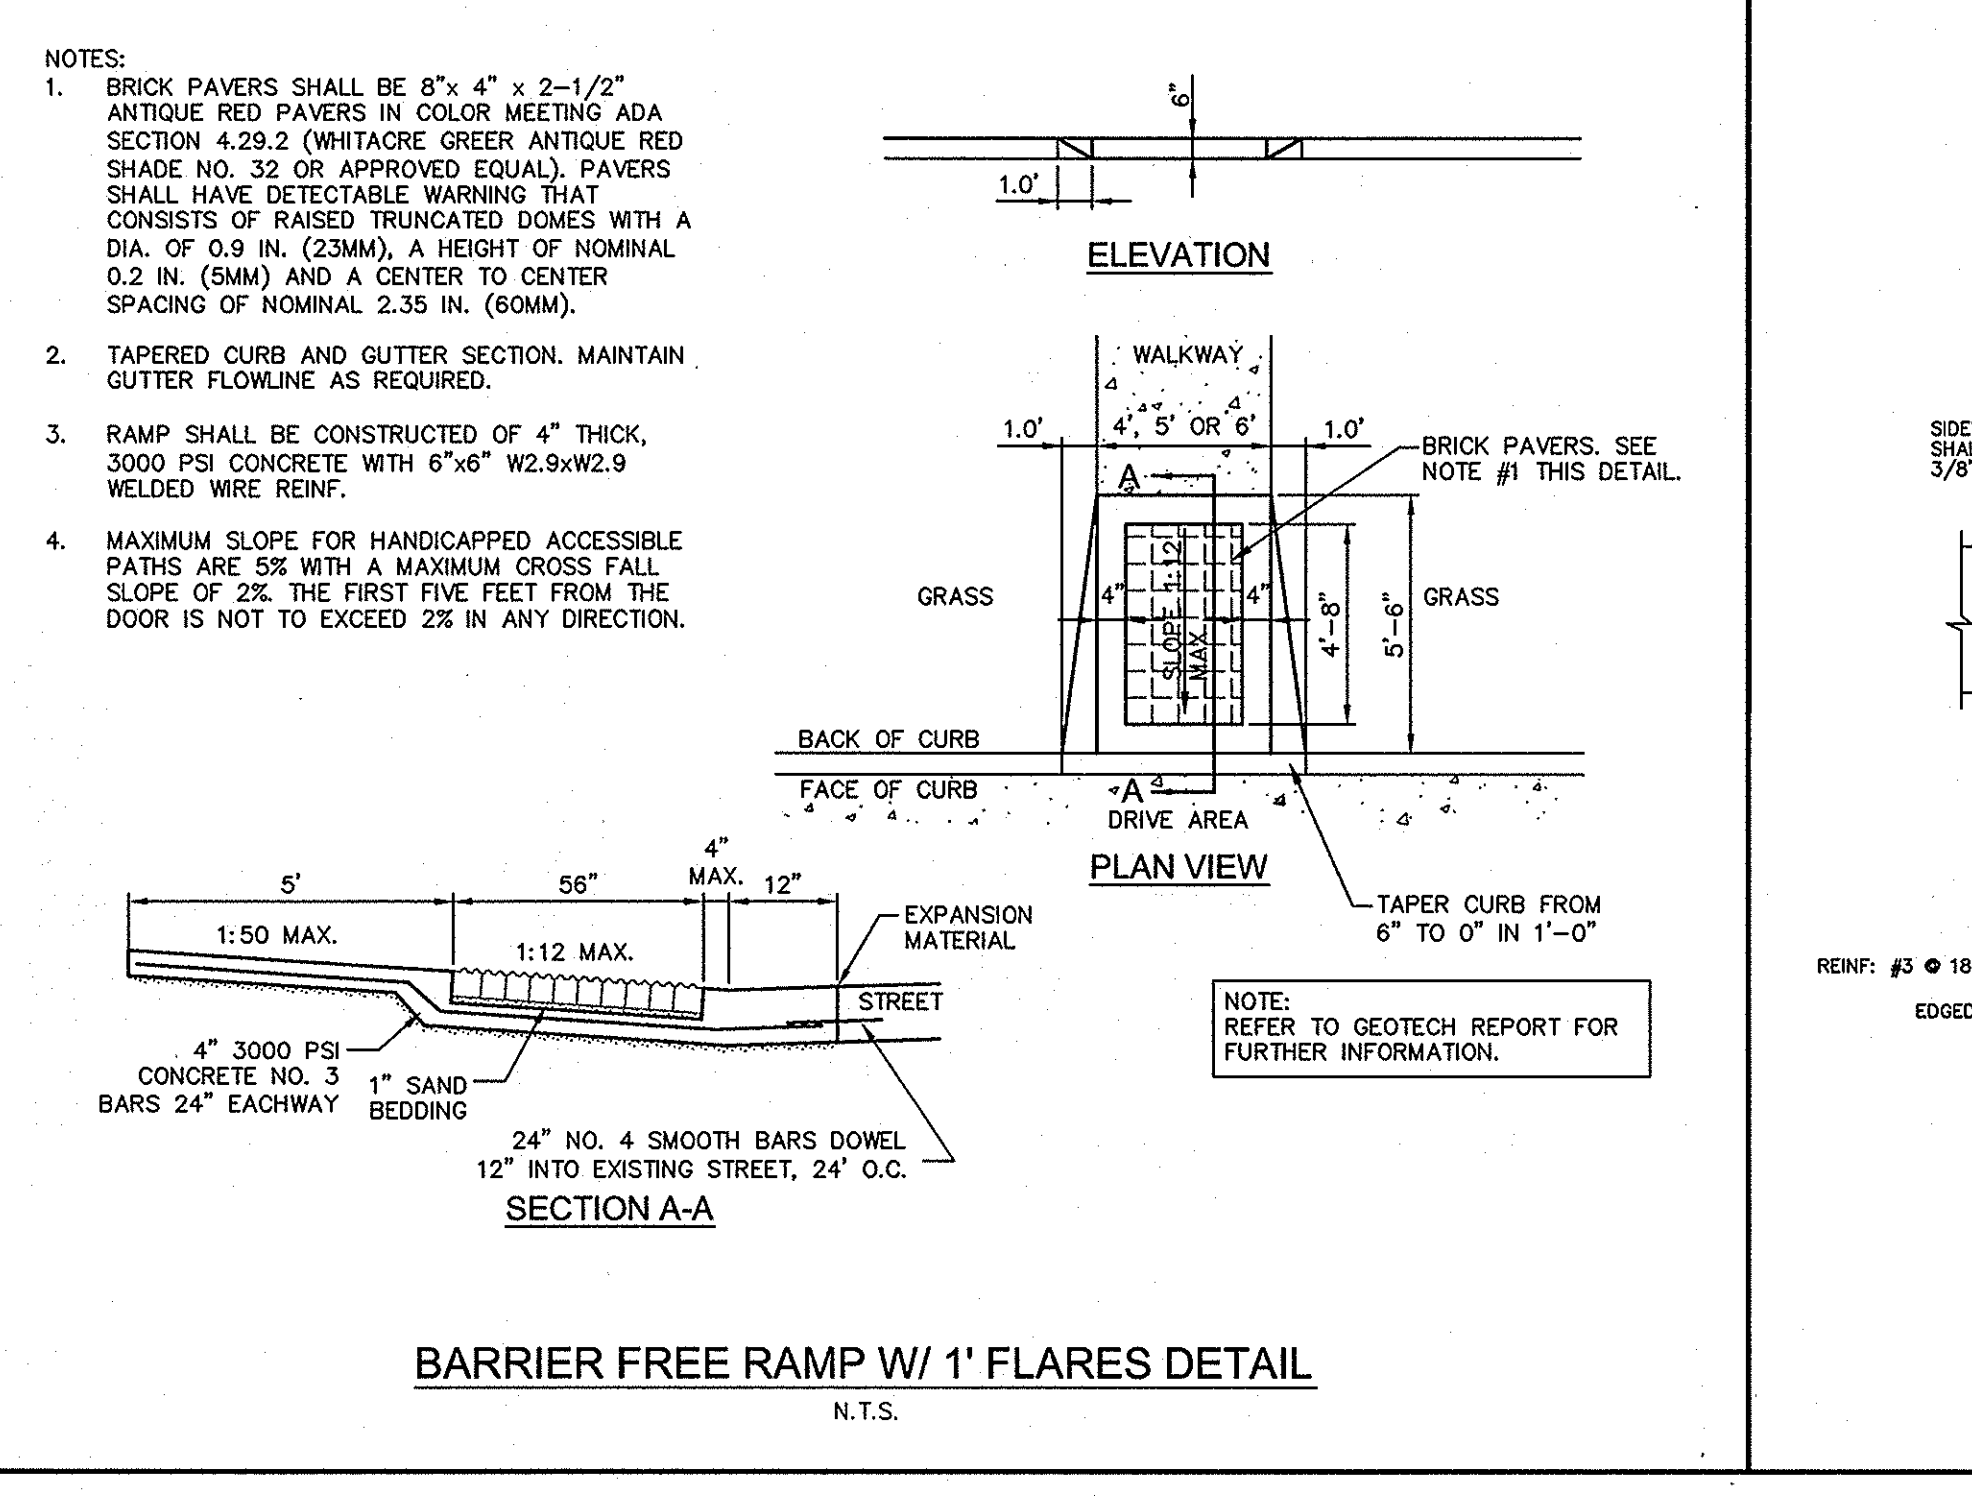

**BARRIER FREE RAMP W/ 1' FLARES DETAIL**  
N.T.S.

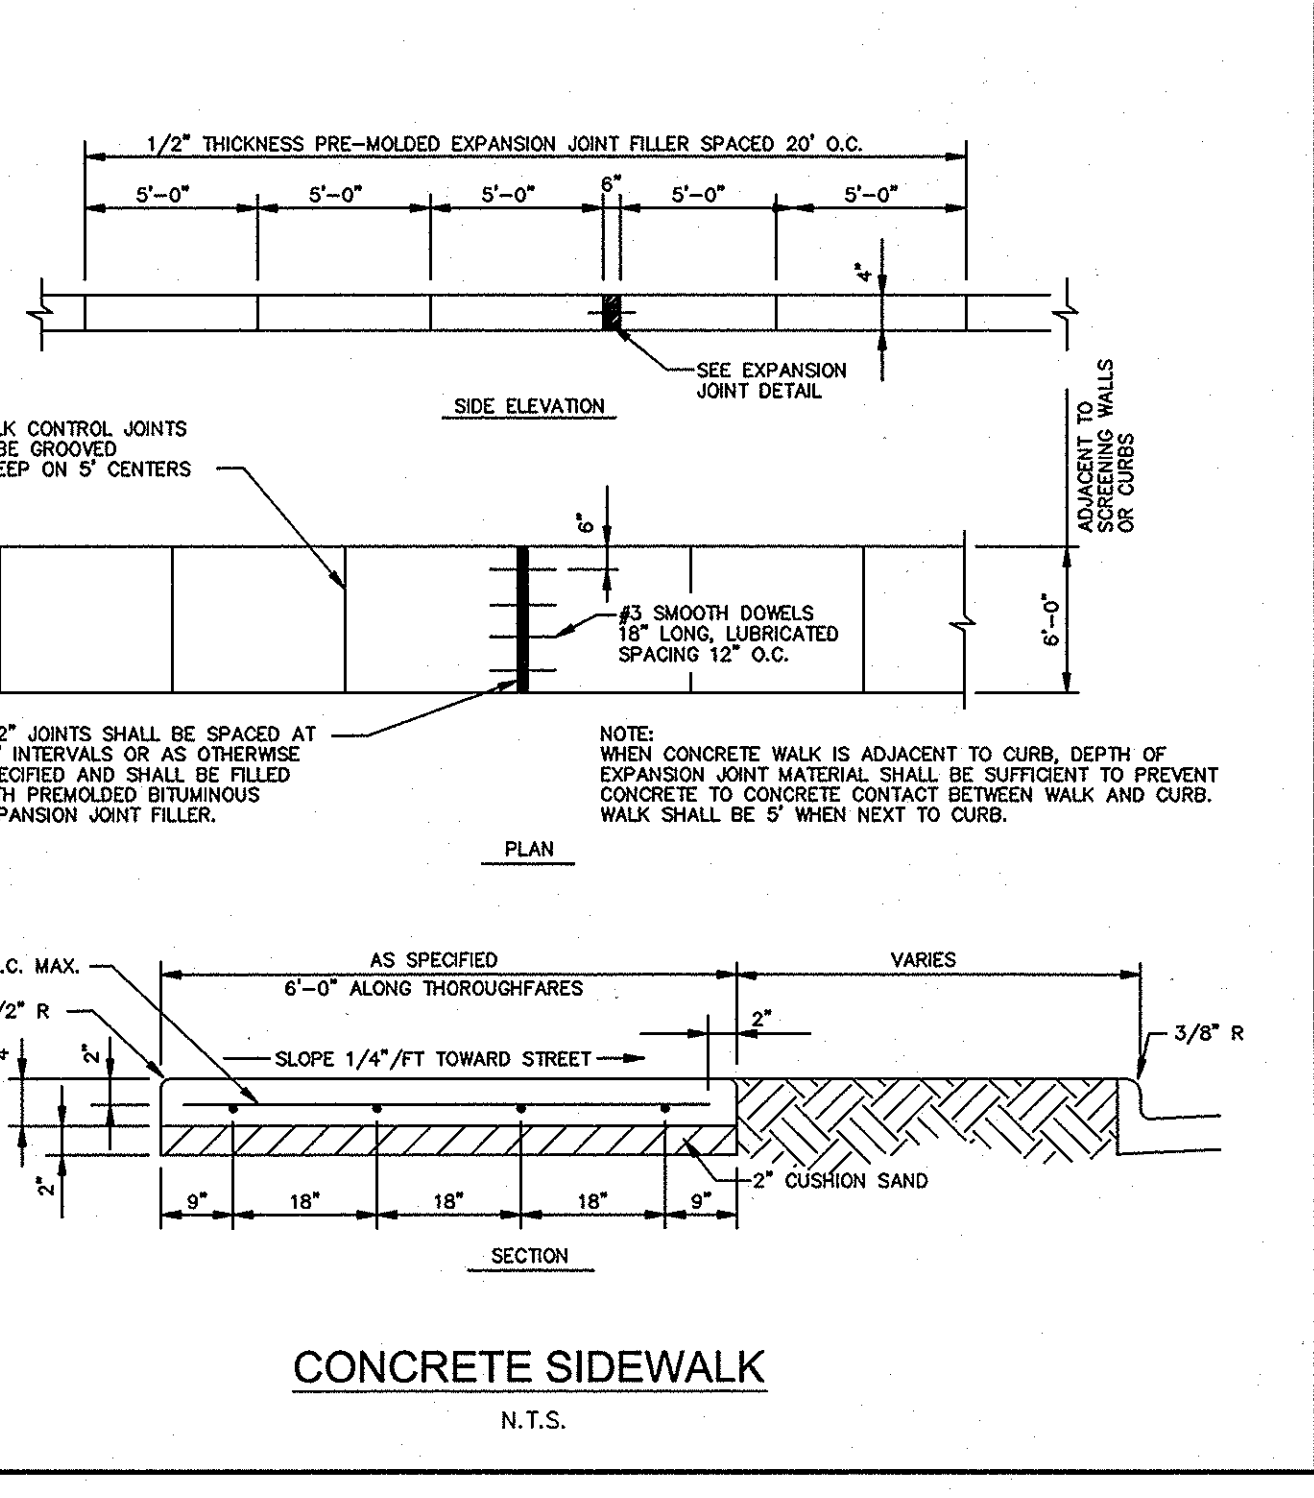

**CONCRETE SIDEWALK**  
N.T.S.

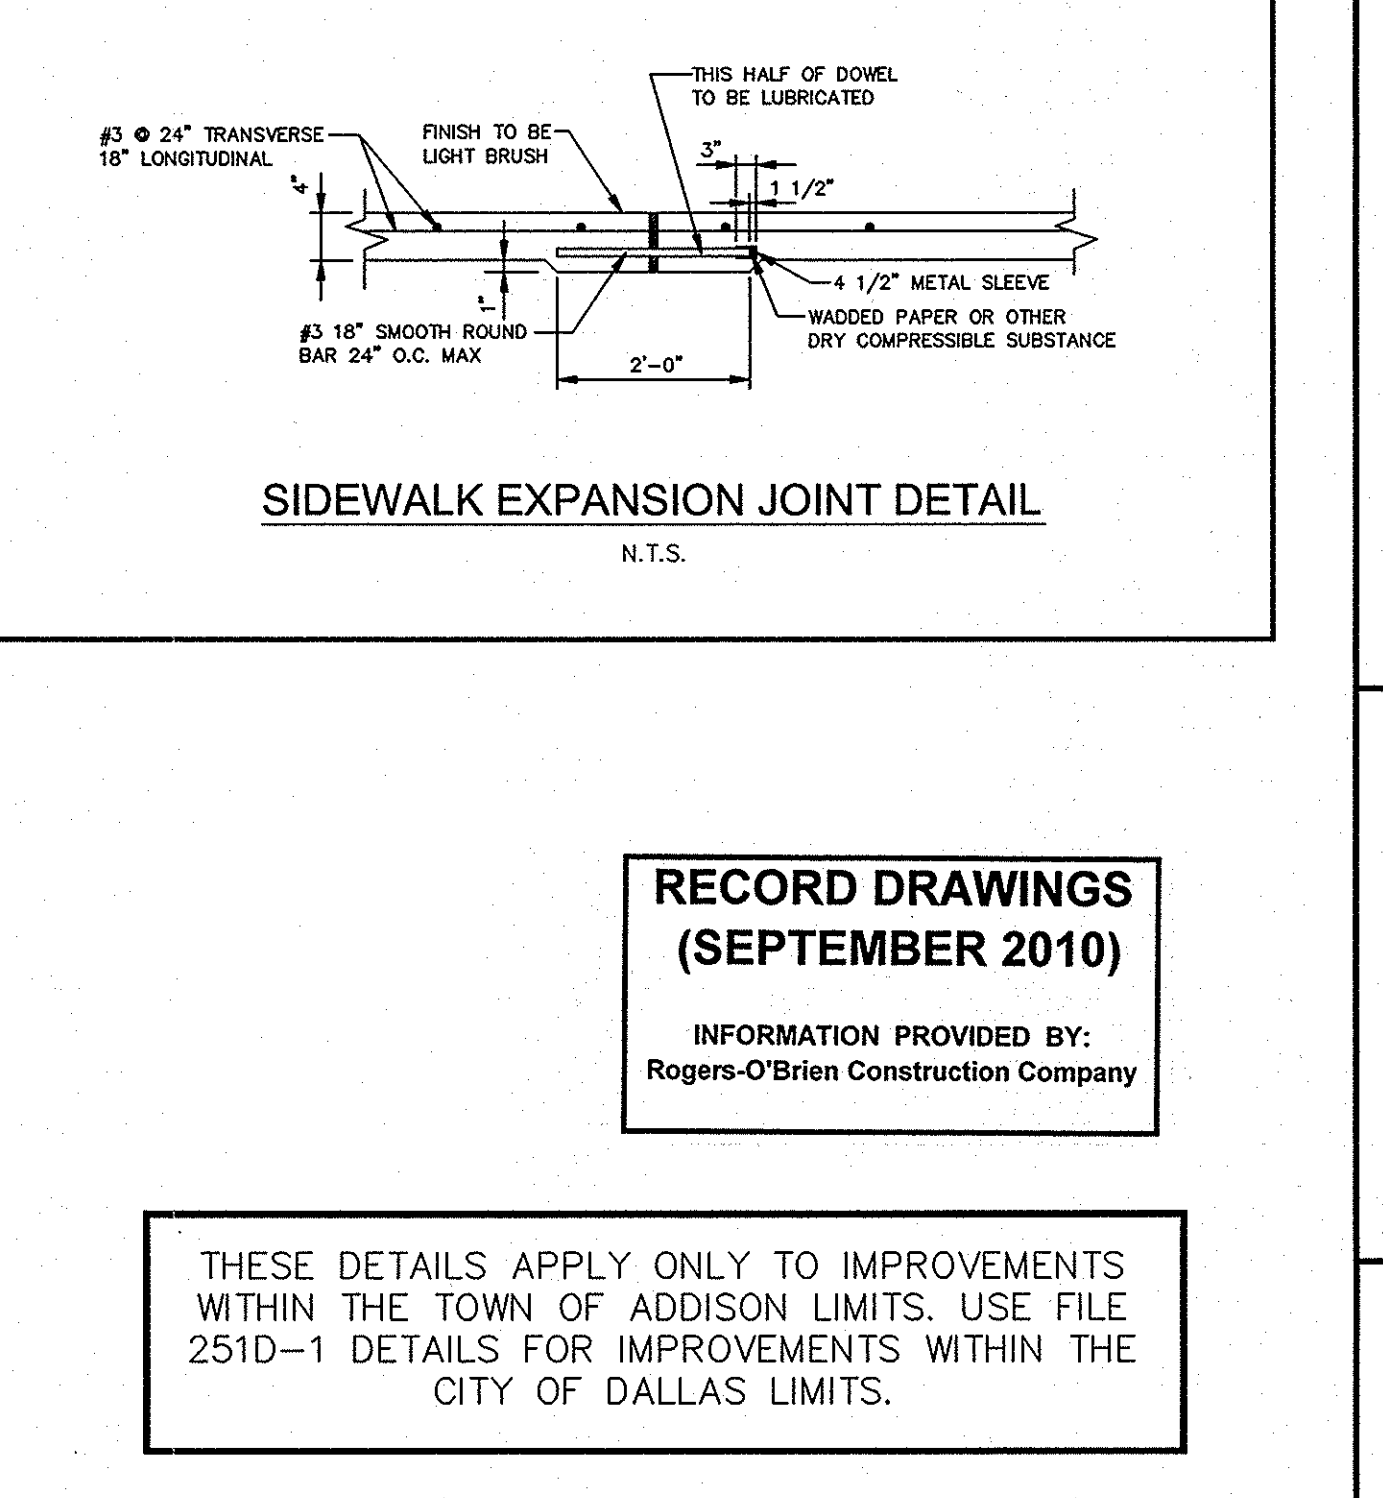


**SIDEWALK EXPANSION JOINT DETAIL**  
N.T.S.

**RECORD DRAWINGS (SEPTEMBER 2010)**

INFORMATION PROVIDED BY:  
Rogers-O'Brien Construction Company

THESE DETAILS APPLY ONLY TO IMPROVEMENTS WITHIN THE TOWN OF ADDISON LIMITS. USE FILE 251D-1 DETAILS FOR IMPROVEMENTS WITHIN THE CITY OF DALLAS LIMITS.

**Kimley-Horn and Associates, Inc.**  
Tel. No. (972) 335-3580  
Fax No. (972) 335-3779  
5750 Genesis Court, Suite 200  
Frisco, Texas 75034  
State of Texas Registration No. E-928

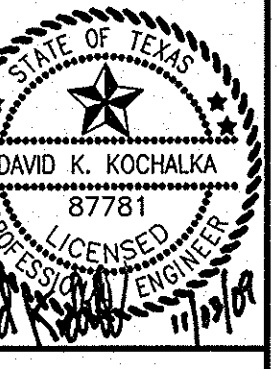


**METHODIST HOSPITAL FOR SURGERY**  
ADDISON, TEXAS  
FILE NUMBER: 311T-7863

**CONSTRUCTION DETAILS**

Scale: AS SHOWN  
Designed by: RCO  
Drawn by: RCO  
Checked by: DNK  
Date: 11/09/09  
Project No.: 69020500  
SHEET  
C-22

1:25/27/2009 - 4:52/5/2009 - UTILITY PLAN -  
PLOTTED BY: BRASWELL, TERRY 11/09/09 3:52 PM  
DWG NAME: K:\P\09020500 - METHODIST HOSPITAL ADDISON\DWG\PLAN\SET\CONSTR.DWG  
C:\P\09020500

STANDARD CONSTRUCTION DETAILS	
CITY OF FRISCO, TEXAS	
REVISION NO.	DATE
DESCRIPTION	BY
DATE	BY
DATE	BY
DATE	BY


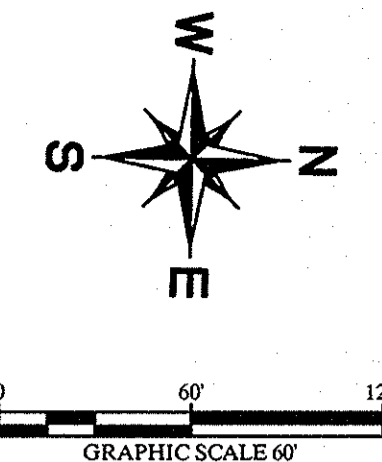


**LEGEND**

	SHADOW VEHICLE WITH IMPACT ATTENUATOR
	CHANNELIZATION DRUM
	TRAFFIC CONTROL SIGN AND POST
	LEFT FLASHING ARROW BOARD
	WORK AREA DURING CONSTRUCTION

- NOTES**
- ALL TRAFFIC CONTROL SHALL CONFORM TO THE LATEST VERSION OF THE TEXAS MANUAL ON UNIFORM TRAFFIC CONTROL DEVICES (TMUTCD), PART VI. FIELD MODIFICATIONS MAY BE MADE TO ADDRESS LOCAL CONDITIONS WITH THE APPROVAL OF THE ENGINEER.
  - CONTRACTOR IS RESPONSIBLE FOR INSTALLATION, MAINTENANCE, AND REMOVAL OF TRAFFIC CONTROL DEVICES. TRAFFIC CONTROL DEVICES SHOULD BE INSPECTED DAILY AND REPAIRED OR REPLACED AS NECESSARY. AFTER REMOVAL, CONTRACTOR IS RESPONSIBLE FOR RESTORATION OF MODIFICATIONS TO ROADWAY AND SIDEWALK SURFACES, ROADWAY MARKINGS, AND SIGNAGE DUE TO TRAFFIC CONTROL DEVICES OR CONSTRUCTION ACTIVITY.
  - DIMENSIONS SHOWN ARE TO FACE OF CURB.
  - TEMPORARY TRAFFIC CONTROL CRITERIA:  
POSTED SPEED IS 55 MPH.  
• CHANNELIZED DEVICE SPACING: 25' MAXIMUM (AS SHOWN)  
• SIGN SPACING: 500' MINIMUM (AS SHOWN)
  - NO TRAFFIC LANE OR SIDEWALK ALONG SOUTHBOUND DALLAS PARKWAY TO BE CLOSED WITHOUT FIRST OBTAINING THE APPROPRIATE PERMIT FROM PAUL THOMPSON OR RUSSELL FINLEY WITH THE CITY OF DALLAS PUBLIC WORKS AND TRANSPORTATION DEPT. (P&T). CLOSURE OF ANY TRAFFIC LANE MUST BE RESTRICTED TO THE HOURS OF 9:00 AM TO 3:30 PM WORKDAYS.
  - WHEN TRAFFIC CONTROL PLAN IS NOT IN EFFECT, REMOVE ALL DEVICES FROM THE TRAVELED LANE AND COVER OR REMOVE ALL WARNING SIGNS.
  - CONTRACTOR TO MAINTAIN ACCESS TO EXISTING ACTIVE DRIVEWAYS EXCEPT WHERE NOTED.
  - IF THE TRAFFIC CONTROL PLAN IS IN EFFECT DURING THE HOURS OF DARKNESS, ALL CHANNELIZATION DEVICES SHALL HAVE A TYPE "A" STEADY-BURN WARNING LIGHT OR EQUIVALENT REFLECTOR, AND ALL WARNING SIGNS SHALL HAVE A TYPE "A" LOW-INTENSITY FLASHING WARNING LIGHT.

App. \_\_\_\_\_  
Revisions \_\_\_\_\_  
No. \_\_\_\_\_ Date \_\_\_\_\_

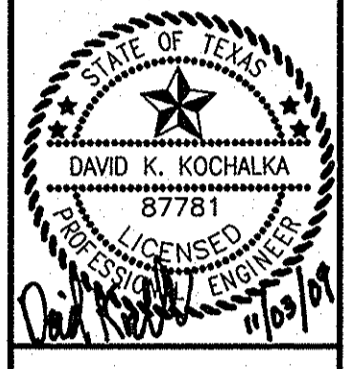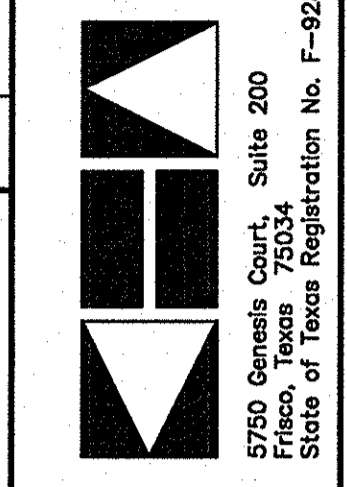


**METHODIST HOSPITAL FOR SURGERY**  
**ADDISON, TEXAS**  
**FILE NUMBER: 311T-7863**

**TRAFFIC CONTROL PLAN**

Scale: AS SHOWN  
Designed by: RCC  
Drawn by: RCC  
Checked by: DKK  
Date: 11/09/09  
Project No. 6906500

SHEET  
**C-23**

**RECORD DRAWINGS (SEPTEMBER 2010)**  
INFORMATION PROVIDED BY:  
Rogers-O'Brien Construction Company

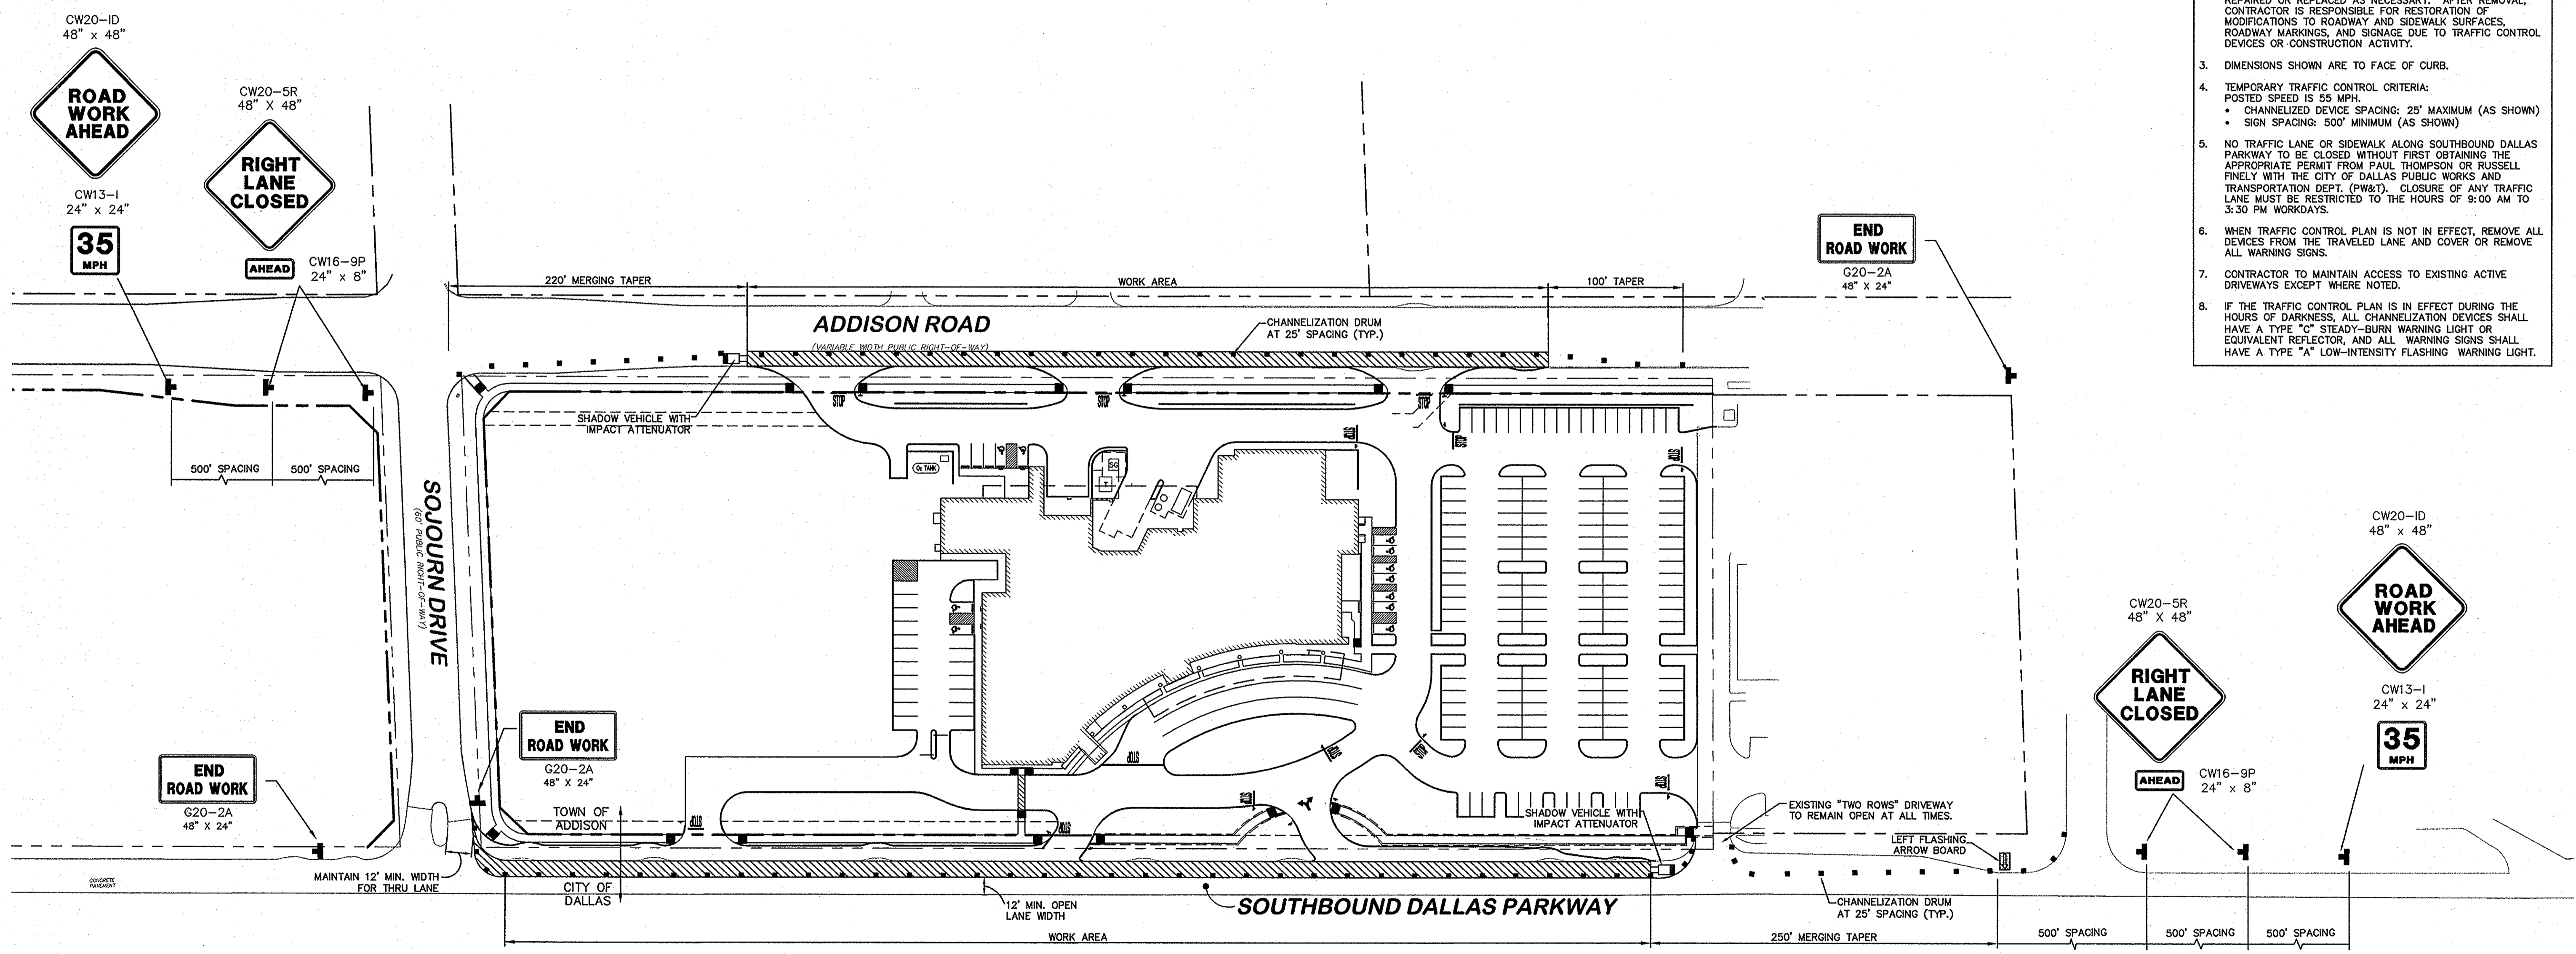

IMAGES  
PLOTTED BY  
DWG NAME  
DATE  
SCALE

**DALLAS NORTH TOLLWAY**  
(VARIABLE WIDTH PUBLIC RIGHT-OF-WAY)

CW20-ID  
48" x 48"  
**ROAD WORK AHEAD**

CW20-5R  
48" x 48"  
**RIGHT LANE CLOSED**

CW13-I  
24" x 24"  
**35 MPH**

CW16-9P  
24" x 8"  
**AHEAD**

**END ROAD WORK**  
G20-2A  
48" x 24"

**END ROAD WORK**  
G20-2A  
48" x 24"

**END ROAD WORK**  
G20-2A  
48" x 24"

**RIGHT LANE CLOSED**

CW20-ID  
48" x 48"  
**ROAD WORK AHEAD**

CW13-I  
24" x 24"  
**35 MPH**

**AHEAD**  
CW16-9P  
24" x 8"


DISCLAIMER: The use of this standard is governed by the "Texas Engineering Practice Act". No warranty of any kind is made by TxDOT for any purpose whatsoever. TxDOT assumes no responsibility for the conversion of this standard to other formats or for incorrect results or damages resulting from its use.

ACC: LEVELS DISPLAYED

**BOX DATA**


SECTION DIMENSIONS					Fill Height (ft)	M (Min) (in)	REINFORCING (in <sup>2</sup> /ft) ②								Lift Weight (Tons) ①
S (ft)	H (ft)	T <sub>T</sub> (in)	T <sub>B</sub> (in)	T <sub>S</sub> (in)			A <sub>S1</sub>	A <sub>S2</sub>	A <sub>S3</sub>	A <sub>S4</sub>	A <sub>S5</sub>	A <sub>S6</sub>	A <sub>S7</sub>	A <sub>S8</sub>	
4	2	7.5	6	5	<2	-	0.18	0.40	0.20	0.12	0.20	0.18	0.18	0.14	4.5
4	2	5	5	5	2<3	38	0.21	0.23	0.20	0.12	-	-	-	-	3.6
4	2	5	5	5	3-5	38	0.12	0.12	0.12	0.12	-	-	-	-	3.6
4	2	5	5	5	10	38	0.12	0.12	0.13	0.12	-	-	-	-	3.6
4	2	5	5	5	15	38	0.14	0.17	0.18	0.12	-	-	-	-	3.6
4	2	5	5	5	20	38	0.19	0.23	0.23	0.12	-	-	-	-	3.6
4	2	5	5	5	25	38	0.23	0.28	0.28	0.12	-	-	-	-	3.6
4	2	5	5	5	30	38	0.28	0.33	0.33	0.12	-	-	-	-	3.6
4	2	5	5	5	35	38	0.33	0.38	0.39	0.12	-	-	-	-	3.6
4	3	7.5	6	5	<2	-	0.18	0.45	0.23	0.12	0.22	0.18	0.18	0.14	5.0
4	3	5	5	5	2<3	38	0.16	0.28	0.25	0.12	-	-	-	-	4.1
4	3	5	5	5	3-5	38	0.12	0.12	0.13	0.12	-	-	-	-	4.1
4	3	5	5	5	10	38	0.12	0.14	0.15	0.12	-	-	-	-	4.1
4	3	5	5	5	15	38	0.12	0.20	0.20	0.12	-	-	-	-	4.1
4	3	5	5	5	20	38	0.14	0.26	0.26	0.12	-	-	-	-	4.1
4	3	5	5	5	25	38	0.17	0.32	0.32	0.12	-	-	-	-	4.1
4	3	5	5	5	30	38	0.21	0.38	0.38	0.12	-	-	-	-	4.1
4	3	5	5	5	35	38	0.25	0.44	0.44	0.12	-	-	-	-	4.1
4	4	7.5	6	5	<2	-	0.18	0.47	0.25	0.12	0.23	0.18	0.18	0.14	5.5
4	4	5	5	5	2<3	38	0.13	0.31	0.28	0.12	-	-	-	-	4.6
4	4	5	5	5	3-5	38	0.12	0.14	0.15	0.12	-	-	-	-	4.6
4	4	5	5	5	10	38	0.12	0.15	0.16	0.12	-	-	-	-	4.6
4	4	5	5	5	15	38	0.12	0.21	0.22	0.12	-	-	-	-	4.6
4	4	5	5	5	20	38	0.12	0.27	0.28	0.12	-	-	-	-	4.6
4	4	5	5	5	25	38	0.14	0.33	0.34	0.12	-	-	-	-	4.6
4	4	5	5	5	30	38	0.17	0.39	0.40	0.12	-	-	-	-	4.6
4	4	5	5	5	35	38	0.20	0.45	0.46	0.12	-	-	-	-	4.6

- ① For Box Length = '8'-0"
- ② A<sub>S1</sub> thru A<sub>S4</sub>, A<sub>S7</sub> and A<sub>S8</sub> are minimum required areas of reinforcement per linear foot of box length. A<sub>S6</sub> and A<sub>S5</sub> are minimum required areas of reinforcement per linear foot of box width.

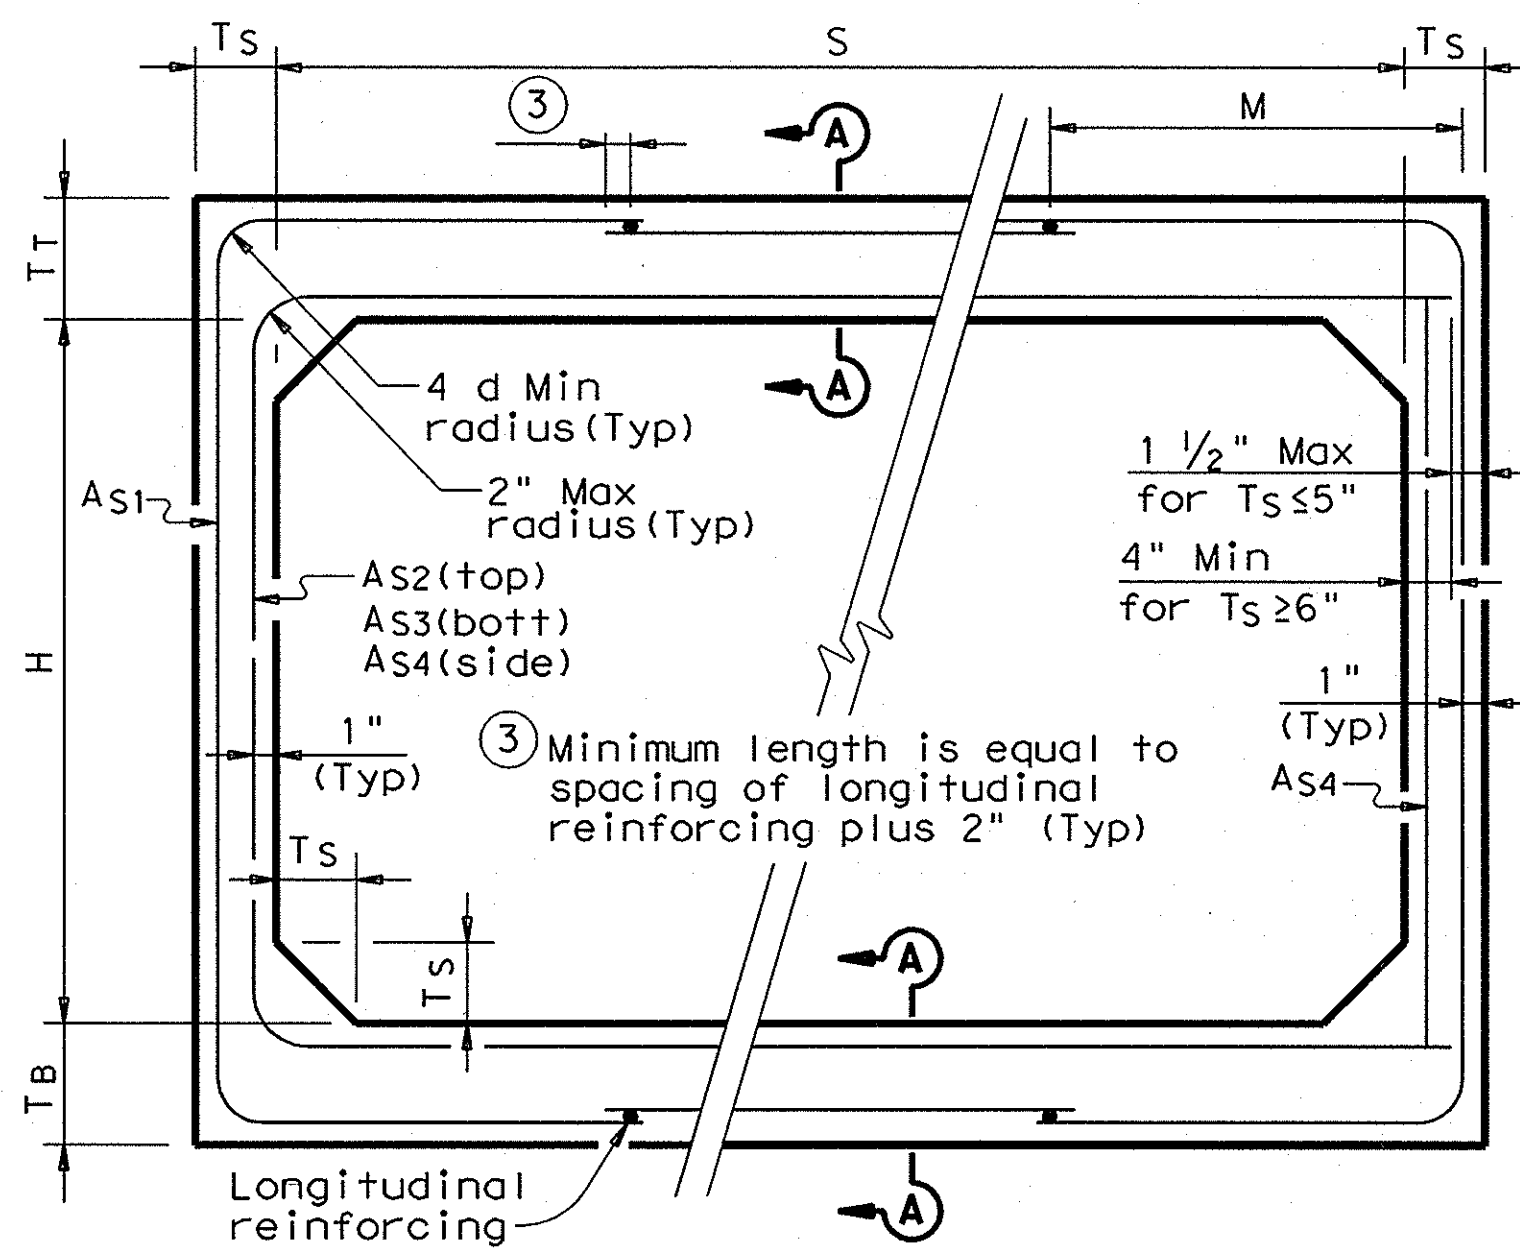


**CORNER OPTION "A"**      **CORNER OPTION "B"**

**FILL HEIGHT 2 FT AND GREATER**

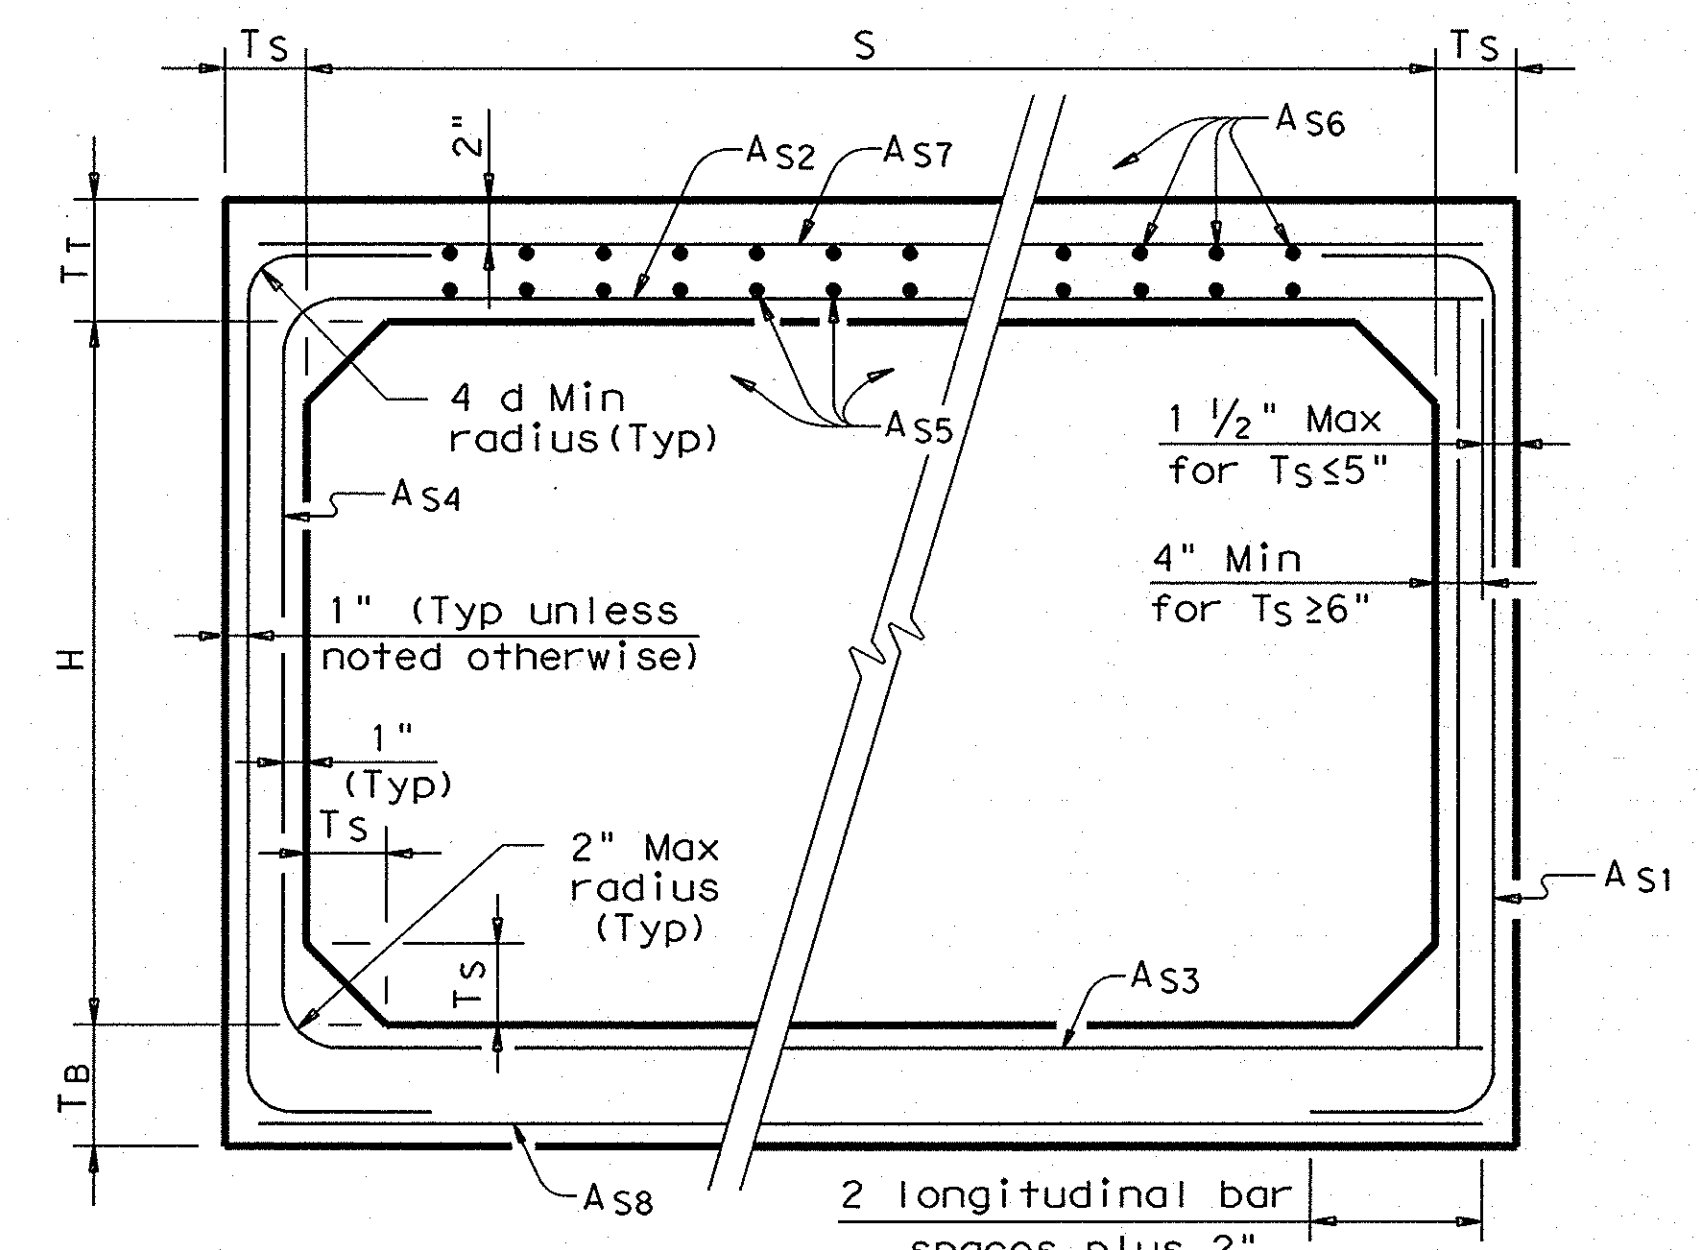

**CORNER OPTION "A"**      **CORNER OPTION "B"**

**FILL HEIGHT LESS THAN 2 FT**

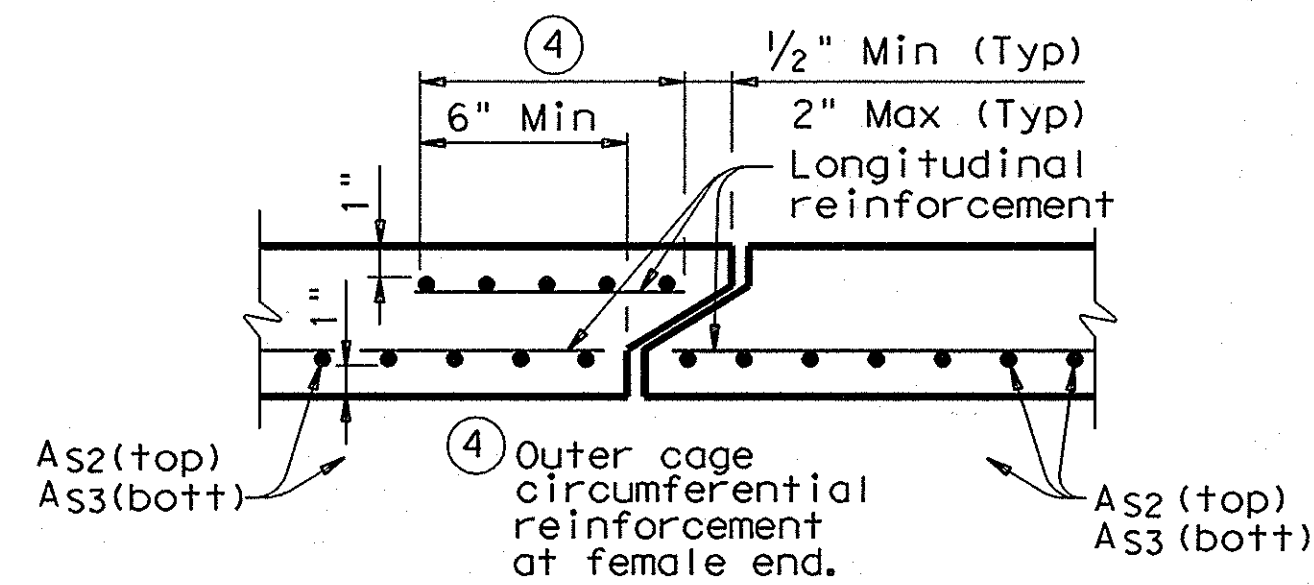

**SECTION A-A**

(TOP AND BOTTOM SLAB JOINT REINFORCEMENT)

**GENERAL NOTES:**

Designs shown conform to ASTM C1433. Refer to ASTM C1433 for information or details not shown. All concrete shall be Class "H" Concrete with a minimum compressive strength of 5,000 psi. See SCP-MD standard sheet for miscellaneous details and notes not shown. In lieu of furnishing the designs shown on this sheet, the contractor may furnish an alternate design that is equal to or exceeds the box design for the design fill height in the table. Shop plans for alternate designs shall be submitted in accordance with Item "Precast Concrete Structures".

**RECORD DRAWINGS (SEPTEMBER 2010)**

INFORMATION PROVIDED BY:  
Rogers-O'Brien Construction Company

HS20 LOADING

Texas Department of Transportation  
Bridge Division

**SINGLE BOX CULVERTS PRECAST**  
**4'-0" SPAN**

**SCP-4**






FILE: scp04ste.dgn	DN: GAF	CK: LMW	DW: BWH/TxDOT	CR: GAF
© TxDOT May 2005	DISTRICT	FEDERAL AID PROJECT		SHEET
REVISIONS				
06-06 - Revised reinforcing.	COUNTY	CONTROL	SECT	JOB
08-07 - General notes.				HIGHWAY





DISCLAIMER: The use of this standard is governed by the "Texas Engineering Practice Act". No warranty of any kind is made by TxDOT for any purpose whatsoever. TxDOT assumes no responsibility for the conversion of this standard to other formats or for incorrect results or damages resulting from its use.


COMMENTS:  
ACTIVE FILE LEVELS DISPLAYED

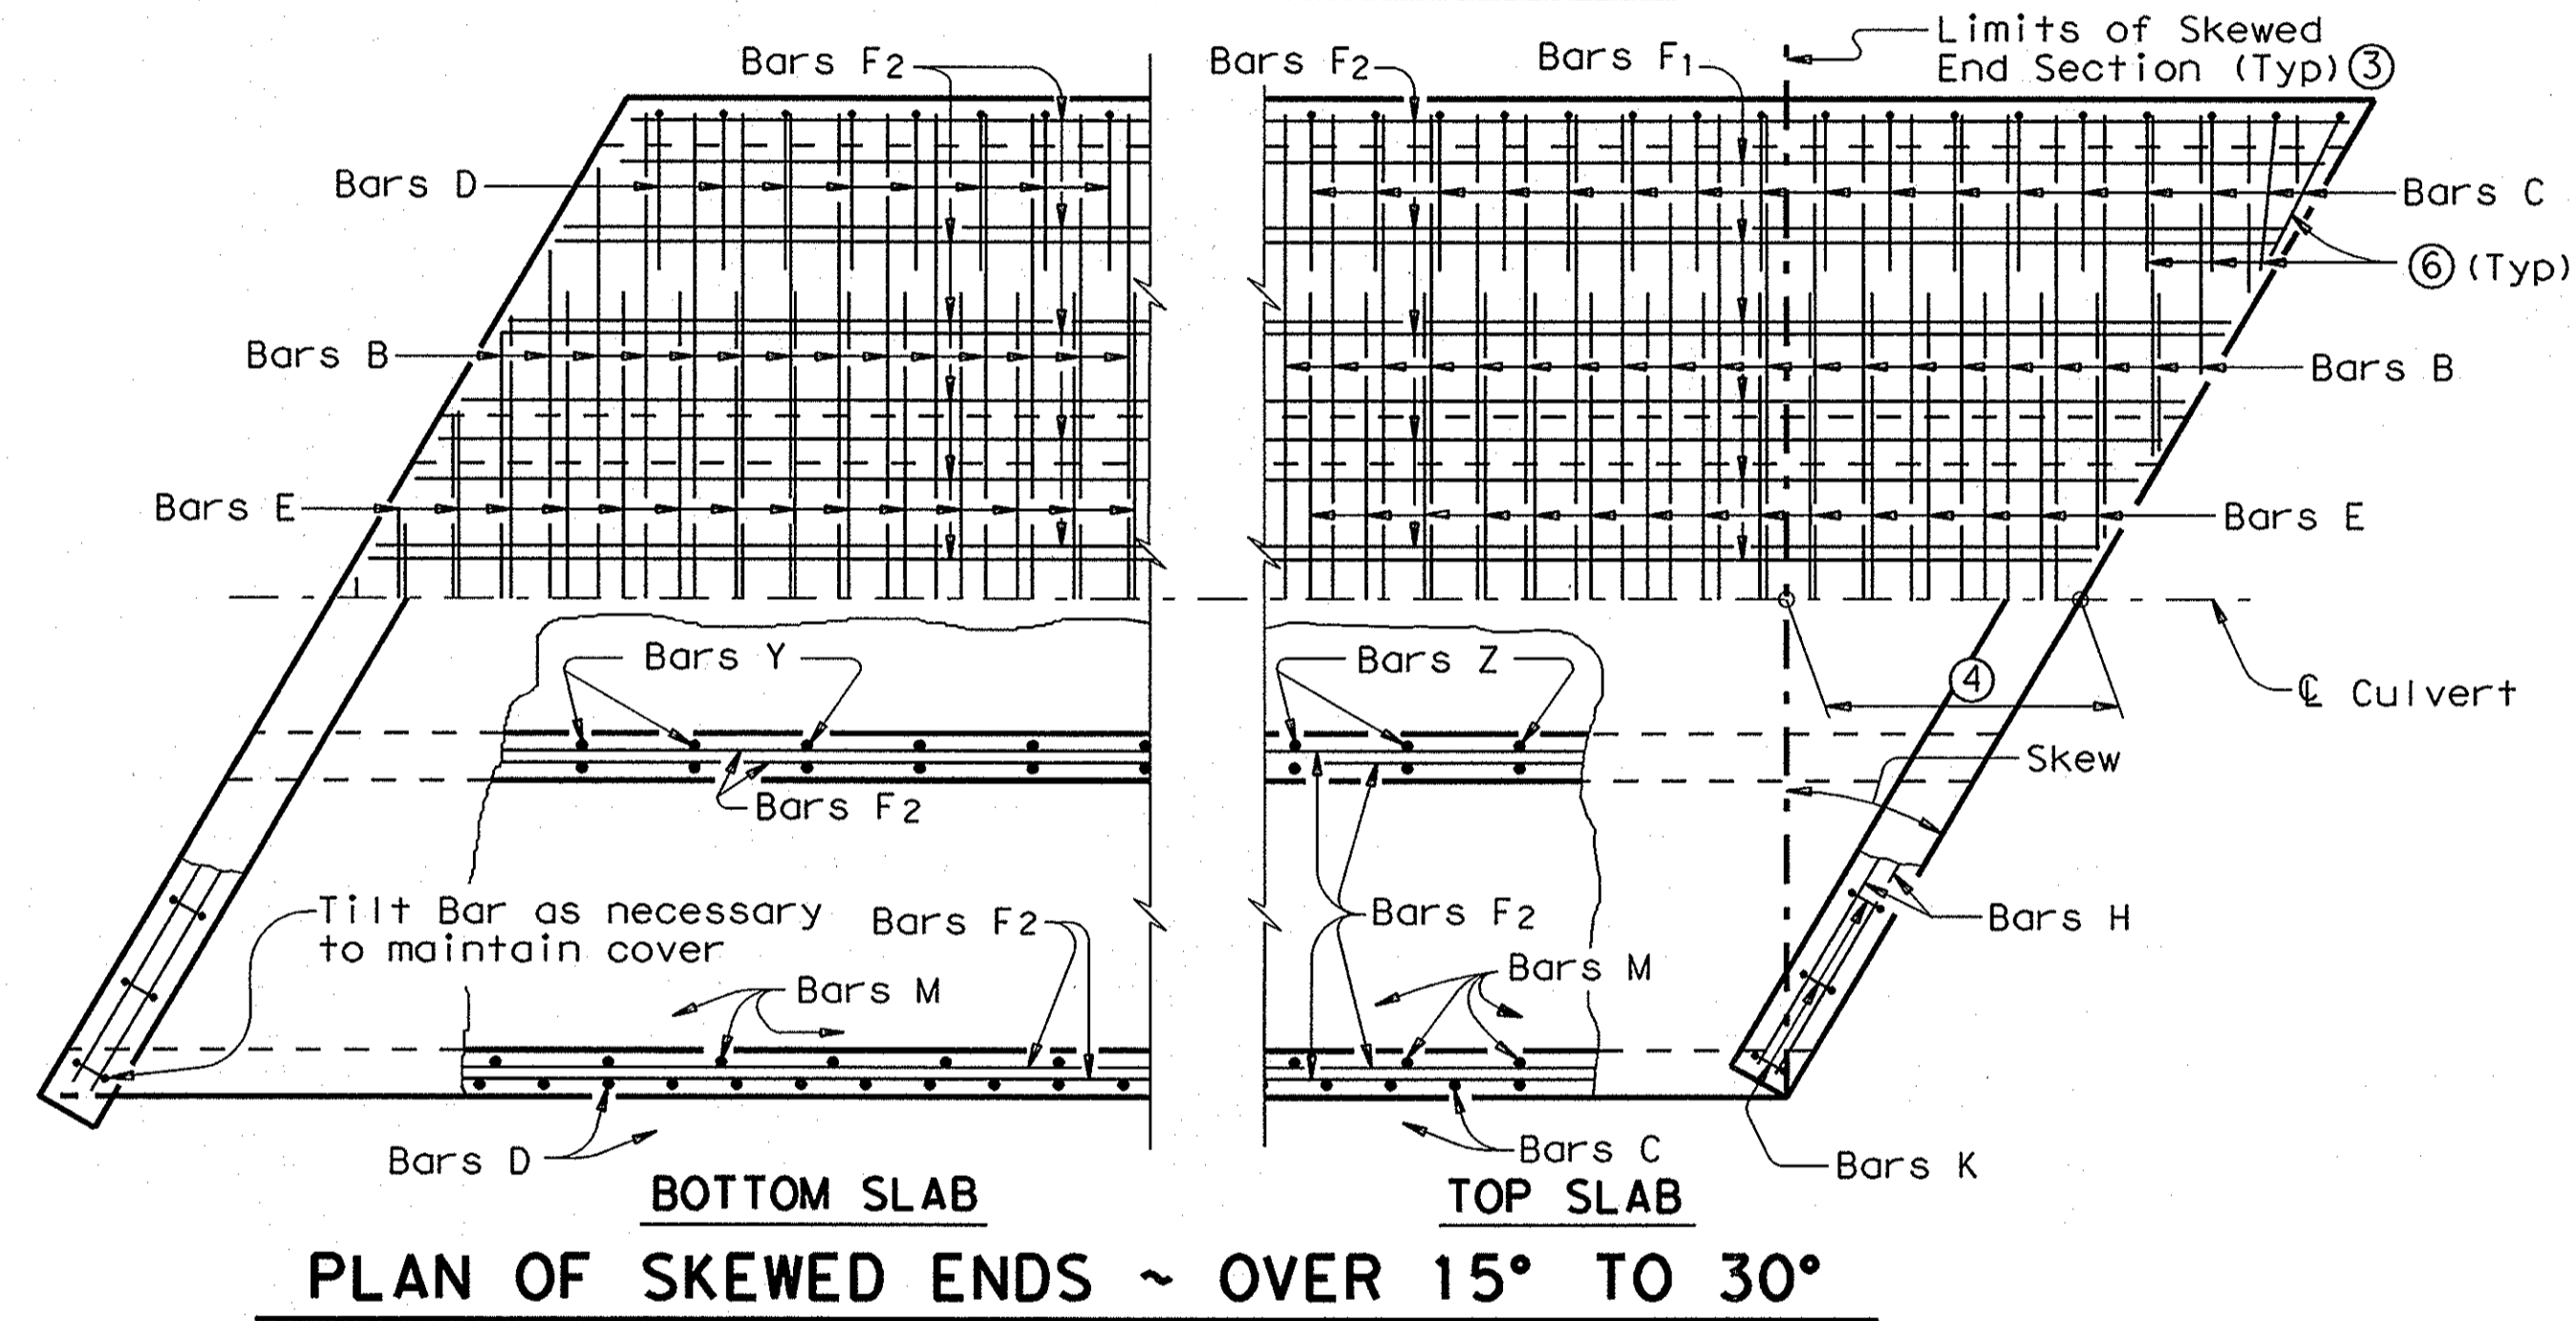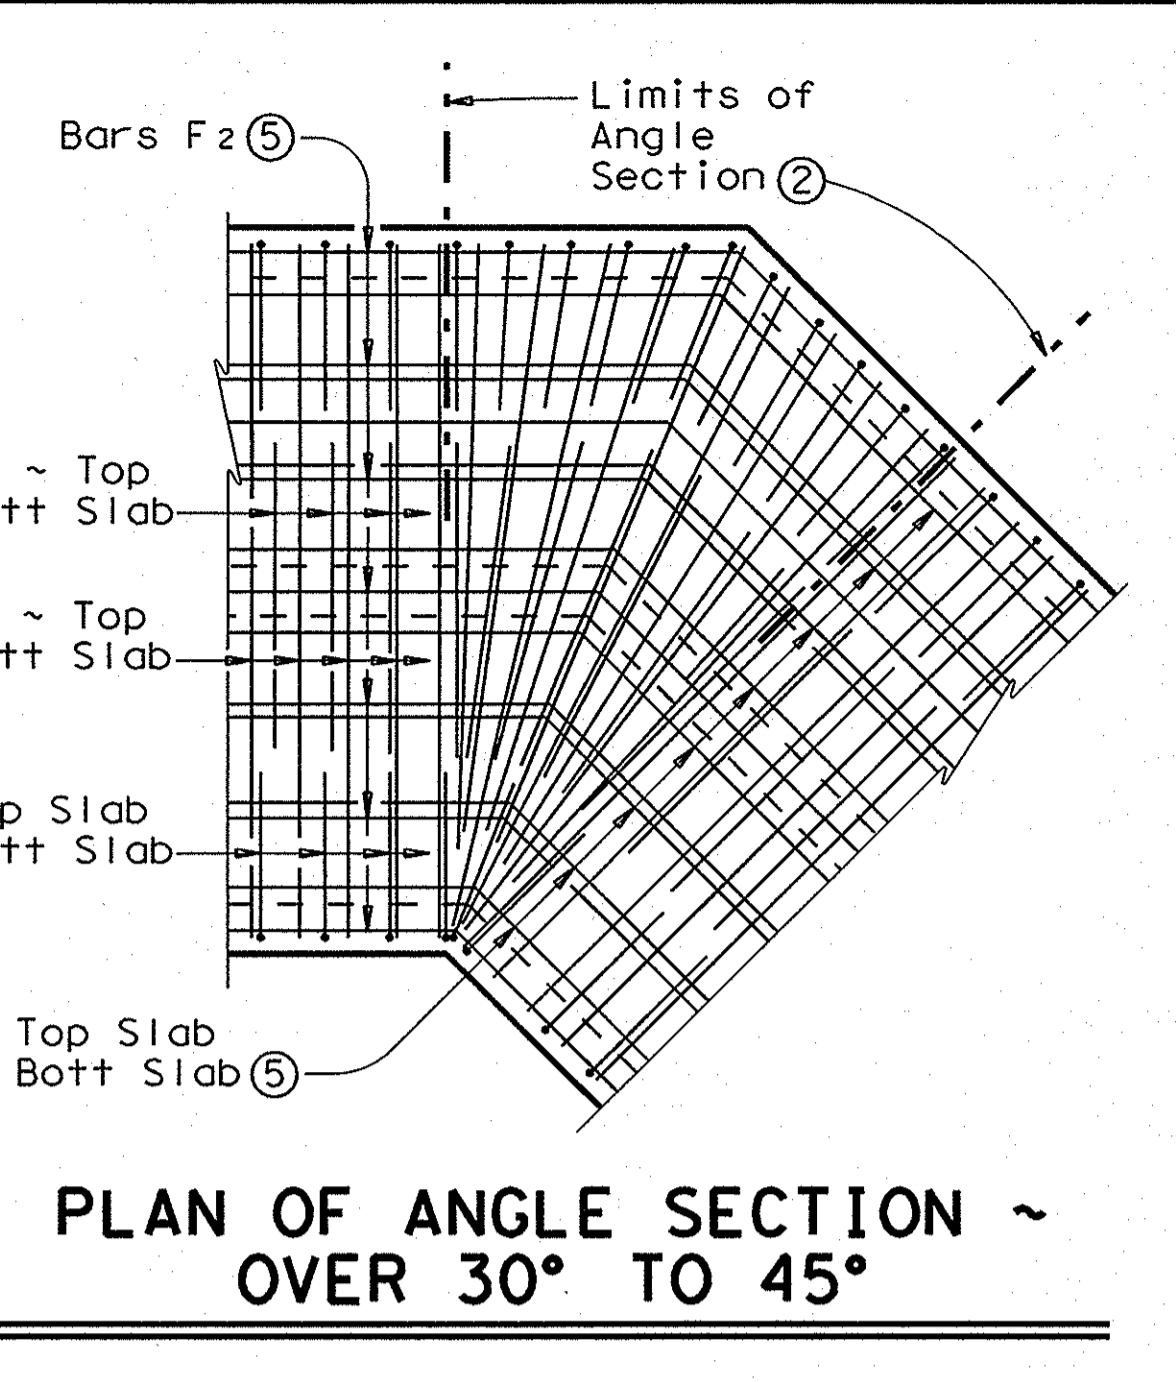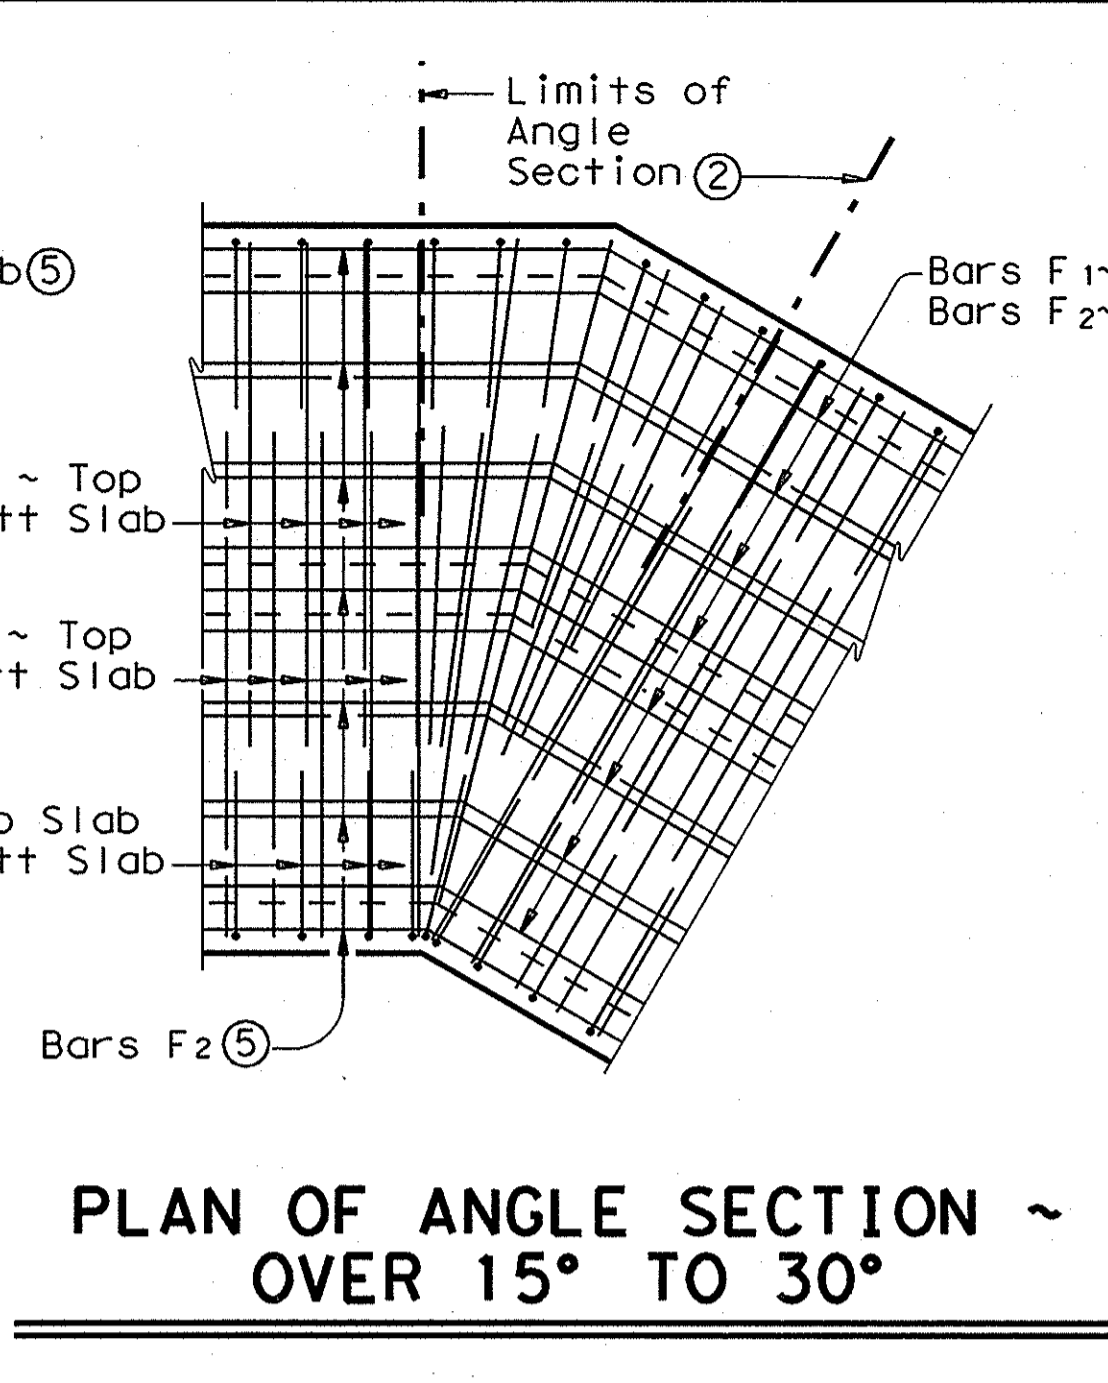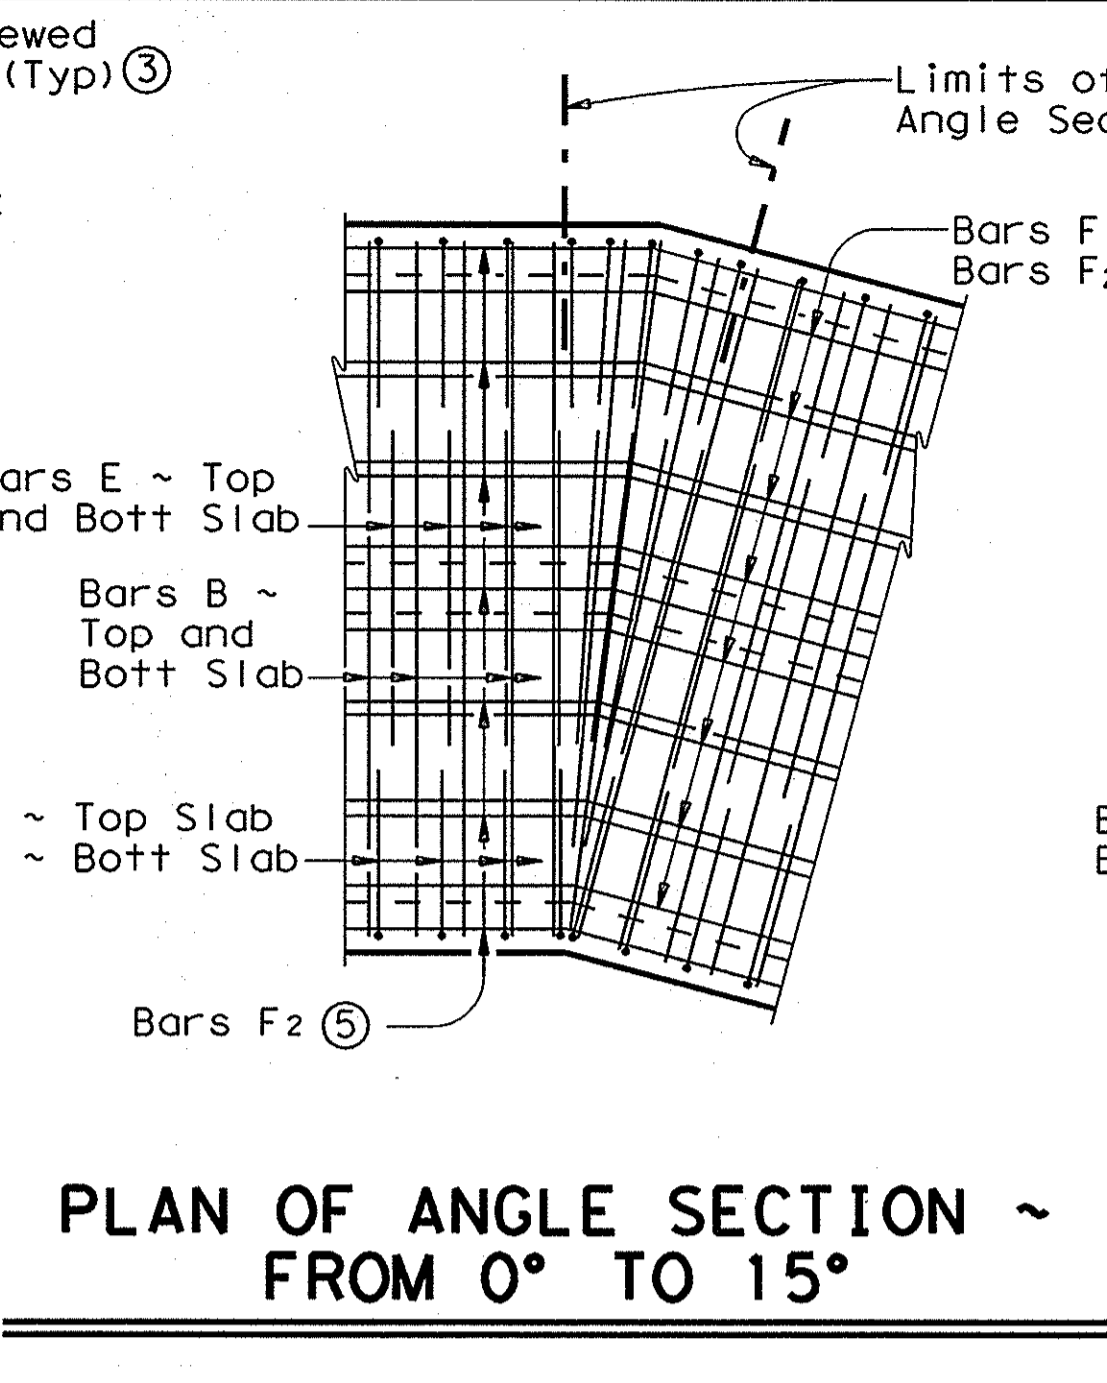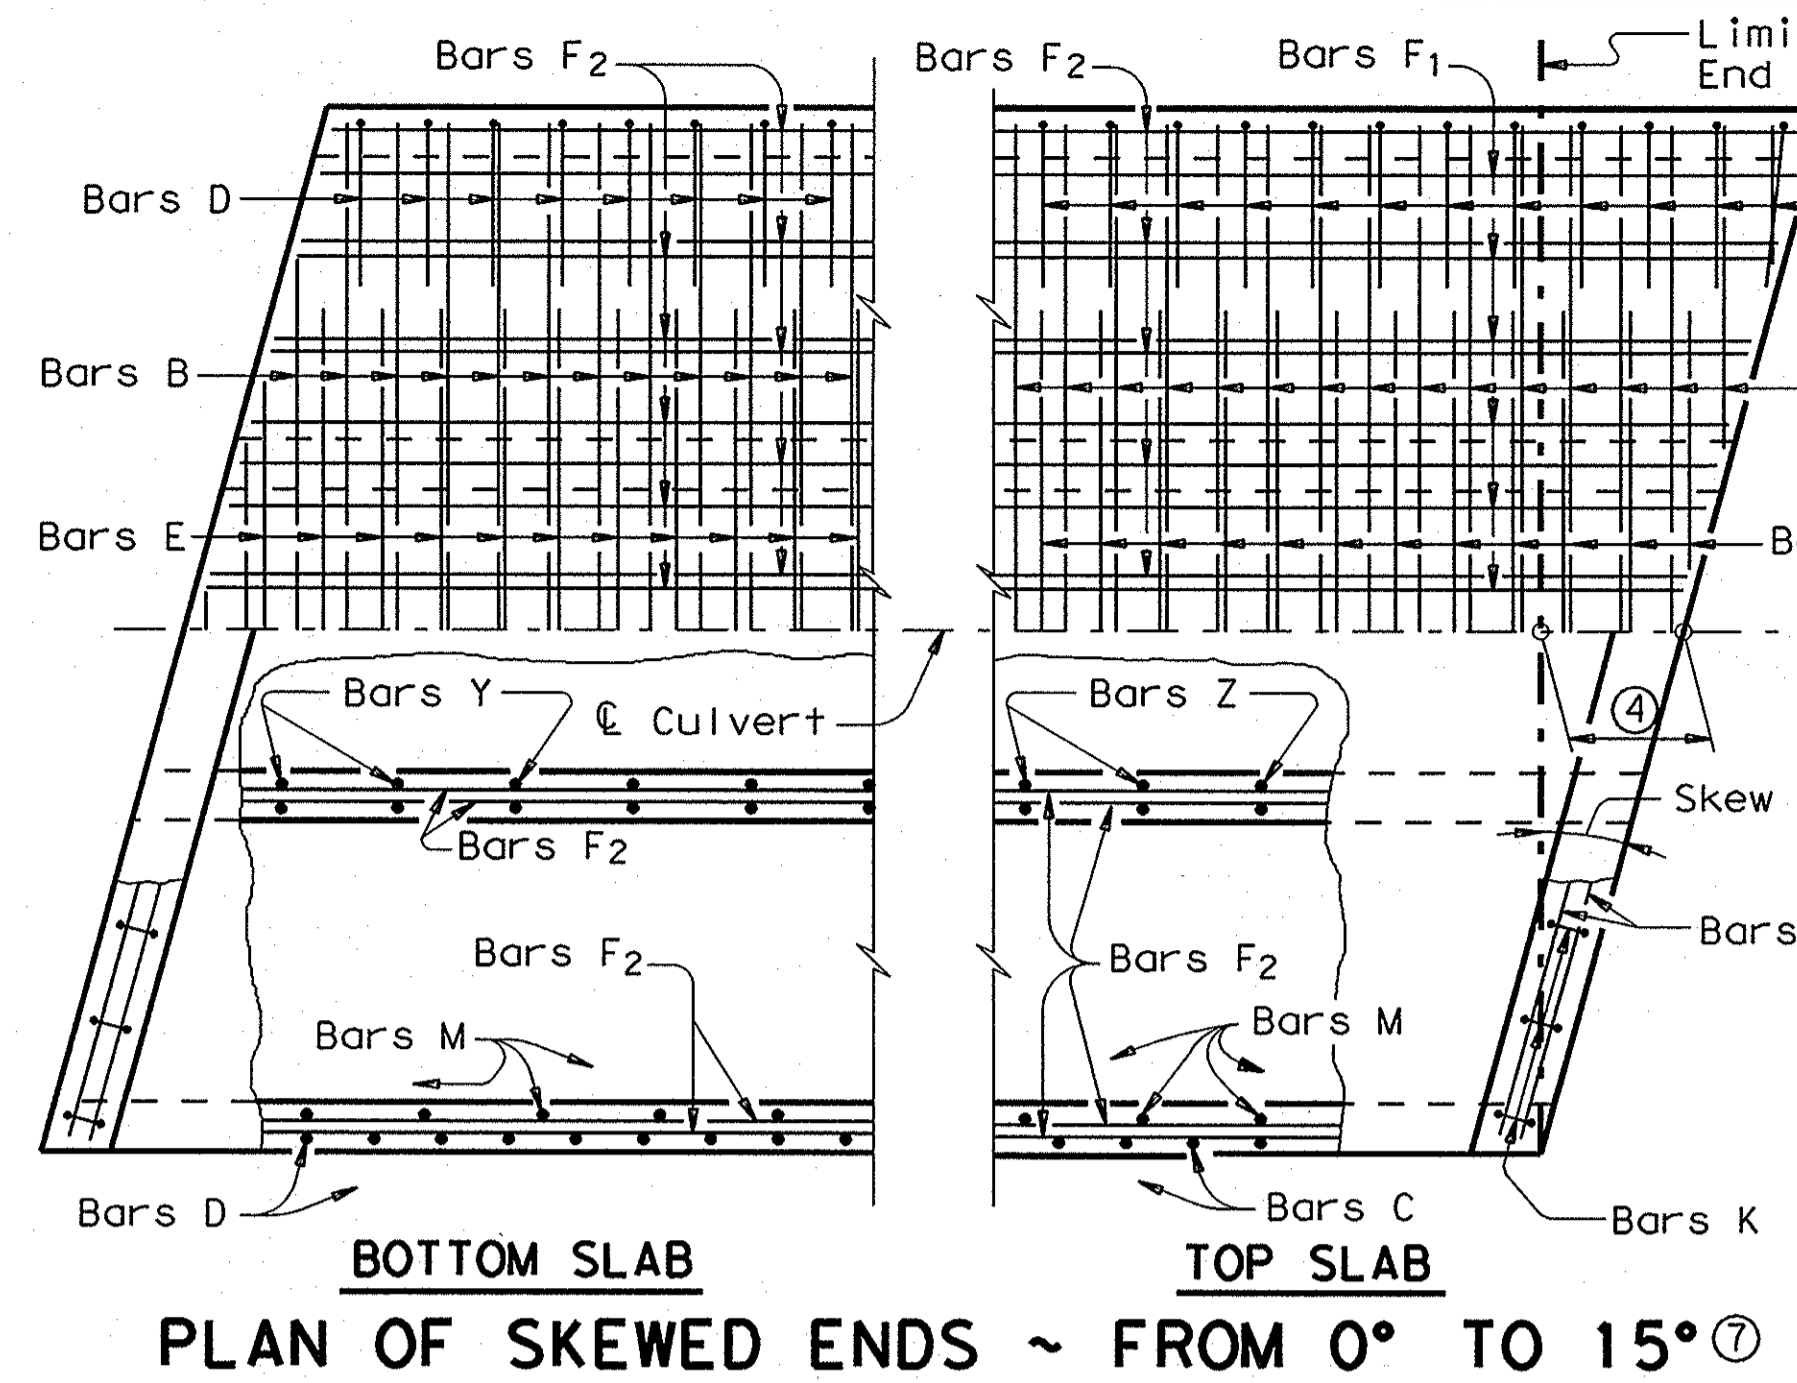


**GENERAL NOTES:**

Designed according to current AASHTO Standard and Interim Specifications.  
 All reinforcing steel shall be Grade 60.  
 All concrete shall be Class "C" with these exceptions:  
 use Class "S" for top slabs of culverts with overlay, with 1-to-2 course surface treatment, or with the top slab as the final riding surface.  
 Class "C" concrete shall have a minimum compressive strength of 3,600 psi. Class "S" concrete shall have a minimum compressive strength of 4,000 psi.  
 Refer to Multiple Box Culverts Cast-in-Place standard for details of straight sections of culvert. For skewed sections and angle sections refer to Multiple Box Culverts Cast-in-Place standard for slab and wall dimensions, bar sizes, maximum bar spacing, and any other details not shown. For Skewed ends with curbs, adjust length of Bars H, number of Bars K, curb concrete volume and reinforcing steel weight by dividing the values shown on the culvert standards by the cosine of the skew angle.  
 The use of permanent forms is not allowed.  
 Laps for Bars H, when required, shall be 1'-9" for uncoated bars and 2'-7" for epoxy coated.

- ① For box culverts with less than 2'-0" of fill, the top slab shall be broken back to provide a minimum 1'-10" lap of the existing longitudinal bars with the longitudinal bars in the extension. If the depth of fill is 2'-0" or greater, the top slab shall be broken back to provide a 1'-0" minimum embedment of existing longitudinal reinforcing into the extension. Alternatively, if the fill height is greater than 2'-0", the existing curb may be left in place and 2'-0" long #6 bars shall be drilled and grouted 1'-0" into the existing top slab at 1'-6" center to center spacing. Wings and apron shall be broken back as necessary to install the extension. Exposed wingwall and apron reinforcing may be removed or cleaned and included in the extension. When lengthening existing box culverts with dimensions different than current standard dimensions, horizontal and vertical transitions shall be formed as directed by the Engineer. Bottom slabs shall match to maintain an uninterrupted flow line. Existing and new reinforcing shall be field bent into transition maintaining specified cover requirements. For top slabs of culverts with overlay, with 1-to-2 course surface treatment, or with the top slab as the final riding surface, the "H" dimension may be adjusted to provide a smooth riding surface.
- ② When the spacing between Bars B or Bars E becomes less than half of the normal spacing, bars shall be cut to avoid fouling
- ③ The length of Bars B and E will vary in the skewed end sections
- ④  $[One\ half\ of\ overall\ width] \times [Tan\ of\ the\ skew\ angle]$
- ⑤ Bars F1 and F2 shall be continuous through the angle section. They shall be bent to remain parallel to the walls of the Box Culvert.
- ⑥ When necessary to avoid fouling in acute corners, the slab extension leg of Bars C and Bars D may be shortened to a minimum of 1'-6" for skews of 30° and 45°.
- ⑦ For skews of 15° or less, the contractor has the option of placing Bars B, C, D and E parallel to the skewed end while maintaining spacing along centerline box. Lengths of Bars B and E shown on the standards shall be increased to accommodate the skew.

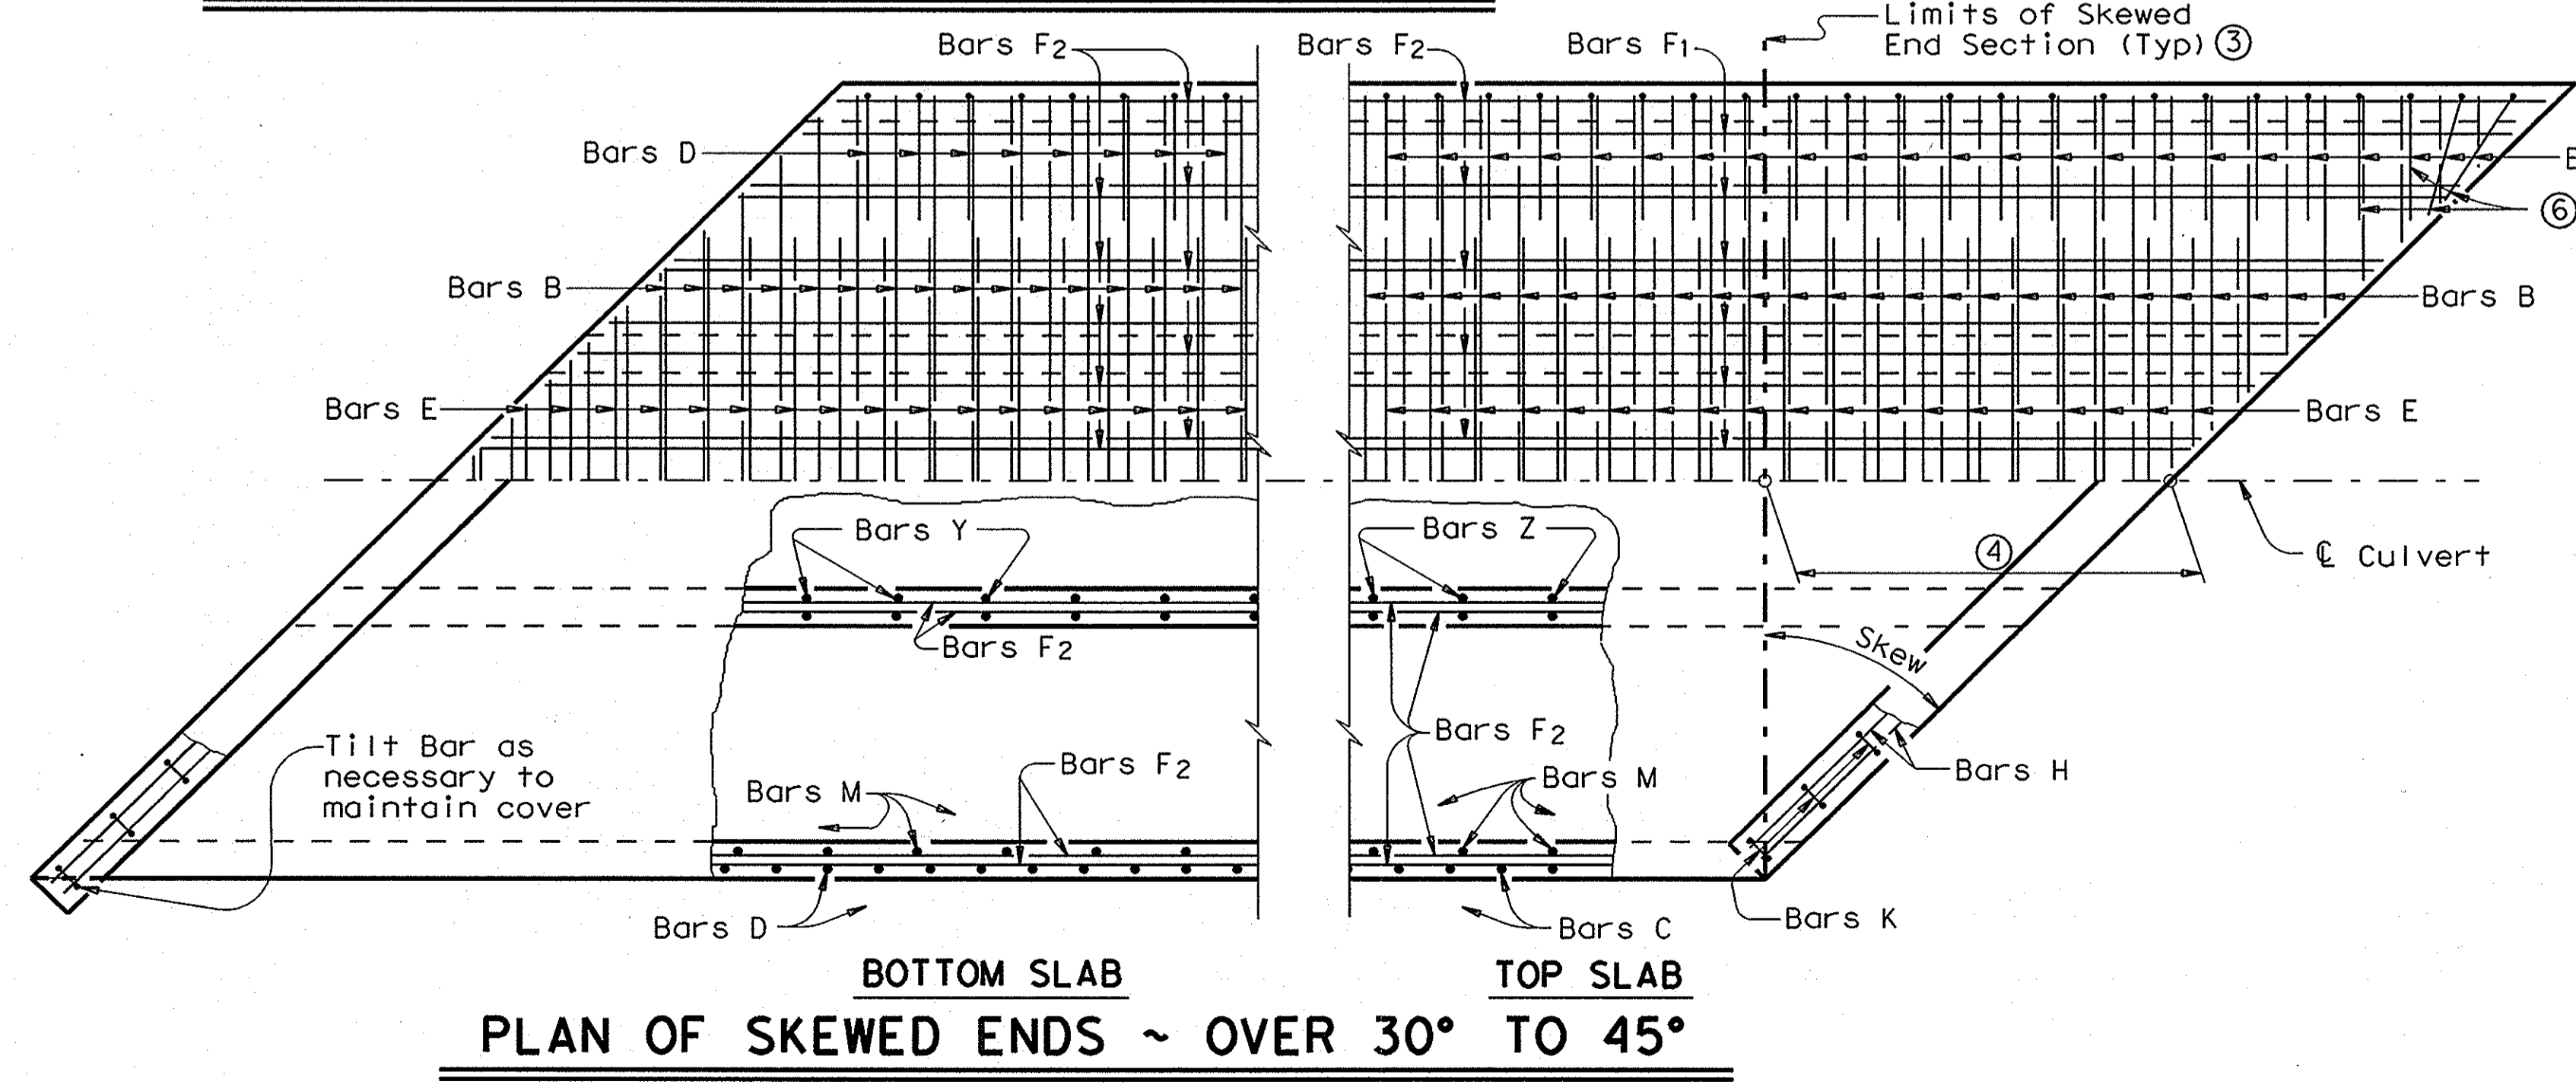

**RECORD DRAWINGS (SEPTEMBER 2010)**  
 INFORMATION PROVIDED BY:  
 Rogers-O'Brien Construction Company

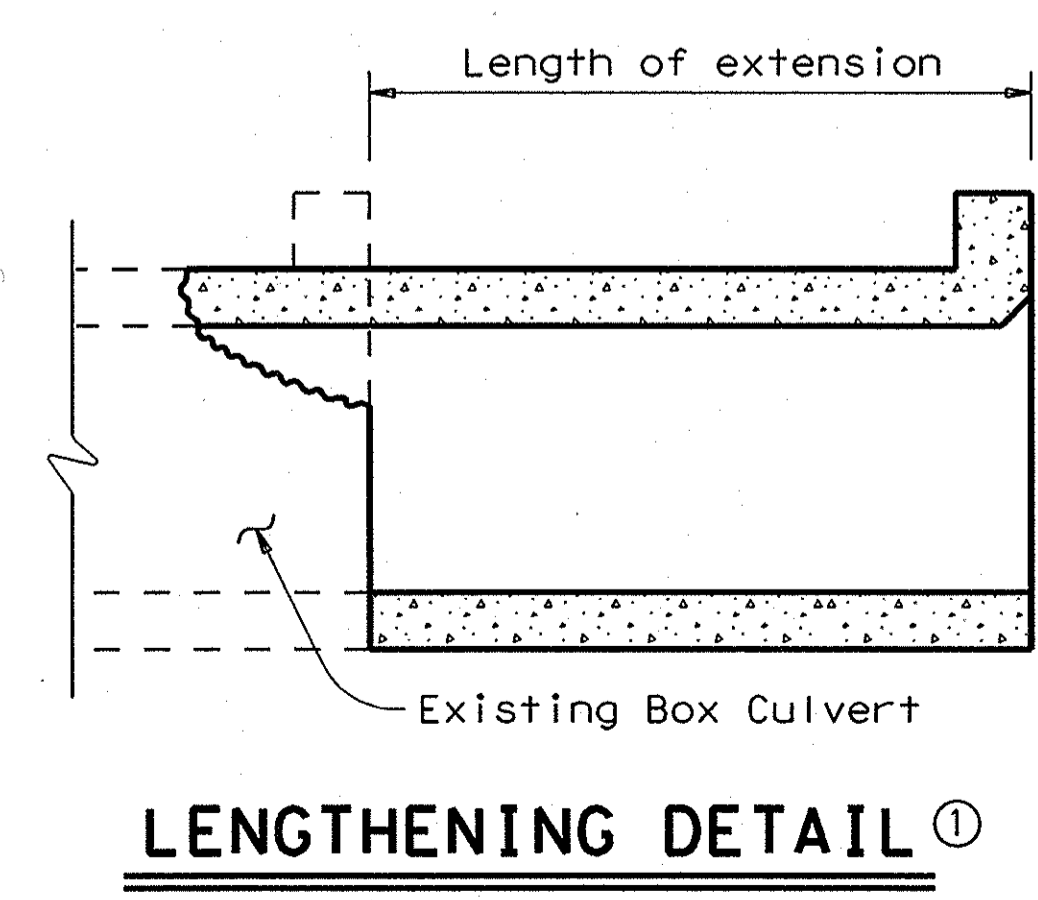

HS20 LOADING

Texas Department of Transportation  
 Bridge Division

**MULTIPLE BOX CULVERTS  
 CAST-IN-PLACE  
 MISCELLANEOUS DETAILS**

**MC-MD**

FILE: mc-mdste.dgn	DN: GAF	CK: LMW	DW: BWH/TxDOT	CK: GAF
© TxDOT May 2005		DISTRICT		SHEET
REVISIONS		FEDERAL AID PROJECT		
COUNTY	CONTROL	SECT	JOB	HIGHWAY