


PAVING, DRAINAGE, AND UTILITY CONSTRUCTION PLANS FOR METHODIST HOSPITAL FOR SURGERY WEST OF DALLAS NORTH TOLLWAY, EAST OF ADDISON ROAD, NORTH OF SOJOURN DRIVE ADDISON, TEXAS

PLANS SUBMITTAL/REVIEW LOG

FIRST SUBMITTAL TO TOWN OF ADDISON - NOT FOR CONSTRUCTION.	5/1/09
SECOND SUBMITTAL TO TOWN OF ADDISON - NOT FOR CONSTRUCTION.	6/17/09
THIRD SUBMITTAL TO TOWN OF ADDISON - NOT FOR CONSTRUCTION.	7/29/09
FOURTH SUBMITTAL TO TOWN OF ADDISON - NOT FOR CONSTRUCTION.	8/14/09
SUBMITTAL FOR CONSTRUCTION	8/25/09
CITY OF DALLAS COMMENTS	09/09/09
RESUBMITTAL TO TOWN OF ADDISON - NOT FOR CONSTRUCTION. MODIFICATIONS BASED ON CHANGE TO THE CENTRAL UTILITY PLAN.	10/21/09
RESUBMITTAL TO TOWN OF ADDISON	11/03/09

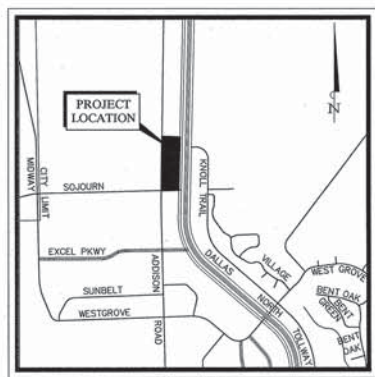

VICINITY MAP
N.T.S.

RECORD DWS
UPDATED
4/10/10

RECORD DWS
UPDATED
10/15/10

NOT
UPDATED
BE RECORDED
DETAILS

INDEX OF SHEETS

SHEET NO.	DESCRIPTION	DATE	REVISION
C-01	COVER SHEET	8/25/09	11/03/09
1 of 1	FINAL PLAN		12/21/09
C-02	GENERAL NOTES	8/25/09	11/03/09
C-03	DEMOLITION PLAN	8/25/09	11/03/09
C-04	DIMENSION CONTROL AND PAVING PLAN	8/25/09	11/03/09
C-05	GRADING PLAN	8/25/09	11/03/09
C-06	DRAINAGE AREA MAP	8/25/09	11/03/09
C-07	STORM SEWER CALCULATIONS	8/25/09	11/03/09
C-08	DETENTION CALCULATIONS	8/25/09	11/03/09
C-09	STORM SEWER PLAN	8/25/09	11/03/09
C-10	STORM SEWER PROFILES	8/25/09	11/03/09
C-11	STORM SEWER PROFILES	8/25/09	11/03/09
C-12	DETENTION PROFILES	8/25/09	11/03/09
C-13	DETENTION PROFILES	8/25/09	11/03/09
C-14	UTILITY PLAN	8/25/09	11/03/09
C-14A	UTILITY EXHIBIT	8/25/09	11/03/09
C-15	WATER LINE PROFILES	8/25/09	11/03/09
C-16	DALLAS NORTH TOLLWAY FRONTAGE ROAD TURN LANE #1	8/25/09	11/03/09
C-17	DALLAS NORTH TOLLWAY FRONTAGE ROAD TURN LANE #2	8/25/09	11/03/09
C-18	EROSION CONTROL PLAN	8/25/09	11/03/09
C-19	EROSION CONTROL DETAILS	8/25/09	11/03/09
C-20	CONSTRUCTION DETAILS	8/25/09	11/03/09
C-21	CONSTRUCTION DETAILS	8/25/09	11/03/09
C-22	CONSTRUCTION DETAILS	8/25/09	11/03/09
C-23	TRAFFIC CONTROL PLAN	8/25/09	11/03/09
SCP-4	TXDOT SINGLE BOX CULVERT - PRECAST - 4'-0" SPAN		
SCP-MD	TXDOT SINGLE BOX CULVERT - PRECAST - MISC. DETAILS		
MC-6-16	TXDOT MULTIPLE BOX CULVERTS CAST IN PLACE 6'-0" SPAN		
MC-6-13	TXDOT MULTIPLE BOX CULVERTS CAST IN PLACE 8'-0" SPAN		
MC-MD	TXDOT MULTIPLE BOX CULVERTS C.I.P. MISC. DETAILS		

- △ REVISION FROM CENTRAL UTILITY PLAN RELOCATION
- △ REVISION TO DOCTOR PARKING AND DOCK LAYOUT
- △ APPROVED CITY OF DALLAS TURN LANE PLANS
- △ MODIFIED SITE PLAN: SHIFTED 1 LANDSCAPE ISLANDS IN N. PARKING, ADDED PARKING TO DR. AREA, MODIFIED DOCK AREA, ADJUSTED RADIUS PAVING & SIDEWALK COMING OUT SOUTH SIDE OF MOTOR COURT, ADDED MOW STRIP, MODIFIED SIDEWALK AND PATIO AREA, INCREASED SIDEWALK FROM ELECTRICAL ROOM, MODIFIED CURB TO ALLOW FOR E-CALL BOXES

APPROVED FOR CONSTRUCTION
Town of Addison
Public Works Department
APPROVED BY: *David E. ...*
DATE: 3/16/2010



**RECORD DRAWINGS
(SEPTEMBER 2010)**
INFORMATION PROVIDED BY:
Rogers-O'Brien Construction Company

**STOP!
CALL BEFORE YOU DIG**
DIG TESS
1-800-DIG-TESS
(@ least 72 hours prior to digging)

All responsibility for the adequacy of these plans remains with the Engineer who prepared them. In approving these plans, the Town of Addison makes no representation of adequacy of the work of the Design Engineer.

**AUGUST 25, 2009
PW#2008-18**

DEVELOPER
ADVANTA MEDICAL DEVELOPMENT, LLC.
5225 VILLAGE CREEK DRIVE
PLANO, TX 75093
TEL: 972-499-6302

ARCHITECT
BOKA POWELL, LLC
8070 PARK LANE, SUITE 300
DALLAS, TX 75231
TEL: 972-701-9000
FAX: 972-991-3008

ENGINEER
 Kimley-Horn and Associates, Inc.
5750 GENESIS COURT
SUITE 200
FRISCO, TEXAS 75034
TEL. (972) 335-3580
FAX. 972-335-3779
CONTACT: DAVID KOCHALKA, P.E.
STATE OF TEXAS REGISTRATION NO. F-928