
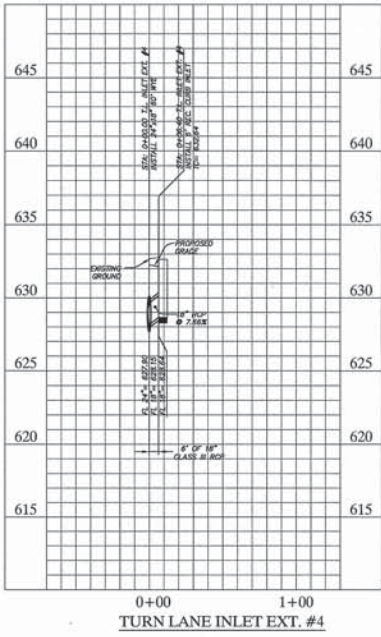
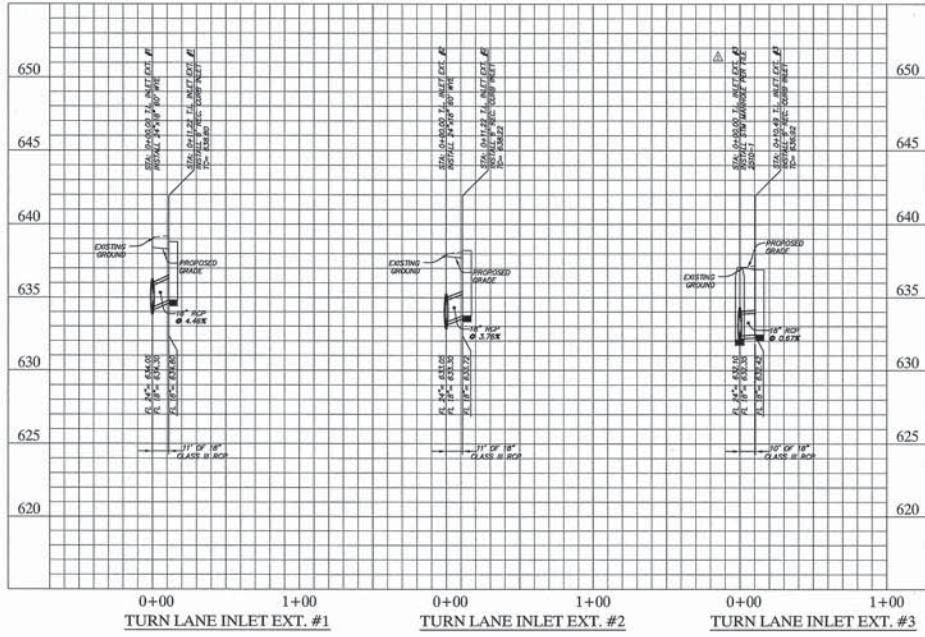


DATE: 08/11/10
 DRAWN BY: J. H. HORN
 CHECKED BY: J. H. HORN
 PROJECT: METHODIST HOSPITAL FOR SURGERY ADDISON, TEXAS
 SHEET: C-11

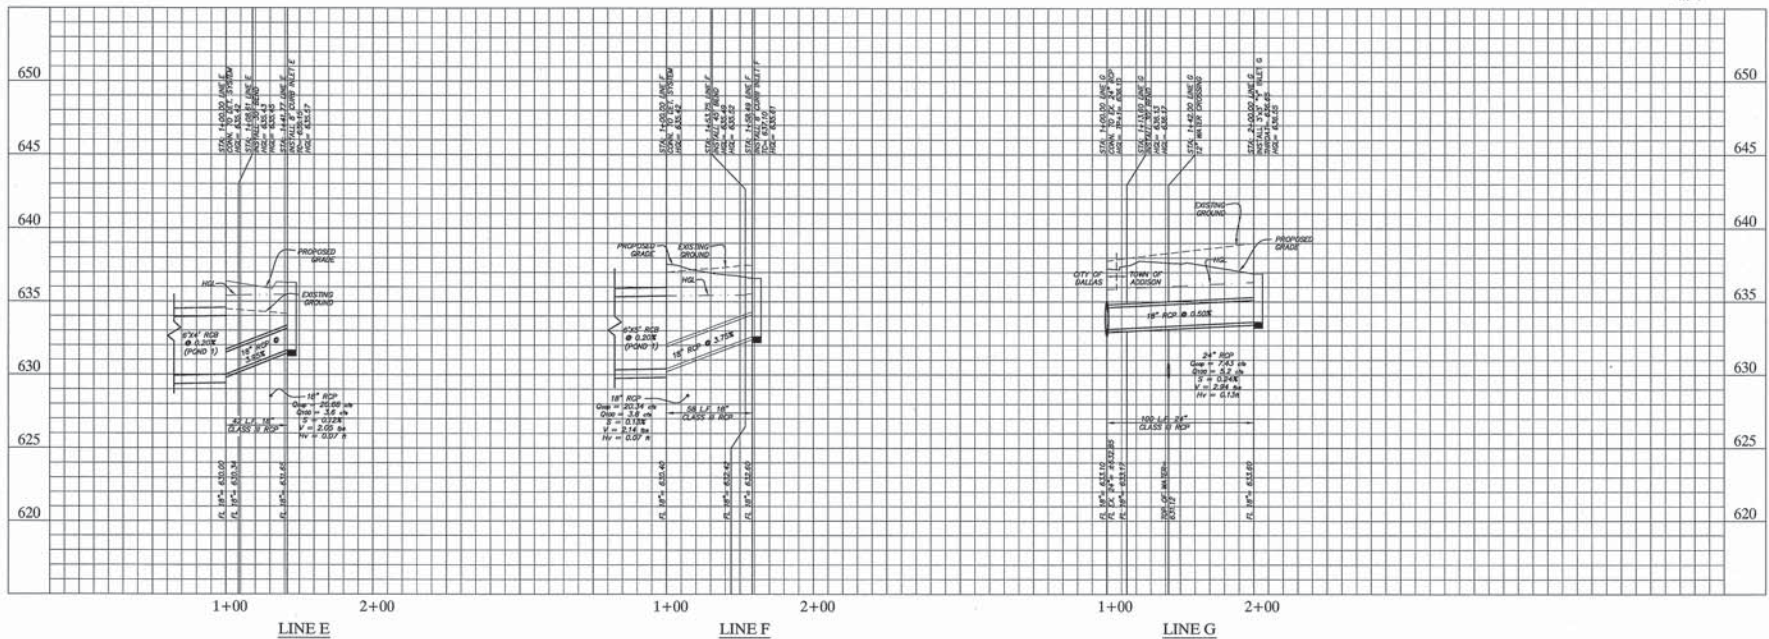

RECORD DRAWINGS
(SEPTEMBER 2010)
 INFORMATION PROVIDED BY:
 Rogers-O'Brien Construction Company

BENCHMARK

- BM #1 FOUND ON TOP OF THE CONCRETE BASE OF A LIGHT POLE IN THE CENTER MEDIAN OF EXCEL PARKWAY APPROXIMATELY 50 FEET WEST OF THE CENTERLINE OF ADDISON ROAD. (OVER TOWN OF ADDISON PLAN # 98503, SHEET 2, DATED JANUARY 1988) ELEV=644.41
- BM #2 SET ON TOP OF A CONCRETE CURB INLET LOCATED ON THE WEST SIDE OF DALLAS PARKWAY APPROXIMATELY 825 FEET NORTH OF THE CENTERLINE OF SOLOURN DRIVE. ELEV=638.78
- BM #3 SET ON TOP OF A CONCRETE CURB INLET LOCATED ON THE WEST SIDE OF DALLAS PARKWAY APPROXIMATELY 160 FEET NORTH OF THE CENTERLINE OF SOLOURN DRIVE. ELEV=638.04

No. _____ Date: _____ Revision: _____

Kimley-Horn and Associates, Inc.
 7700 Greenville Avenue, Suite 200
 Dallas, Texas 75231
 Tel: 972/772-3333
 Fax: 972/772-3335



METHODIST HOSPITAL FOR SURGERY
FOR SURGERY
ADDISON, TEXAS
FILE NUMBER: 311T-7863

STORM SEWER PROFILES

AS SHOWN
 Design: JHH
 Drawn By: JHH
 Checked By: JHH
 Date: 08/11/10
 Project No. 070000
SHEET
C-11