


WATER LINE "A"

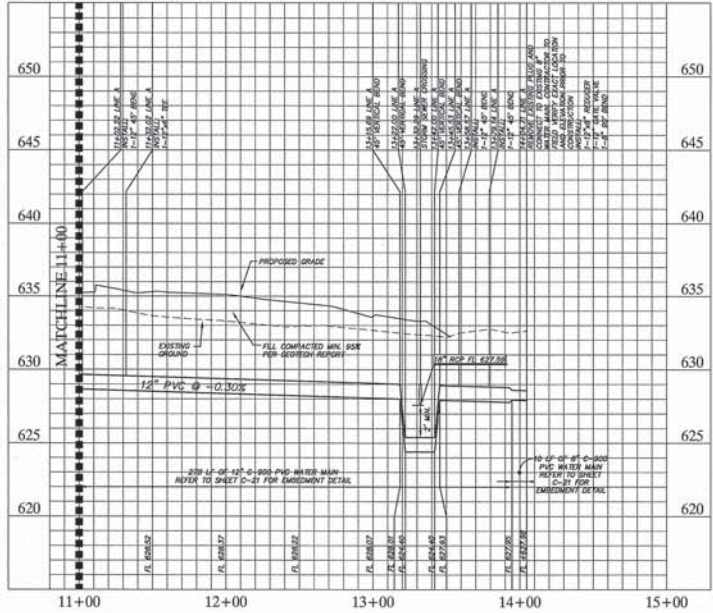

WATER LINE "A"

**RECORD DRAWINGS
(SEPTEMBER 2010)**
INFORMATION PROVIDED BY:
Rogers-O'Brien Construction Company

BENCHMARK

1. "C" FOUND ON TOP OF THE CONCRETE BASE OF A LIGHT POLE IN THE CENTER MESHAN OF EXCEL PARKWAY APPROXIMATELY 50 FEET WEST OF THE CENTERLINE OF ADDISON ROAD. (PER TOWN OF ADDISON PLAN # 9802L SHEET 2, DATED JANUARY 1998) ELEV=64.45
2. BM W/SET SET ON TOP OF A CONCRETE CURB BUILT LOCATED ON THE WEST SIDE OF DALLAS PARKWAY APPROXIMATELY 828 FEET NORTH OF THE CENTERLINE OF SOLOURN DRIVE. ELEV=62.78
3. BM W/SET SET ON TOP OF A CONCRETE CURB BUILT LOCATED ON THE WEST SIDE OF DALLAS PARKWAY APPROXIMATELY 160 FEET NORTH OF THE CENTERLINE OF SOLOURN DRIVE. ELEV=63.64

No.	Date	Description

Kimley-Horn and Associates, Inc.
2700 Guadalupe Street, Suite 200
Austin, Texas 78704
Tel: 512/472-2322
Fax: 512/472-2322



**METHODIST HOSPITAL
FOR SURGERY
ADDISON, TEXAS**
FILE NUMBER: 311T-7863

WATER LINE PROFILES

AS SHOWN
Designed By: EGO
Drawn By: EGO
Checked By: EKE
Date: 11/20/09
Project No.: 0101008

SHEET
C-15

DATE PLOTTED: 11/20/09 10:58 AM
PLOT FILE: C:\PROJECTS\1101008\1101008.dwg
PLOT SCALE: 1"=40'