#### INDEX OF SHEETS

#### NUMBER: DESCRIPTION: COVER SHEET AND LOCATION MAP SHEET INDEX/GENERAL NOTES 2 & 3 STRIP MAPS TYPICAL PAVING SECTIONS 5 - 8 CONSTRUCTION PLANS & PROFILES PAVEMENT REMOVAL PLANS 10 & 11 COORDINATE LAYOUT PLANS 12 SIGN PLAN 13 - 15 PAVING MARKING PLANS 16 & 17 CONTOUR PLANS 18 - 21 CROSS SECTIONS 22 CROSS SECTIONS AT DRIVEWAYS 23 - 31 DETAIL SHEETS 32 DRAINAGE AREA MAPS

33 - 35 STORM SYSTEM CALCULATIONS

DETAIL & NOTES

TS-6 TRAFFIC SIGNAL ELECTRICAL DETAILS

45 STORM WATER POLLUTION PREVENTION PLAN
46 - 51 STORM WATER POLLUTION PREVENTION PLAN

36 - 39 STORM SEWER PLANS 40 - 43 STORM SEWER PROFILES 44 PHASING PLAN

52 - 56 LANDSCAPE PLANS

57 - 62 IRRIGATION PLANS 63 - 69 ELECTRICAL PLANS COUNTY OF DALLAS, TEXAS DEPARTMENT OF PUBLIC WORKS

MCIP ROADWAY IMPROVEMENTS TOWN OF ADDISON, TEXAS

TOA NO. 2002-102

MCIP PROJECT NO. 10305


ADDISON RD - FROM BELT LINE RD TO ARAPAHO RD



NO EQUATION
NO EXCEPTION
NO RAILROAD

LENGTH DF PROJECT 1500 FT.

CONSTRUCTION TYPE PAVING AND DRAINAGE

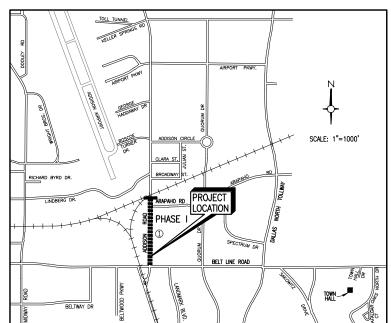




THESE DOCUMENTS ARE FOR BIDDING, CONSTRUCTION, AND PERMIT PURPOSES.

DATE: 10/31/06

### DESIGN SPEED: 40 MPH

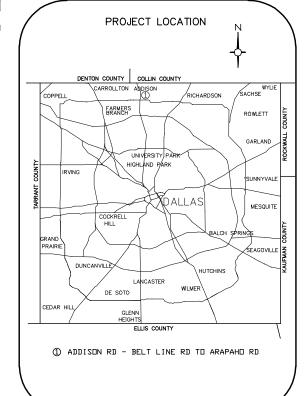

## COUNTY OFFICIALS

COUNTY JUDGE JAMES FOSTER

COMMISSIONER DISTRICT NO. 1

MAURINE DICKEY

COMMISSIONER DISTRICT NO. 2
MIKE CANTRELL

COMMISSIONER DISTRICT NO. 3

JOHN WILEY PRICE

COMMISSIONER DISTRICT NO. 4 KENNETH A. MAYFIELD This record drawing is a compilation of the sealed engineering drawing for this project; modified by addenda, change orders and information furnished by the contractor. The information shown on the record drawings that was provided by the contractor or others not associated with the design engineer cannot be verified for occuracy or completeness. This original sealed drawings are on file at the offices of Birkhoff, Hendricks & Carter, L.L.P.

BY <u>J.W.B.</u> DATE <u>05/04/2010</u>

#