


REVISION: 5/4/10 - ROWE
 H:\Projects\Addison\2002102\PHASE1\SHEET\Sheets-As-Built\2002102C03_Strip.dwg
 PLOT SCALE: 1:1,0152
 PLOT STYLE: 11x17.ctb
 PLOTTED BY: ROWE ON 5/14/2010

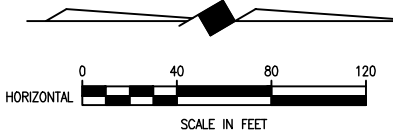

EDWARD COOK SURVEY
ABST. NO. 326
 15211 ADDISON ROAD JOINT VENTURE
 VOL. 96156, PG. 4963
 70,516 SF (1.6188 ACRES)
 BLOCK 1, LOT 2

EDWARD COOK SURVEY
ABST. NO. 326
 GEORGE P. KONDOS, ET. AL.
 VOL. 91084, PG. 2102
 26,687 SF (0.6126 ACRES)

EDWARD COOK SURVEY
ABST. NO. 326
 ADDISON POST OFFICE
 JOINT VENTURE
 VOL. 85161, PG. 1657
 17,304.7 SF (0.397 ACRES)

WHITE ROCK MASONIC
LODGE #234, A.F. & A.M.
 VOL. 3981, PG. 416
 17,500 SF (0.402 ACRES)

TOWN OF ADDISON
 VOL. 5143, PG. 162
 8,929.8 SF (0.205 ACRES)

G.W. FISHER SURVEY
ABST. NO. 482
 H.I. MOSES JR. &
 JAMES R. CLINE
 VOL. 83036, PG. 2893
 16,805.4 S.F. (0.386 ACRES)


G.W. FISHER SURVEY
ABST. NO. 482
 SIDERIS PROPERTIES
 VOL. 98221, PG. 5415
 19,824 S.F. (0.226 ACRES)

G.W. FISHER SURVEY
ABST. NO. 482
 TOWN OF ADDISON
 VOL. 96194, PG. 1586
 8,000 S.F. (0.184 ACRES)

G.W. FISHER SURVEY
ABST. NO. 482
 MINOL CENTER LIMITED PARTNERSHIP
 VOL. 92038 PG. 0247
 75,261 S.F. (1.7277 ACRES)

G.W. FISHER SURVEY
ABST. NO. 482
 DART

BIDJAAR BOUTIQUE HOTELS, LTD.
 VOL. 2002224 PG. 02354

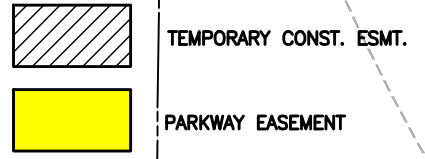

This record drawing is a compilation of the sealed engineering drawing for this project; modified by addenda, change orders and information furnished by the contractor. The information shown on the record drawings that was provided by the contractor or others not associated with the design engineer cannot be verified for accuracy or completeness. This original sealed drawings are on file at the offices of Birkhoff, Hendricks & Carter, L.L.P.
 BY J.W.B. DATE 05/04/2010

THESE DOCUMENTS ARE FOR BIDDING, CONSTRUCTION, AND PERMIT PURPOSES.
 DATE: 10/31/06



TOWN OF ADDISON, TEXAS
ADDISON ROAD IMPROVEMENTS
BELT LINE ROAD TO ARAPAHO ROAD PHASE I
ADDISON ROAD STRIP MAP
BIRKHOFF, HENDRICKS & CONWAY L.L.P.
 CONSULTING ENGINEERS
 Dallas, Texas

DESIGNED BY: <u>J.W.B.</u>	PROJECT: <u>2002102</u>	SHEET NO. <u>3</u>
DRAWN BY: <u>R.J.L.</u>	DATE: <u>MAY 2005</u>	OF 68 SHEETS

These plans and related specifications were prepared for construction of this specific project only. Reuse of these documents is not permitted without written authorization of Birkhoff, Hendricks, & Conway, L.L.P.