

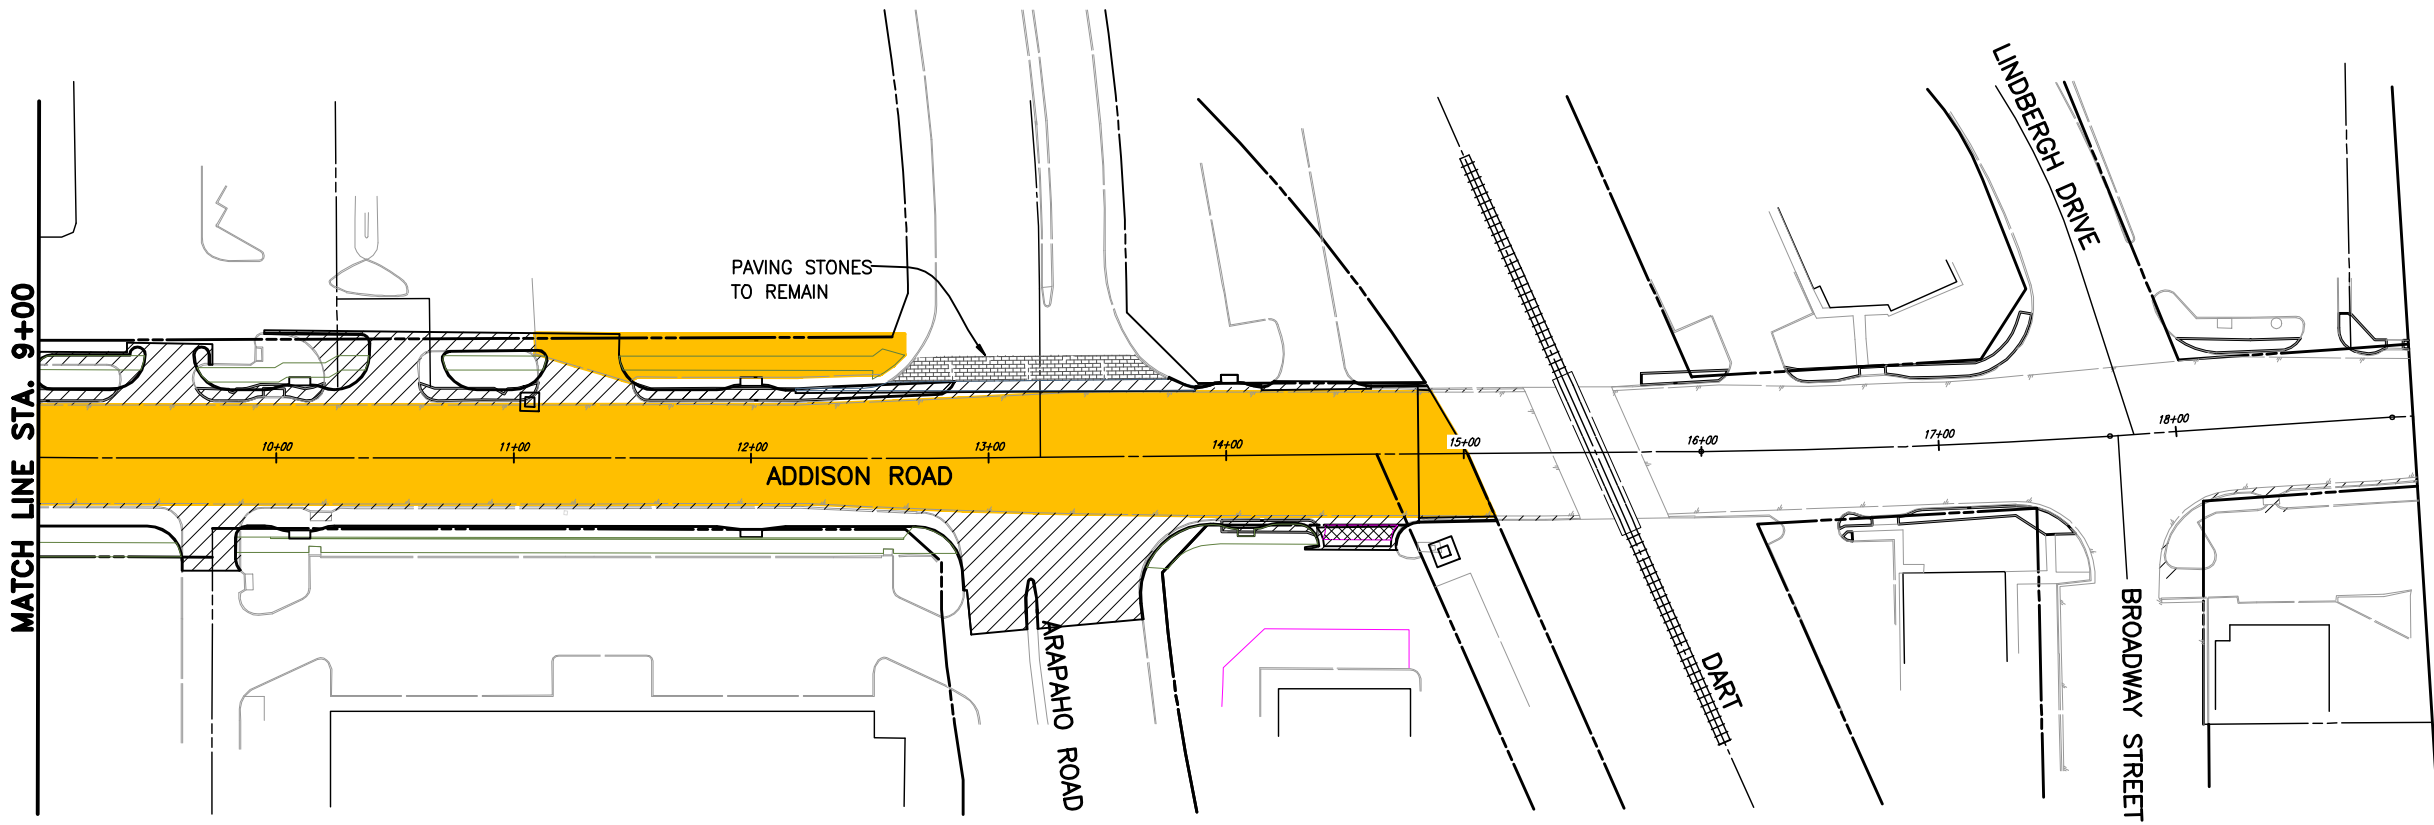
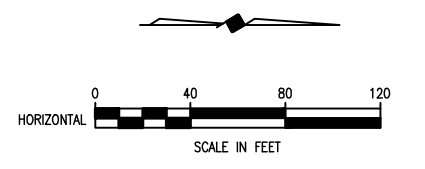


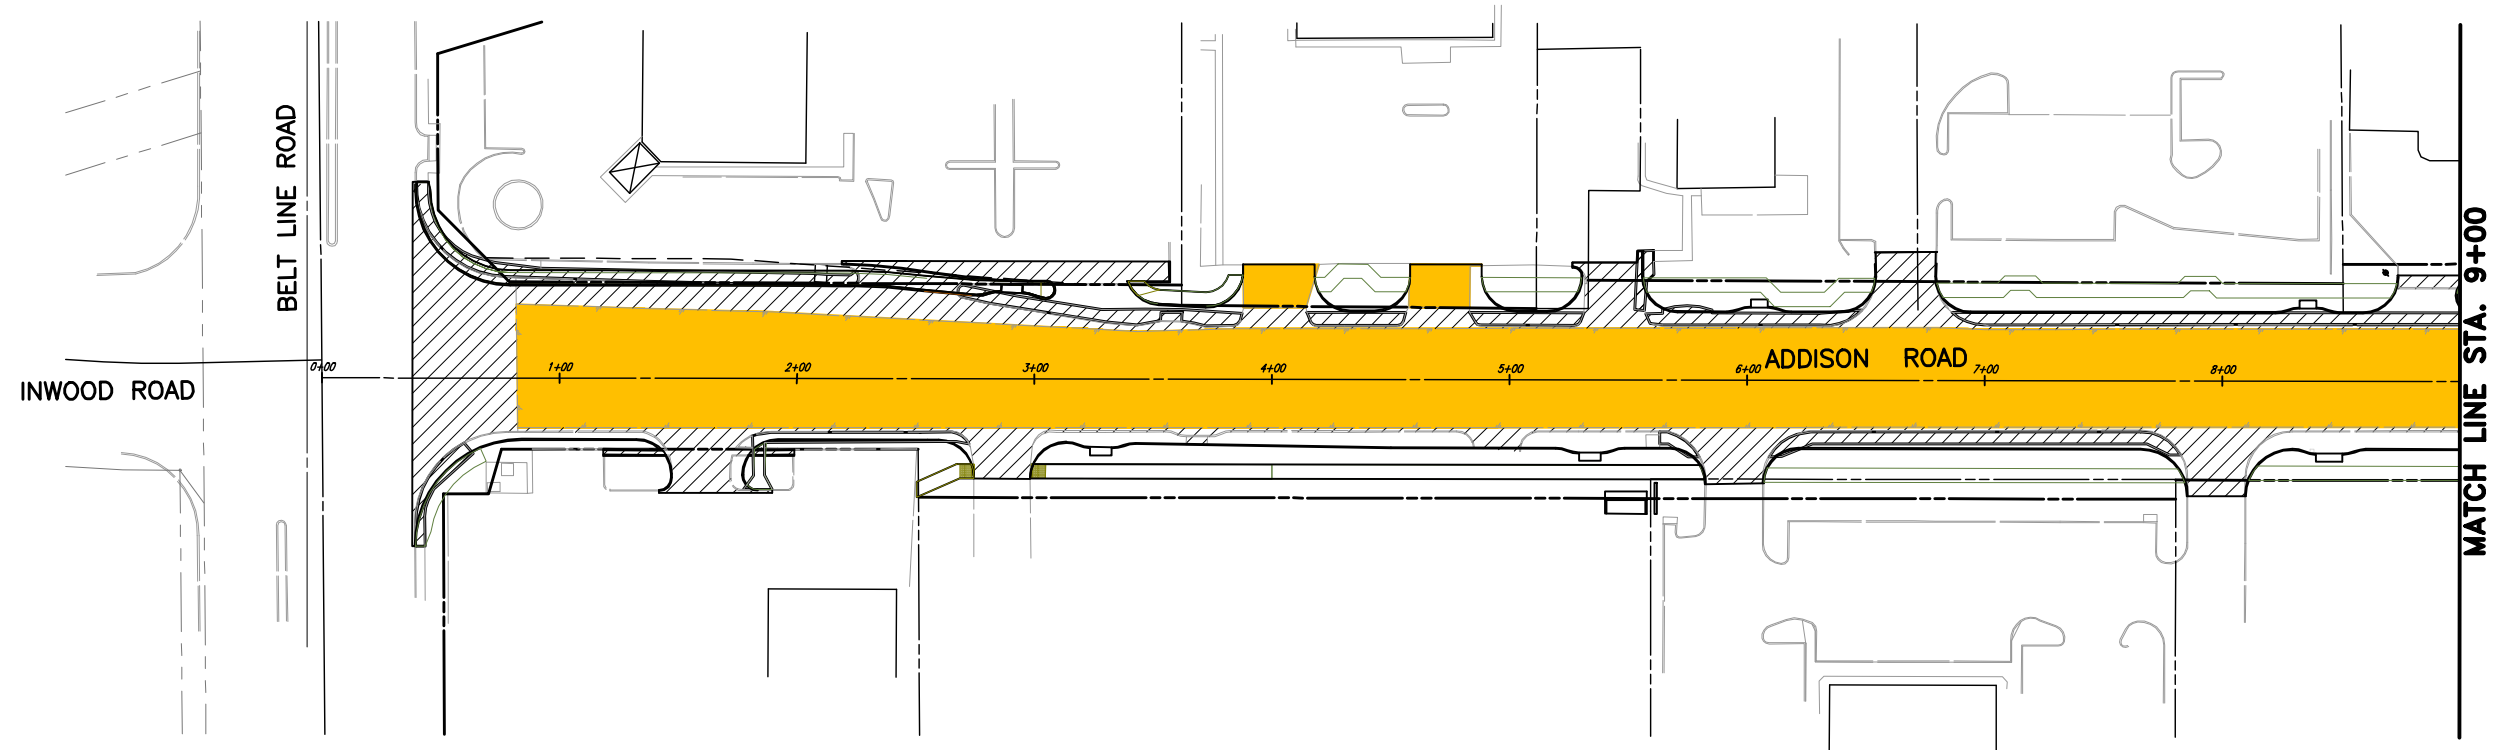

H:\PROJECTS\ADDISON\2002102\PHASE1\2002102\PHASE1\2002102\REMOVAL.DWG 04/27/05 R.L. SCALE: 1=40 XREF: REMOVE-BASE

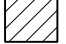

- LEGEND**
-  CONCRETE REMOVAL W/BASE
 -  PAVING STONE REMOVAL W/BASE
 -  ASPHALT REMOVAL W/BASE

These plans and related specifications were prepared for construction of this specific project only. Reuse of these documents is not permitted without written authorization of Birkhoff, Hendricks, & Conway, L.L.P.

TOWN OF ADDISON, TEXAS
ADDISON ROAD IMPROVEMENTS
BELT LINE ROAD TO ARAPAHO ROAD PHASE I
PAVEMENT REMOVAL

BIRKHOFF, HENDRICKS & CONWAY L. L. P.
CONSULTING ENGINEERS
Dallas, Texas



This record drawing is a compilation of the sealed engineering drawing for this project, modified by addenda, change orders and information furnished by the contractor. The information shown on the record drawings that was provided by the contractor or others not associated with the design engineer cannot be verified for accuracy or completeness. This original sealed drawings are on file at the offices of Birkhoff, Hendricks & Carter, L.L.P.
BY J.W.B. DATE 05/04/2010

THESE DOCUMENTS ARE FOR BIDDING, CONSTRUCTION, AND PERMIT PURPOSES.
John W. Birkhoff
DATE: 10/31/06

DESIGNED BY: J.W.B.	PROJECT: 2002-102	SHEET NO. 9
DRAWN BY: R.J.L.	DATE: SEPTEMBER 2006	OF 68 SHEETS