

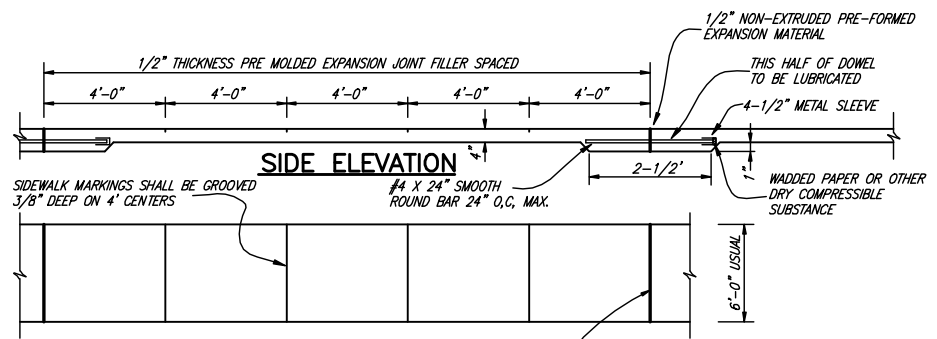


PLOTTED BY: FLOWE ON 5/14/2010  
 PLOT STYLE: 11x17.ctb  
 PLOT SCALE: 1:1.0101  
 H:\Projects\Addison\2002102\PHASE1\Sheet-Sheets-As-Built\2002102C23\_Detail.dwg  
 REVISION: 5/6/10 - FLOWE

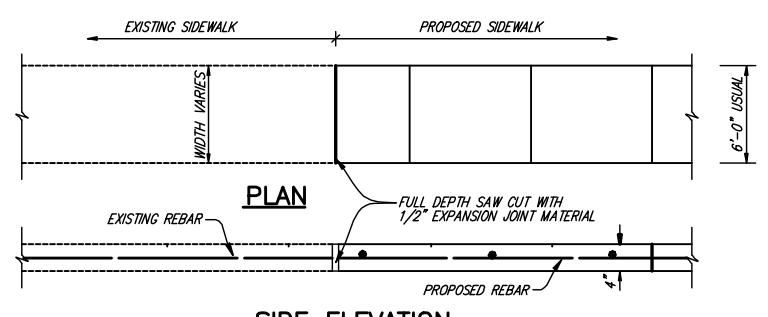


**CONCRETE SIDEWALK**

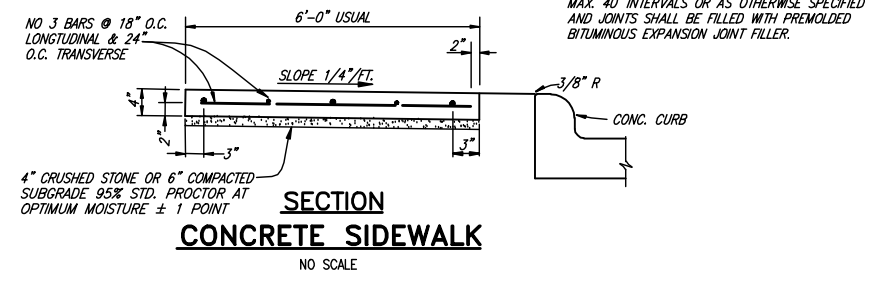


**SIDEWALK BUTT JOINT DETAIL**


NOTE: ALL CONCRETE SHALL BE 4000 P.S.I. SEE TYPICAL SECTION SHEET FOR REQUIREMENTS

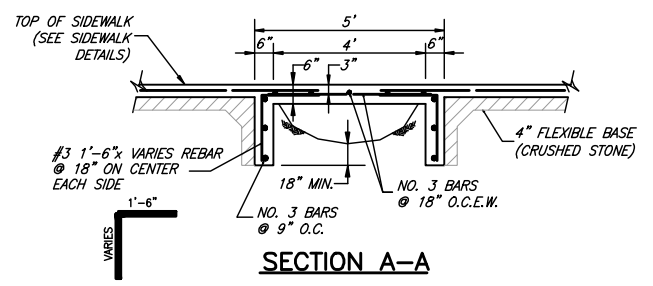


**SECTION A-A**

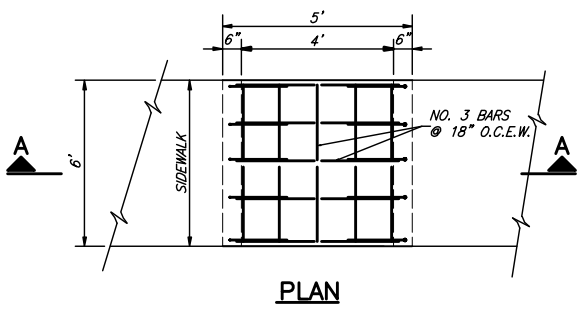


**REINFORCED CONCRETE SIDEWALK BRIDGE**

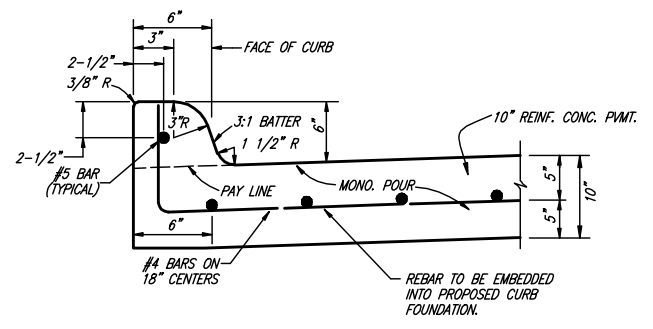


**INTEGRAL CURB**

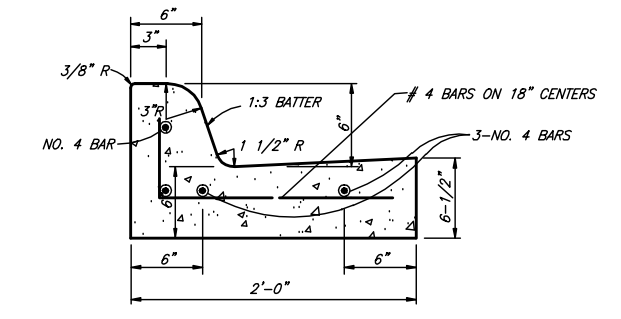


**SEPARATE 24" CURB AND GUTTER**

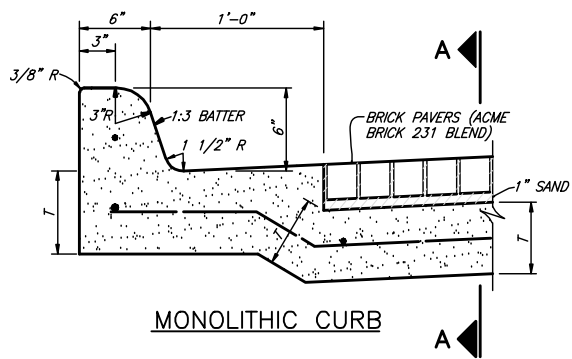

**MONOLITHIC CURB**

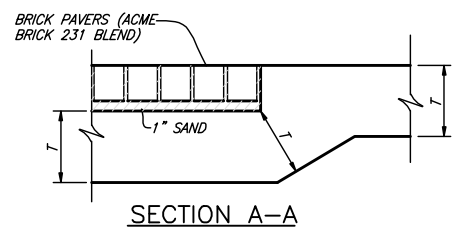


**BRICK PAVER DETAIL**

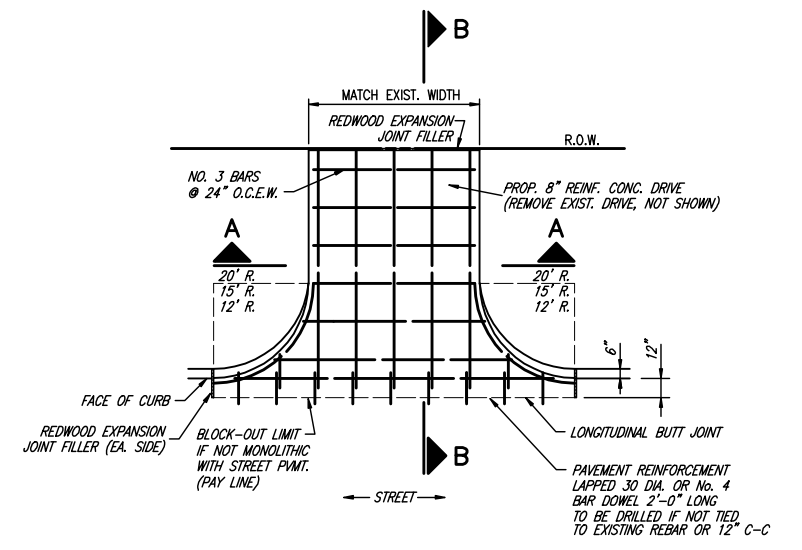


**DRIVEWAY RETURN TO STREET**


NOTE: FINISHED GRADING WITHIN THE R.O.W. SHALL BE BROADCAST SEEDING. WHERE PROPOSED DRIVEWAY CONSTRUCTION GOES BEYOND THE R.O.W. AND INTO PRIVATE PROPERTY, THE FINISHED GRADING SHALL BE BLOCK SODED TO RESTORE THE LANDSCAPING TO ITS PRE-CONSTRUCTION APPEARANCE.

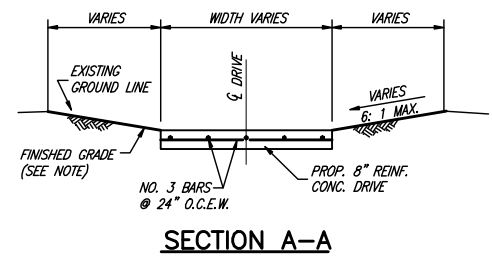

**SECTION A-A**

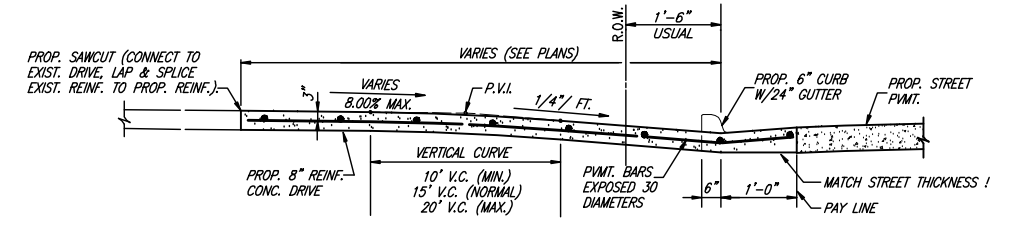

**SECTION B-B (TYPE 1 ENTRANCE)**

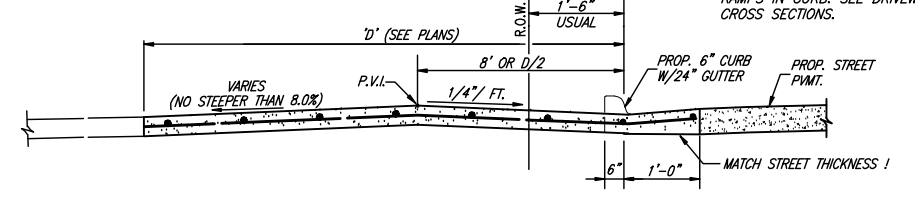


**SECTION B-B (TYPE 2 ENTRANCE)**

**DRIVEWAY RETURN SECTIONS**

This record drawing is a compilation of the sealed engineering drawing for this project; modified by addenda, change orders and information furnished by the contractor. The information shown on the record drawings that was provided by the contractor or others not associated with the design engineer cannot be verified for accuracy or completeness. This original sealed drawings are on file at the offices of Birkhoff, Hendricks & Carter, L.L.P.  
 BY: J.W.B. DATE: 05/04/2010

These plans and related specifications were prepared for construction of this specific project only. Reuse of these documents is not permitted without written authorization of Birkhoff, Hendricks, & Conway, L.L.P.

THESE DOCUMENTS ARE FOR BIDDING, CONSTRUCTION, AND PERMIT PURPOSES.  
 John W. Birkhoff  
 DATE: 10/31/06

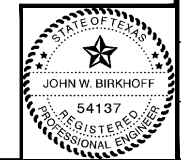

**TOWN OF ADDISON, TEXAS**

**ADDISON ROAD IMPROVEMENTS  
 BELT LINE ROAD TO ARAPAHO ROAD PHASE I  
 DETAILS**

**BIRKHOFF, HENDRICKS & CONWAY L. L. P.**  
 CONSULTING ENGINEERS  
 Dallas, Texas

DESIGNED BY: J.W.B.	PROJECT: 2002 102	SHEET NO. 23
DRAWN BY: M.W.C.	DATE: SEPTEMBER 2006	OF 68 SHEETS