


PLOTTED BY: RLOWE ON 5/14/2010
 PLOT STYLE: 11x17.ctb
 PLOT SCALE: 1:1.0101
 H:\Projects\Addison\2002102\PHASE1\Sheet\Sheets-As-Built\2002102C28_Detail.dwg
 REVISION: 5/13/10 - RLOWE

TABLE OF VARIABLE DIMENSIONS AND QUANTITIES FOR ONE HEADWALL						
SLOPE	DIA OF PIPE/D	Values for one Pipe			Values to be added for each add'l Pipe	
		W	Reinf (Lbs)	Conc (CY)	W	Reinf (Lbs)
2:1	12"	9'-0"	122	1.1	1'-9"	15 0.2
	15"	10'-3"	136	1.3	2'-2"	16 0.2
	18"	11'-6"	163	1.5	2'-8"	19 0.3
	21"	12'-9"	200	1.8	3'-1"	31 0.4
	24"	14'-0"	217	2.1	3'-7"	34 0.4
	27"	15'-3"	254	2.4	3'-11"	37 0.5
	30"	16'-6"	272	2.7	4'-4"	40 0.6
	33"	17'-9"	314	3.1	4'-8"	43 0.6
	36"	19'-0"	371	3.9	5'-1"	46 0.8
	42"	21'-6"	442	4.9	5'-10"	52 1.0
	48"	25'-0"	569	6.4	6'-7"	59 1.3
	54"	27'-6"	701	7.5	7'-6"	82 1.6
	60"	30'-0"	794	8.8	8'-3"	90 1.8
	66"	32'-6"	894	10.2	8'-9"	96 2.0
	72"	35'-0"	1055	11.7	9'-4"	103 2.3
3:1	12"	13'-0"	175	1.6	1'-9"	14 0.2
	15"	14'-9"	193	1.9	2'-2"	17 0.2
	18"	16'-6"	228	2.2	2'-8"	19 0.3
	21"	18'-3"	299	2.6	3'-1"	31 0.4
	24"	20'-0"	323	3.0	3'-7"	33 0.4
	27"	21'-9"	371	3.5	3'-11"	37 0.5
	30"	23'-6"	415	4.0	4'-4"	40 0.5
	33"	25'-3"	469	4.6	4'-8"	43 0.6
	36"	27'-0"	556	5.7	5'-1"	46 0.8
	42"	30'-6"	675	7.1	5'-10"	52 1.0
	48"	35'-6"	837	9.2	6'-7"	59 1.3
	54"	39'-0"	1015	11.0	7'-6"	84 1.6
	60"	42'-6"	1171	12.9	8'-3"	91 1.8
	66"	46'-0"	1298	14.9	8'-9"	98 2.0
	72"	49'-6"	1561	17.1	9'-4"	103 2.3
4:1	12"	17'-0"	229	2.0	1'-9"	15 0.2
	15"	19'-3"	266	2.4	2'-2"	17 0.2
	18"	21'-6"	308	2.9	2'-8"	19 0.3
	21"	23'-9"	382	3.5	3'-1"	31 0.3
	24"	26'-0"	430	3.9	3'-7"	34 0.4
	27"	28'-3"	486	4.7	3'-11"	37 0.5
	30"	30'-6"	539	5.2	4'-4"	40 0.6
	33"	32'-9"	603	6.0	4'-8"	42 0.6
	36"	35'-0"	738	7.5	5'-1"	47 0.8
	42"	39'-6"	881	9.3	5'-10"	52 1.0
	48"	46'-0"	1102	12.1	6'-7"	61 1.3
	54"	50'-6"	1364	14.4	7'-6"	84 1.6
	60"	55'-0"	1547	16.9	8'-3"	91 1.8
	66"	59'-6"	1741	19.5	8'-9"	98 2.0
	72"	64'-0"	2069	22.4	9'-4"	102 2.3
6:1	12"	25'-0"	336	3.0	1'-9"	14 0.2
	15"	28'-3"	384	3.6	2'-2"	17 0.2
	18"	31'-6"	452	4.2	2'-8"	19 0.3
	21"	34'-9"	581	5.1	3'-1"	31 0.4
	24"	38'-0"	644	5.8	3'-7"	34 0.4
	27"	41'-3"	737	6.9	3'-11"	37 0.5
	30"	44'-6"	807	7.7	4'-4"	39 0.6
	33"	47'-9"	912	8.9	4'-8"	44 0.6
	36"	51'-0"	1108	11.0	5'-1"	48 0.8
	42"	57'-6"	1318	13.7	5'-10"	54 1.0
	48"	67'-0"	1674	17.9	6'-7"	59 1.3
	54"	73'-6"	2064	21.3	7'-6"	83 1.6
	60"	80'-0"	2343	24.9	8'-3"	89 1.8
	66"	86'-6"	2635	28.9	8'-9"	96 2.0
	72"	93'-0"	3123	33.1	9'-4"	101 2.3

① Quantities increase slightly for metal pipe installations.


This record drawing is a compilation of the sealed engineering drawing for this project; modified by addenda, change orders and information furnished by the contractor. The information shown on the record drawings that was provided by the contractor or others not associated with the design engineer cannot be verified for accuracy or completeness. This original sealed drawings are on file at the offices of Birkhoff, Hendricks & Carter, L.L.P.

BY J.W.B. DATE 05/04/2010

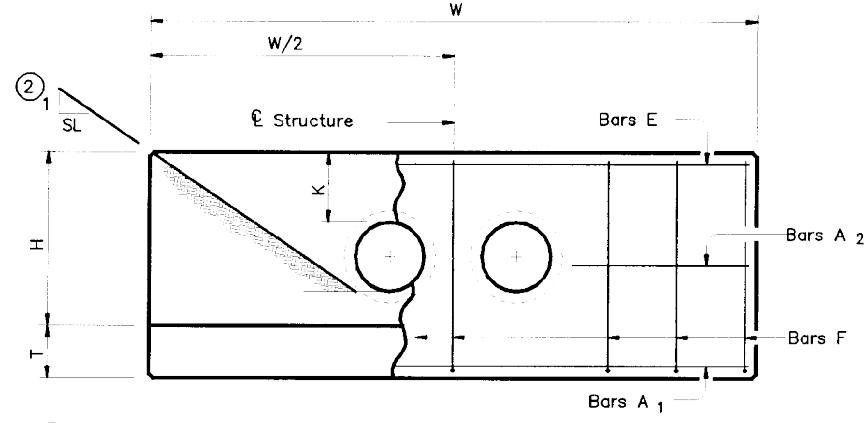


② Indicated slope is perpendicular to Q Pipe or Pipes

ELEVATION

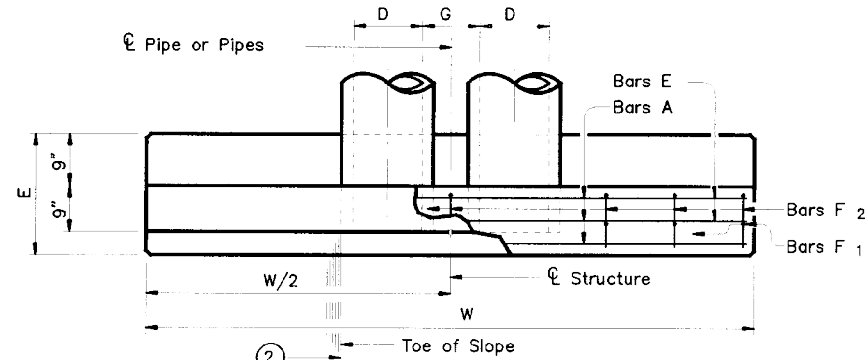

PLAN OF NON-SKEWED PIPES

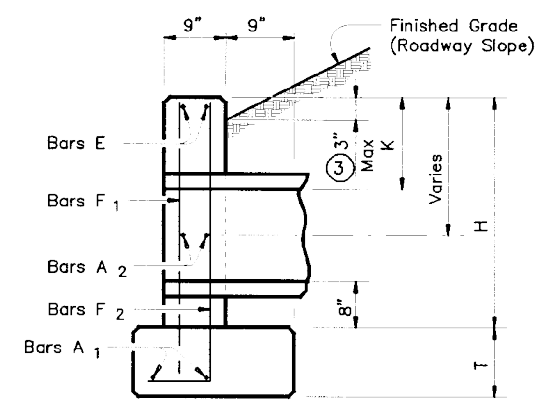

SECTION


③ For vehicle safety, curb heights and wall heights shall be reduced, if necessary, to provide a maximum 3" projection above finished grade. No changes will be made in quantities and no additional compensation will be allowed for this work.

THESE DOCUMENTS ARE FOR BIDDING, CONSTRUCTION, AND PERMIT PURPOSES.
 JOHN W. BIRKHOFF
 DATE: 10/31/06

TABLE OF CONSTANT DIMENSIONS					
DIA OF PIPE/D	G	K	H	T	E
12"	9"	1'-0"	2'-8"	9"	1'-9"
15"	11"	1'-0"	2'-11"	9"	1'-9"
18"	1'-2"	1'-0"	3'-2"	9"	1'-9"
21"	1'-4"	1'-0"	3'-5"	9"	2'-0"
24"	1'-7"	1'-0"	3'-8"	9"	2'-0"
27"	1'-8"	1'-0"	3'-11"	9"	2'-3"
30"	1'-10"	1'-0"	4'-2"	9"	2'-3"
33"	1'-11"	1'-0"	4'-5"	9"	2'-6"
36"	2'-1"	1'-0"	4'-8"	1'-0"	2'-6"
42"	2'-4"	1'-0"	5'-2"	1'-0"	2'-9"
48"	2'-7"	1'-3"	5'-11"	1'-0"	3'-0"
54"	3'-0"	1'-3"	6'-5"	1'-0"	3'-3"
60"	3'-3"	1'-3"	6'-11"	1'-0"	3'-6"
66"	3'-3"	1'-3"	7'-5"	1'-0"	3'-9"
72"	3'-4"	1'-3"	7'-11"	1'-0"	4'-0"

④ TABLE OF REINFORCING STEEL			
Bar	Size	Spa	No.
A1	# 5	~	2
A2	# 5	1'-6"	~
E	# 5	~	2
F	# 5	1'-0"	~

④ Quantities shown are for one structure end. (One headwall)

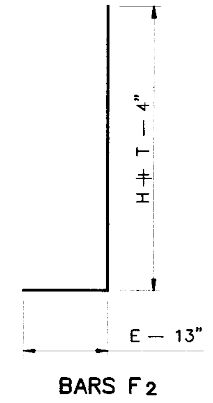


GENERAL NOTES:
 Designed according to current AASHTO Standard and Interim Specifications.
 Reinforcing steel shall be placed with the center of the outside layer of bars 2" from the surface of the concrete.
 All reinforcing steel shall be Grade 60.
 All concrete shall be Class "C" and shall have a minimum 28 day compressive strength of 3600 psi.

TOWN OF ADDISON, TEXAS

**ADDISON ROAD IMPROVEMENTS
 BELT LINE ROAD TO ARAPAHO ROAD PHASE I
 CH-PW-0 CONCRETE HEADWALL DETAIL**

BIRKHOFF, HENDRICKS & CONWAY L. L. P.
 CONSULTING ENGINEERS
 Dallas, Texas

DESIGNED BY: <u>J.W.B.</u>	PROJECT: <u>2002 102</u>	SHEET NO. <u>28</u>
DRAWN BY: <u>R.J.L.</u>	DATE: <u>SEPTEMBER 2006</u>	OF 68 SHEETS

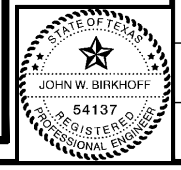

These plans and related specifications were prepared for construction of this specific project only. Reuse of these documents is not permitted without written authorization of Birkhoff, Hendricks, & Conway, L.L.P.