
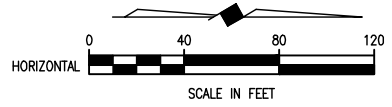
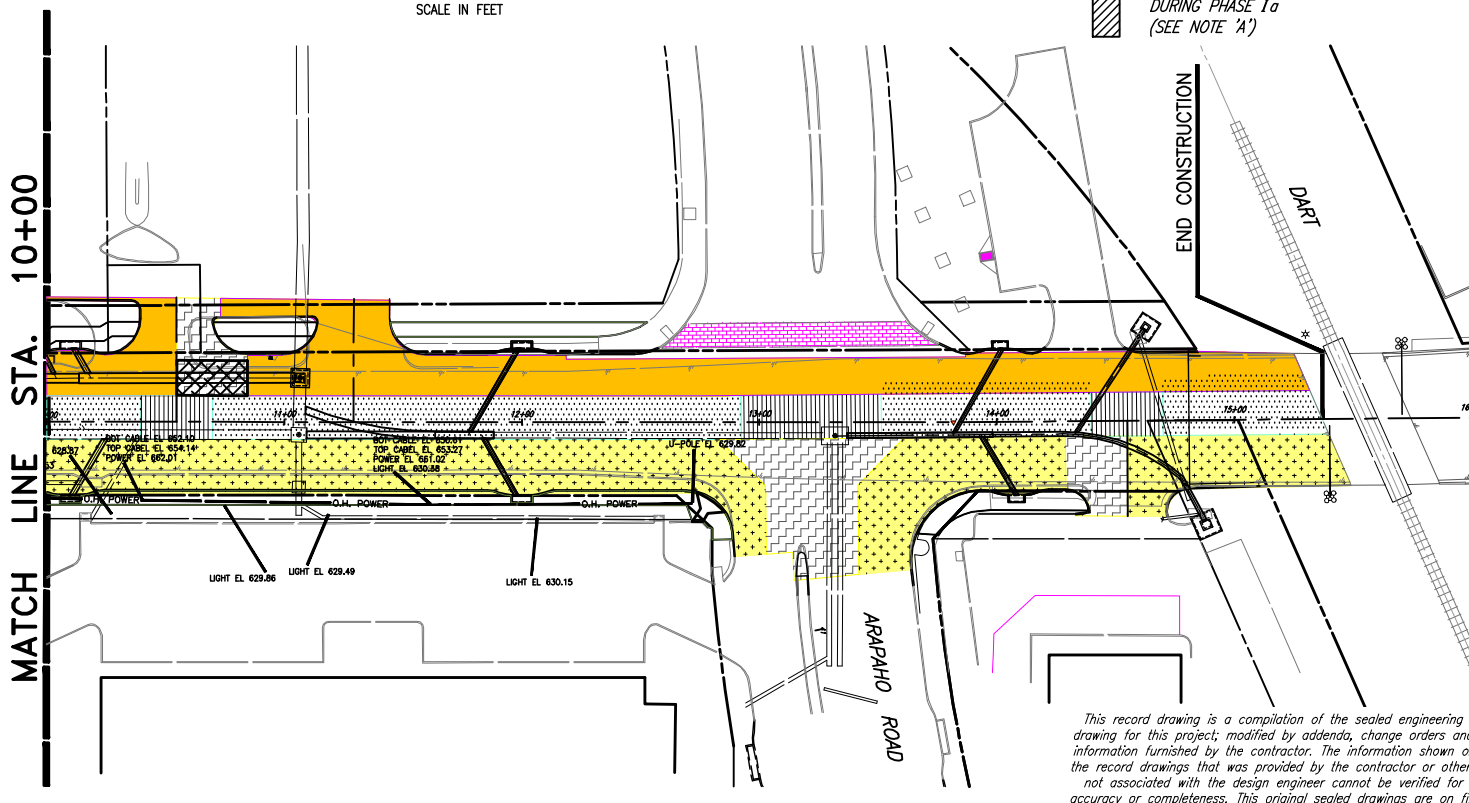


REVISIONS: 5/14/10 - ROWE  
 H:\Projects\Addison\2002102\PHASE1\Sheet-A-Built\2002102\44\_Phasings.dwg  
 PLOT SCALE: 1:1.0101  
 PLOT STYLE: 11x17.ctb  
 PLOTTED BY: ROWE ON 5/14/2010

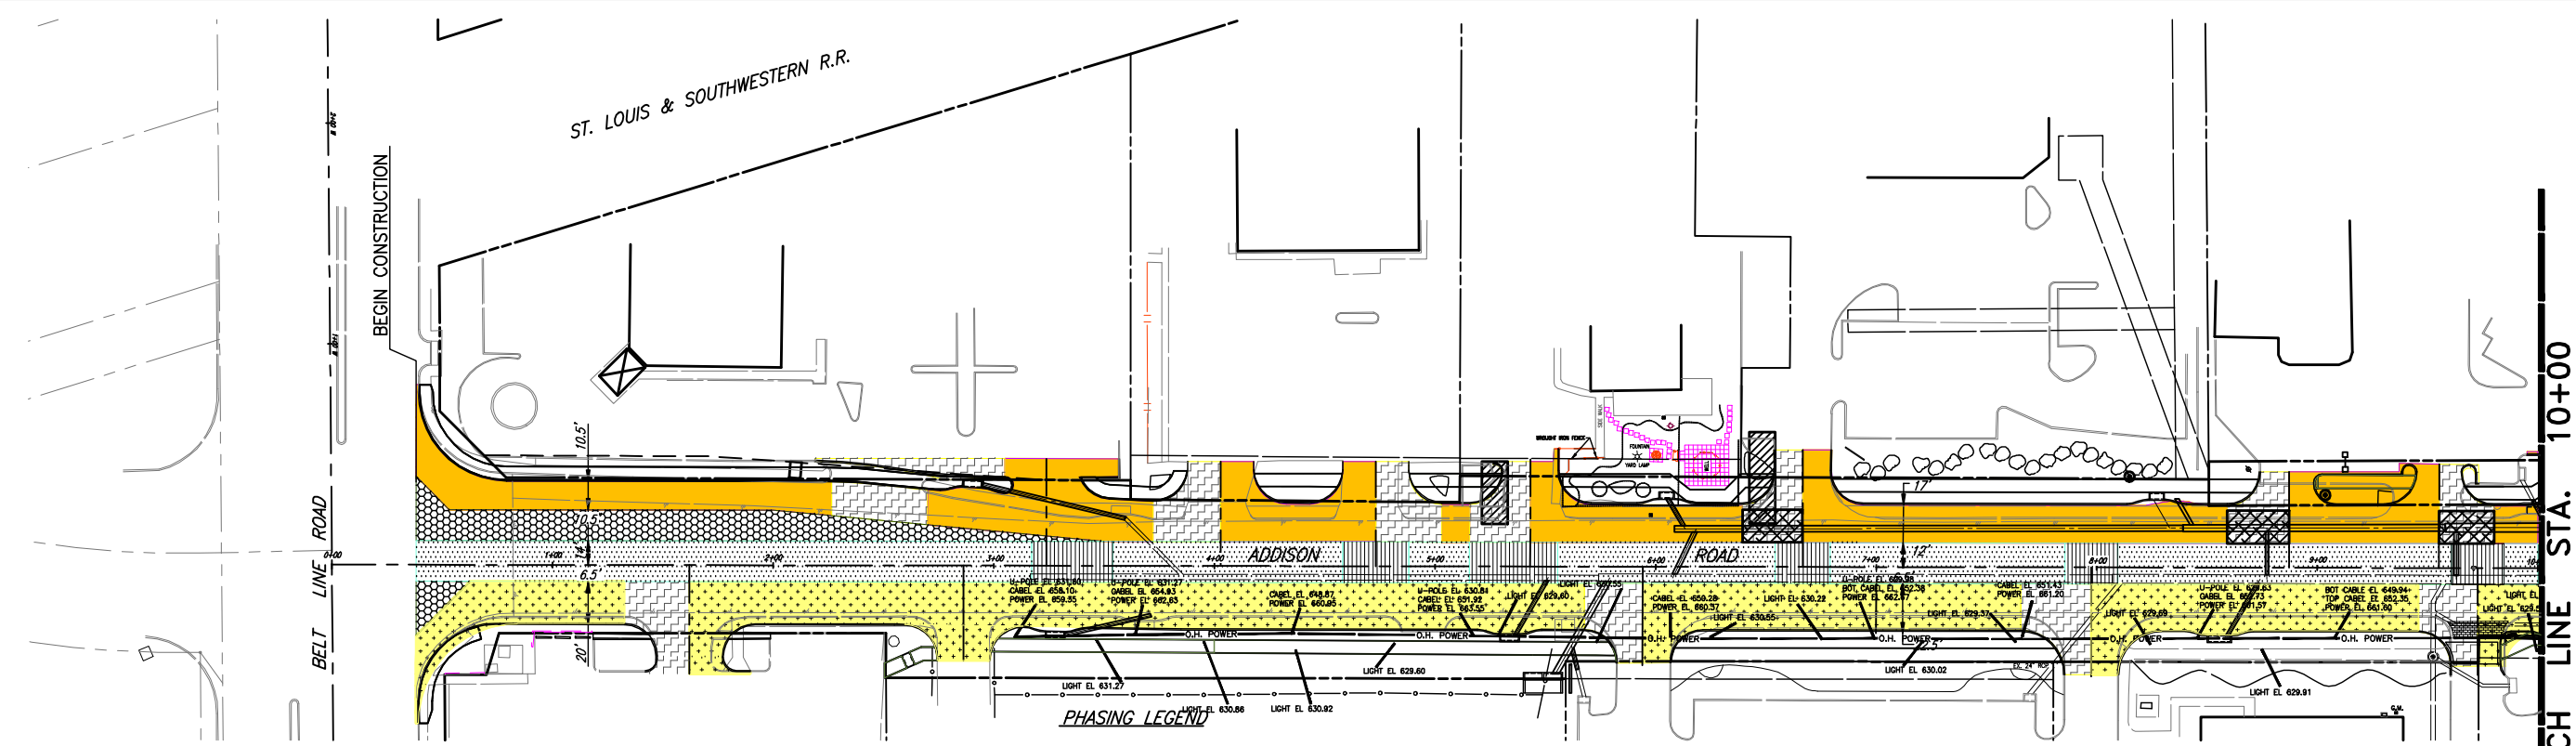

NOTE 'A':  
 TEMPORARY H.M.A.C.  
 SHALL BE SUBSIDIARY TO  
 CONCRETE PAVEMENT -  
 NO SEPARATE PAY ITEM

- PHASING LEGEND**
- PHASE I a
  - PHASE I b
  - PHASE I c
  - PHASE II
  - PHASE III a
  - PHASE III b
  - TEMPORARY H.M.A.C. DURING PHASE I a (SEE NOTE 'A')
- TEMPORARY H.M.A.C. TO BE INSTALLED AFTER STORM SEWER INSTALL UNTIL PH I b PAVING IS COMPLETED.

**GENERAL SEQUENCE OF CONSTRUCTION**

**CONSTRUCTION DESCRIPTION**  
 ADDISON ROAD IMPROVEMENTS PROJECT INCLUDES THE CONSTRUCTION OF A REINFORCED CONCRETE 5-LANE, INCLUDING A CENTER TURN LANE, ROADWAY WITH MONOLITHIC CURBS, ALSO INCLUDING STORM SEWERS, STORM SEWER LATERALS, INLETS, SANITARY SEWER LATERALS, SANITARY SEWER MANHOLES, DRIVEWAYS, SIDEWALKS WITH BARRIER FREE RAMPS, LANDSCAPE IMPROVEMENTS, ASPHALT PAVEMENT WITH CONCRETE CURB AND GUTTER, TRAFFIC MARKINGS, WATER SERVICE RELOCATIONS.

OTHER ITEMS INCLUDES REMOVAL OF EXISTING REINFORCED CONCRETE AND ASPHALT PAVEMENT, TEMPORARY TRAFFIC HANDLING DEVICES ALONG WITH OTHER MISCELLANEOUS ITEMS TO PROVIDE A COMPLETE OPERABLE ROADWAY.

**PHASE I**  
 CONTRACTOR SHALL MOBILIZE AND PERFORM NECESSARY CONTROL STAKING, THEN PREPARE THE RIGHT-OF-WAY AND IMPLEMENT THE SW3P AND INSTALL EROSION CONTROL DEVICES ALONG WITH CONSTRUCTION SIGNING AND MARKINGS.

EXCAVATE AND CONSTRUCT STORM SEWER LINES 'A', INLETS BOXES, JUNCTION BOX AND LATERAL STUBOUTS AND LATERALS WHERE PRACTICAL FROM THE DOWNSTREAM END.

EXCAVATE AND CONSTRUCT SANITARY SEWER MANHOLES AND SANITARY SEWER SERVICE LATERALS AND CONNECT TO EXISTING SANITARY SEWER LATERALS. REMOVE ALL WATER METER BOXES AND WATER METERS THAT WILL BE IN PROPOSED CONCRETE PAVEMENT AND RELOCATE AS DIRECTED IN THE GENERAL NOTES.

PREPARE SUBGRADE ON FINISHED GRADE AND CONSTRUCT PORTION OF NORTHBOUND AND SOUTHBOUND LANES AT DESIGN GRADE AS SHOWN IN THE PLANS ALONG WITH PORTION OF DRIVEWAYS ALONG THE EAST AND WEST SIDE OF ROADWAY INCLUDING PLACEMENT OF TEMPORARY H.M.A.C. AT LOCATION FOR ACCESS TO AND FROM BUSINESSES. COMPLETE INLET TOPS.

FURNISH AND INSTALL ALL NECESSARY TEMPORARY TRAFFIC CONTROL DEVICES FOR THE COMPLETION OF PHASE I.

**PHASE II**  
 CONSTRUCT REMAINING STORM SEWER LINE 'A' LATERALS AND CONNECT TO LATERALS IN PHASE I. COMPLETE CONSTRUCTION OF STORM SEWER AND LATERALS, C1 & CE.

PREPARE SUBGRADE ON FINISHED GRADE AND CONSTRUCT PORTION OF NORTHBOUND, SOUTHBOUND LANES AND CENTER TURN LANE AT DESIGN GRADE AS SHOWN IN THE PLANS INCLUDING PLACEMENT OF TEMPORARY H.M.A.C. AT LOCATION FOR ACCESS TO AND FROM BUSINESS.



FURNISH AND INSTALL ALL NECESSARY TEMPORARY TRAFFIC CONTROL DEVICES FOR THE COMPLETION OF PHASE II.

**PHASE III**  
 COMPLETE STORM SEWER LINE 'A' LATERALS IN PHASE I & PHASE II. COMPLETE STORM SEWER AND LATERALS, C1 & CE IN PHASE I & PHASE II.


PREPARE SUBGRADE ON FINISHED GRADE AND CONSTRUCT PORTION OF NORTHBOUND, SOUTHBOUND LANES AND CENTER TURN LANE AT DESIGN GRADE AS SHOWN IN THE PLANS.

COMPLETE THE INSTALLATION OF ALL PERMANENT SIGNING AND PAVEMENT MARKINGS, STREET LIGHTS AND PEDESTRIAN LIGHTS

COMPLETE FINAL GRADING, TOP SOIL, LANDSCAPE AND IRRIGATION.

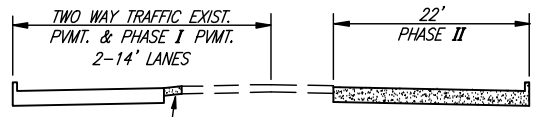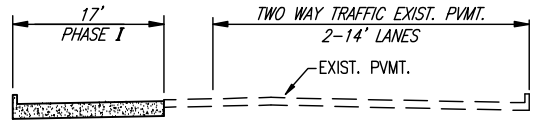

H.M.A.C. TRANSITION BETWEEN EXIST. & PHASE I PAVMT.

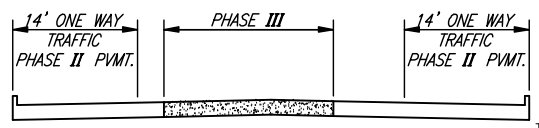

PHASING SECTIONS (LOOKING NORTH)  
 N.T.S.

These plans and related specifications were prepared for construction of this specific project only. Reuse of these documents is not permitted without written authorization of Birkhoff, Hendricks, & Conway, L.L.P.

This record drawing is a compilation of the sealed engineering drawing for this project, modified by addenda, change orders and information furnished by the contractor. The information shown on the record drawings that was provided by the contractor or others not associated with the design engineer cannot be verified for accuracy or completeness. This original sealed drawings are on file at the offices of Birkhoff, Hendricks & Carter, L.L.P.

BY J.W.B. DATE 05/04/2010

THESE DOCUMENTS ARE FOR BIDDING, CONSTRUCTION, AND PERMIT PURPOSES.  
  
 DATE: 10/31/06



**TOWN OF ADDISON, TEXAS**  
**ADDISON ROAD IMPROVEMENTS**  
**BELT LINE ROAD TO ARAPAHO ROAD PHASE I**  
**PHASING PLAN**

**BIRKHOFF, HENDRICKS & CONWAY L.L.P.**  
 CONSULTING ENGINEERS  
 Dallas, Texas

DESIGNED BY: J.W.B. PROJECT: 2002 102 SHEET NO. 44  
 DRAWN BY: R.J.L. DATE: SEPTEMBER 2006 OF 68 SHEETS