



PLOTTED BY: RLOWE ON: 5/14/2010
 PLOT STYLE: 11x17.ctb
 PLOT SCALE: 1:1.0101
 H:\Projects\Addison\2002102\PHASE1\Sheet\Sheet-As-Built\2002102051_SWQP.dwg
 REVISION: 5/12/10 - RLOWE

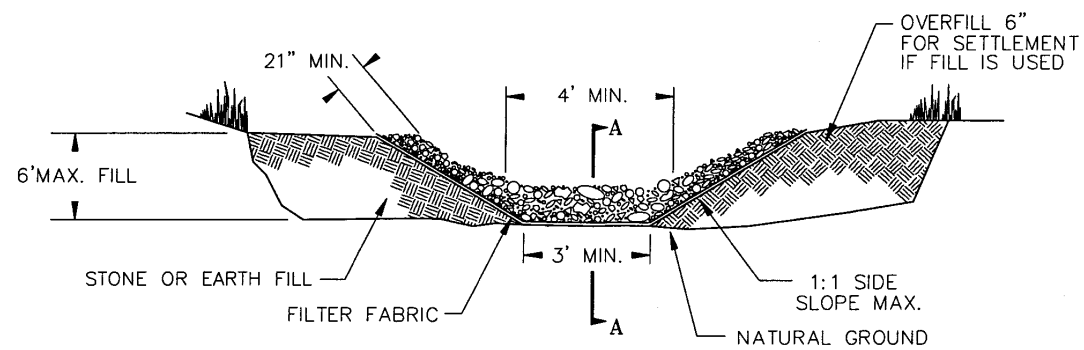

VIEW LOOKING UPSTREAM

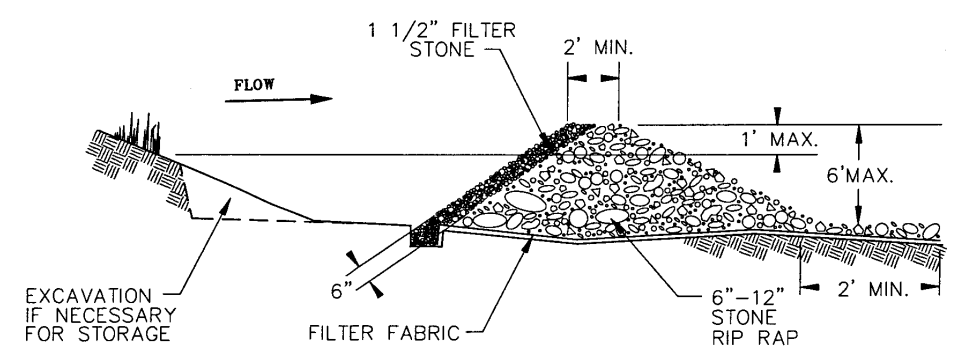

SECTION

STONE OUTLET SEDIMENT TRAP
N.T.S.

5.13 STONE OUTLET SEDIMENT TRAP

1. **DESCRIPTION** - A ponding area formed by placing an earth and/or stone embankment across a drainageway or swale. The ponding area may be natural or improved to provide the required storage volume.
2. **PURPOSE** - To detain sediment laden runoff long enough to allow the majority of the sediment to settle from the water and to allow diffused runoff from the outlet.
3. **APPLICATIONS** - Normally used where the natural topography allows for the construction of the embankment to form the ponding area. Diversions, drainage improvements, and localized grading will allow placement in almost any location that has adequate space for the storage area and will accept the runoff from the disturbed site. The stone outlet sediment trap can be used instead of the standard sediment basin.
4. **LIMITATIONS** - Do not place device in a live stream. Avoid placing in areas planned for future improvements such as pavement or buildings. Inlet channels or pipe should be located as far away from the stone outlet as is practicable to allow for maximum sediment settling time in the basin.
5. **DESIGN CRITERIA** -
 - A. Drainage Area - 30 acres, maximum.
 - B. Storage Volume - 1800 cubic feet per acre of disturbed land draining to the device.
 - C. Surface Area of Storage Area - 1% (0.01) of the area draining to the device.
 - D. Embankment Height - 6 feet (maximum) to top.
 - E. Embankment Slopes - 1.5H:1V or flatter.
 - F. Embankment Top Width - 2 feet (minimum)
 - G. Stone Outlet Width - 4 feet (minimum)
 - H. Outlet Capacity - 10-year design storm, C = 0.50, Max. Tc = 15 minutes.
 - I. Freeboard @ Design Flow - 6 inches.
6. **MATERIAL SPECIFICATIONS** -
 - A. Stone Rip-Rap - NCTCOG Specification 2.1.6.(b)(2), Type A or re-cycled concrete meeting the same gradation.
 - B. Filter Stone - NCTCOG Specification 2.1.8.(e).
 - C. Filter Fabric - NCTCOG Specification 2.23.4.
7. **MAINTENANCE REQUIREMENTS** - Stone outlet sediment traps should be inspected weekly and after major rain events to ensure that the device is functioning properly. Remove sediment from the storage area when the depth of sediment has built up to one-half the height of the stone outlet. Inspect the downstream base of the stone outlet and the downstream flow channel to ensure that no excessive erosion or gullies have developed and repair as necessary. The sediment storage area should drain within 48 to 72 hours after a rain event. The filter stone on the upstream face of the stone outlet may require cleaning or replacement if standing water remains for longer periods.

This record drawing is a compilation of the sealed engineering drawing for this project; modified by addenda, change orders and information furnished by the contractor. The information shown on the record drawings that was provided by the contractor or others not associated with the design engineer cannot be verified for accuracy or completeness. This original sealed drawings are on file at the offices of Birkhoff, Hendricks & Carter, L.L.P.

BY J.W.B. DATE 05/04/2010

THESE DOCUMENTS ARE FOR BIDDING, CONSTRUCTION, AND PERMIT PURPOSES.

John Bullhoff

DATE: 10/31/06



These plans and related specifications were prepared for construction of this specific project only. Reuse of these documents is not permitted without written authorization of Birkhoff, Hendricks, & Conway, L.L.P.

TOWN OF ADDISON, TEXAS	
ADDISON ROAD IMPROVEMENTS BELT LINE ROAD TO ARAPAHO ROAD PHASE I STORM WATER POLLUTION PREVENTION PLAN DETAILS	
BIRKHOFF, HENDRICKS & CONWAY L. L. P. CONSULTING ENGINEERS Dallas, Texas	
DESIGNED BY: <u>J.W.B.</u>	PROJECT: <u>2002 102</u>
DRAWN BY: <u>TJH</u>	DATE: <u>SEPTEMBER 2006</u>
SHEET NO. 51 OF 68 SHEETS	