


1"=5'

ARAPAHO RD.

EXISTING STAMPED  
COLORED CONCRETE

ADDISON RD.

EXISTING  
CURB &  
GUTTER

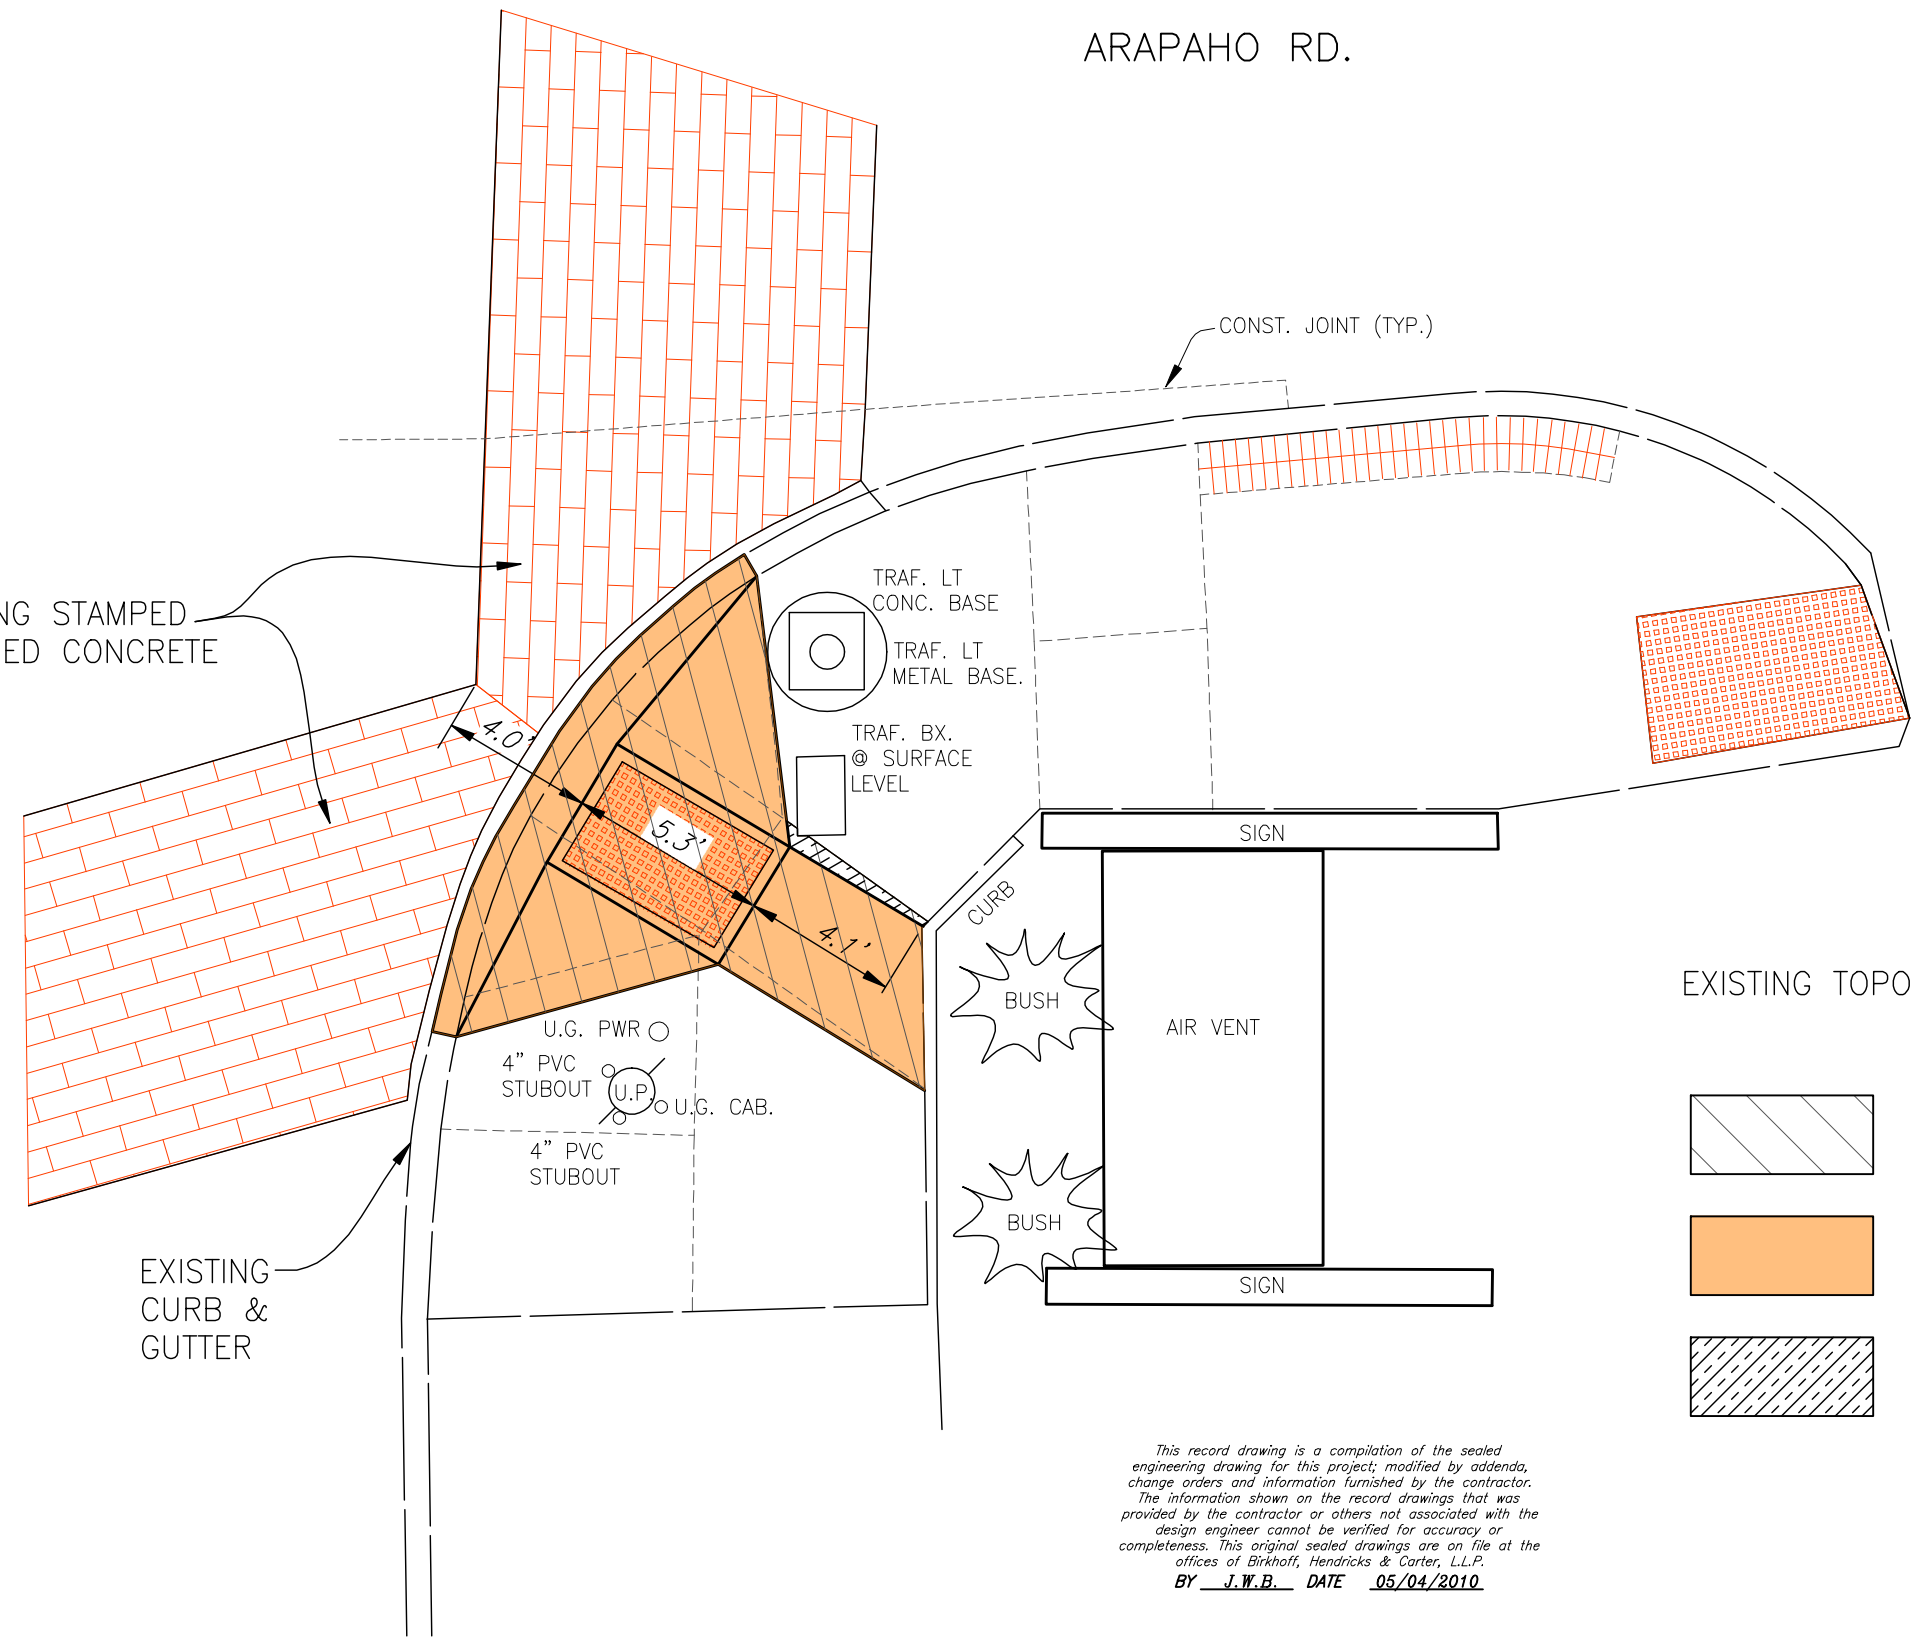


EXISTING TOPO SURVEYED - FEB. 10, 2009



EXIST. SIDEWALK PVMT. AND  
BARRIER FREE RAMP REMOVAL



BARRIER FREE RAMP REPLACEMENT  
(STANDARD REINFORCED CONCRETE)

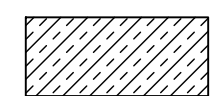


SIDEWALK PVMT. REPLACEMENT

This record drawing is a compilation of the sealed engineering drawing for this project; modified by addenda, change orders and information furnished by the contractor. The information shown on the record drawings that was provided by the contractor or others not associated with the design engineer cannot be verified for accuracy or completeness. This original sealed drawings are on file at the offices of Birkhoff, Hendricks & Carter, L.L.P.  
 BY J.W.B. DATE 05/04/2010

These plans and related specifications were prepared for construction of this specific project only. Reuse of these documents is not permitted without written authorization of Birkhoff, Hendricks, & Conway, L.L.P.

**BIRKHOFF, HENDRICKS & CONWAY, L.L.P.**  
 PROFESSIONAL ENGINEERS  
 Texas Firm F526  
 11910 Greenville Ave., Suite 600  
 Dallas, Texas 75243 (214) 361-7900

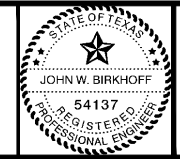

THESE DOCUMENTS ARE FOR  
 BIDDING, CONSTRUCTION,  
 AND PERMIT PURPOSES.  
 DATE: 6/16/09

**TOWN OF ADDISON, TEXAS**  
**ADDISON ROAD IMPROVEMENTS**  
**BARRIER FREE RAMP GEOMETRIES**  
**AT ADDISON ROAD & ARAPAHO ROAD**

BHC  
 PROJECT NO.  
 2006-137  
 May 2010

SHEET NO.  
**1**