

SAMBUCA  
15207 ADDISON RD.


STEAK HOUSE  
ADDISON RD.

NOTE: 1. PRIVATE OWNER SHALL BE RESPONSIBLE FOR RESTORING 100% COVERAGE AND AUTO-OPERATION.  
PRIVATE PROPERTY SPRINKLERS SHALL BE FIELD LOCKED, CAPPED FOR CONSTRUCTION, REPAIRED TO MAKE OPERATIONAL. ALSO NOTE CONTRACTOR SHALL RUN PRIVATE SYSTEMS IN THE PRESENCE OF OWNER TO VERIFY CONDITIONAL OF SYSTEM BEFORE CONSTRUCTION ACTIVITIES.  
EXISTING PLANT MATERIAL TO REMAIN. CONTRACTOR TO COORDINATE WITH PROPERTY OWNER AND MAINTAINING EXISTING LANDSCAPE IRRIGATION.  
2. ALL NEW PROPOSED REMOTE CONTROL VALVES TO BE LOCATED AWAY FROM STREET, CLOSE TO SIDEWALK.  
3. LOCATION OF IRRIGATION WATER SERVICE, VALVING AND CONTROLLER TO BE LOCATED IN THE FIELD BY THE TOWN OF ADDISON.  
4. IRRIGATION CONCRCTOR TO RUN ELECTRICAL CONDUIT AND CONDUCTORS BETWEEN ELECTRICAL SERVICE PANEL AND SEPARATE CONTROLLER 20 AMP. CIRCUIT FOR EACH CONTROLLER IS SHOWN IN THE ELECTRICAL PLANS.  
5. USE APPROPRIATE NOZZLES TO CONVEY WATER TO LANDSCAPED AREAS.

NOZZLE	RAJUS(T)	FLOW(GPM)	PRECIP.(in/h)
BH	8	0.52	1.58
BH	8	0.58	1.58
BH	10	0.70	1.52
BH	12	1.30	1.74
BH	15	1.85	1.58
BH	15	0.92	1.58
BH	190	4.30	
BH	190	1.21	
BH	190	0.81	

NOTE: USE VAN Series NOZZLES WATERING ODD-SHAPED AREAS SEE SHEET No. 61 & 62, FOR IRRIGATION DETAILS AND NOTES

BIDUAR BOUTIQUE HOTELS, LTD.  
15200 ADDISON RD., SUITE

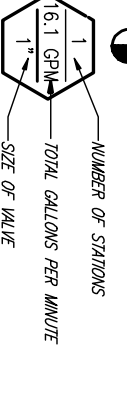

This record drawing is a completion of the seeded engineering drawing for this project, modified by additions, change orders and information furnished by the contractor. The information shown on the record drawings is the responsibility of the contractor. It is not to be used for any other project without the written consent of Birkhoff, Hendricks & Conway, L.L.P. of the offices of Birkhoff, Hendricks & Conway, L.L.P.

BY J.W.B. DATE 05/04/2010

TOWN OF ADDISON, TEXAS

ADDISON ROAD IMPROVEMENTS  
BELT LINE ROAD TO ARAPAHO ROAD PHASE I  
ADDISON ROAD IRRIGATION

BIRKHOFF, HENDRICKS & CONWAY L.L.P.  
CONSULTING ENGINEERS  
DALLAS, TEXAS



DESIGNED BY: G.C.  
DRAWN BY: B.H.A.C.  
PROJECT: 2002 102  
DATE: APRIL 2007  
SHEET NO. 59  
OF 68 SHEETS

