
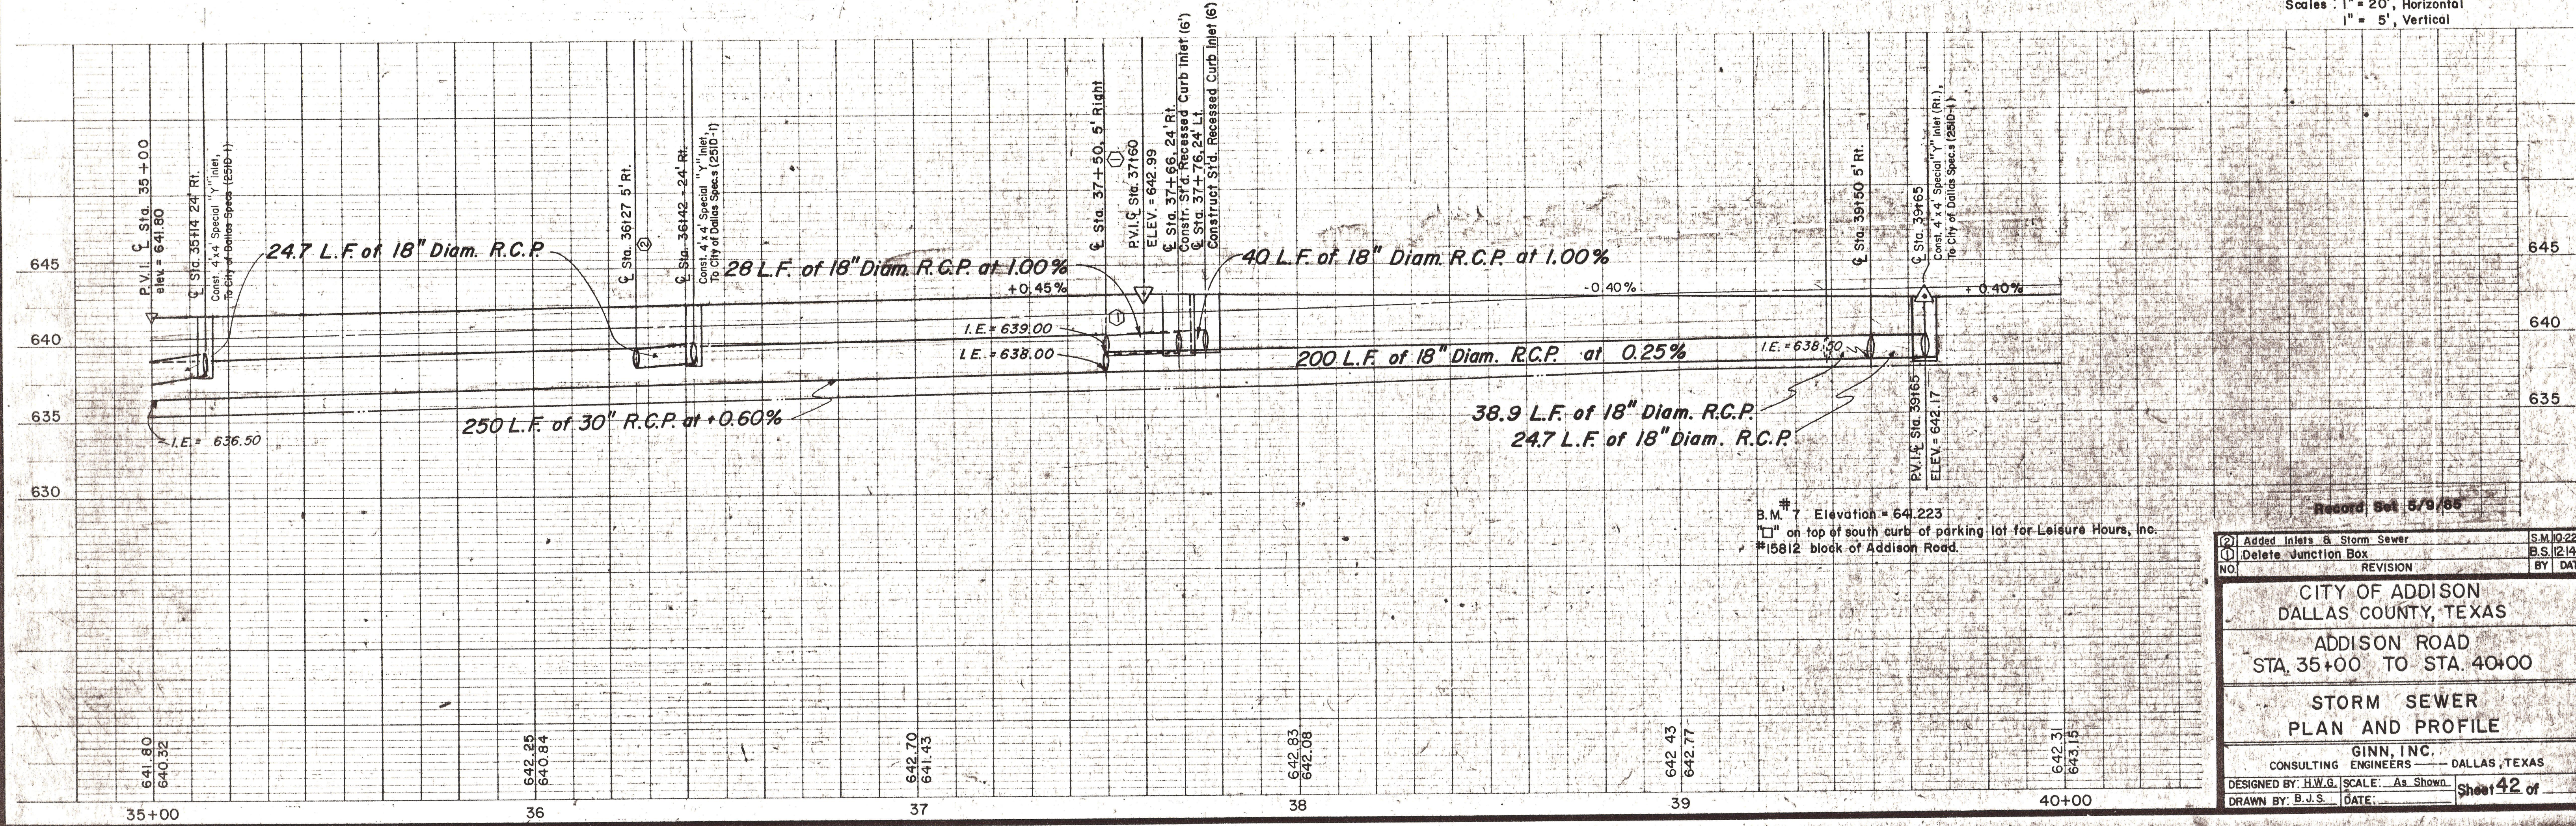


ITEM	DESCRIPTION	UNIT	QUANTITY
31	24" R.C.P.	L.F.	66
30	30" R.C.P.	L.F.	250
32	18" R.C.P.	L.F.	70
19	Recessed Curb-Type Inlets	EA.	2
35	ADJUST WATER LINE	EA.	1
1	REMOVE CONC.	EA.	2
36	ADJUST VALVE BOXES	EA.	1

**LEGEND**

- ⊙ Bench Mark
- ⊕ Hub and Tack
- ⊖ Iron Pin
- ⊕ Monument
- ⊕ Gas Meter
- ⊕ Gas Valve
- ⊕ Gas Line
- ⊕ Power Pole (typical pole symbol)
- ⊕ Power Line
- ⊕ Guy Wire and Anchor
- ⊕ Telephone Cable Box, or Meter
- ⊕ Telephone Line
- ⊕ Water Meter
- ⊕ Water Valve
- ⊕ Water Line
- ⊕ Fire Hydrant
- ⊕ Walkway Spigot
- ⊕ Manhole
- ⊕ Cleanout
- ⊕ Drainage Inlet
- ⊕ Sanitary Sewer Line
- ⊕ Storm Sewer Line
- ⊕ Fence Line
- ⊕ Flow Direction Indicator
- ⊕ Property or Right-of-Way Line
- ⊕ Easement Line

Scales : 1" = 20', Horizontal  
1" = 5', Vertical

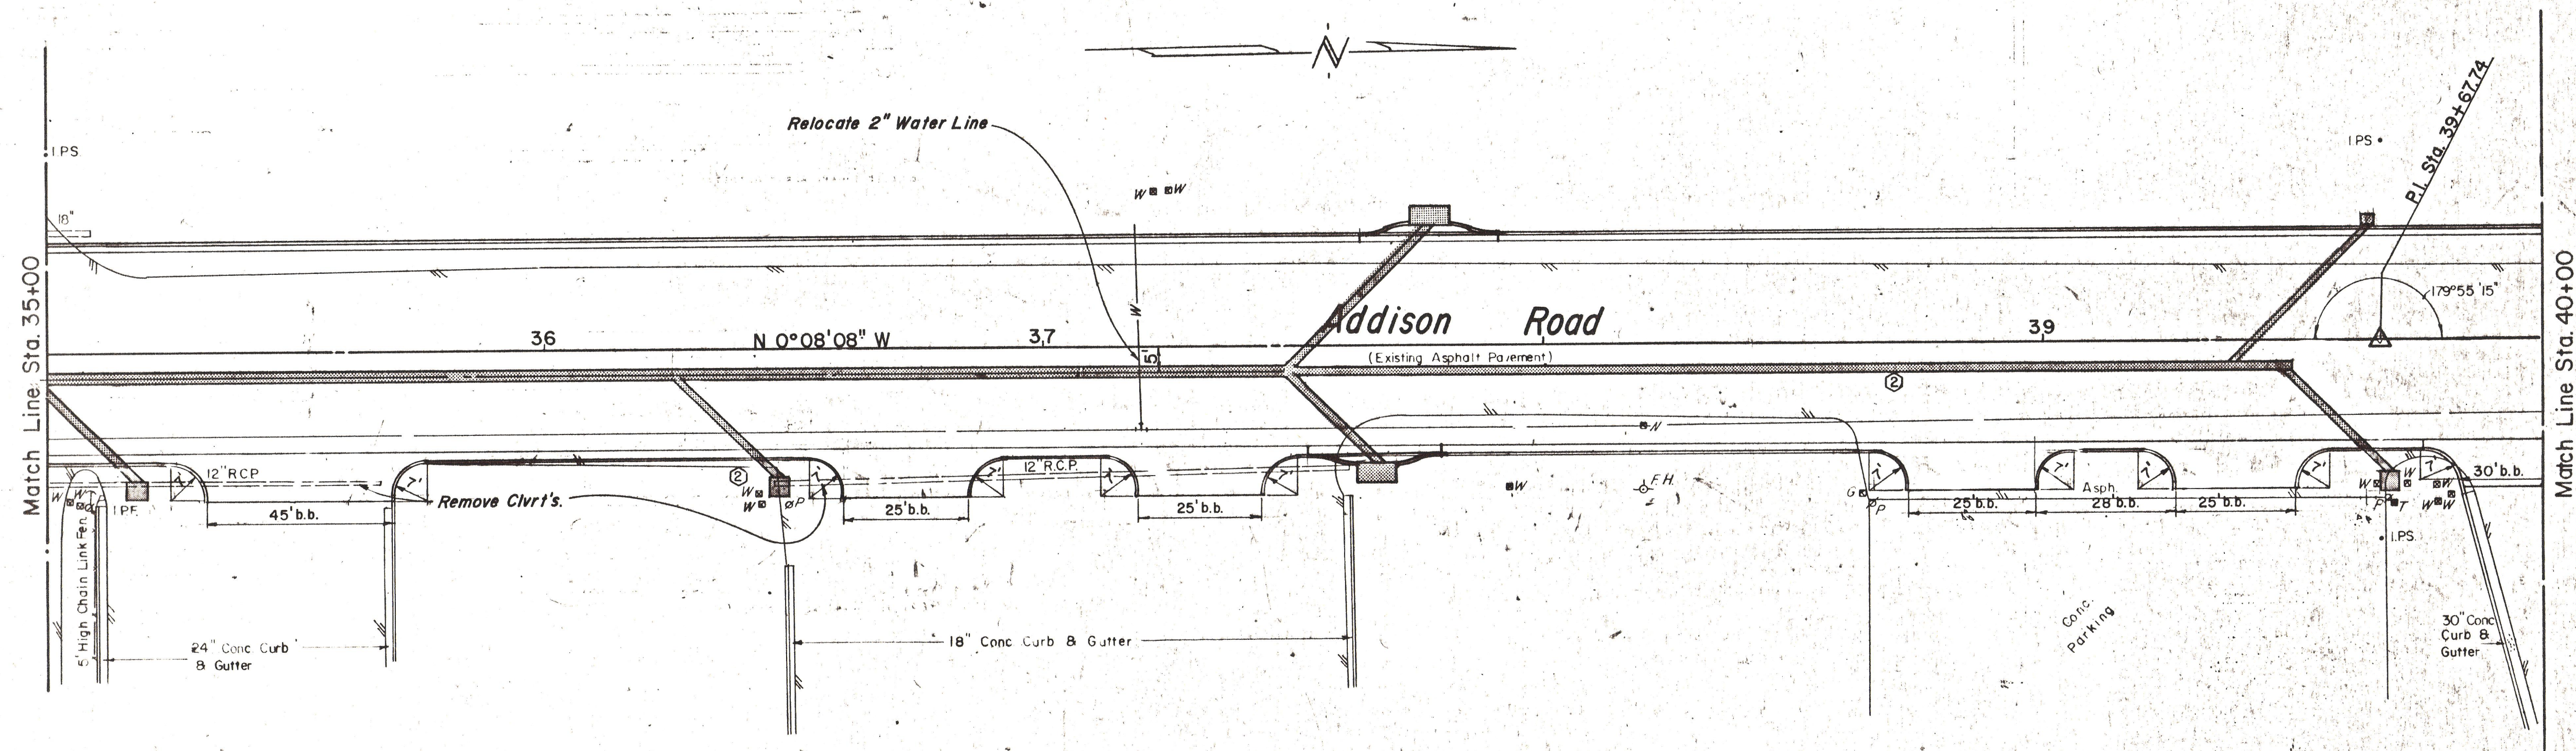

Record Set 5/9/88

⊕ Added Inlets & Storm Sewer	S.M. 10-2273
⊖ Deleted Junction Box	B.S. 12-1478
NO.	REVISION
BY	DATE

**CITY OF ADDISON**  
DALLAS COUNTY, TEXAS

**ADDISON ROAD**  
STA. 35+00 TO STA. 40+00

**STORM SEWER**  
**PLAN AND PROFILE**

GINN, INC.  
CONSULTING ENGINEERS - DALLAS, TEXAS

DESIGNED BY: H.W.G. SCALE: As Shown  
DRAWN BY: B.J.S. DATE: \_\_\_\_\_

Sheet 42 of \_\_\_\_\_