


ESTIMATED QUANTITIES			
ITEM	DESCRIPTION	UNIT	QUANTITY
36	ADJUST VALVE BOXES	EA	2
1	REMOVE CONC.	EA	1

- LEGEND**
- Bench Mark
 - ⊕ Hub and Tack
 - ⊕ Iron Pin
 - ⊕ Monument
 - ⊕ Gas Meter
 - ⊕ Gas Valve
 - ⊕ Gas Line
 - ⊕ Power Pole (typical pole symbol)
 - ⊕ Power Line
 - ⊕ Guy Wire and Anchor
 - ⊕ Telephone Cable Box, or Riser
 - ⊕ Telephone Line
 - ⊕ Water Meter
 - ⊕ Water Valve
 - ⊕ Water Line
 - ⊕ Fire Hydrant
 - ⊕ Water Spigot
 - ⊕ Manhole
 - ⊕ Cleanout
 - ⊕ Drainage Inlet
 - ⊕ Sanitary Sewer Line
 - ⊕ Storm Sewer Line
 - ⊕ Storm Sewer Line
 - ⊕ Fence Line
 - ⊕ Flow Direction Indicator
 - ⊕ Property or Right-of-Way Line
 - ⊕ Easement Line

Scales: 1" = 20', Horizontal
 1" = 5', Vertical

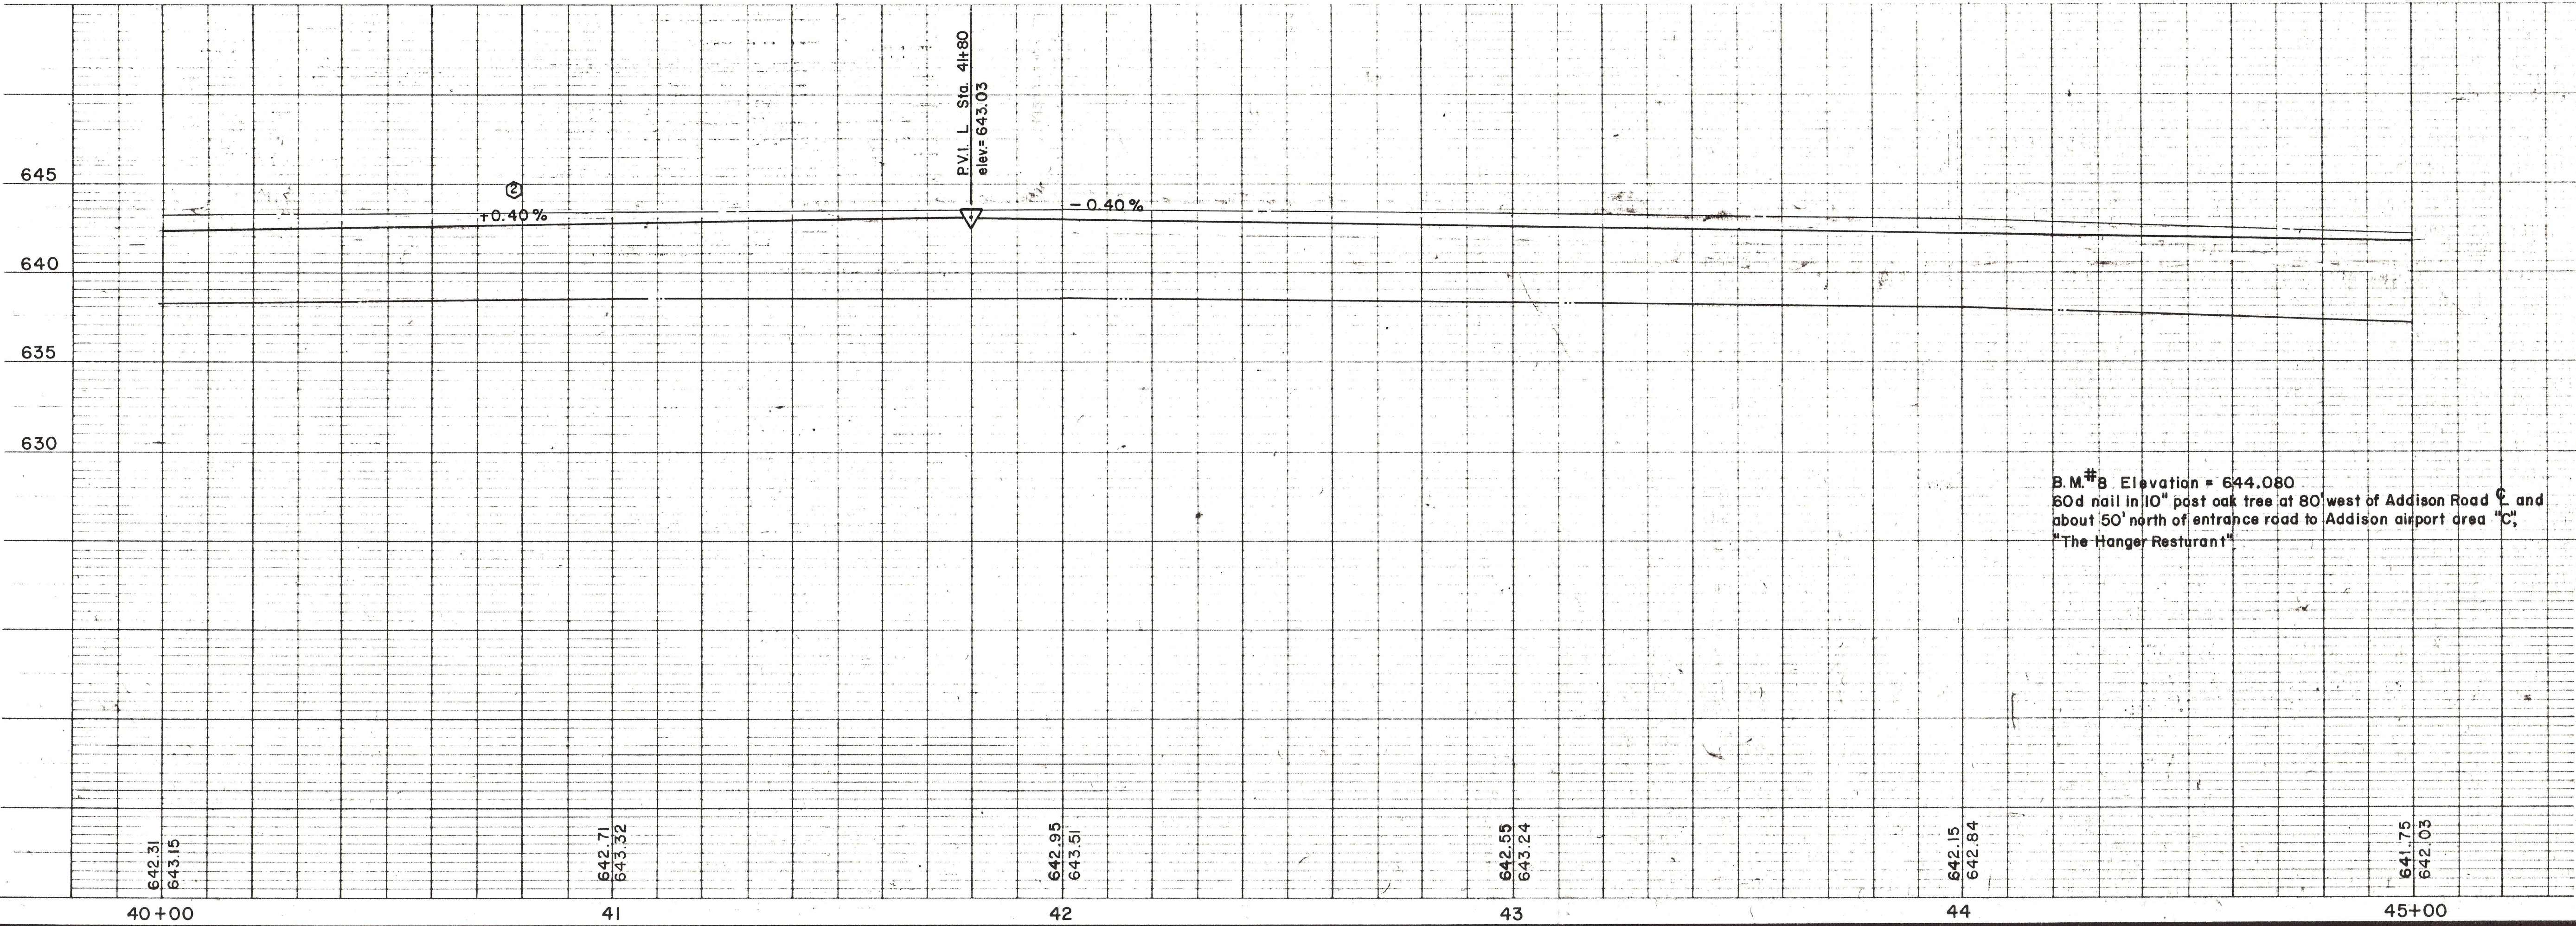

B.M. # B Elevation = 644.080
 60d nail in 10" post oak tree at 80' west of Addison Road C and
 about 50' north of entrance road to Addison airport area "C",
 "The Hanger Restaurant"

Record Set 5/9/85

②	Changed Grade	B.H. 10/22/79
①	Removal Note Added	B.S. 12/14/79
NO.	REVISION	BY DATE

CITY OF ADDISON
 DALLAS COUNTY, TEXAS

ADDISON ROAD
 STA. 40+00 TO STA. 45+00

STORM SEWER
 PLAN AND PROFILE

GINN, INC.
 CONSULTING ENGINEERS — DALLAS, TEXAS

DESIGNED BY: H.W.G. SCALE: As Shown
 DRAWN BY: B.J.S. DATE:
 Sheet 43 of