


ESTIMATED QUANTITIES			
ITEM	DESCRIPTION	UNIT	QUANTITY
30	30" R.C.P.	L.F.	10
27	48" R.C.P.	L.F.	71
26	54" R.C.P.	L.F.	185
25	60" R.C.P.	L.F.	245
23	84" R.C.P.	L.F.	71
17	INLET - Y TYPE	EA	1
19	Recessed Curb - Type Inlet	EA	3
21	Junction Box	EA	1
22	HEADWALL	EA	1
32	18" R.C.P.	L.F.	50
31	24" R.C.P.	L.F.	90
13	MISC. CONC.	C.Y.	20
38	Adjust Water Line (8")	L.F.	30
36	Adjust Valve Boxes	EA	2
34	Adjust M.H.'s	EA	1
4)	DBL. 6'x3' Box Culvert	L.S.	1
1	Remove Conc.	EA	5

- LEGEND**
- Bench Mark
 - ⊕ Hub and Tack
 - ⊙ Iron Pin
 - ⊙ Monument
 - ⊙ Gas Meter
 - ⊙ Gas Valve
 - ⊙ Gas Line
 - ⊙ Power Pole (typical pole symbol)
 - ⊙ Power Line
 - ⊙ Guy Wire and Anchor
 - ⊙ Telephone Cable Box, or Riser
 - ⊙ Telephone Line
 - ⊙ Water Meter
 - ⊙ Water Valve
 - ⊙ Water Line
 - ⊙ Fire Hydrant
 - ⊙ Water Spigot
 - ⊙ Manhole
 - ⊙ Cleanout
 - ⊙ Drainage Inlet
 - ⊙ Sanitary Sewer Line
 - ⊙ Storm Sewer Line
 - ⊙ Fence Line
 - ⊙ Flow Direction Indicator
 - ⊙ Property or Right-of-Way Line
 - ⊙ Easement Line

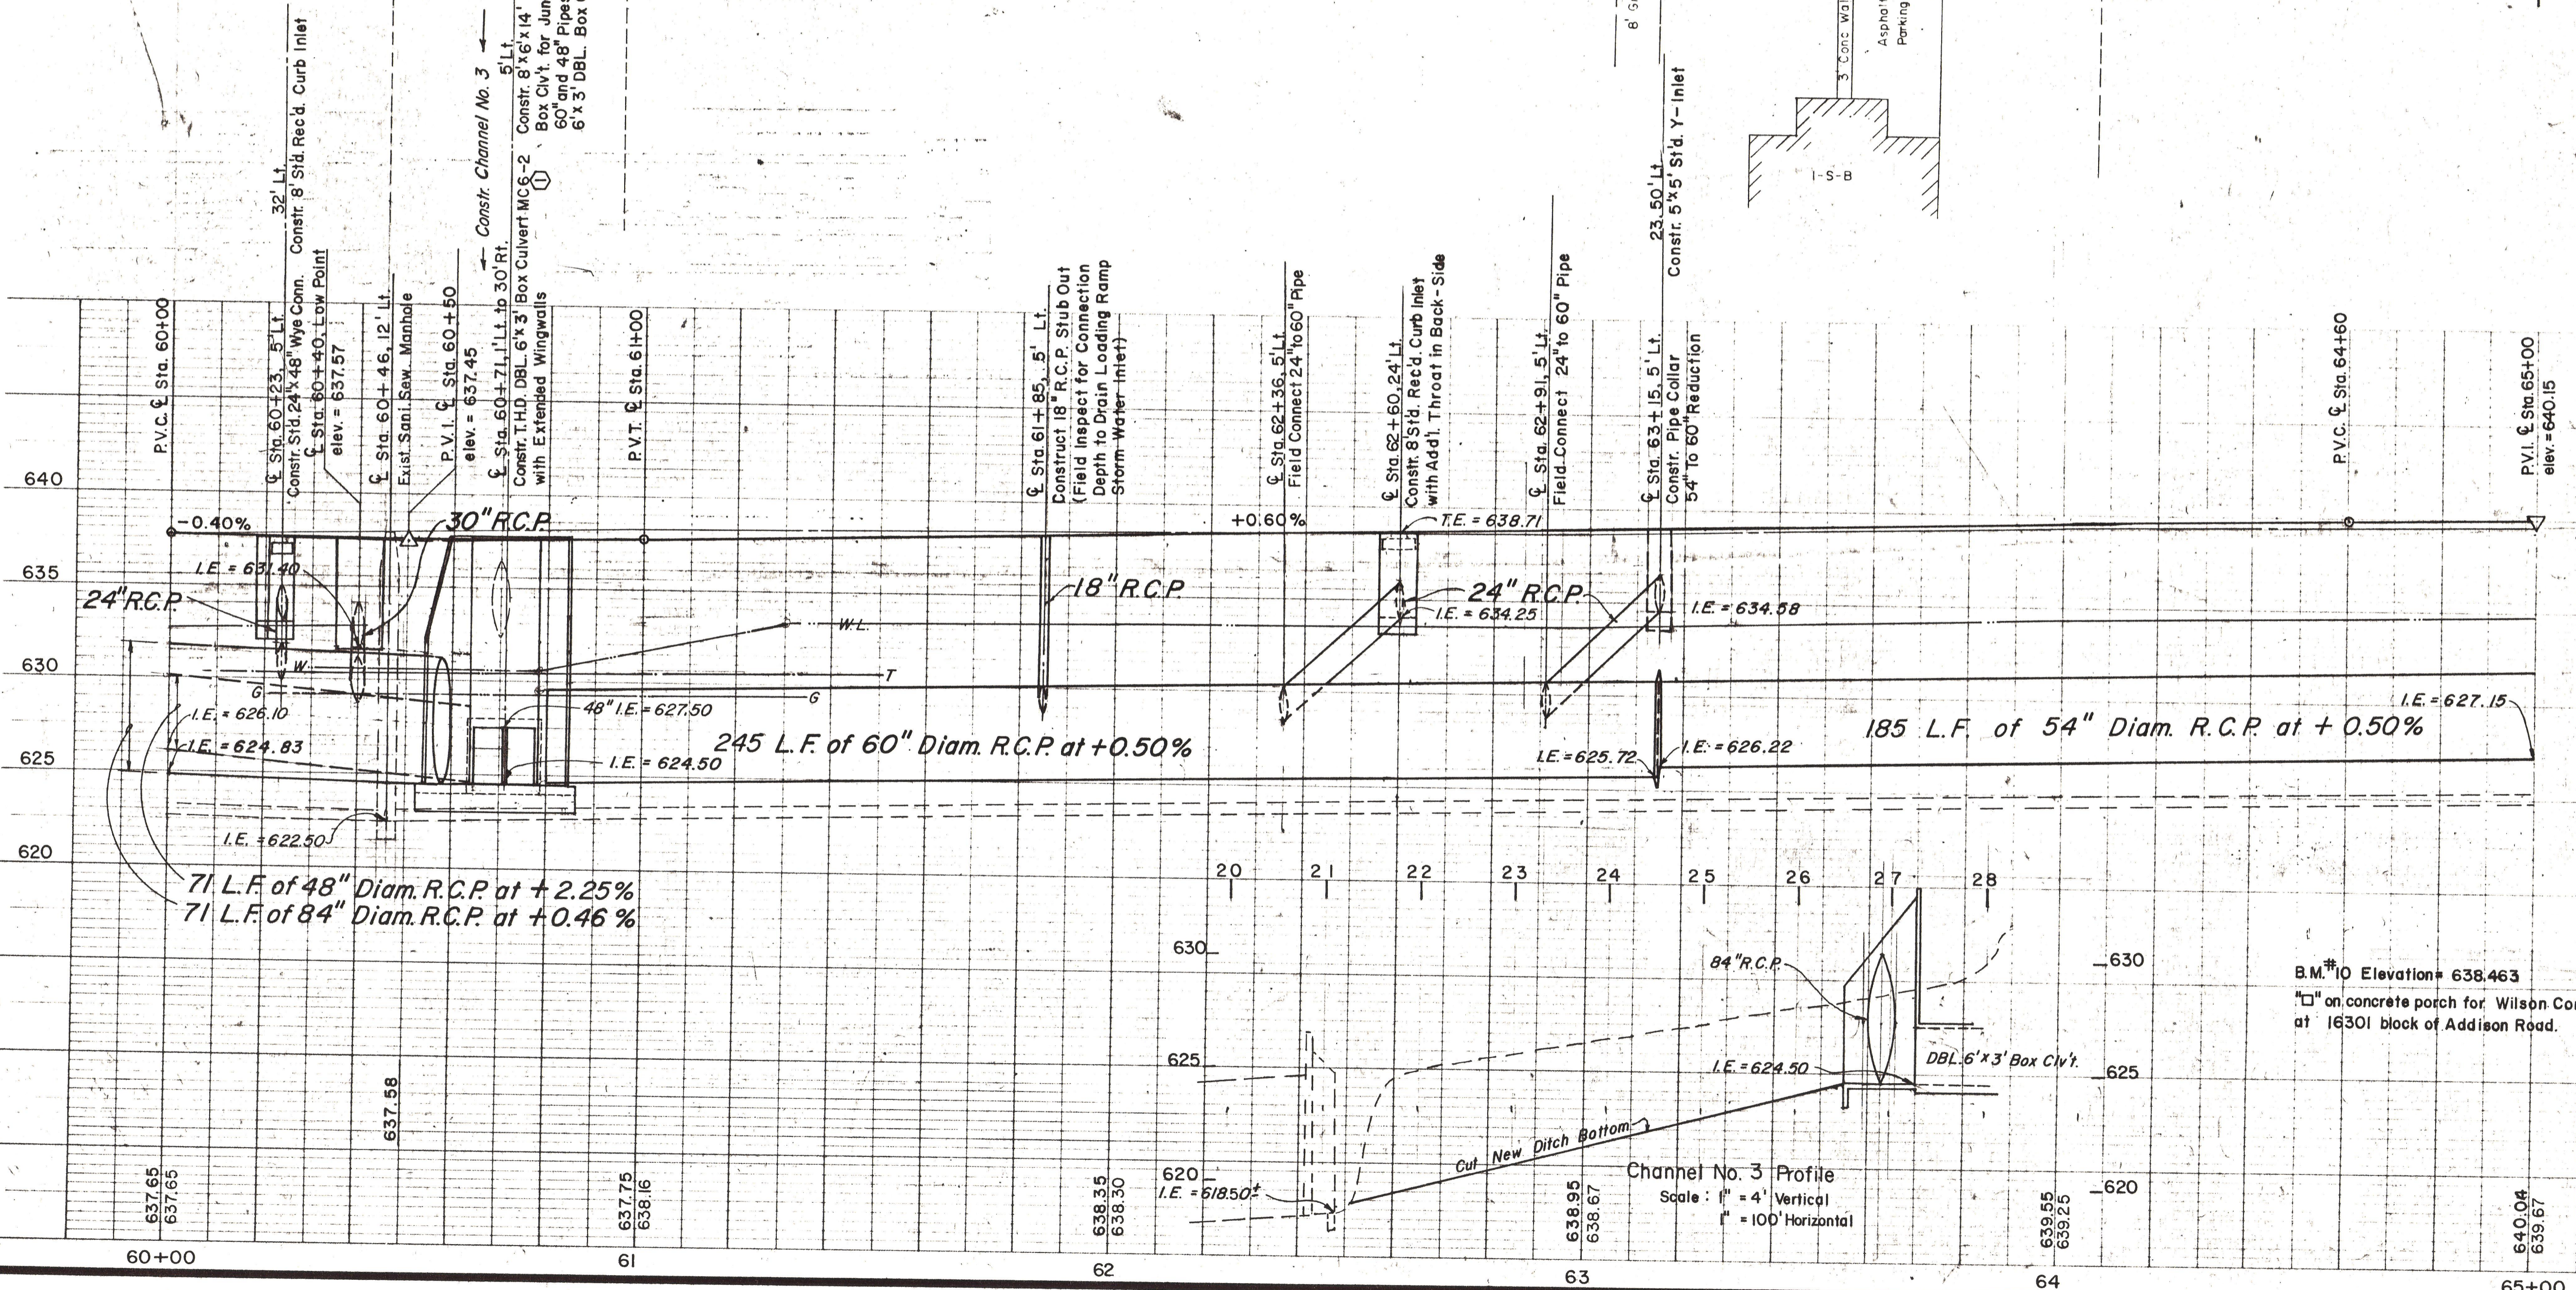

Scales: 1" = 20', Horizontal
1" = 5', Vertical

Record Set 5/9/65

① Structure Designation	B.S. 121478
NO	BY DATE
REVISION	
CITY OF ADDISON DALLAS COUNTY, TEXAS	
ADDISON ROAD STA. 60+00 TO STA. 65+00	
STORM SEWER PLAN AND PROFILE	
GINN, INC. CONSULTING ENGINEERS - DALLAS, TEXAS	
DESIGNED BY: H.W.G.	SCALE: As Shown
DRAWN BY: B.J.S.	DATE: _____
Sheet 47 of _____	