


ESTIMATED QUANTITIES		UNIT	QUANTITY
31	24" R.C.P.	L.F.	30
27	48" R.C.P.	L.F.	50
26	54" R.C.P.	L.F.	450
19	Recessed Curb Inlet	EA.	2
17	Y-Inlet	EA.	1
32	18" RCP	L.F.	31
29	36" RCP	L.F.	21
1	Remove Conc.	EA.	2
36	Adjust Valve Boxes	EA.	1
34	Adjust M.H.'s	EA.	1

- LEGEND**
- Bench Mark
 - Hub and Tack
 - Iron Pin
 - Monument
 - Gas Meter
 - Gas Valve
 - Gas Line
 - Power Pole (typical pole symbol)
 - Power Line
 - Guy Wire and Anchor
 - Telephone Cable Box, or Risers
 - Water Meter
 - Water Valve
 - Water Line
 - Fire Hydrant
 - Water Spigot
 - Manhole
 - Cleanout
 - Drainage Inlet
 - Sanitary Sewer Line
 - Storm Sewer Line
 - Fence Line
 - Flow Direction Indicator
 - Property or Right-of-Way Line
 - Easement Line

Scales: 1" = 20', Horizontal
1" = 5', Vertical

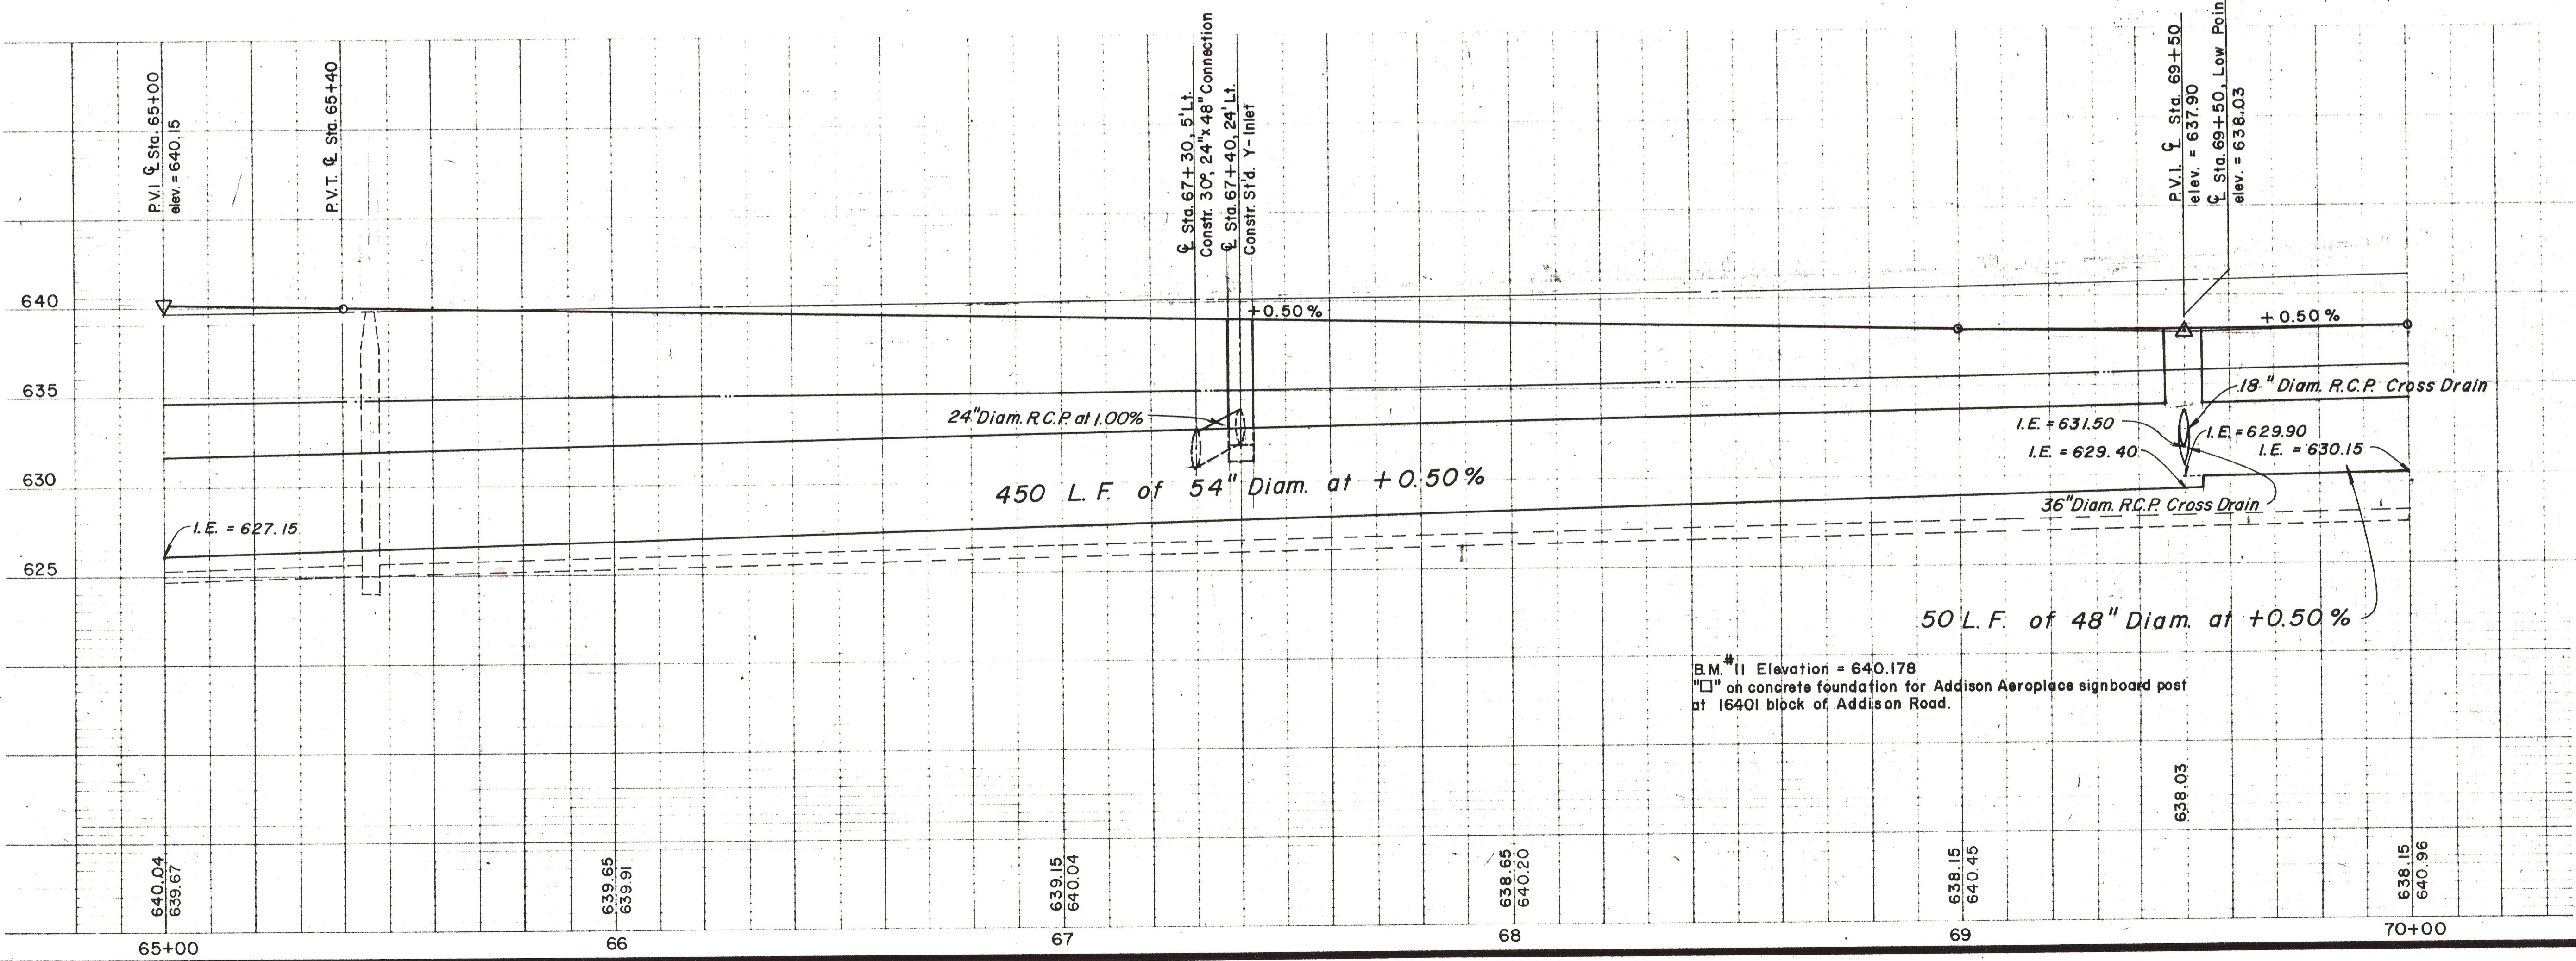

B.M. #11 Elevation = 640.178
"□" on concrete foundation for Addison Aeroplace signboard post at 16401 block of Addison Road.

Record Set 5/9/85

1	Delete Junction Box	B.S. 12/476
NO	REVISION	BY DATE
CITY OF ADDISON DALLAS COUNTY, TEXAS		
ADDISON ROAD STA. 65+00 TO STA. 70+00		
STORM SEWER PLAN AND PROFILE		
GINN, INC. CONSULTING ENGINEERS — DALLAS, TEXAS		
DESIGNED BY: H.W.S.	SCALE: As Shown	Sheet 48 of
DRAWN BY: B.J.S.	DATE:	