


ITEM	DESCRIPTION	UNIT	QUANTITY
32	18\"/>		
31	24\"/>		
30	30\"/>		
29	36\"/>		
26	54\"/>		
19	Recessed Curb Inlet	EA.	3
21	Junction Box	EA.	1
22	Headwall	EA.	1
1	Remove Conc.	EA.	1
13	Misc. Conc.	C.Y.	10

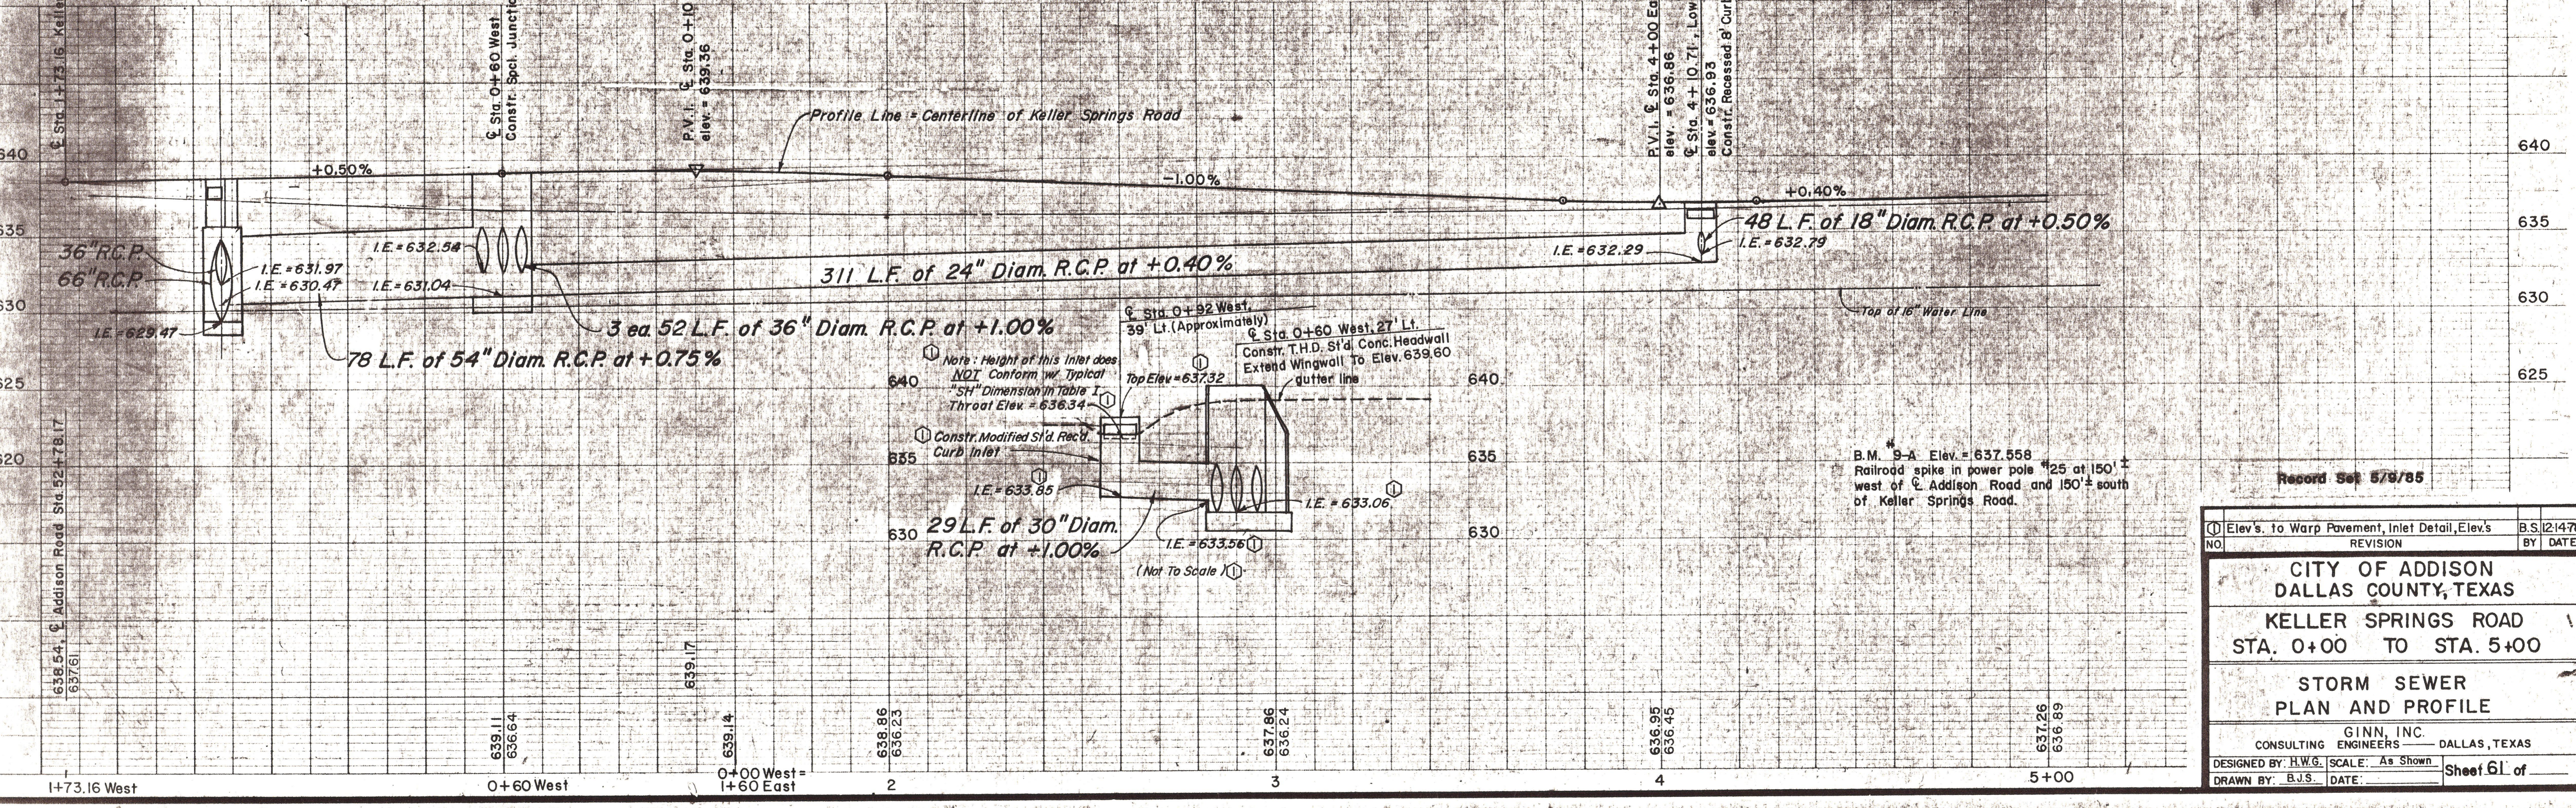

Scales: 1" = 20', Horizontal
1" = 5', Vertical

Record Set 5/9/85

NO.	REVISION	BY	DATE
1	Elev's. to Warp Pavement, Inlet Detail, Elev's	B.S.	12/14/78

CITY OF ADDISON
DALLAS COUNTY, TEXAS
KELLER SPRINGS ROAD
STA. 0+00 TO STA. 5+00

STORM SEWER
PLAN AND PROFILE

GINN, INC.
 CONSULTING ENGINEERS - DALLAS, TEXAS

DESIGNED BY: H.W.S. SCALE: As Shown
 DRAWN BY: B.J.S. DATE:

Sheet 61 of