



Future Street

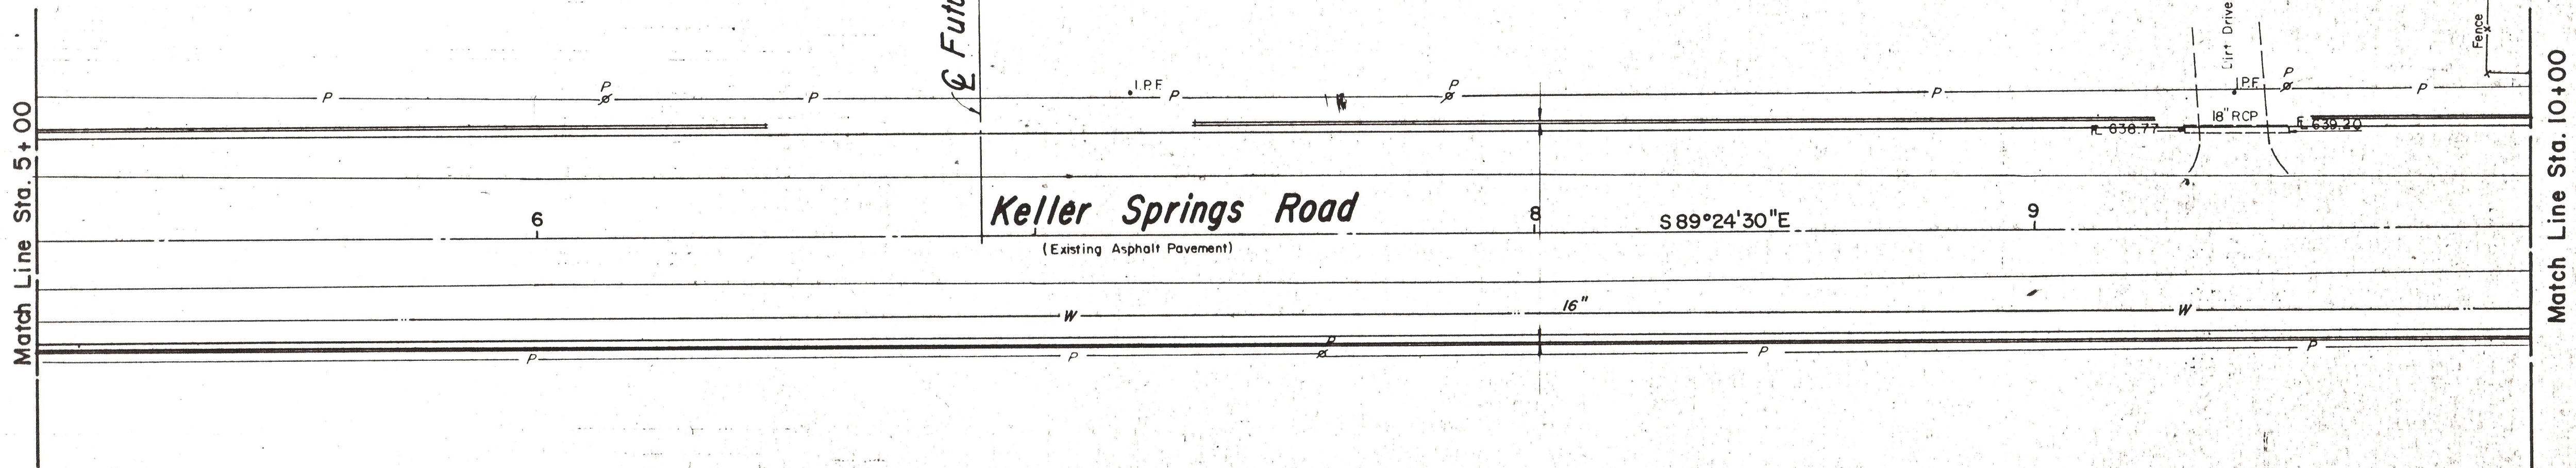

ITEM	DESCRIPTION	ESTIMATED QUANTITIES	
		UNIT	QUANTITY
1	Remove Old Conc.	Ea.	

Scales: 1" = 20' Horizontal  
1" = 5' Vertical

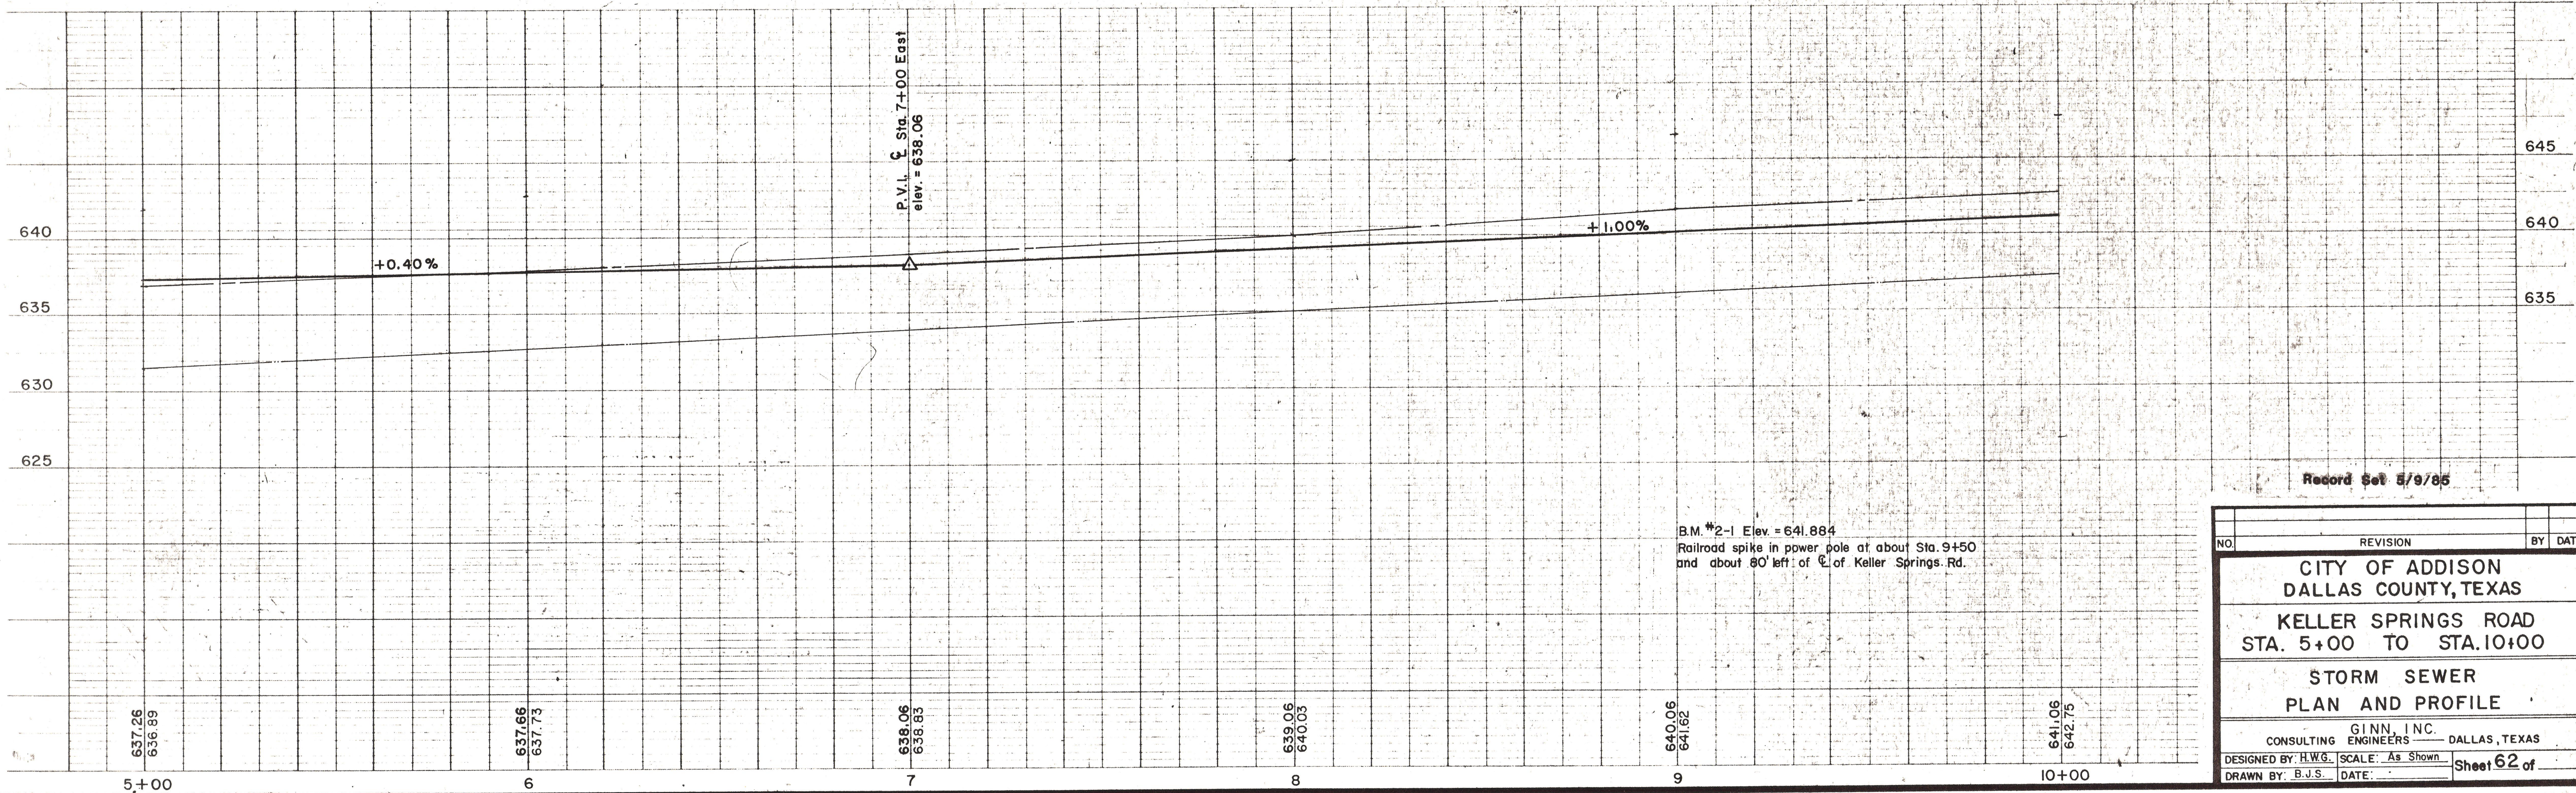

Record Set 5/9/85

NO.	REVISION	BY	DATE
CITY OF ADDISON DALLAS COUNTY, TEXAS			
KELLER SPRINGS ROAD STA. 5+00 TO STA. 10+00			
STORM SEWER PLAN AND PROFILE			
GINN, INC. CONSULTING ENGINEERS - DALLAS, TEXAS			
DESIGNED BY: H.W.G.		SCALE: As Shown	
DRAWN BY: B.J.S.		DATE:	
			Sheet 62 of

637.26  
636.89  
5+00

637.66  
637.73  
6

638.06  
638.83  
7

639.06  
640.03  
8

640.06  
641.82  
9

641.06  
642.75  
10+00