



ESTIMATED QUANTITIES			
ITEM	DESCRIPTION	UNIT	QUANTITY
1	Remove Old Conc.	Ea.	4
36	Adjust Valve Box	Ea.	1

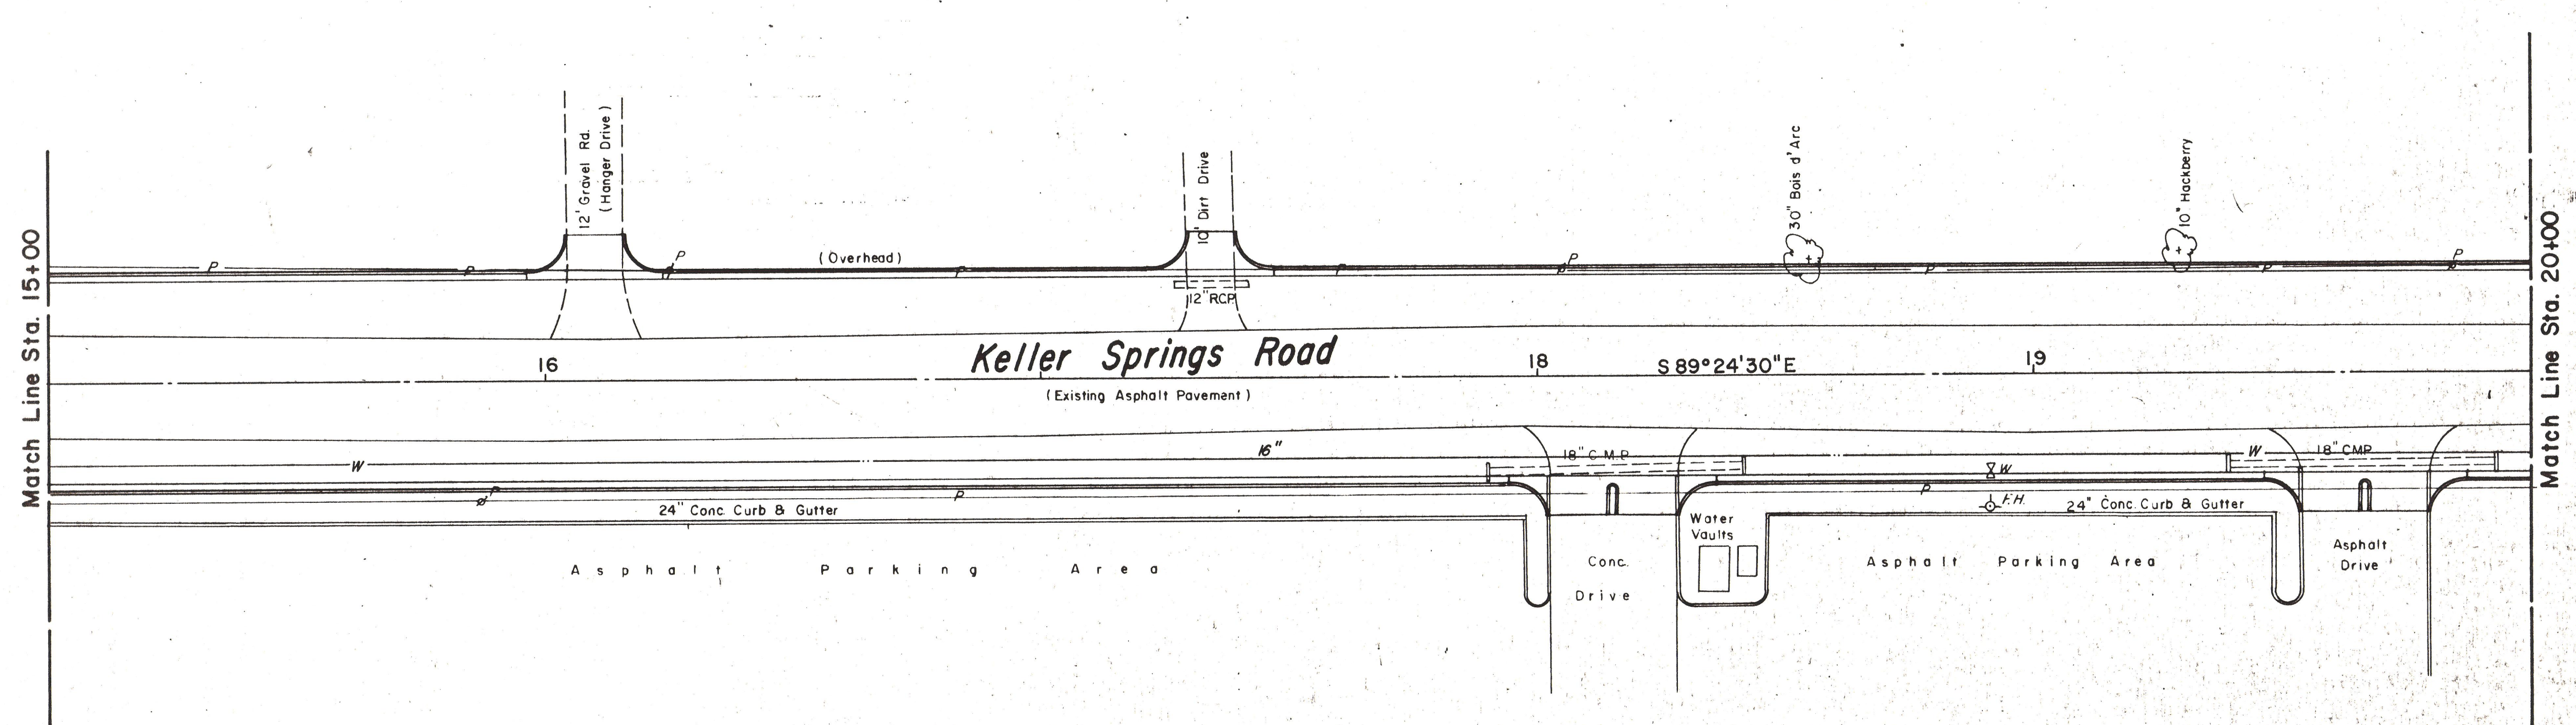

Scales: 1" = 20', Horizontal
 1" = 5', Vertical

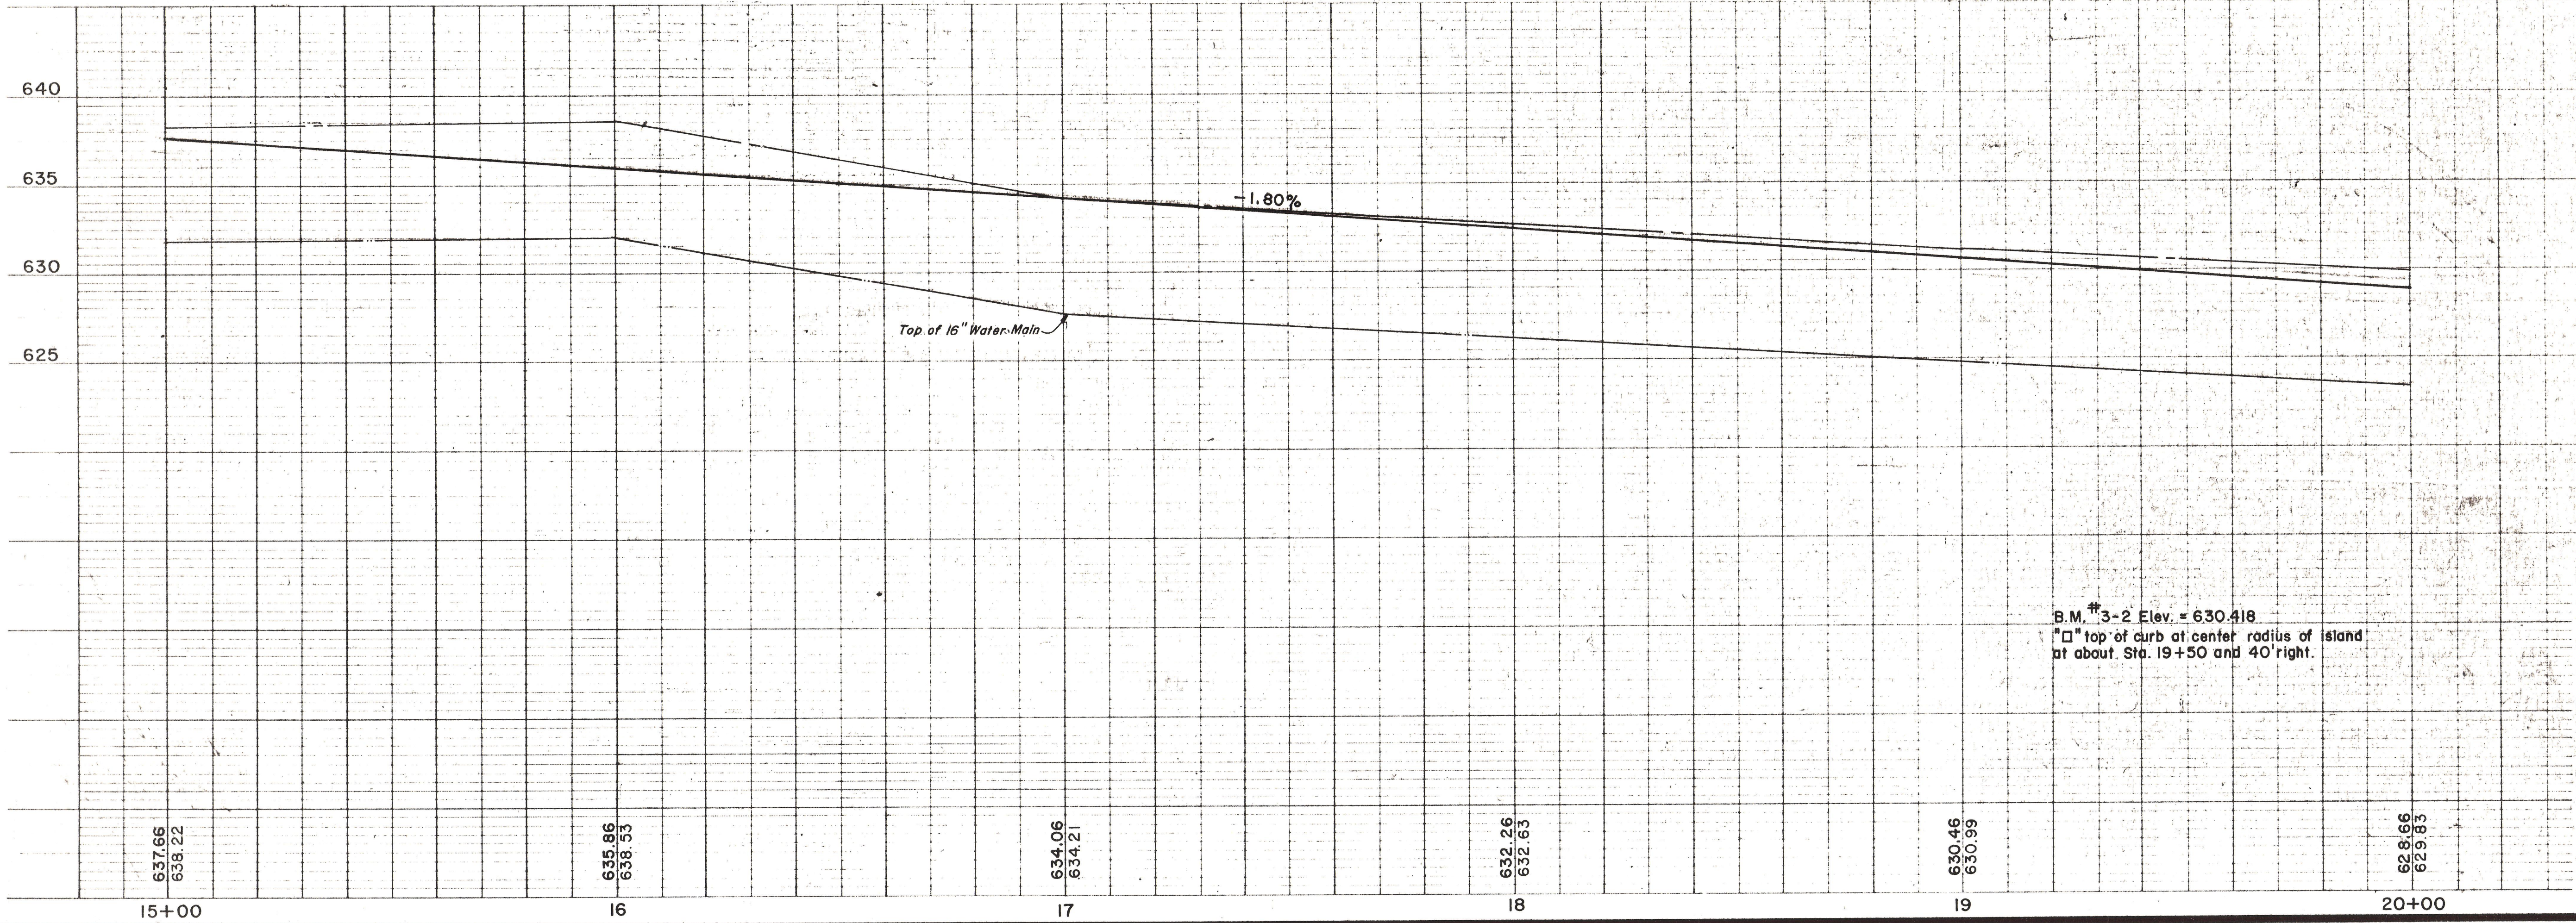

Record Set 5/9/85

NO.	REVISION	BY	DATE

CITY OF ADDISON
DALLAS COUNTY, TEXAS
KELLER SPRINGS ROAD
STA. 15+00 TO STA. 20+00

STORM SEWER
PLAN AND PROFILE

GINN, INC.
CONSULTING ENGINEERS—DALLAS, TEXAS

DESIGNED BY: H.W.G. SCALE: As Shown
DRAWN BY: B.J.S. DATE: _____ Sheet 64 of _____