




PLAN: CONCRETE MANHOLE APRON
NTS

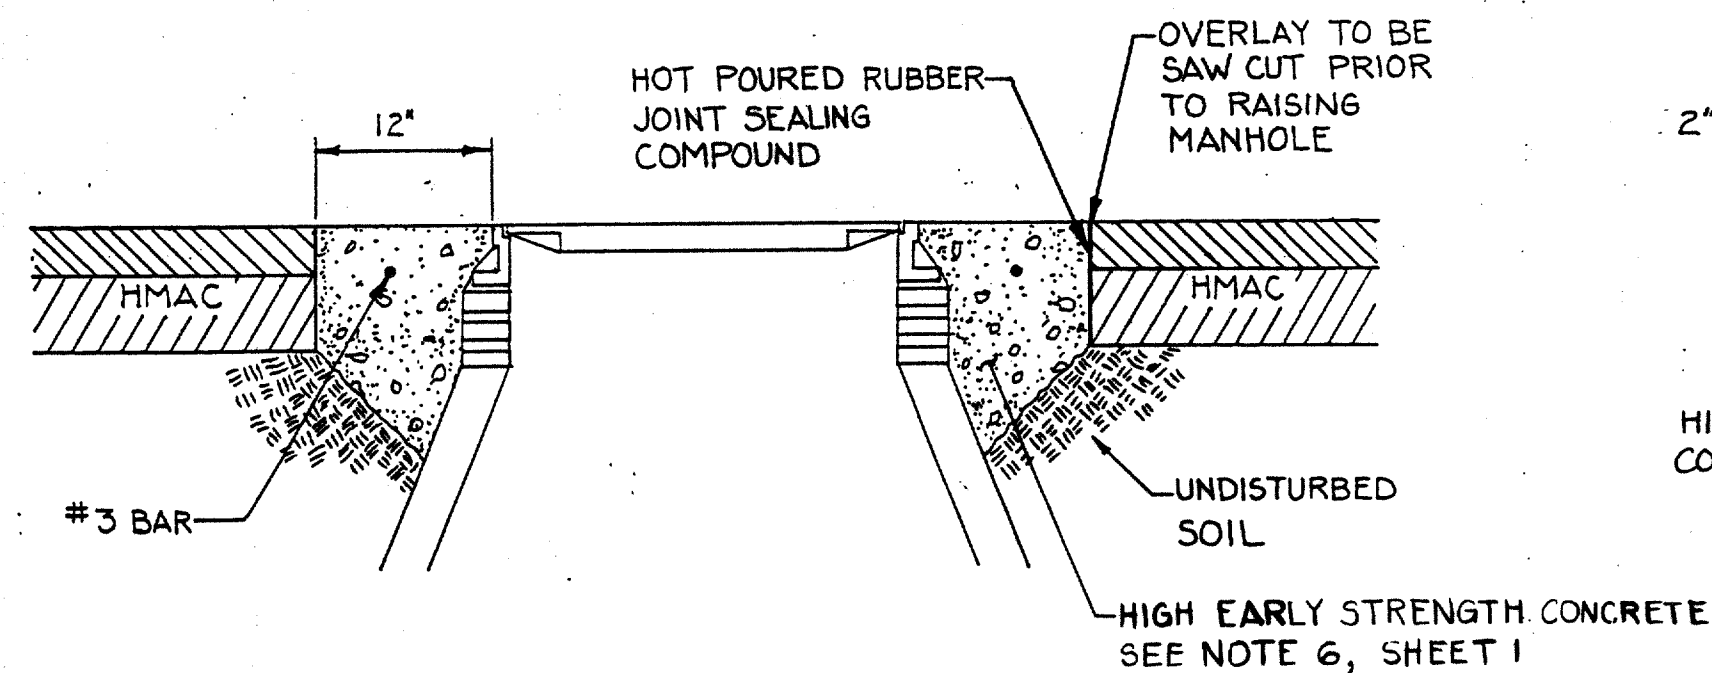


SECTION: CONCRETE MANHOLE APRON
NTS

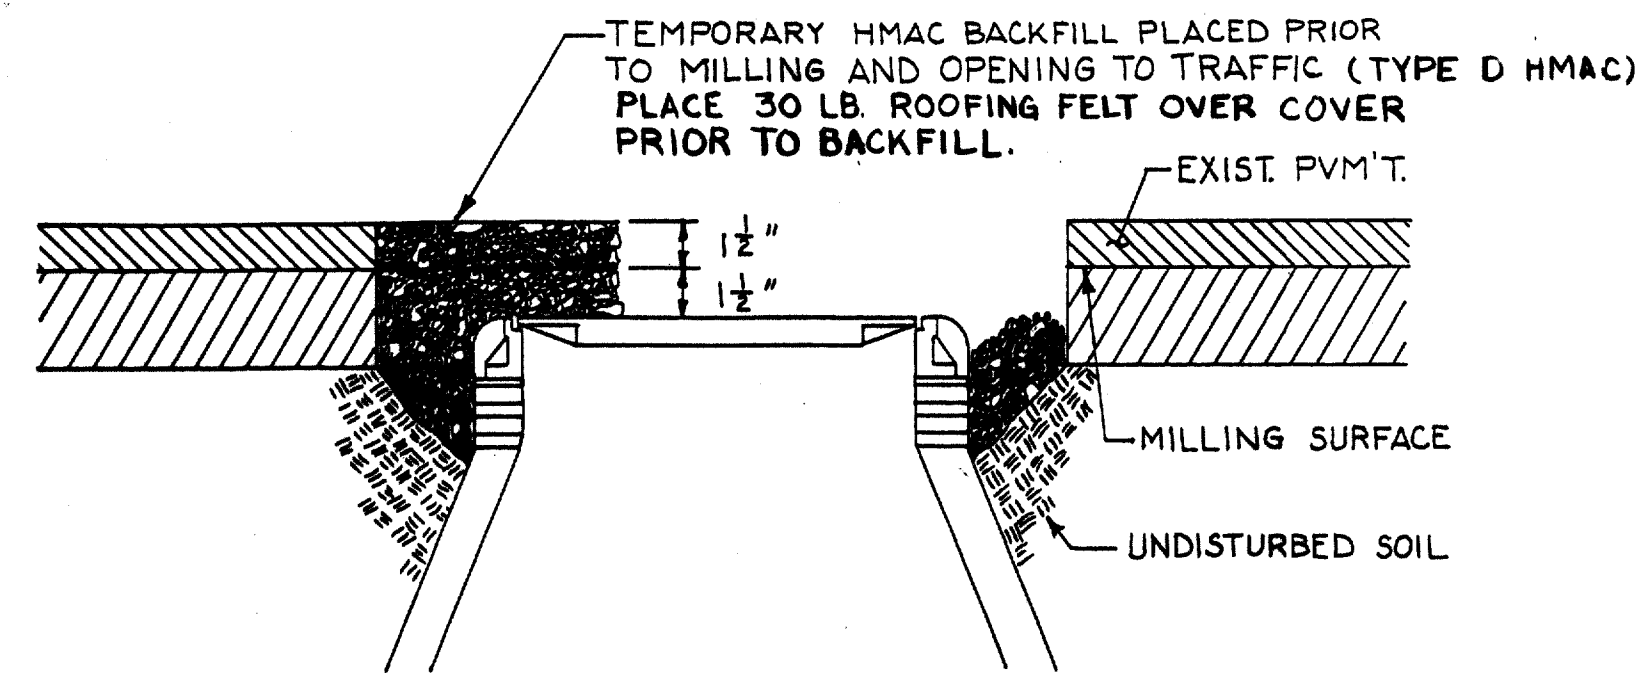


DETAIL: TEMPORARY LOWERING OF MANHOLE
NTS

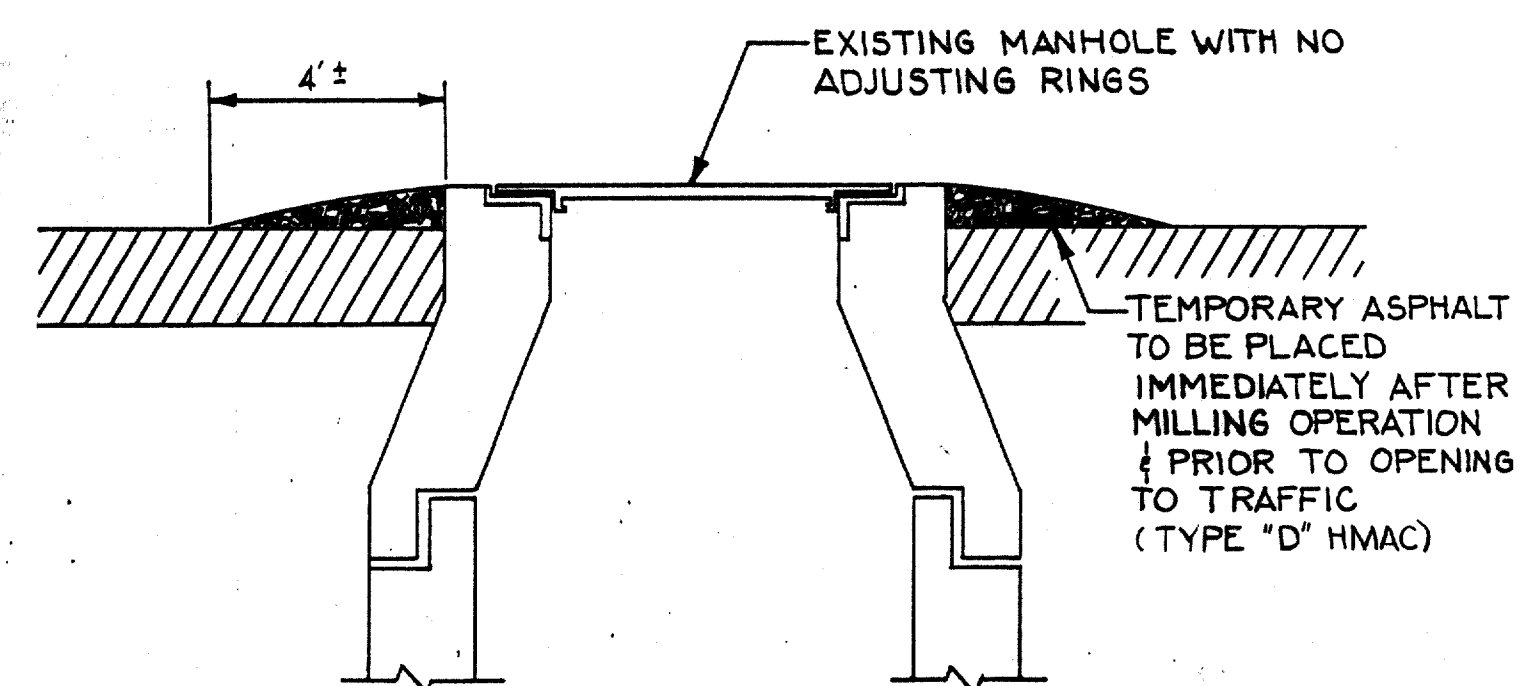


SECTION: TEMPORARY ASPHALT FOR NON-ADJUSTED MANHOLE
NTS

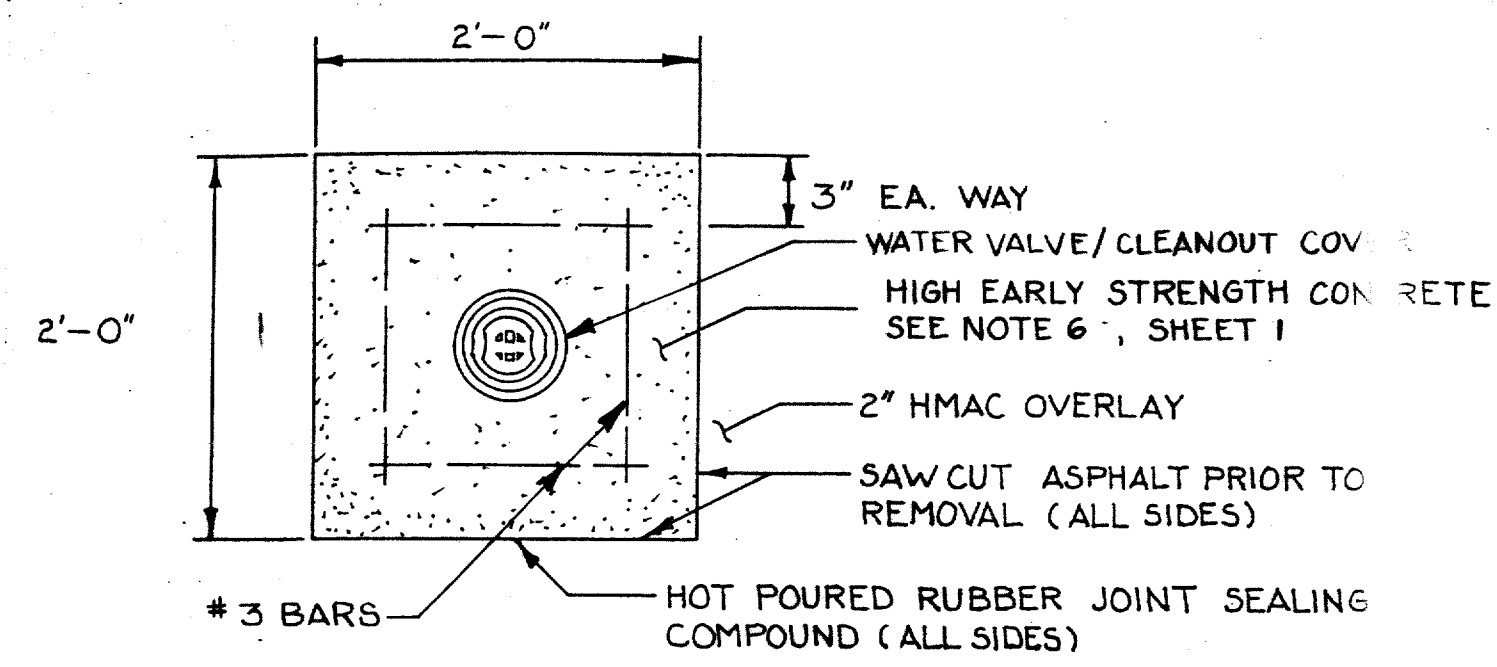


PLAN: CONCRETE VALVE BOX APRON
NTS

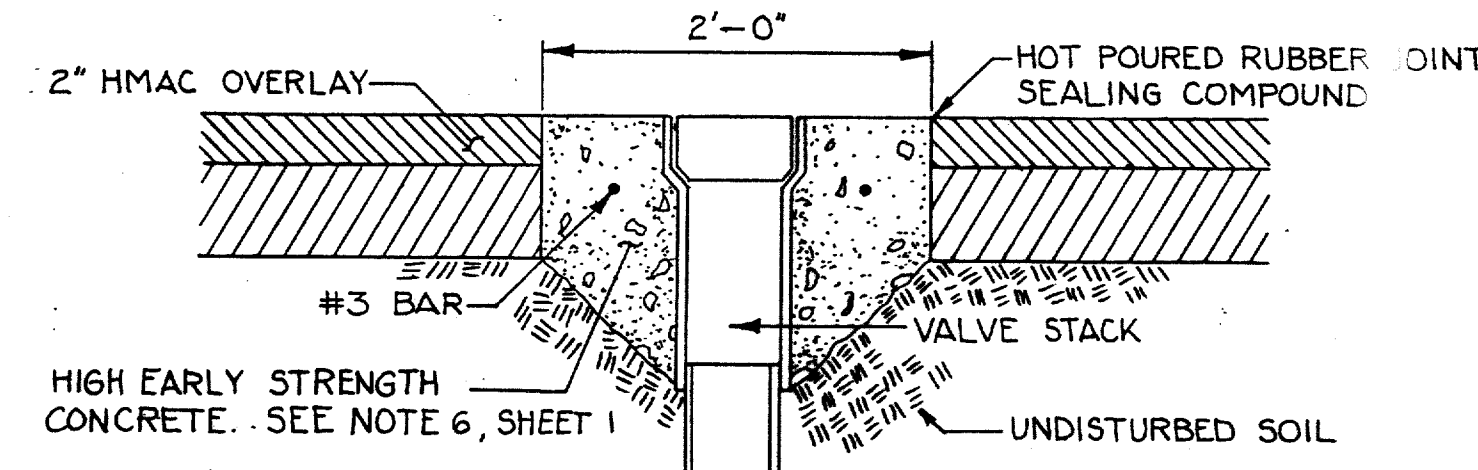



SECTION: CONCRETE VALVE BOX APRON
NTS

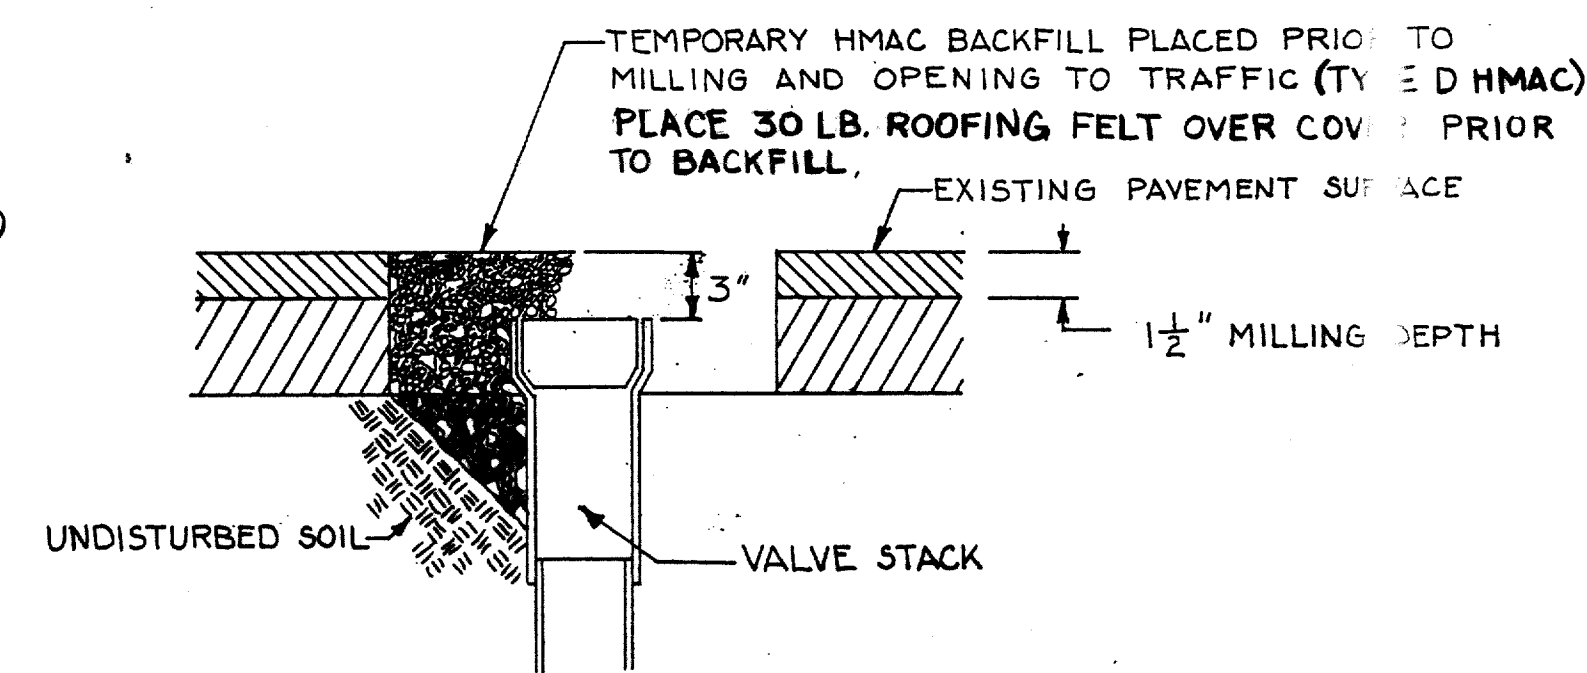

DETAIL: TEMPORARY LOWERING OF VALVE BOX
NTS

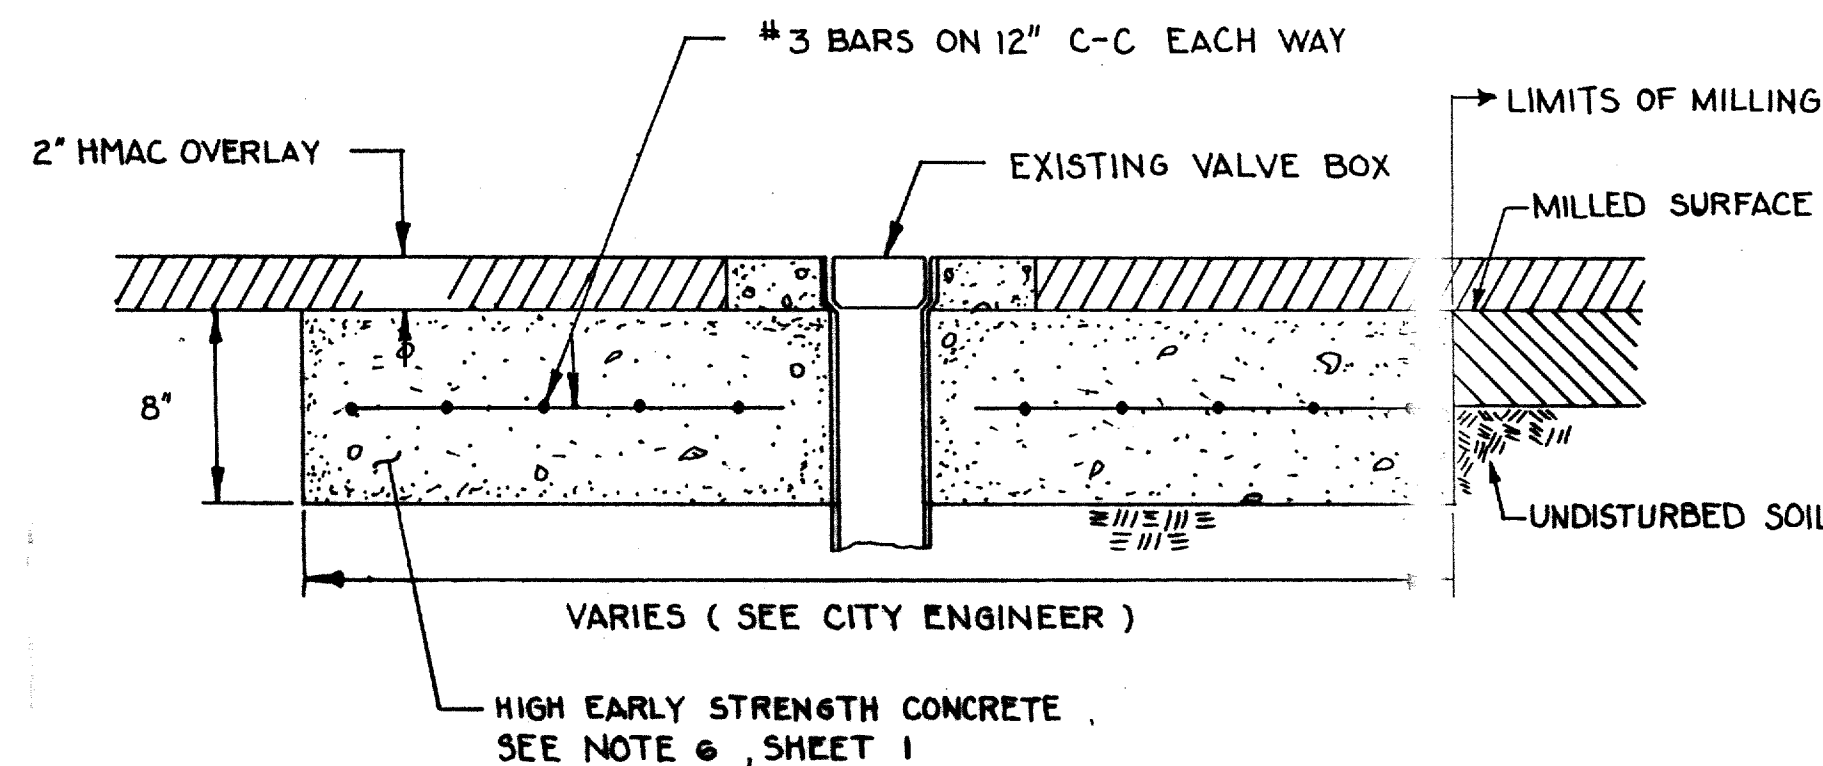


PAVEMENT REPLACEMENT & VALVE ADJUSTMENT
NTS

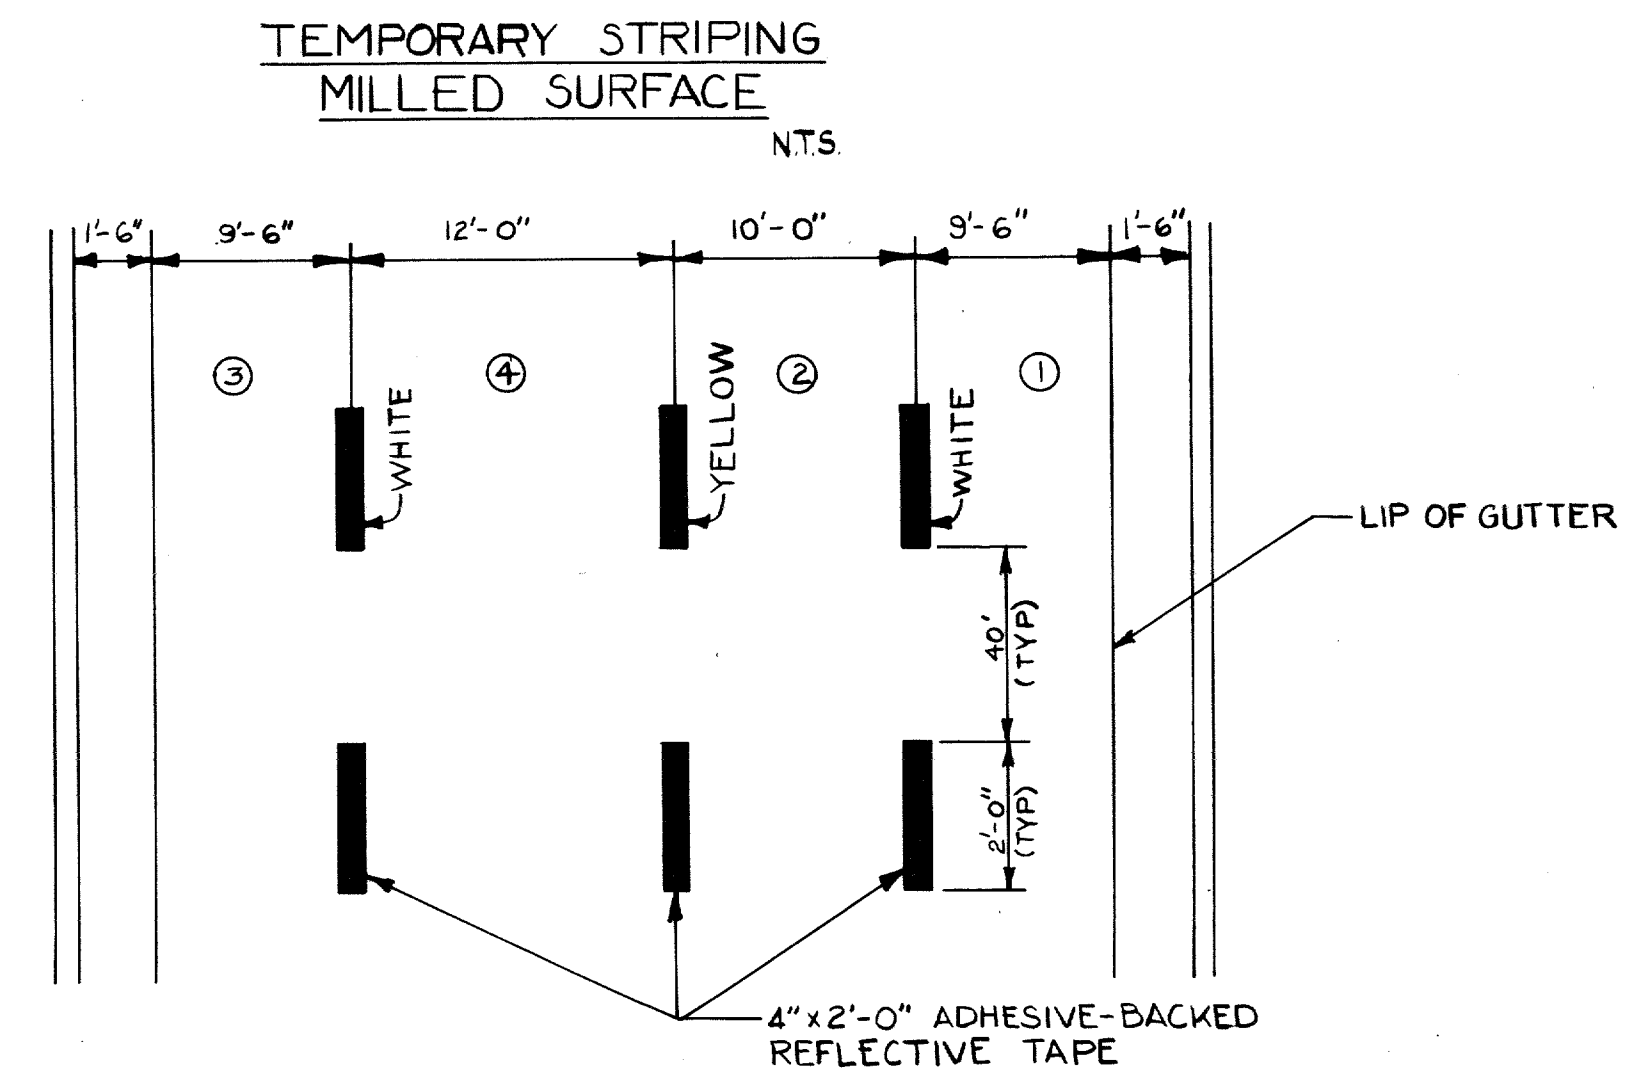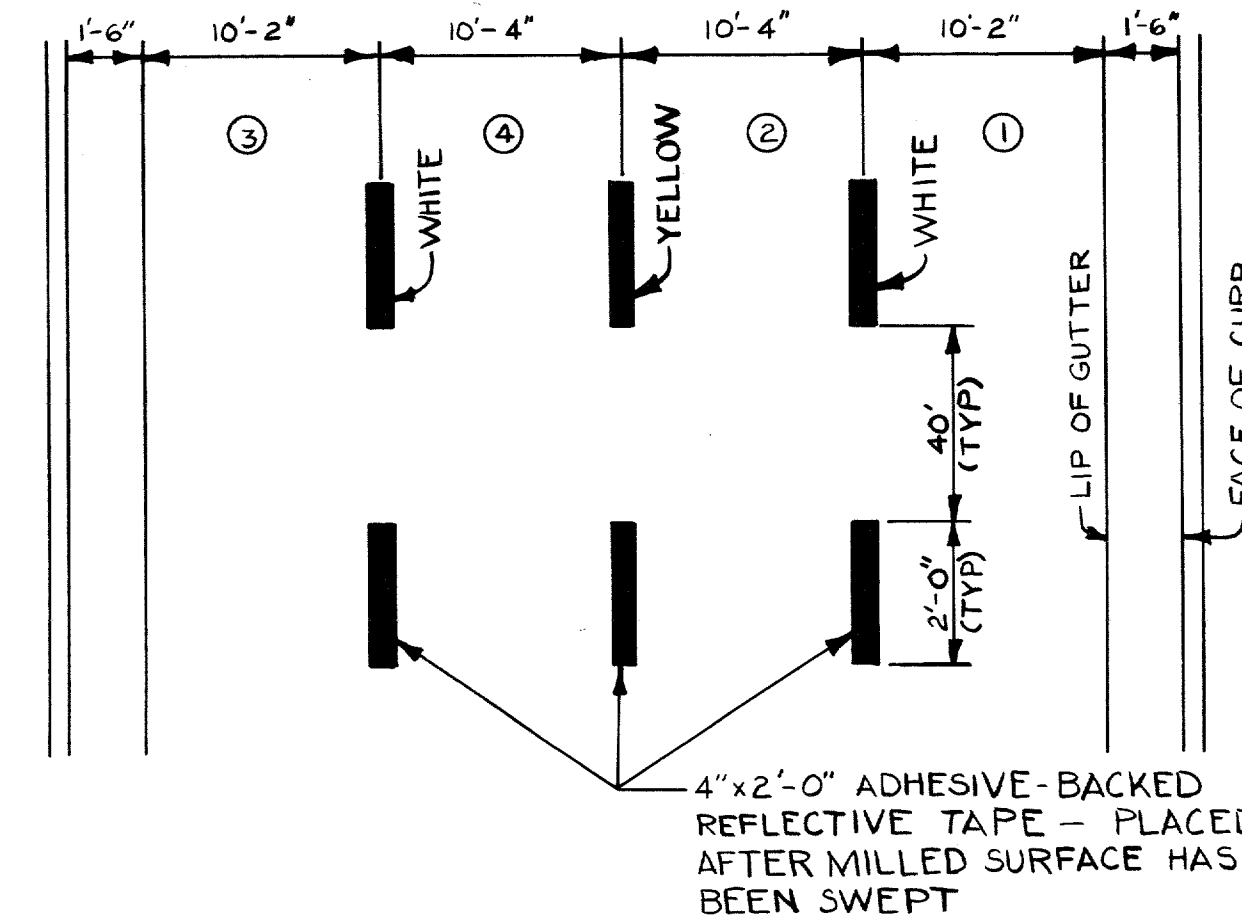

TEMPORARY STRIPING OVERLAYED SURFACE
NTS

RECORD DRAWING
AS BID

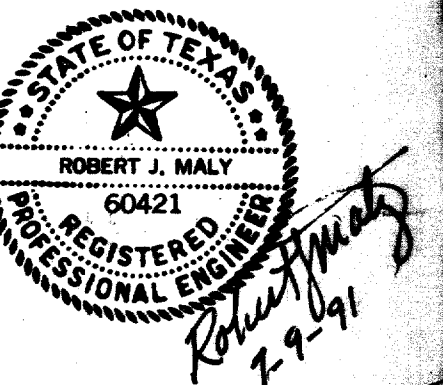

CITY OF ADDISON, TEXAS
ADDISON ROAD OVERLAY

MISCELLANEOUS
DETAILS

Rady & Associates, Inc.
Engineers • Architects • Planners
910 Collier Street Fort Worth, Texas 76102 817/395-6511

DESIGN BY: RJM	REVISIONS BY:	DATE: MAY 1991
DRAWN BY: CLR		JOB NO: 91009
CHECKED BY: RJM/WBR		SHEET NO. 5 OF 5