



h1-15

# TRAFFIC SIGNAL DESIGN PLANS FOR THE INTERSECTION OF ADDISON ROAD WITH KELLER SPRINGS ROAD

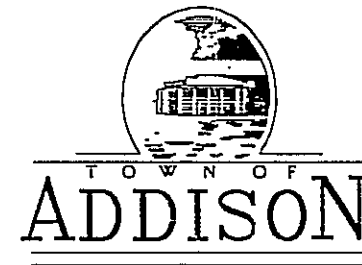

## INDEX OF DRAWINGS

SHEET DESCRIPTION	PAGE
TITLE	1
SIGNAL LAYOUT PLANS	2
SIGNAL LAYOUT TABLES	3
TRAFFIC SIGNAL HEAD DETAILS	4
TRAFFIC SIGNAL POLE FOUNDATIONS	5
CONTROLLER FOUNDATION / GROUND BOX INSTALLATION	6
TRAFFIC CONTROL PLAN DETAILS	7-8

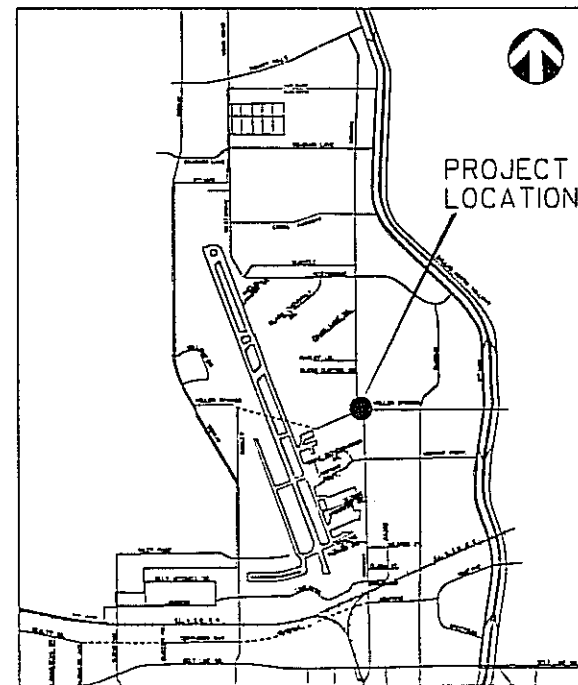

LOCATION MAP



The seal appearing on this document was authorized by Alan P. McNeil, P.E. 69951, on March 23, 1991. Alteration of a sealed document without proper notification to the responsible Engineer is an offense under the Texas Engineering Practice Act.

*Alan P. McNeil*



PARSONS  
TRANSPORTATION GROUP

5485 BELT LINE RD. #199 DALLAS, TEXAS 75240 (972) 991-1900

BUILT AS PER  
SPECIFICATIONS AND PLANS  
BY DURABLE SPECIALTIES INC.

PROJECT COORDINATOR

*[Signature]*

TRAFFIC SIGNALS ADDISON/KSR AS-BUILTS 3-13-00  
51-14