



1132

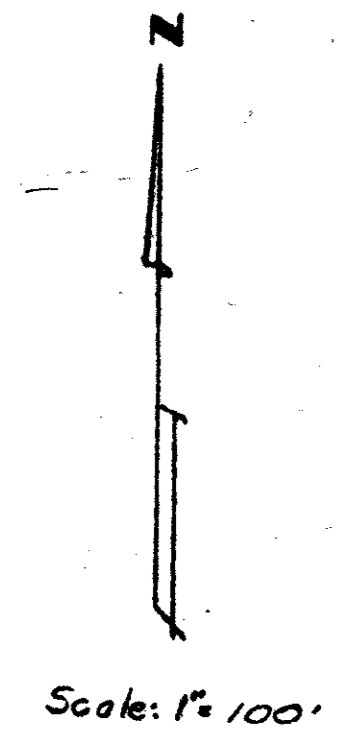

MATCH MARK 'A' SEE SHEET 5710-01A

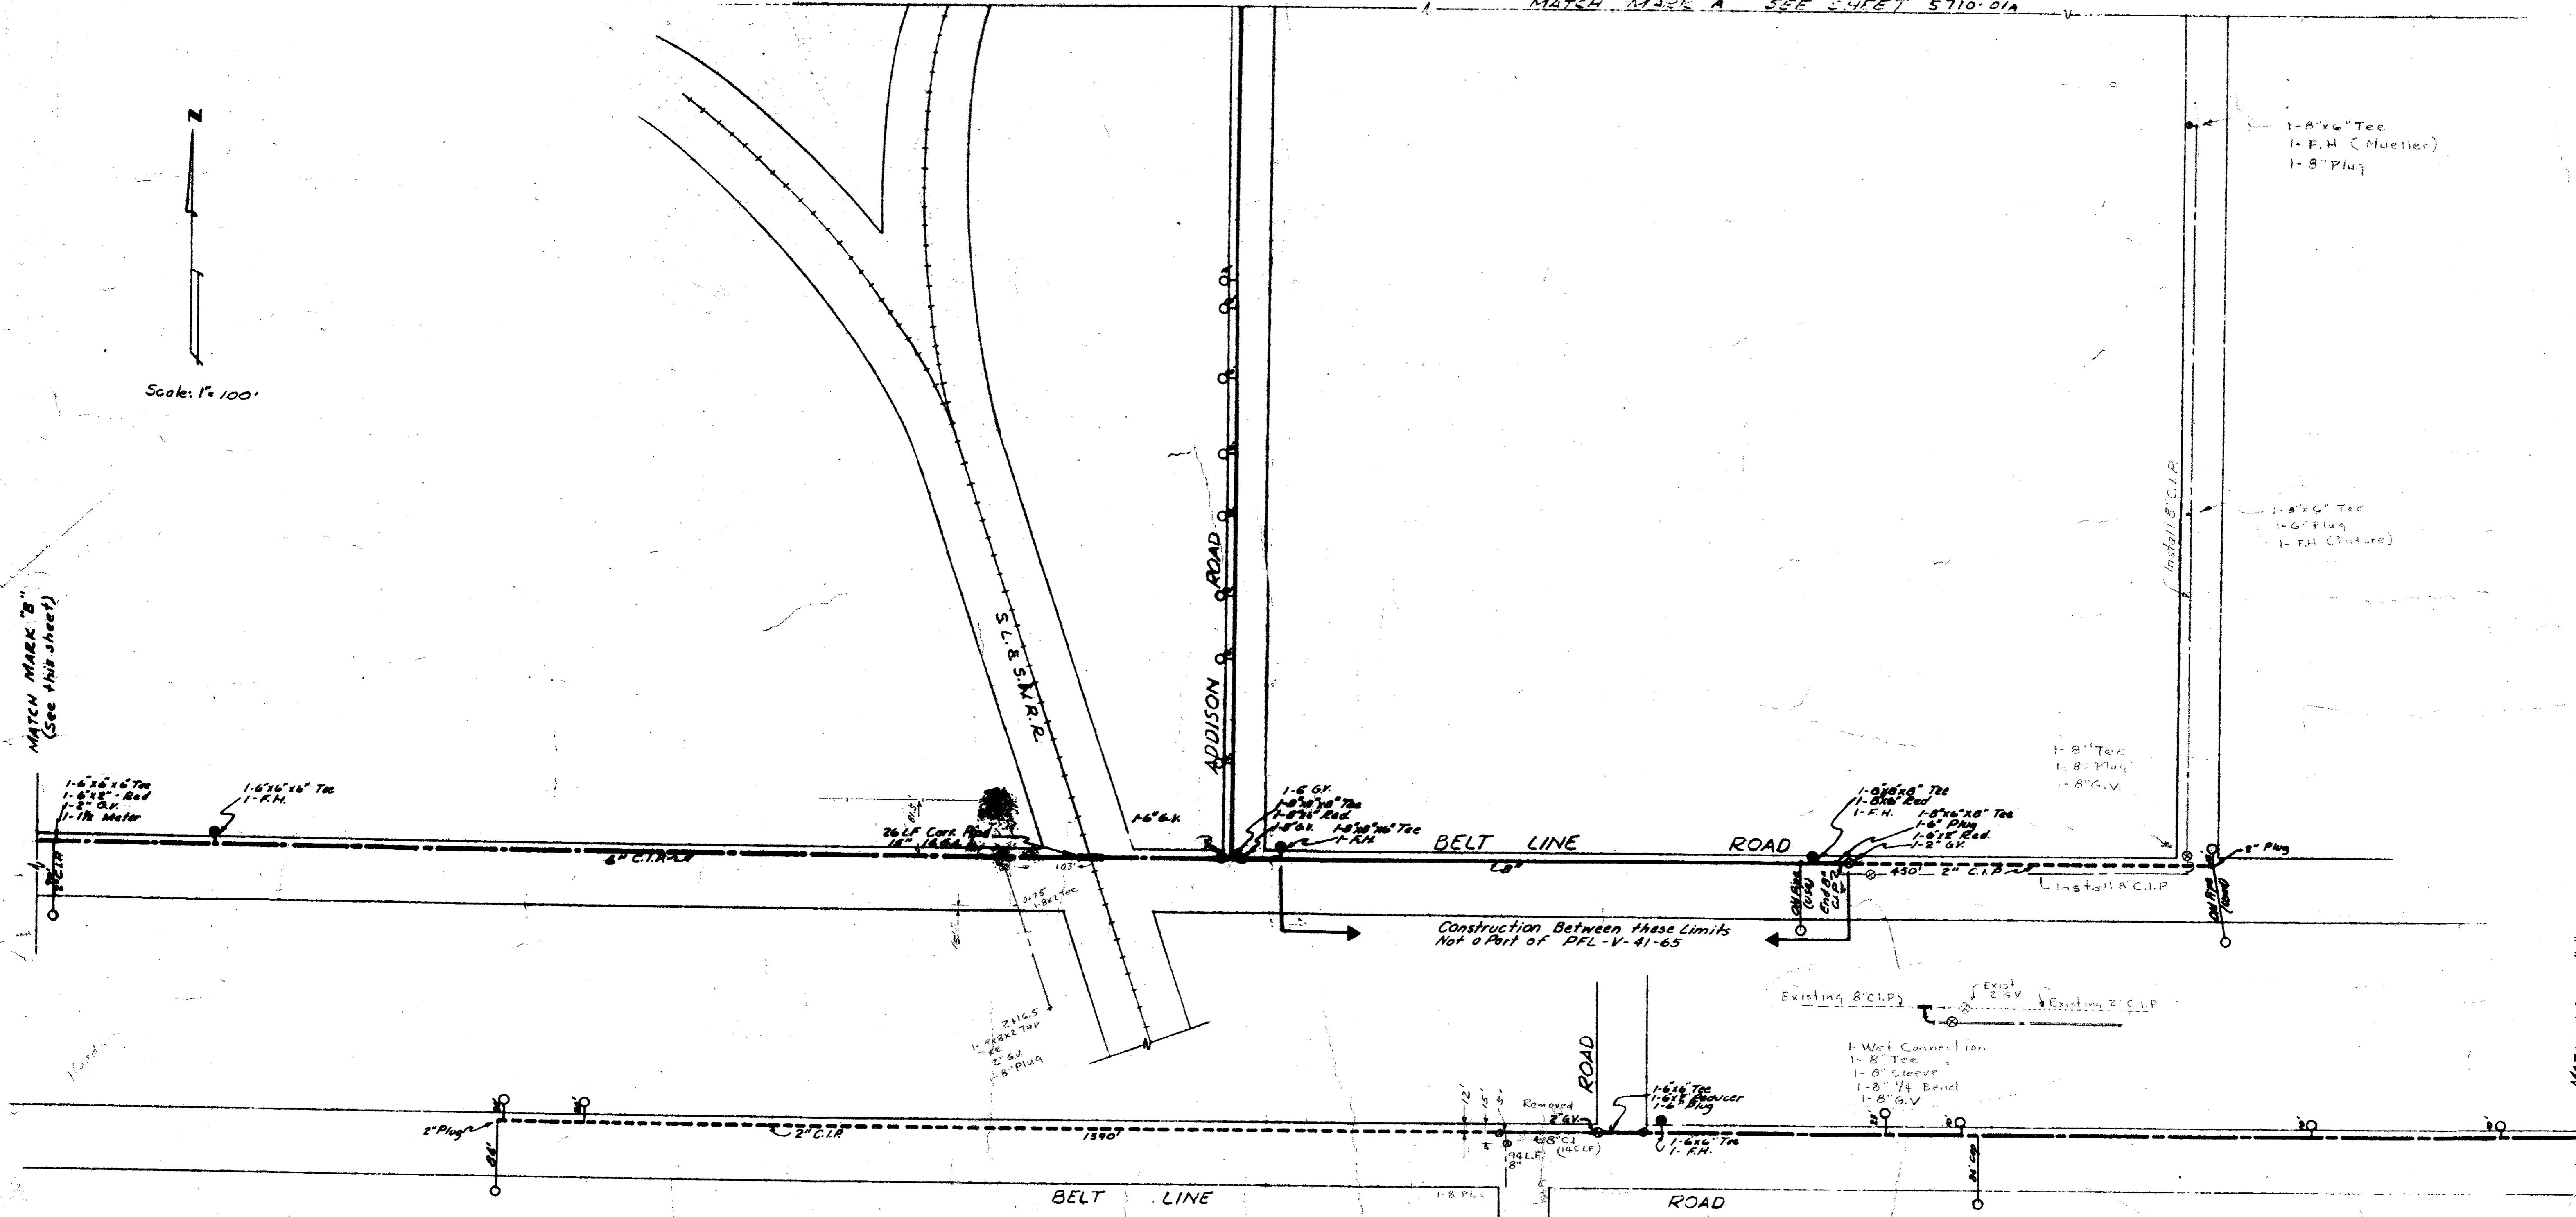

MATCH MARK 'B' (See this sheet)

MATCH MARK 'B' (See this sheet)

Construction Between these Limits Not a Part of PFL-V-41-65

- LEGEND**
- 8" CAST IRON PIPE
 - - - 6" CAST IRON PIPE
 - - - 2" CAST IRON PIPE
 - ⊕ GATE VALVE
 - FIRE HYDRANT
 - COPPER SERVICE & METER & DISTANCE - METER TO MAIN

H.H.F.A. PROJECT NO. PFL-V-41-65
SHEET 1B of 4

ADDISON, TEXAS
WATER DISTRIBUTION SYSTEM

HOMER A. HUNTER ASSOCIATES
CONSULTING ENGINEERS
DALLAS, TEXAS

DESIGNED: E.M.R. APPROVED: H.A.H.

5710-01B REV. JAN. 1969