

MATCH MARK "A" SEE SHEET 5710-01B

2" CIP on Broadway abandoned 8/85
Replaced with 8" PVC

2" CIP on Julian abandoned May 2001
Valves on Clara removed
6" x 6" Cross removed
6" valve installed
6" line on Clara still active
REW


Scale: 1" = 100'

H.H.F.A. PROJECT NO. PFL-V-41-65
SHEET 1A of 4

ADDISON, TEXAS
WATER DISTRIBUTION SYSTEM

HOMER A. HUNTER ASSOCIATES
CONSULTING ENGINEERS
DALLAS, TEXAS

DESIGNED: E.M.R. APPROVED: H.A.H.

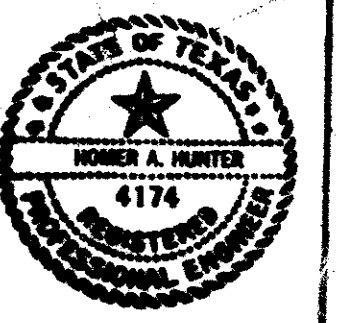

5710-01A REV. JAN. 1959

AS BUILT

SEE SHEET 5710-01B
FOR LEGEND